

**CLAIM OF BENEFICIAL USE SURVEY**  
 LOCATED IN THE NORTHWEST ONE-QUARTER OF THE  
 SOUTHEAST ONE-QUARTER OF SECTION 21,  
 TOWNSHIP 17 SOUTH, RANGE 13 EAST, WILLAMETTE MERIDIAN,  
 DESCHUTES COUNTY, OREGON

**RECEIVED**

OWNER AND PERMITTEE:  
 CRAIG AND KRISTINA GLAZIER

TRANSFER NO. T-9732

NOV 05 2007


WATER RESOURCES DEPT  
 SALEM, OREGON

T17S, R13E


21 22

**POINT OF DELIVERY  
 DETAIL**

SW 1/4 NE 1/4 Section 13  
 T18S, R11E, W.M.

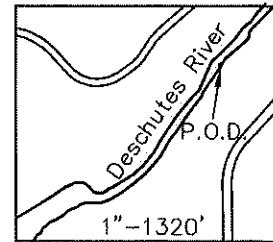


Point of Delivery:  
 C.O.I.D. Main Canal  
 1520' South &  
 1535' West of  
 Northeast corner  
 of Section 13

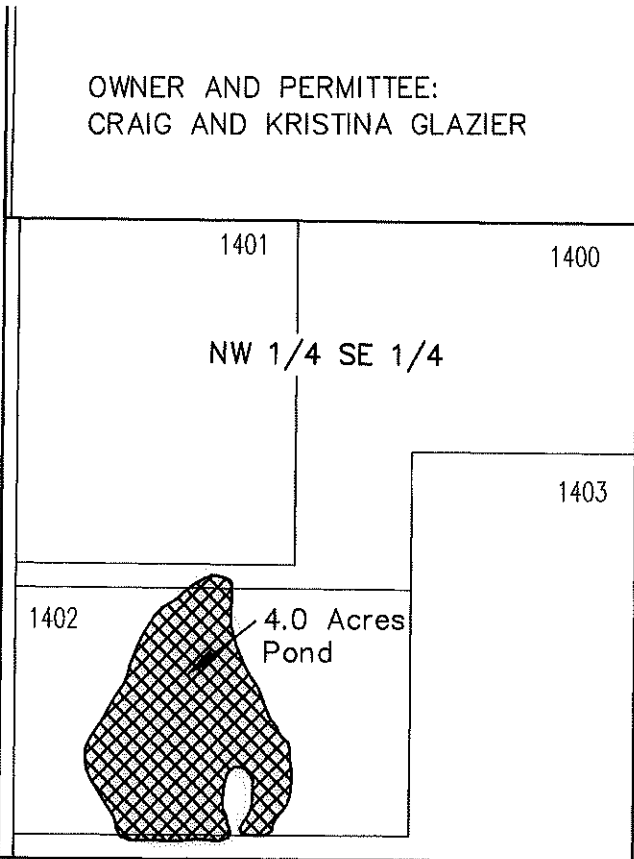

NE 1/4 SE 1/4

SW 1/4 SE 1/4

SE 1/4 SE 1/4

 = PRIMARY WATER RIGHTS  
 IN NW 1/4 NW 1/4 = 4.0 AC.


**RECEIVED**

AUG 20 2007

WATER RESOURCES DEPT  
 SALEM, OREGON

I, James R. Tye, Certified Water Right Examiner in the State of Oregon, hereby certify that this water rights survey map was prepared under my direct supervision.

The preparation of this map is for the purpose of identifying the location of the water right only and has no intent to provide dimensions or locations of property ownership lines.

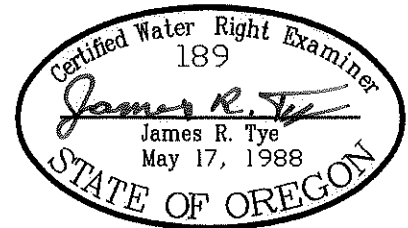


SCALE 1"=400'	DATE 8-16-07	SURVEY BY AERIAL	DRAWN BY K.B.	ORDER NO. 6868-22
---------------	--------------	------------------	---------------	-------------------

**SUN COUNTRY ENGINEERING & SURVEYING, INC.**  
 920 SE ARMOUR ROAD BEND, OREGON 97702 PHONE 382-8882

**CLAIM OF BENEFICIAL USE SURVEY**  
 LOCATED IN THE NORTHWEST ONE-QUARTER OF THE  
 SOUTHEAST ONE-QUARTER OF SECTION 21,  
 TOWNSHIP 17 SOUTH, RANGE 13 EAST, WILLAMETTE MERIDIAN,  
 DESCHUTES COUNTY, OREGON

OWNER AND PERMITTEE:  
 CRAIG AND KRISTINA GLAZIER

TRANSFER NO. T-9732

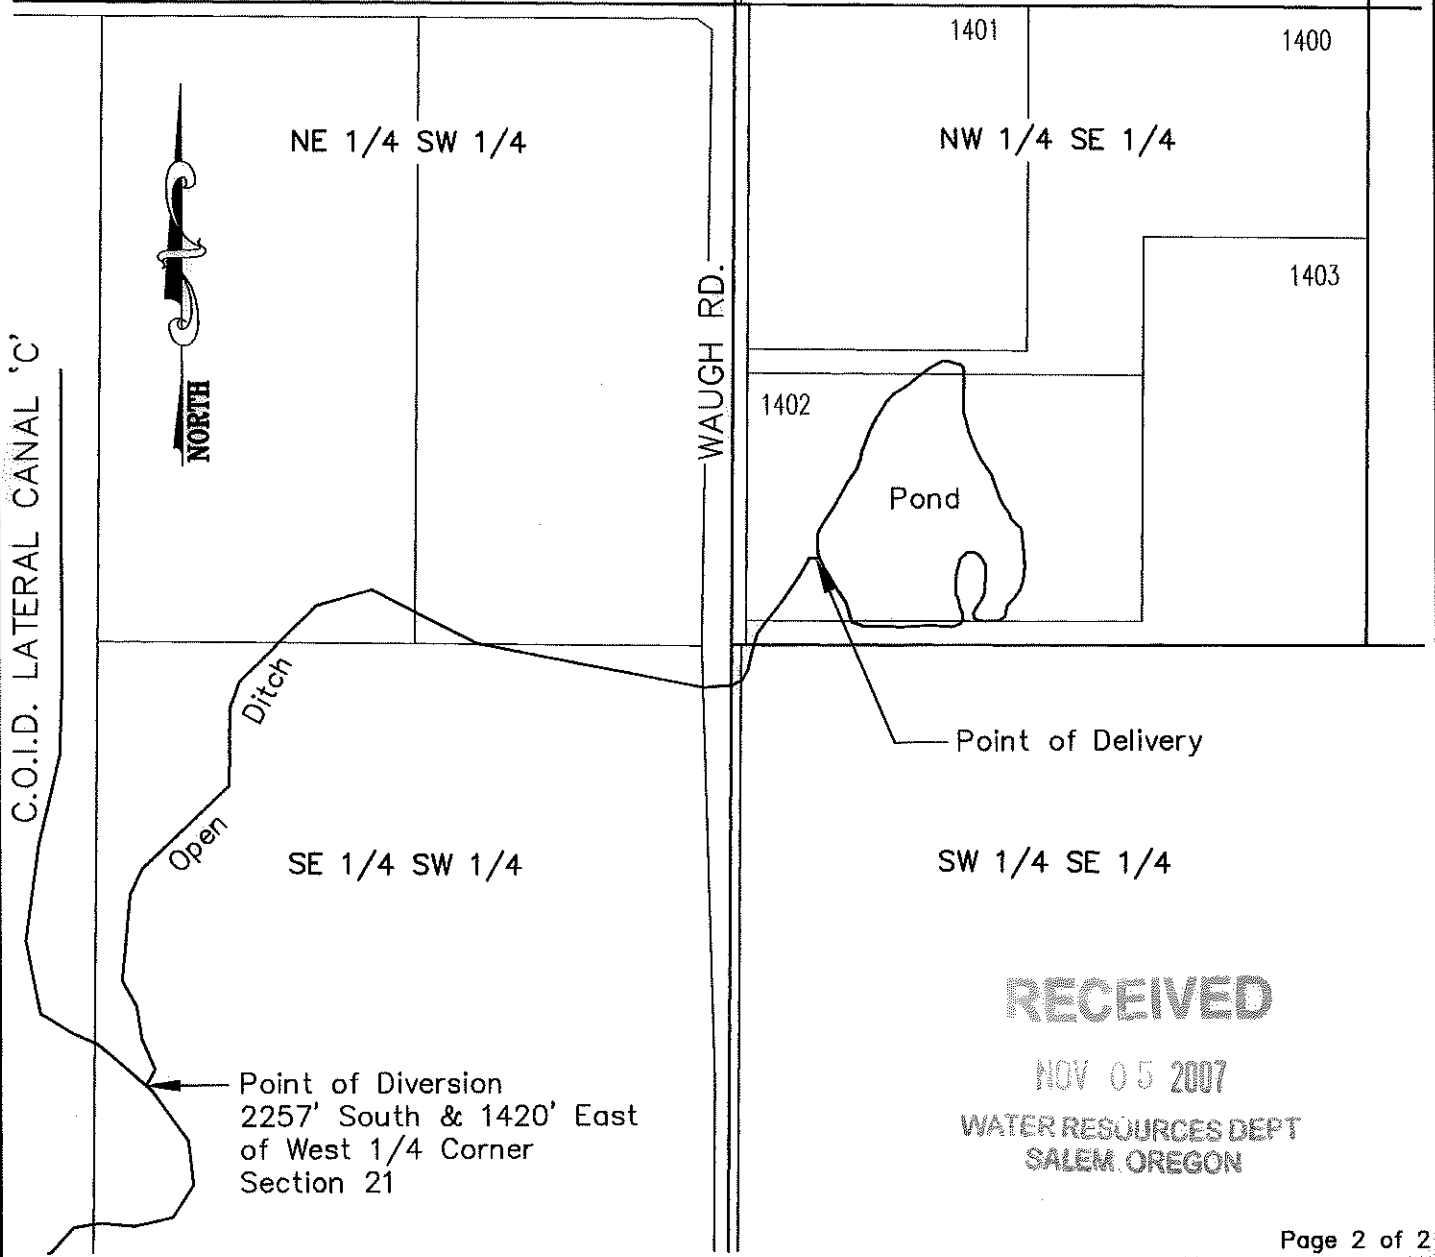

**RECEIVED**

NOV 05 2007

WATER RESOURCES DEPT  
 SALEM, OREGON

SCALE 1"=400' | DATE 8-16-07 | SURVEY BY --- | DRAWN BY K.B. | ORDER NO. 6868-22a

**SUN COUNTRY ENGINEERING & SURVEYING, INC.**  
 920 SE ARMOUR ROAD BEND, OREGON 97702 PHONE 382-8882