

RECEIVED BY OWRI  
 JAN 05 2017  
 SALEM, OR

RIVER

Received by OWRI  
 DEC 27 2018  
 Salem, OR

SCALE: 1" = 400'


Sec 3 T22S R 46E

OFF

T 12556

T-12556  
 Final Order  
 Tax Lot 1800 22S46E03 SWSW  
 ON .8 Acres



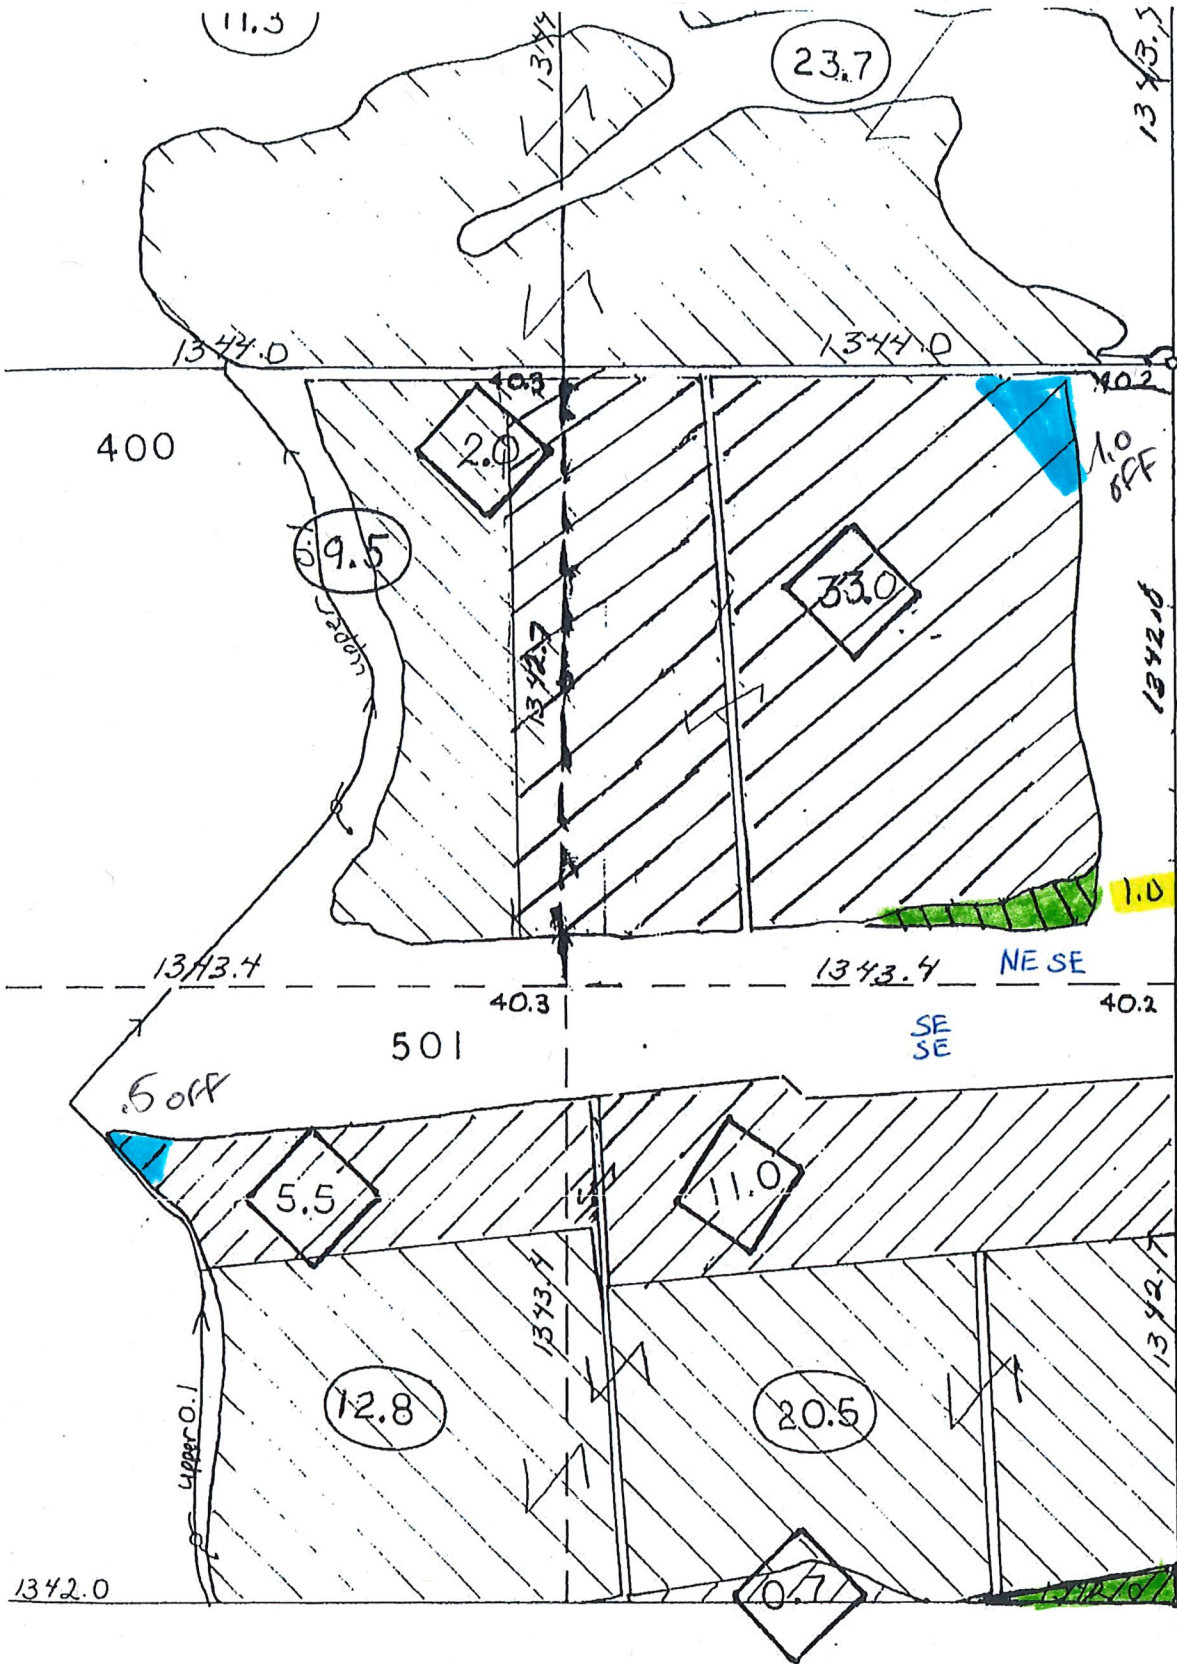

- (xx.x)  
IRR. ACRES  
IN 1/4 1/4
- [Hatched Box]  
IRR. ACRES
- (x.x)  
PENDING
- [Hatched Box]  
PENDING ACRES
- (x.x)  
PRIVATE
- [Vertical Lines Box]  
PRIVATE ACRES
- .....  
PROPERTY LINE IF  
OTHER THAN 1/4 1/4

Received by OWRD

DEC 21 2018

Salem OR



SCALE: 1" = 400'

0.5 Ac ON


SEC. 4 , T.22 S., R.46 E., W.M.

48-102-1584

T-12556  
Final Order  
Tax Lot 400 22S46E04 NESE  
ON 1.0 Acres

OFF  
T 12556

T-12556  
Final Order  
Tax Lot 501 22S46E04 SESE  
ON .5 Acres

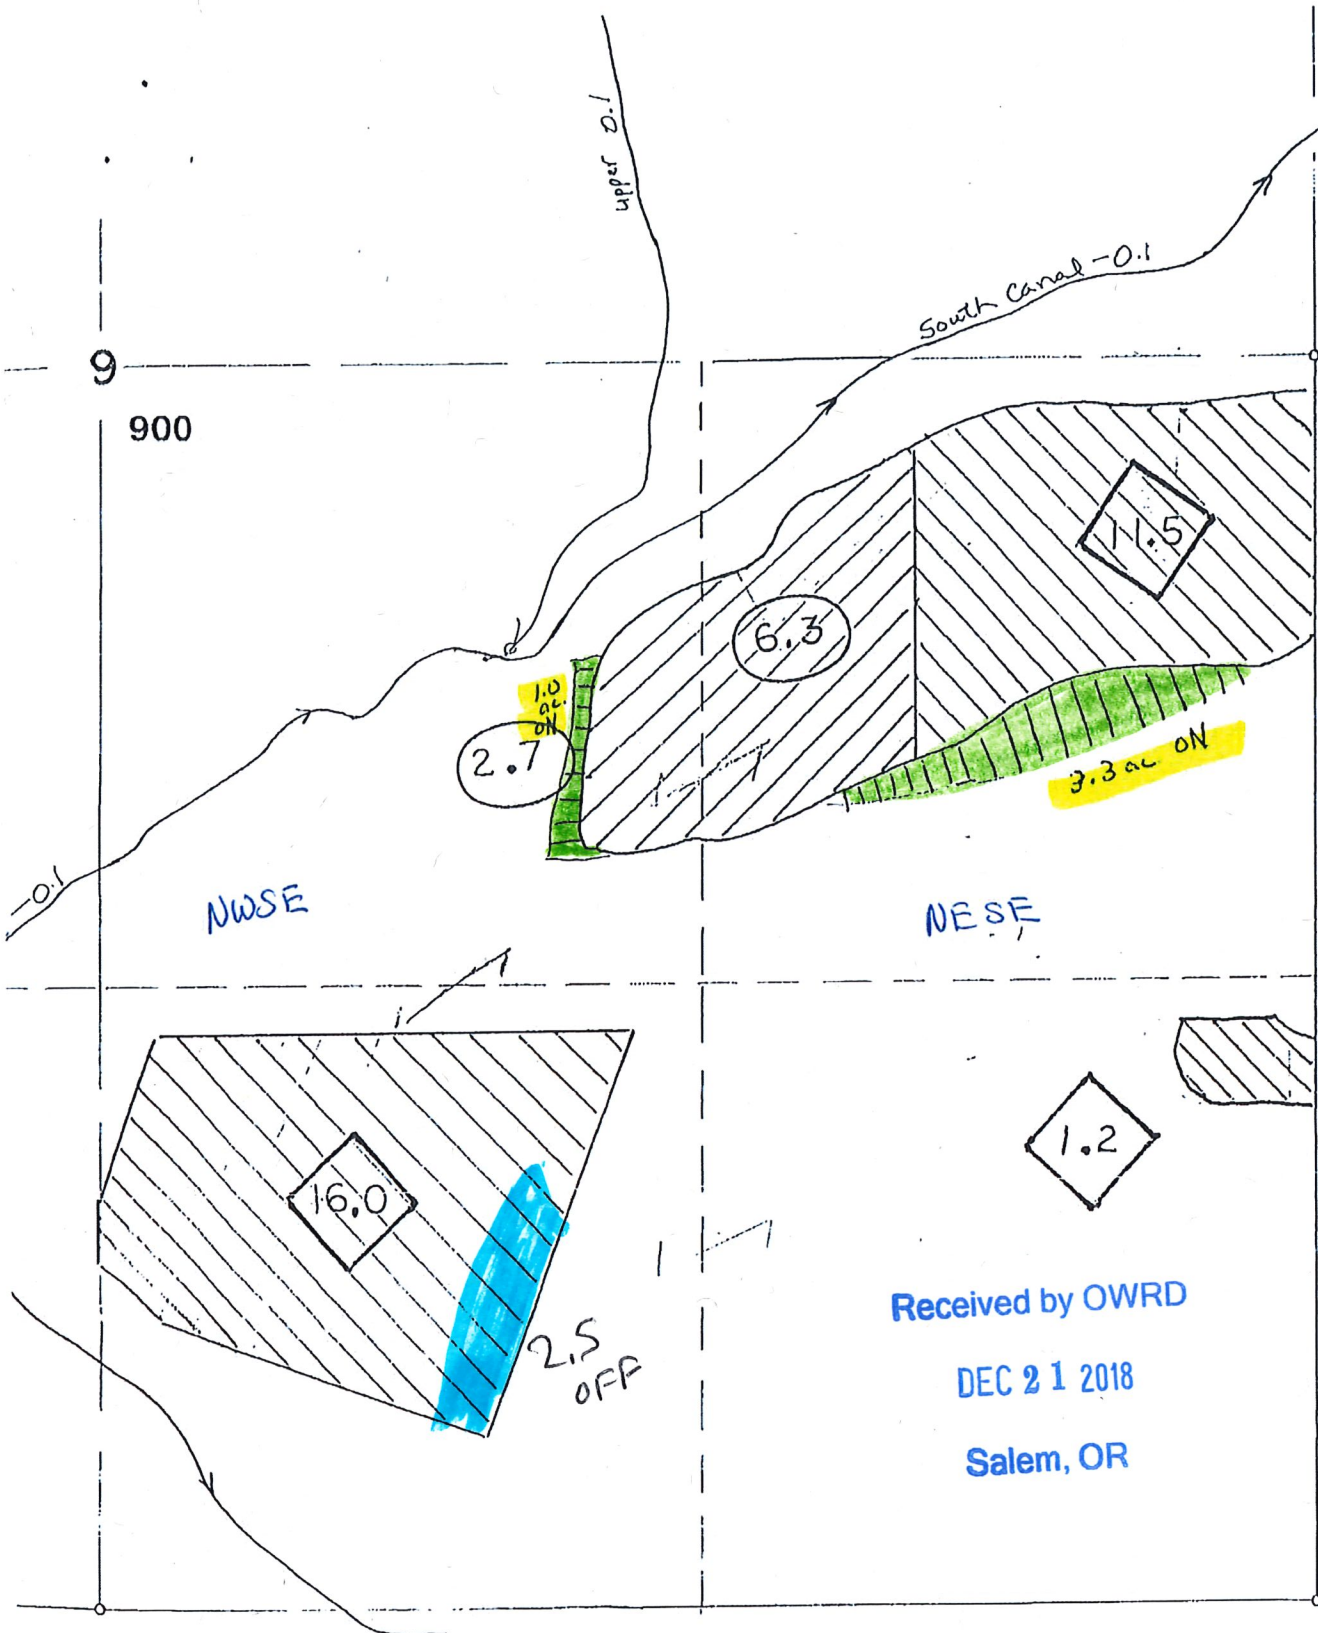

- (xx.)  
IRR. AC  
IN 1/4
- [Hatched Box]  
IRR. AC
- (x.x)  
PENDING
- [Hatched Box]  
PENDING
- (x.x)  
PRIVATE
- [Vertical Lines Box]  
PRIVATE
- PROPER  
OTHER :

Received by OWRD  
 DEC 21 2018  
 Salem, OR

SCALE  
 1" = 400'  
 SOUTHEAST  
 OF SECTION

SEC. 9, T.22 S., R.46 E., W.M.

48-102-15

T-12556  
 Final Order  
 Tax Lot 900 22S46E09 NWSE  
 ON 1.0 Acres

T-12556  
 Final Order  
 Tax Lot 900 22S46E09 NESE  
 ON 3.3 Acres

T 12556



