

Google Earth photo

photo on June 2, 2016

Legend

-  Fort Klamath Museum
-  Fort Klamath Museum



13197

RECEIVED
MAR 01 2019
OWRD

Google Earth

© 2018 Google

Map of
 SB206 Temporary Transfer
 Stephen & Jamie Traynham
 KA 49

T 33 S, R 7.5 E
 Section 22, 23 & 27



Legend

-  Transfer TO 30.8 Ac
-  KA 49 FROM 30.8 acres
-  Ditch



1 inch = 1,320 feet


RECEIVED
 MAR 01 2019
 OWRD

13137

**Map of
SB206 Temporary Transfer
Stephen & Jamie Traynham
KA 49**

**T 33 S, R 7.5 E
Section 22, 23 & 27**

13137

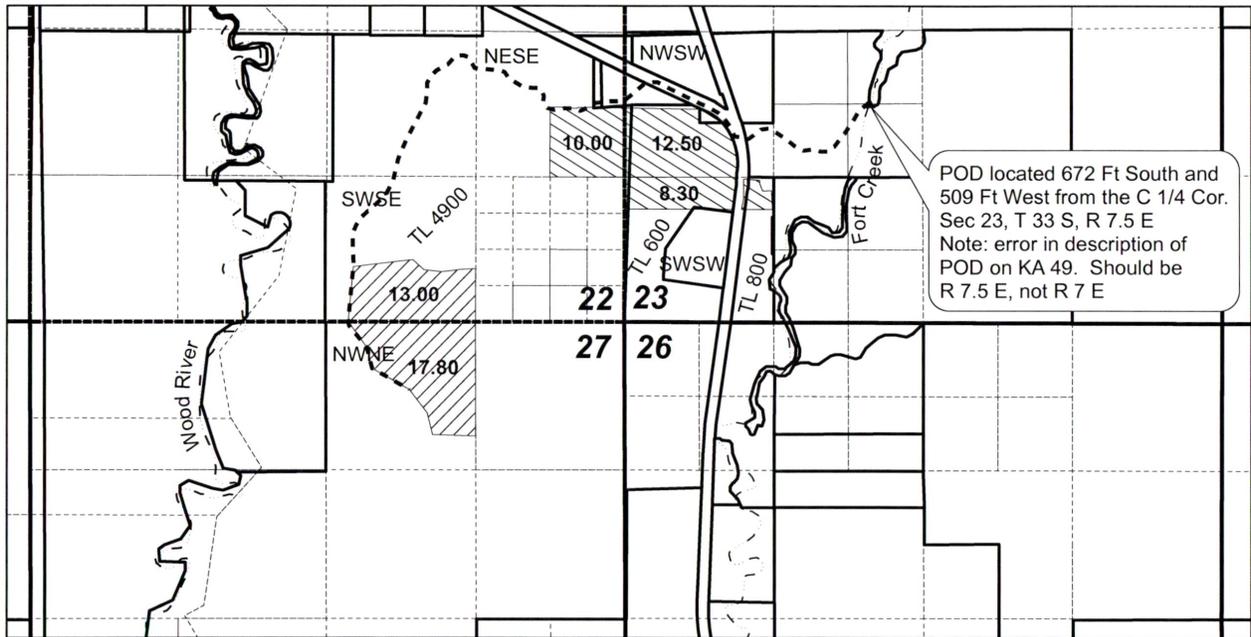

Legend

-  Transfer TO 30.8 Ac
-  KA 49 FROM 30.8 acres
-  Ditch



1 inch = 1,320 feet

RECEIVED
MAR 01 2019
OWRD