






Legend:

- Existing POU – changing 
- Existing POU – not changing 
- Proposed POU 
- Existing PVC mainline 
- Proposed PVC extension 


Map compiled by the applicant.


Application to Transfer water
From Certificate #80359
T-

This map is not intended to provide
Legal dimensions or locations of property
ownership lines.



EXP 6/30/2020

13168

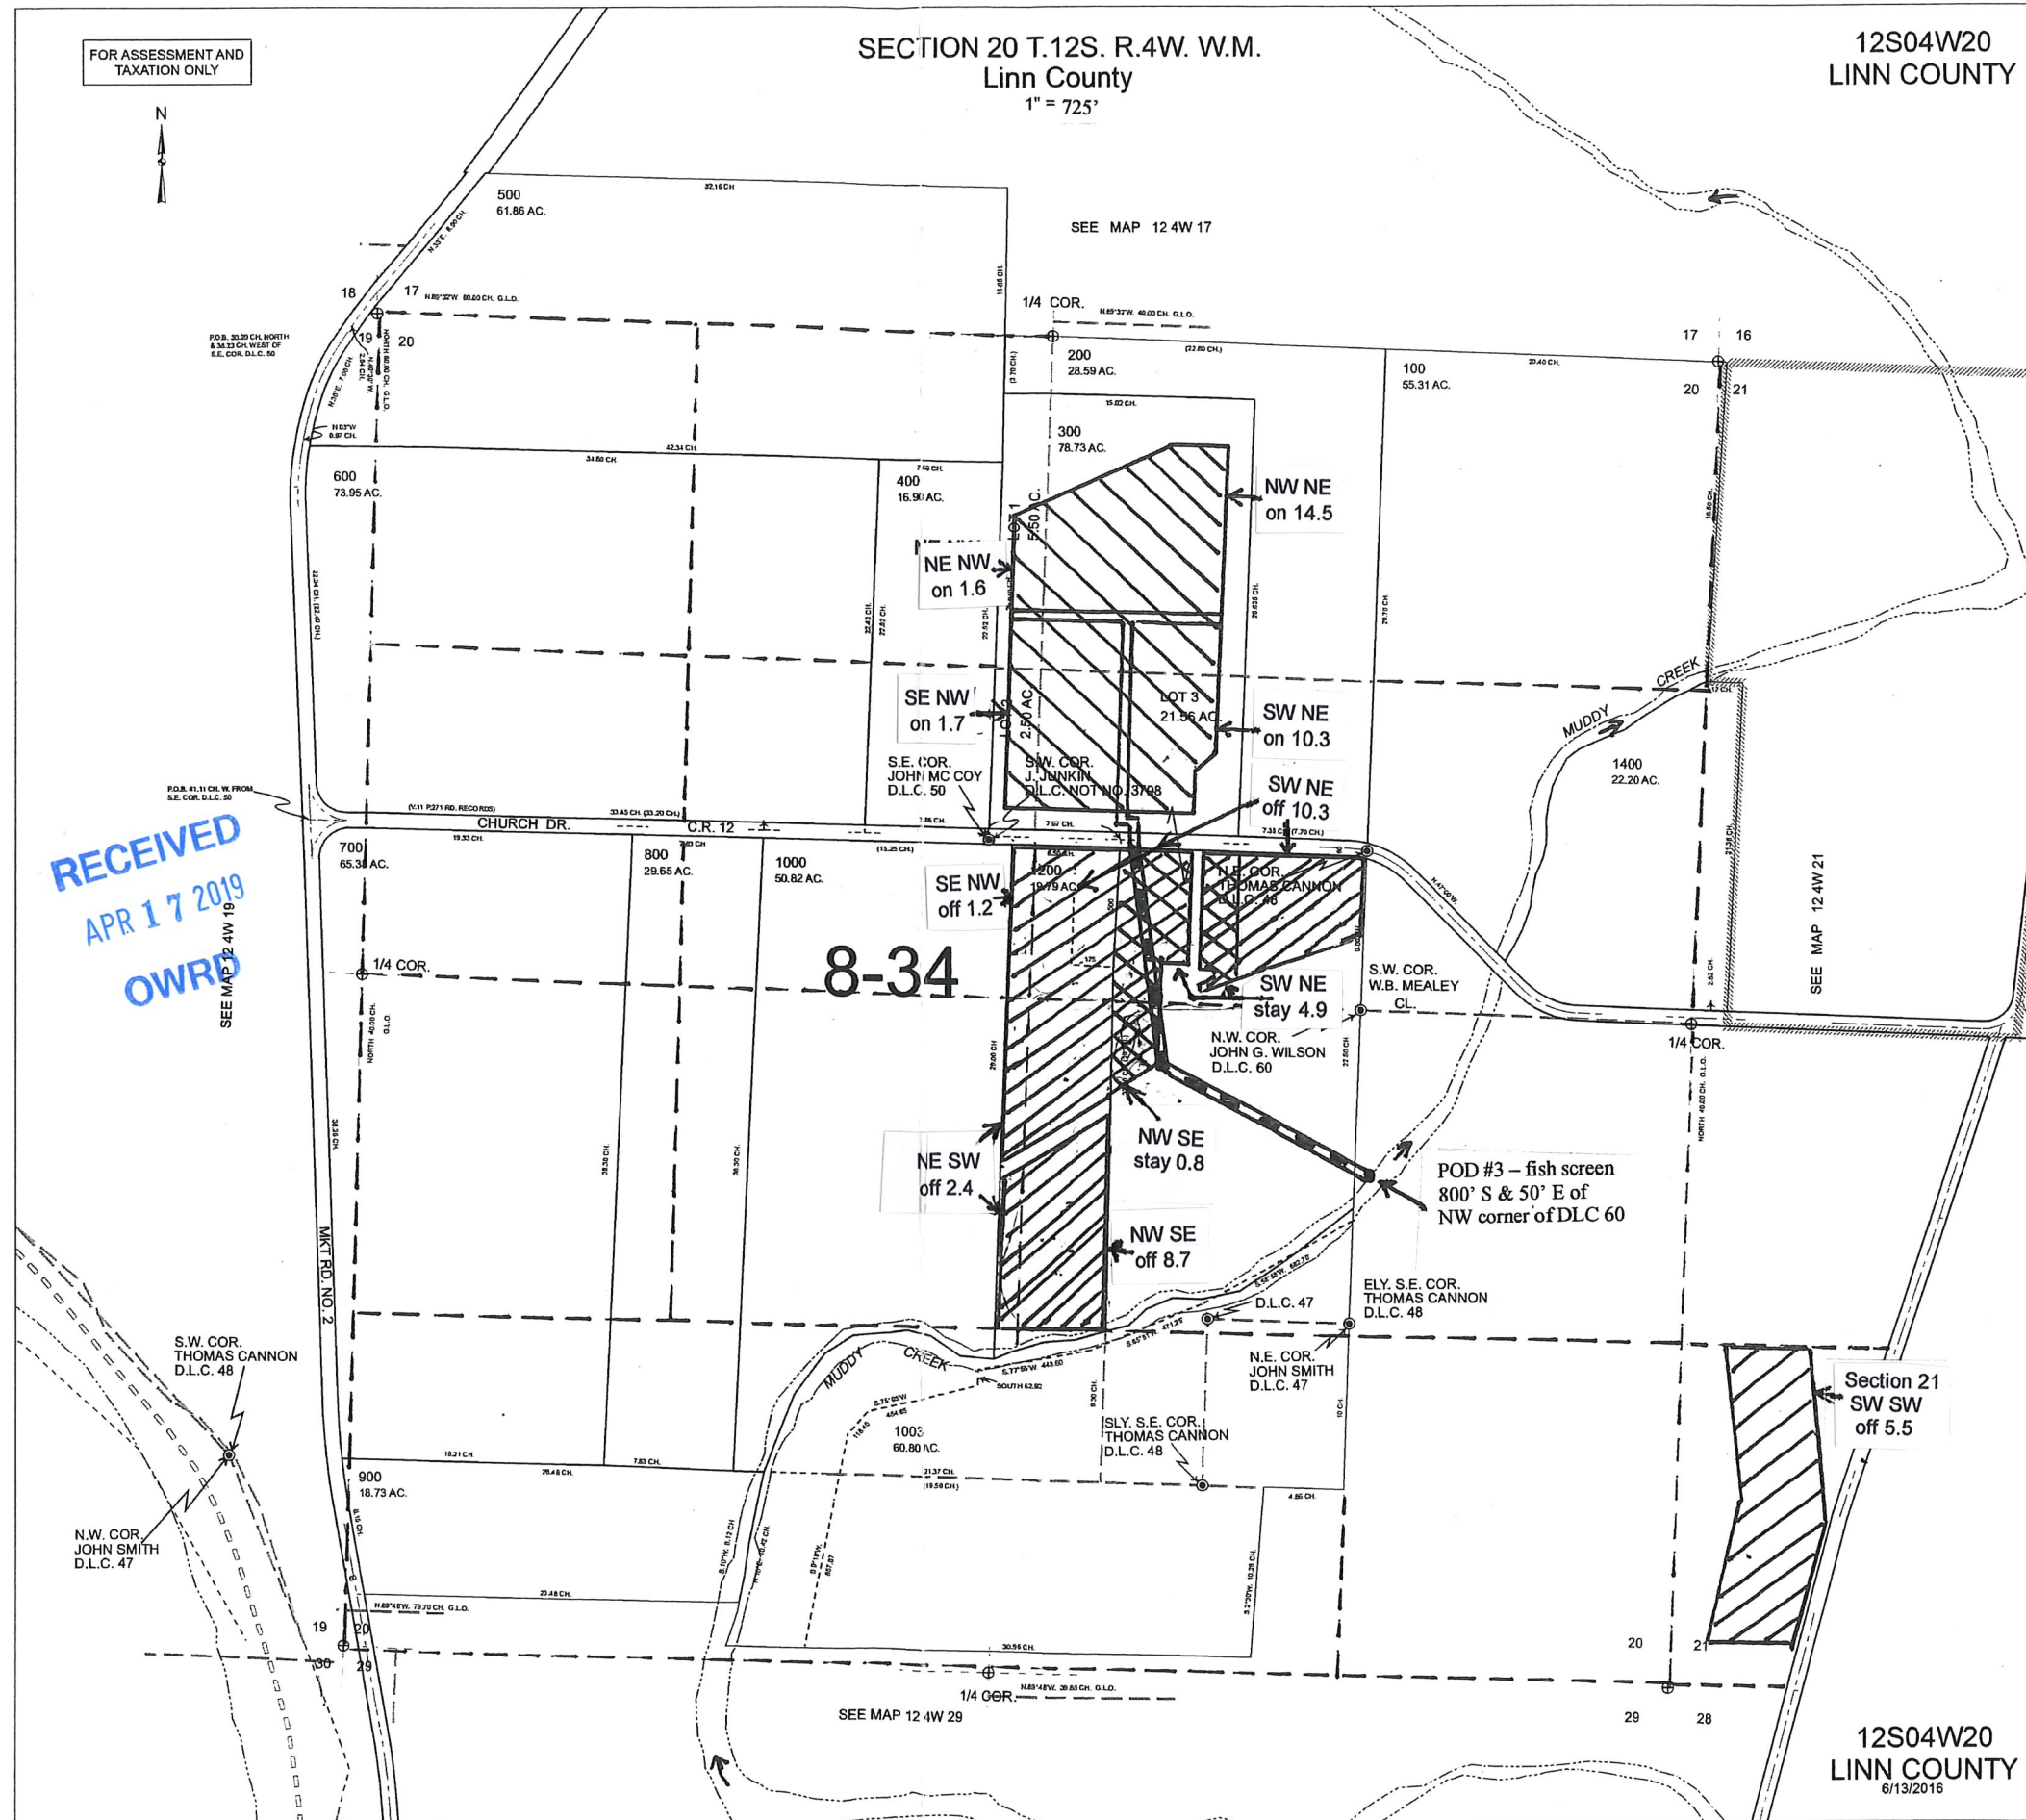

12S04W20
LINN COUNTY
6/13/2016