


Riverbend Farms 2019 Temporary Transfer

FROM Land
Certificate 36427

T.8&9S. R.5&6W. W.M.

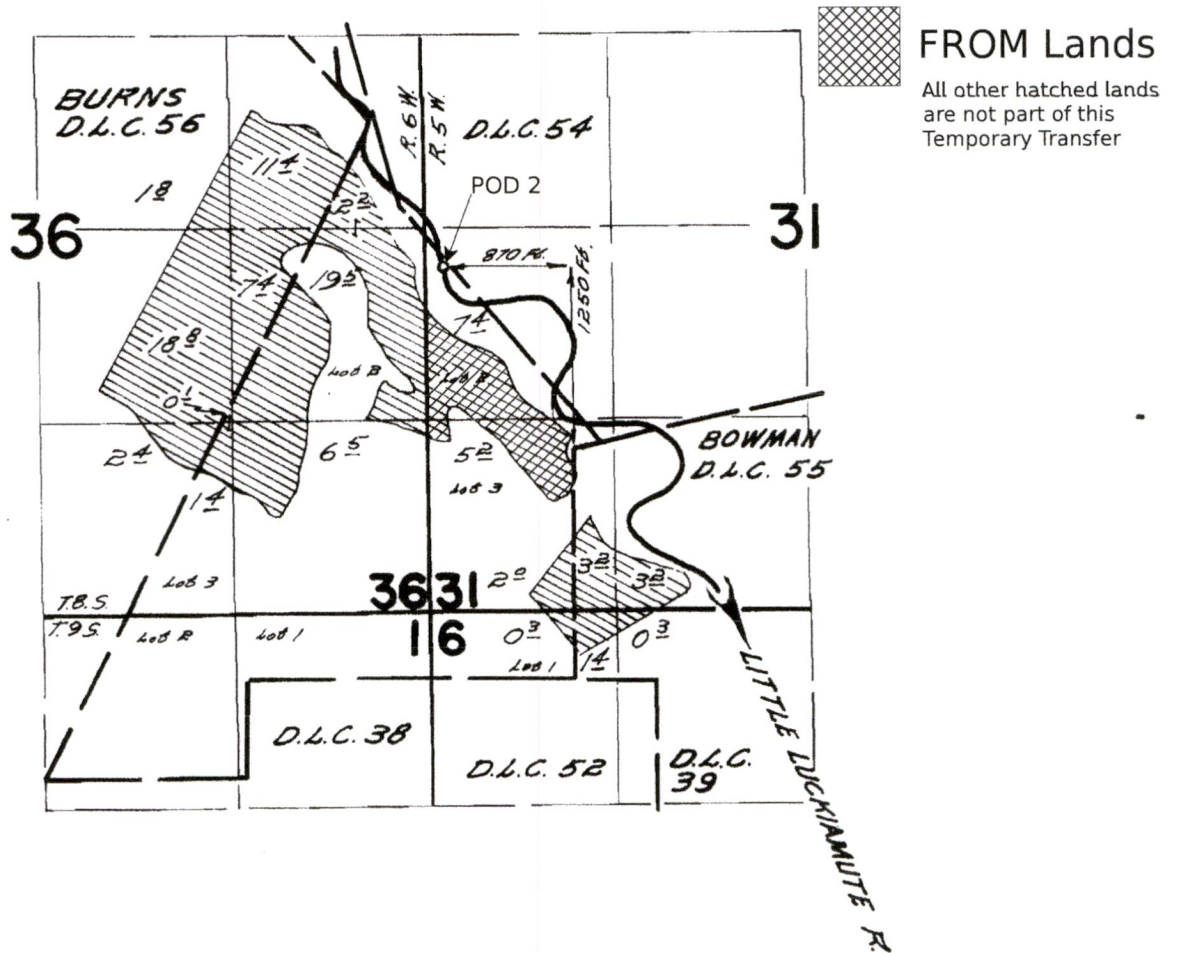

FINAL PROOF SURVEY
UNDER

Application No. 37579 Permit No. 27996
IN NAME OF

DR. C. J. MOSER

Surveyed Sept. 6, 1968, by *H. d. Rypper*

RECEIVED

MAY 13 2019

OWRD

