

9.5.19

Cancelled No.
101
301
901

RECEIVED
JUN 05 2019
OWRD

9.5.19

13198

See Map 9.5.20

19 | 20
30 | 29

**SEC.19 T9S R5W WM
POLK COUNTY**
Scale 1" = 400'

See Map 9.5.18

IMPORTANT
This Map for Assessment
and Taxation Purposes
ONLY


2-18

13-8

2-28

See Map 9.5.24

See Map 9.5.30

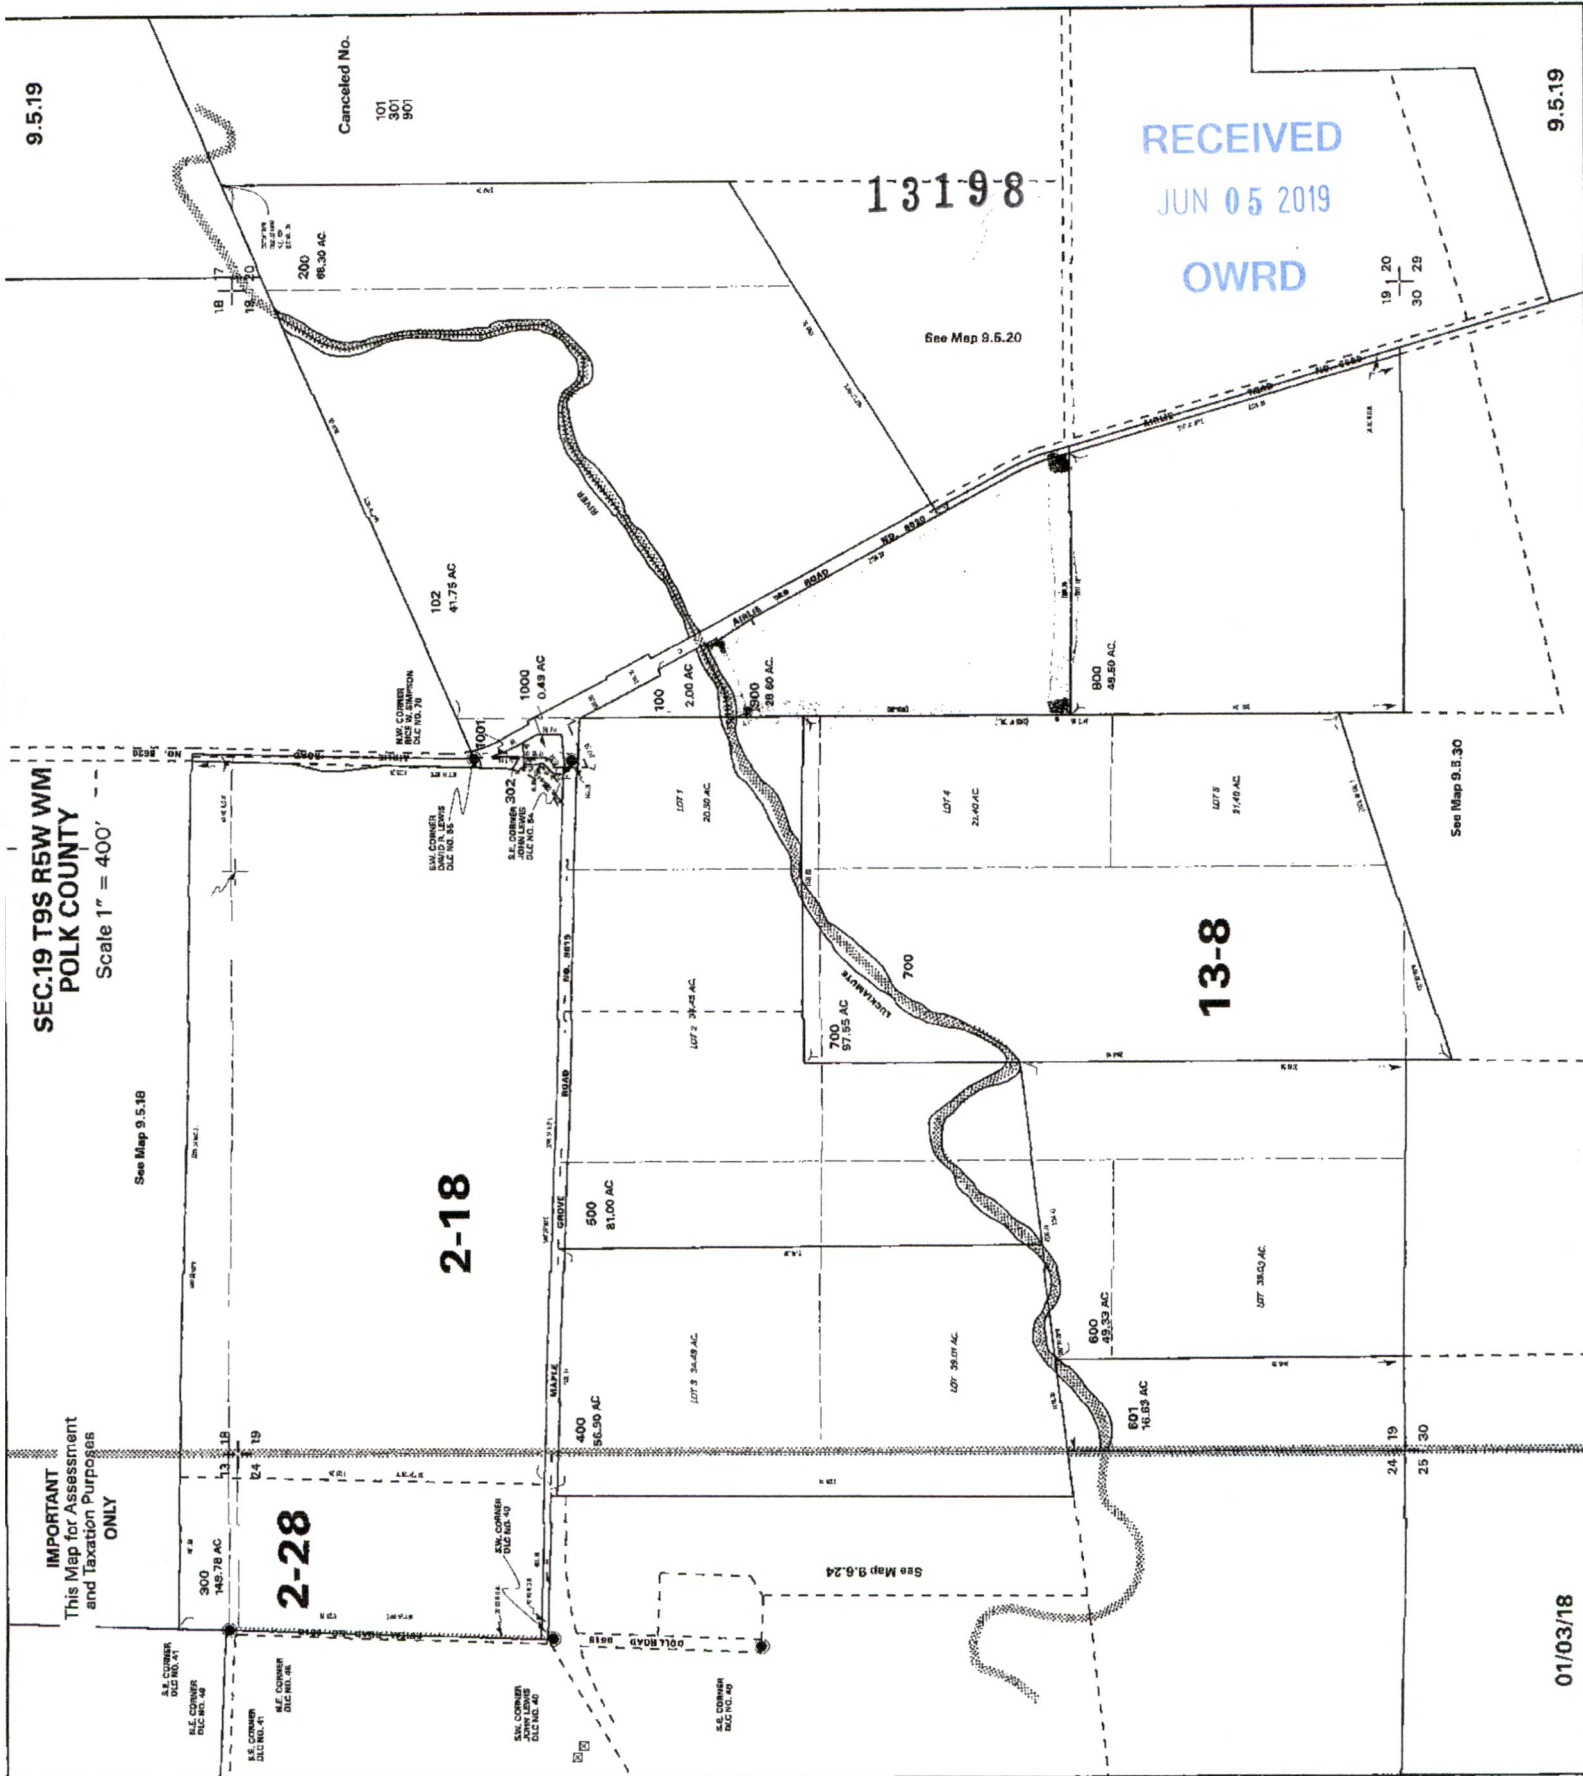

01/03/18


RECEIVED
 JUL 22 1980
 WATER RESOURCES DEPT.
 SALEM, OREGON

RECEIVED
 AUG 11 1980
 WATER RESOURCES DEPT.
 SALEM, OREGON

T-4569

Jerald Bush 2019 Temporary Transfer
 to Chris Horton

FROM Lands
 T. 10 S, R. 6 W, W.M.

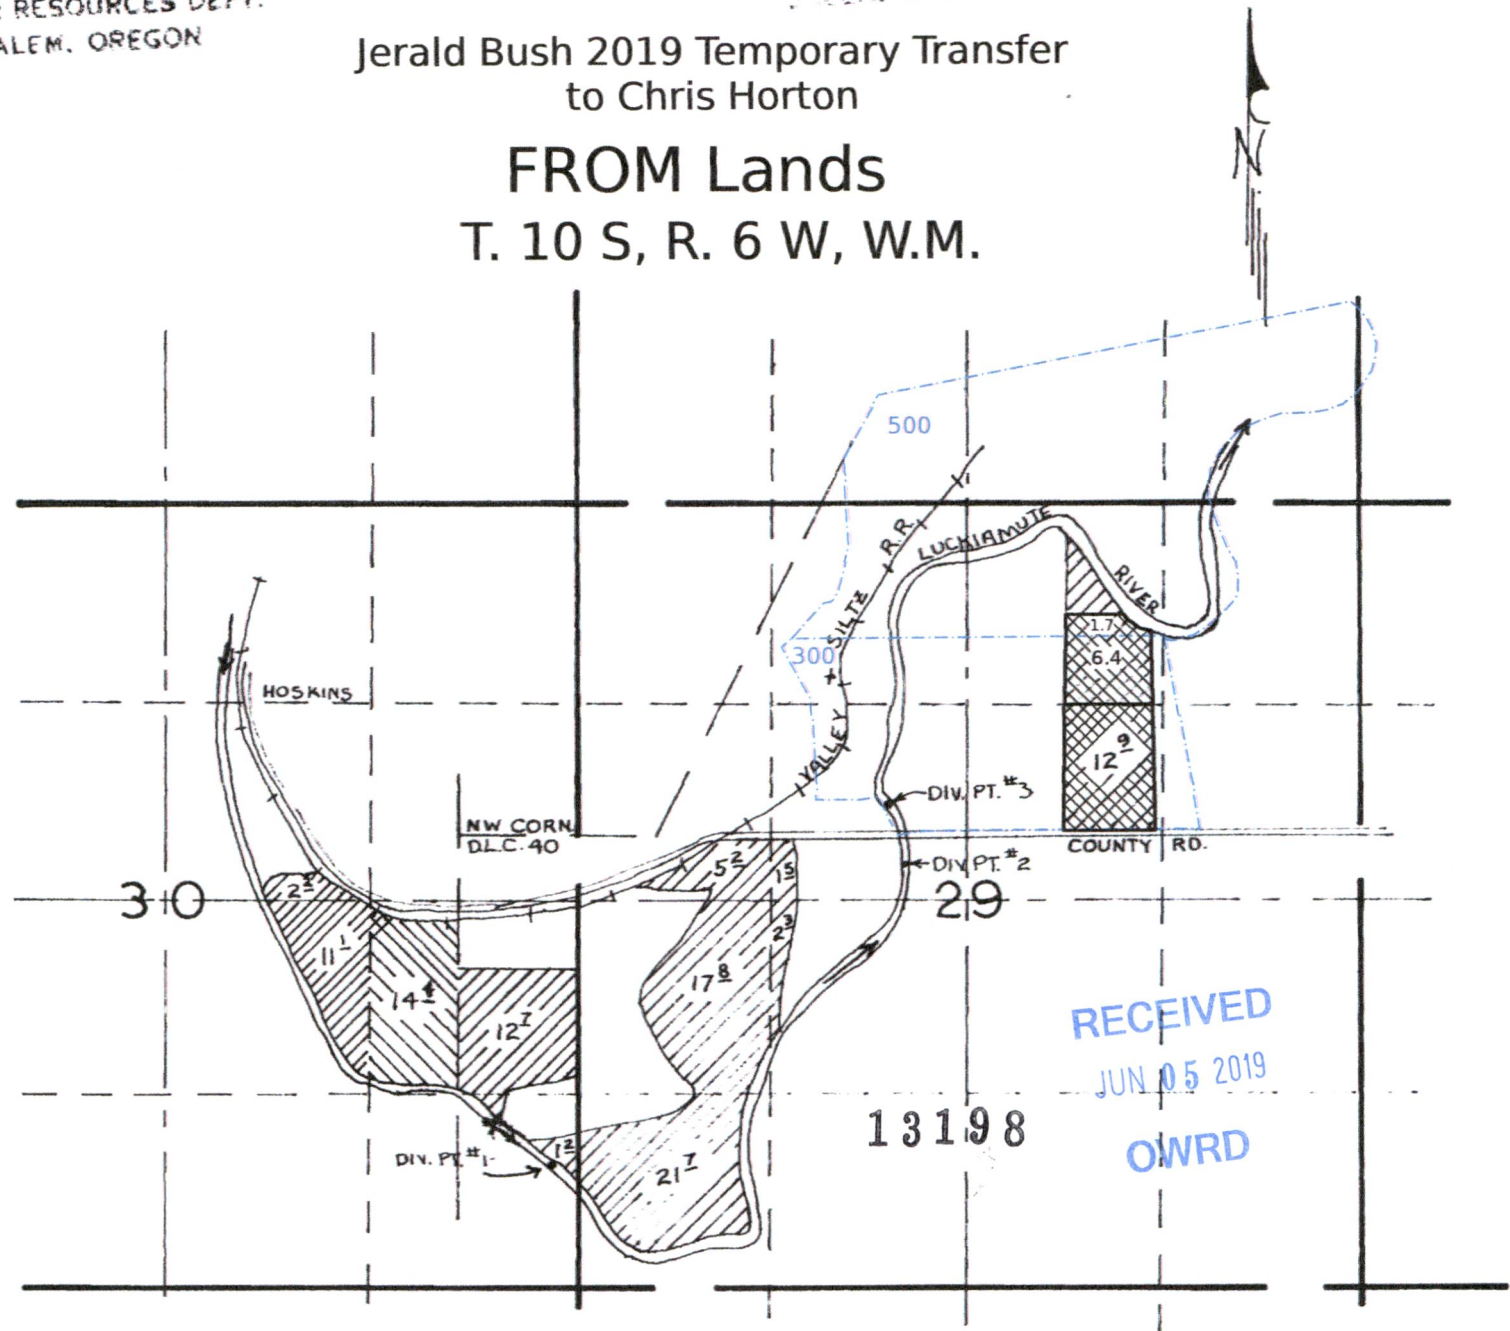

RECEIVED
 JUN 05 2019
 OWRD

Legend

-  **FROM Lands**
 All other lands are not part of this Temporary Transfer
-  **Tax Lot Boundry**

GRACEN L. BUSH

- Div. Pt. #1 - SE1/4 SE1/4, as projected within Watson DLC 40, Section 30, T. 10 S, R. 6 W, W.M.; 2200' S and 620' E from the NW Corner of Watson DLC 40.
- Div. Pt. #2 - SE1/4 NW1/4, as projected within Watson DLC 40, Section 29, T. 10 S, R. 6 W, W.M.; 170' S and 2940' E from the NW Corner of Watson DLC 40.
- Div. Pt. #3 - SE1/4 NW1/4, as projected within Allen DLC 42, Section 29, T. 10 S, R. 6 W, W.M.; 200' N and 2950' E from the NW Corner of Watson DLC 40.

scale: 4" = 1 Mile

JUN 05 2019

OWRD

9.5.20

Cancelled No.

See Map 9.5.21

9.5.20

SEC. 20 T9S R5W WM
POLK COUNTY

Scale 1" = 400'

2015-0004

13-8

2-18

IMPORTANT
This Map for Assessment
and Taxation Purposes
ONLY

See Map 8.5.19

See Map 9.5.30

01/03/18

