

RECEIVED

JUN 14 2019

OWRD
RECEIVED



JUL 08 2019


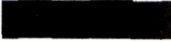

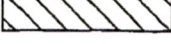
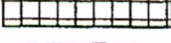
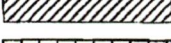






OWRD

Temporary Transfer Map for

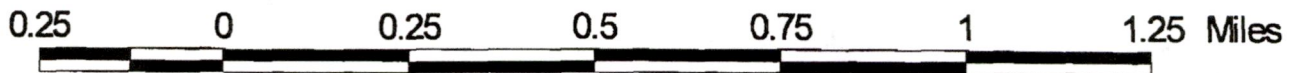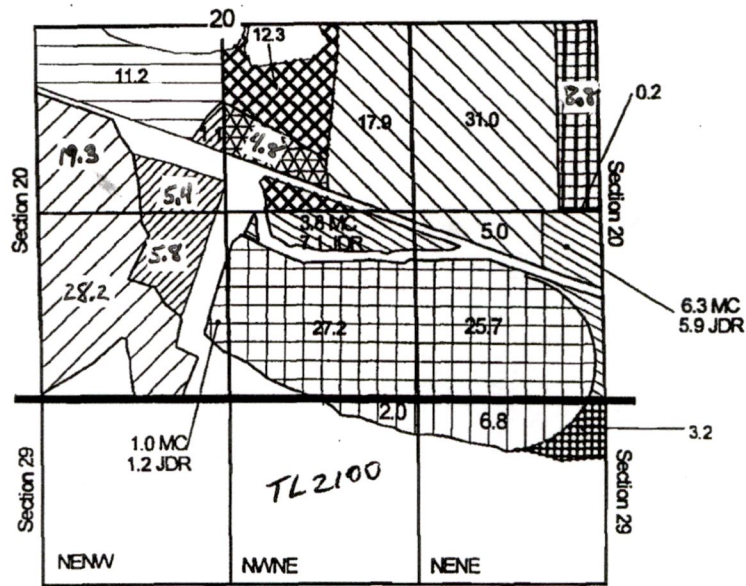Larry Lassen

Township 13 South, Range 29 East, W.M.

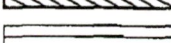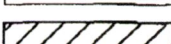

-  Existing C24921 John Day River 1865 Primary (Proposed C26025 Primary Moon Creek & C77607 John Day River 1916 Supplemental)
-  Existing C24921 John Day River 1865 Primary (Proposed C77607 John Day River 1916 Primary)
-  Existing C24921 John Day River 1865 Primary (Proposed C24923 Primary Dustin/Picnic Creeks & C77607 John Day River 1916 Supplemental)
-  Existing C24921 JDR 1865 Primary (Proposed C24922 MC 1872 Primary & C77607 JDR 1916 Supplemental)
-  Existing C24922 MC 1872 Primary & C77607 JDR 1916 Supplemental (Proposed C24921 JDR 1865)
-  Existing C24923 Dustin/Picnic Creek 1882 Primary & Existing C77607 JDR 1916 Supplemental (Proposed C24921 JDR 1865)
-  Existing C26025 MC 1895 Primary & C77607 JDR 1916 Supplemental (Proposed C24921 JDR 1865)
-  Remaining Right C24921 JDR 1865 Primary
-  Remaining Right C24922 MC 1872 Primary & Remaining Right C77607 JDR 1916 Supplemental & Primary
-  Remaining Rights C24923 Dustin Creek/Picnic Creek 1882 Primary & C77607 JDR 1916 Supplemental
-  Remaining Right C24923 Dunston/Picnic Creek 1882 Primary
-  Remaining Right C26025 Moon Creek 1895 Primary & C77607 Supplemental

13217

Larry Lassen

Temporary Transfer

Legend

8/19/2016 Photo

RECEIVED

JUN 27 2019

OWRD

13217

Google Earth



2000 ft

Larry Lassen

Temporary Transfer

Legend

7/7/2013 Photo

RECEIVED
JUN 14 2019
OWRD

RECEIVED
JUL 08 2019
OWRD

13217



2000 ft

Google Earth

Image © USDA Farm Service Agency

Larry Lassen

Temporary Transfer

Legend

RECEIVED
JUL 08 2019
OWRD

8/19/2016 Photo

RECEIVED
JUN 14 2019
OWRD

13217

Google Earth

2000 ft

