


Tumalo Irrigation District


Claim of Beneficial Use - T11701

N13.001

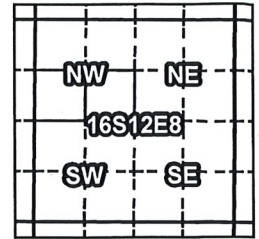

Certificates: 74146 (IR), 76106 (IR)

for Frederick & Mary C. Selleck Trust

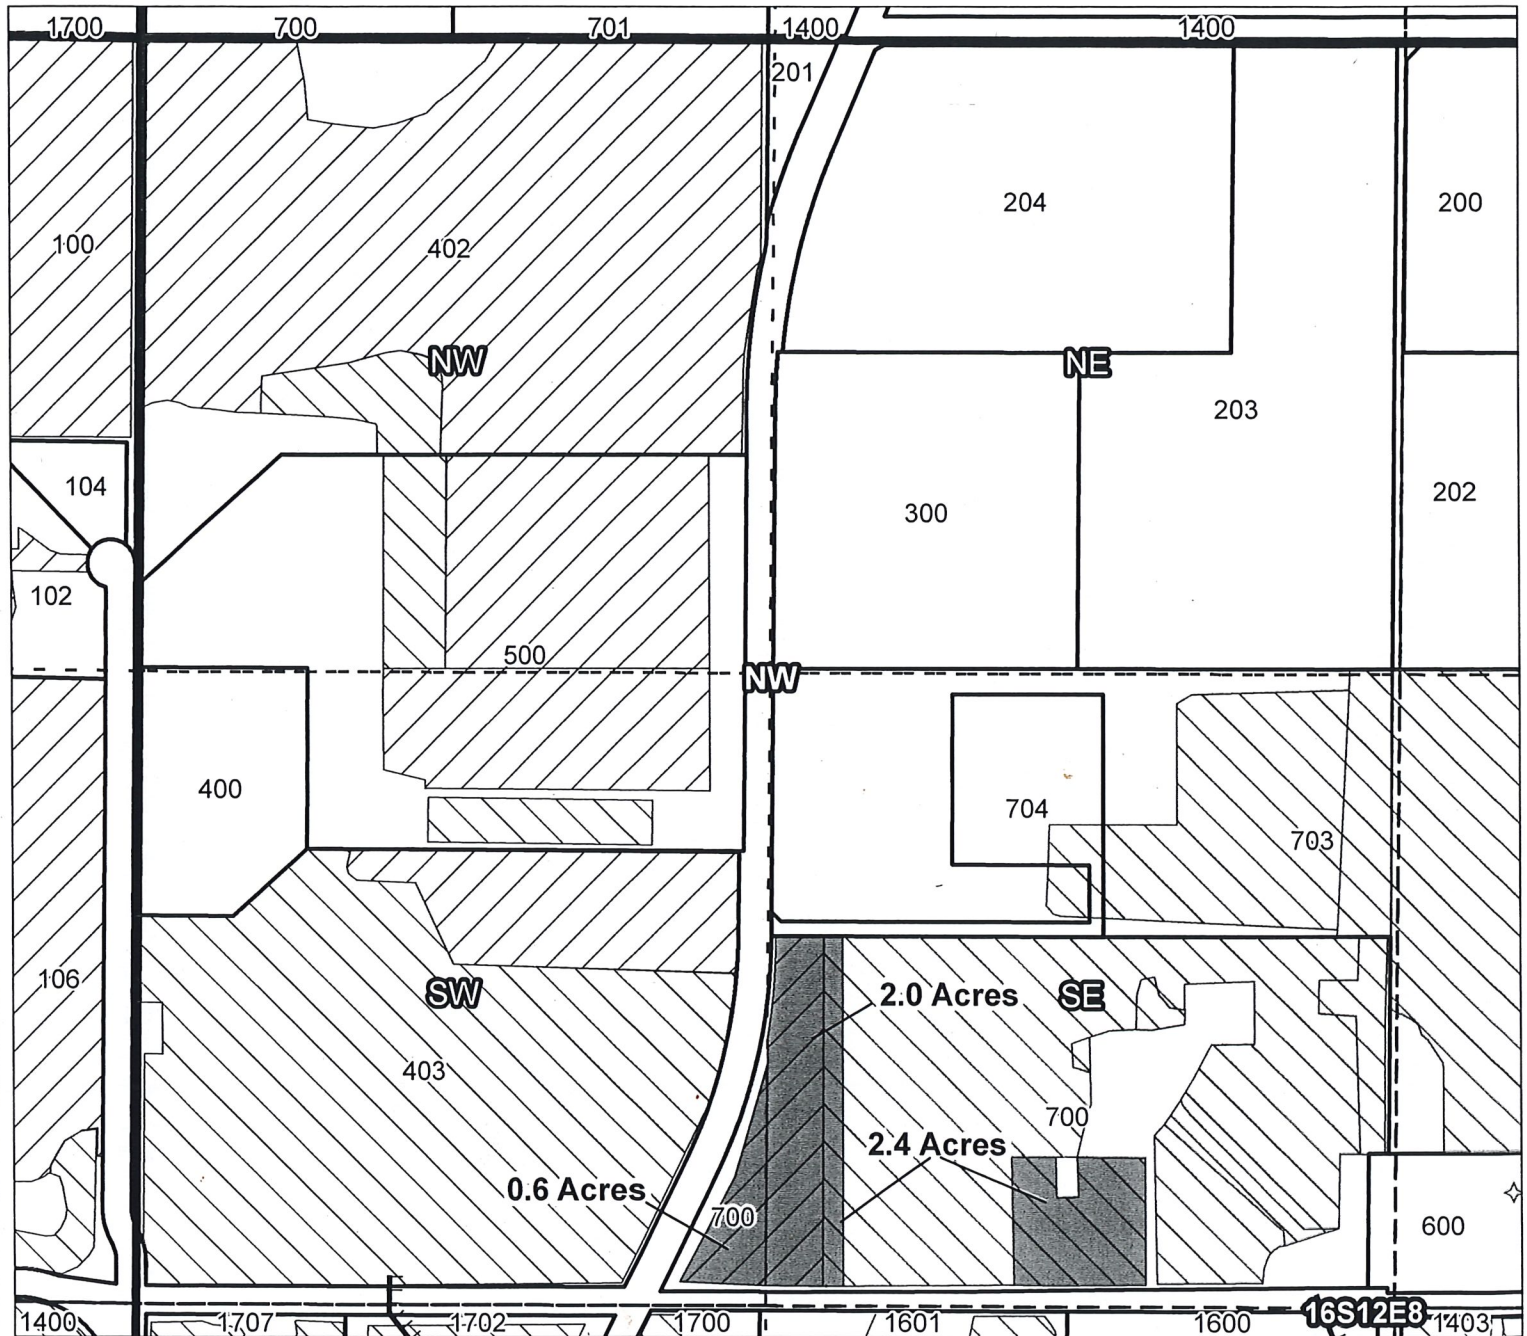

Taxlot 700, 16S12E8SE: 2.4 Acres ON (74146)
 Taxlot 700, 16S12E8SE: 2.0 Acres ON (76106) *CW-9*
 Taxlot 700, 16S12E8SW: 0.6 Acres ON (76106) *CW-9*

RECEIVED BY OWRD

74146 (P); 74147, 74148, 74149, 76520 (S) *EB 25 2016*

*
 *
 74146 (76106 CW-9) (P); 74148, 74149, 76520 (S) *SALEM, OR*

- Canals
- Taxlots
- Rights to Transfer
- Cert 74146, 74147
- Cert 76106
- All Other Certs




1 inch = 400 feet


Tumalo Irrigation District

Claim of Beneficial Use - T11701

N13.002

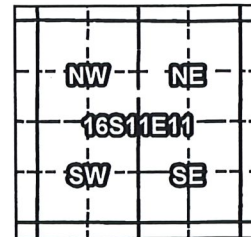

Certificates: 74146 (IR), 74147 (IR),
for Daniel Smithey & Juantina Edwards

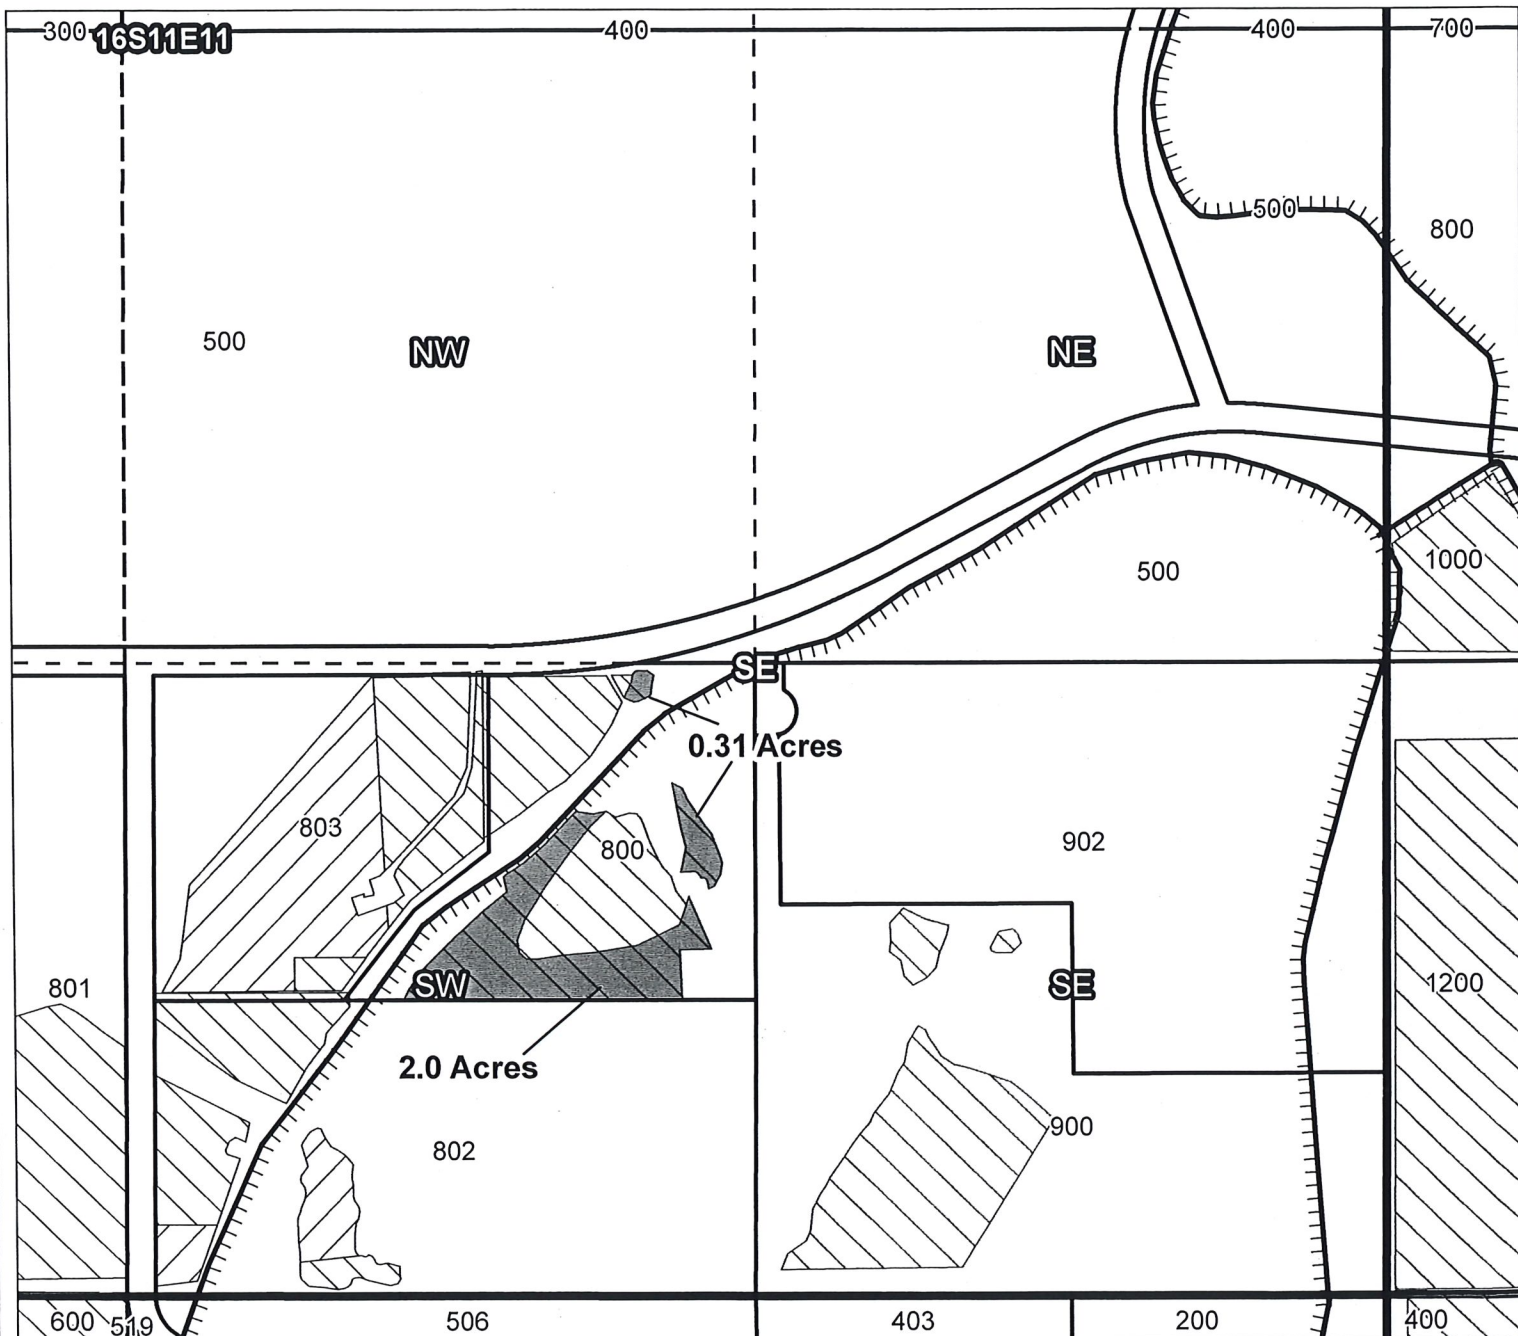

Taxlot 800, 16S11E11SWSE: 2.0 Acres ON (74146)
Taxlot 800, 16S11E11SWSE: 0.31 Acres ON (74147)

- Canals
- Taxlots
- Rights to Transfer
- Cert 74146, 74147
- Cert 76106
- All Other Certs

74146 (P); 74147, 74148, 74149, 76520 (S)
*

74147 (P); 74148, 74149, 76520 (S)
*

RECEIVED BY OWRD

FEB 25 2016

SALEM, OR




1 inch = 400 feet

Prepared by FireWhat Inc. | January 2016


Tumalo Irrigation District

Claim of Beneficial Use - T11701

N12 003

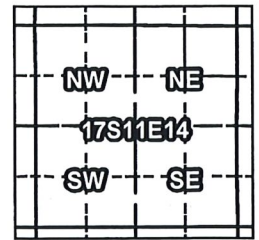

Certificates: 74146 (P); 74147, 74148, 74149, 76520 (S)
for Lance & Janell Julander

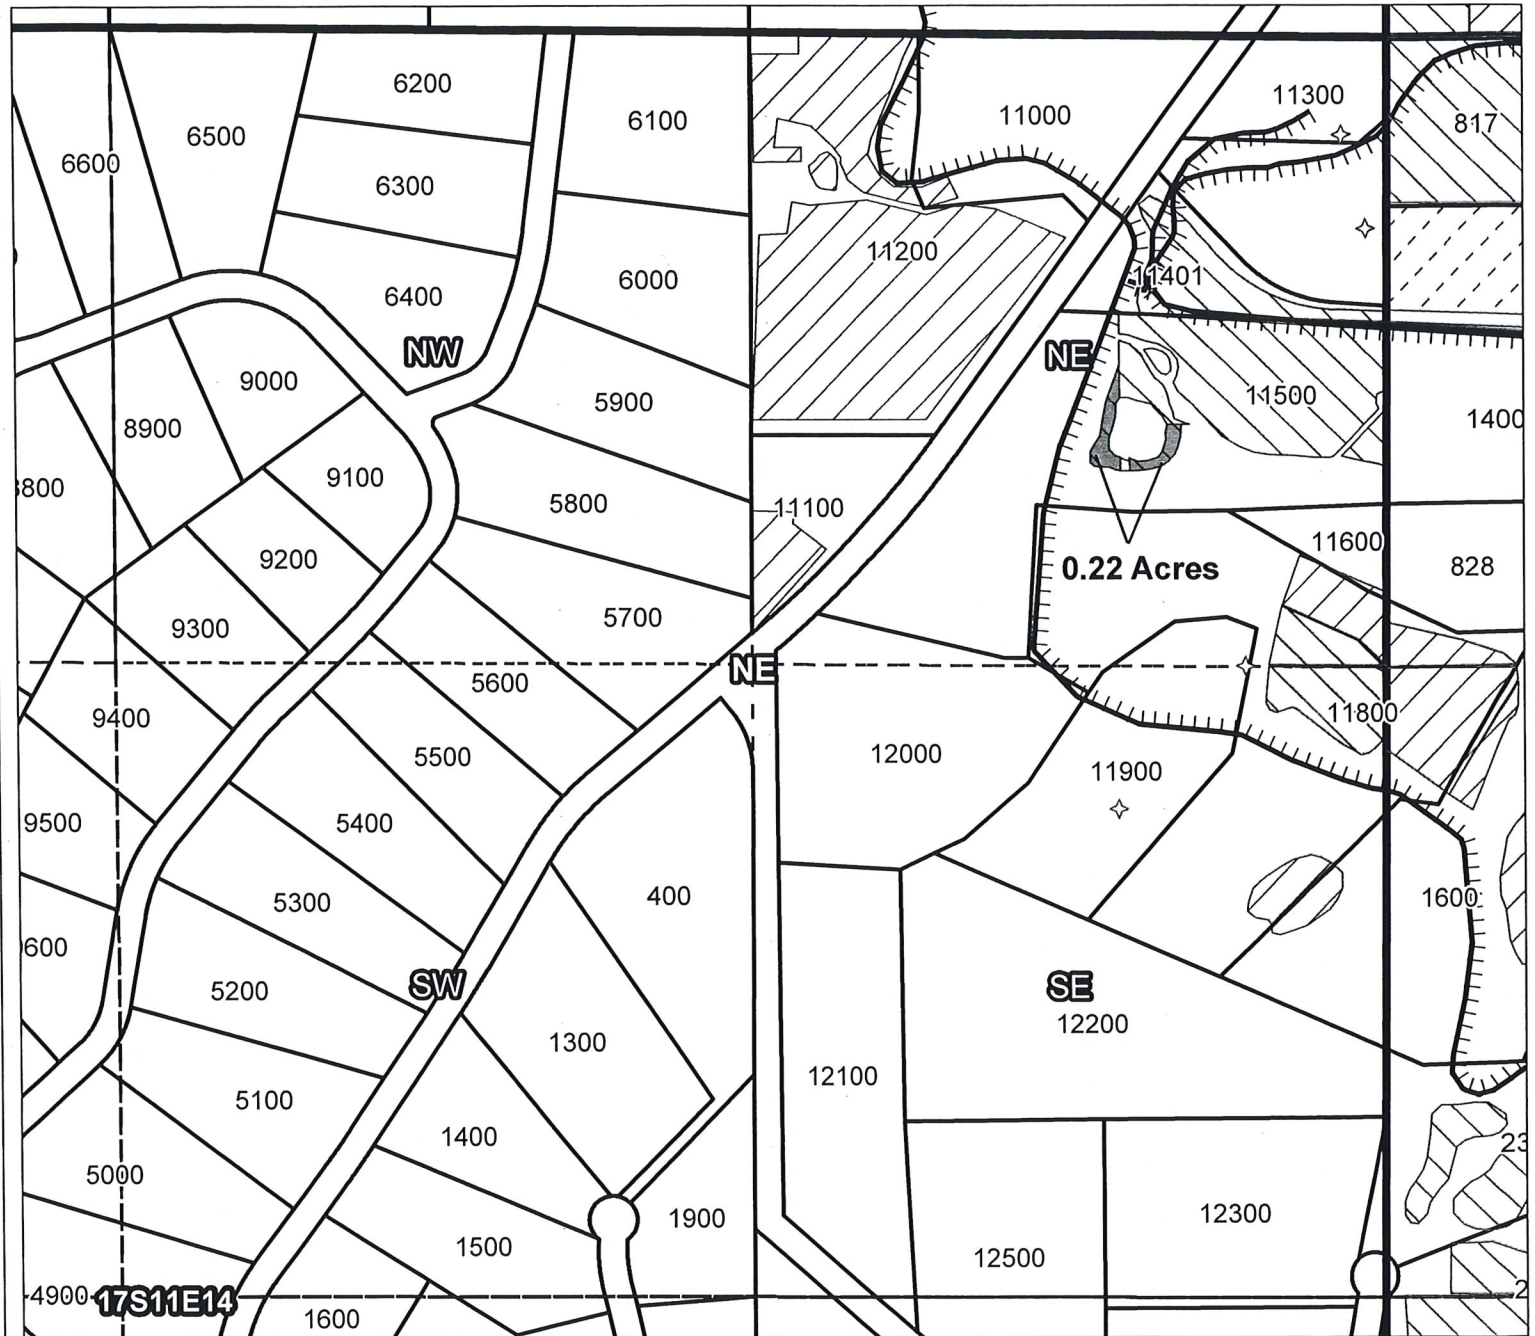

Taxlot 11500, 17S11E14NENE: 0.22 Acres ON (74146)

RECEIVED BY OWRD
FEB 25 2016
SALEM, OR

- Canals
- Taxlots
- Rights to Transfer
- Cert 74146, 74147
- Cert 76106
- All Other Certs




1 inch = 400 feet


Tumalo Irrigation District

Claim of Beneficial Use - T11701

N13.003

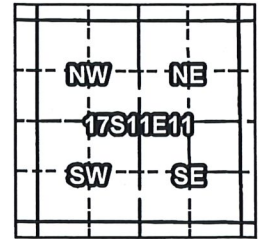

Certificates: 74146 (P); 74147, 74148, 74149, 76520 (S)
 for David & Oksana rosenburg

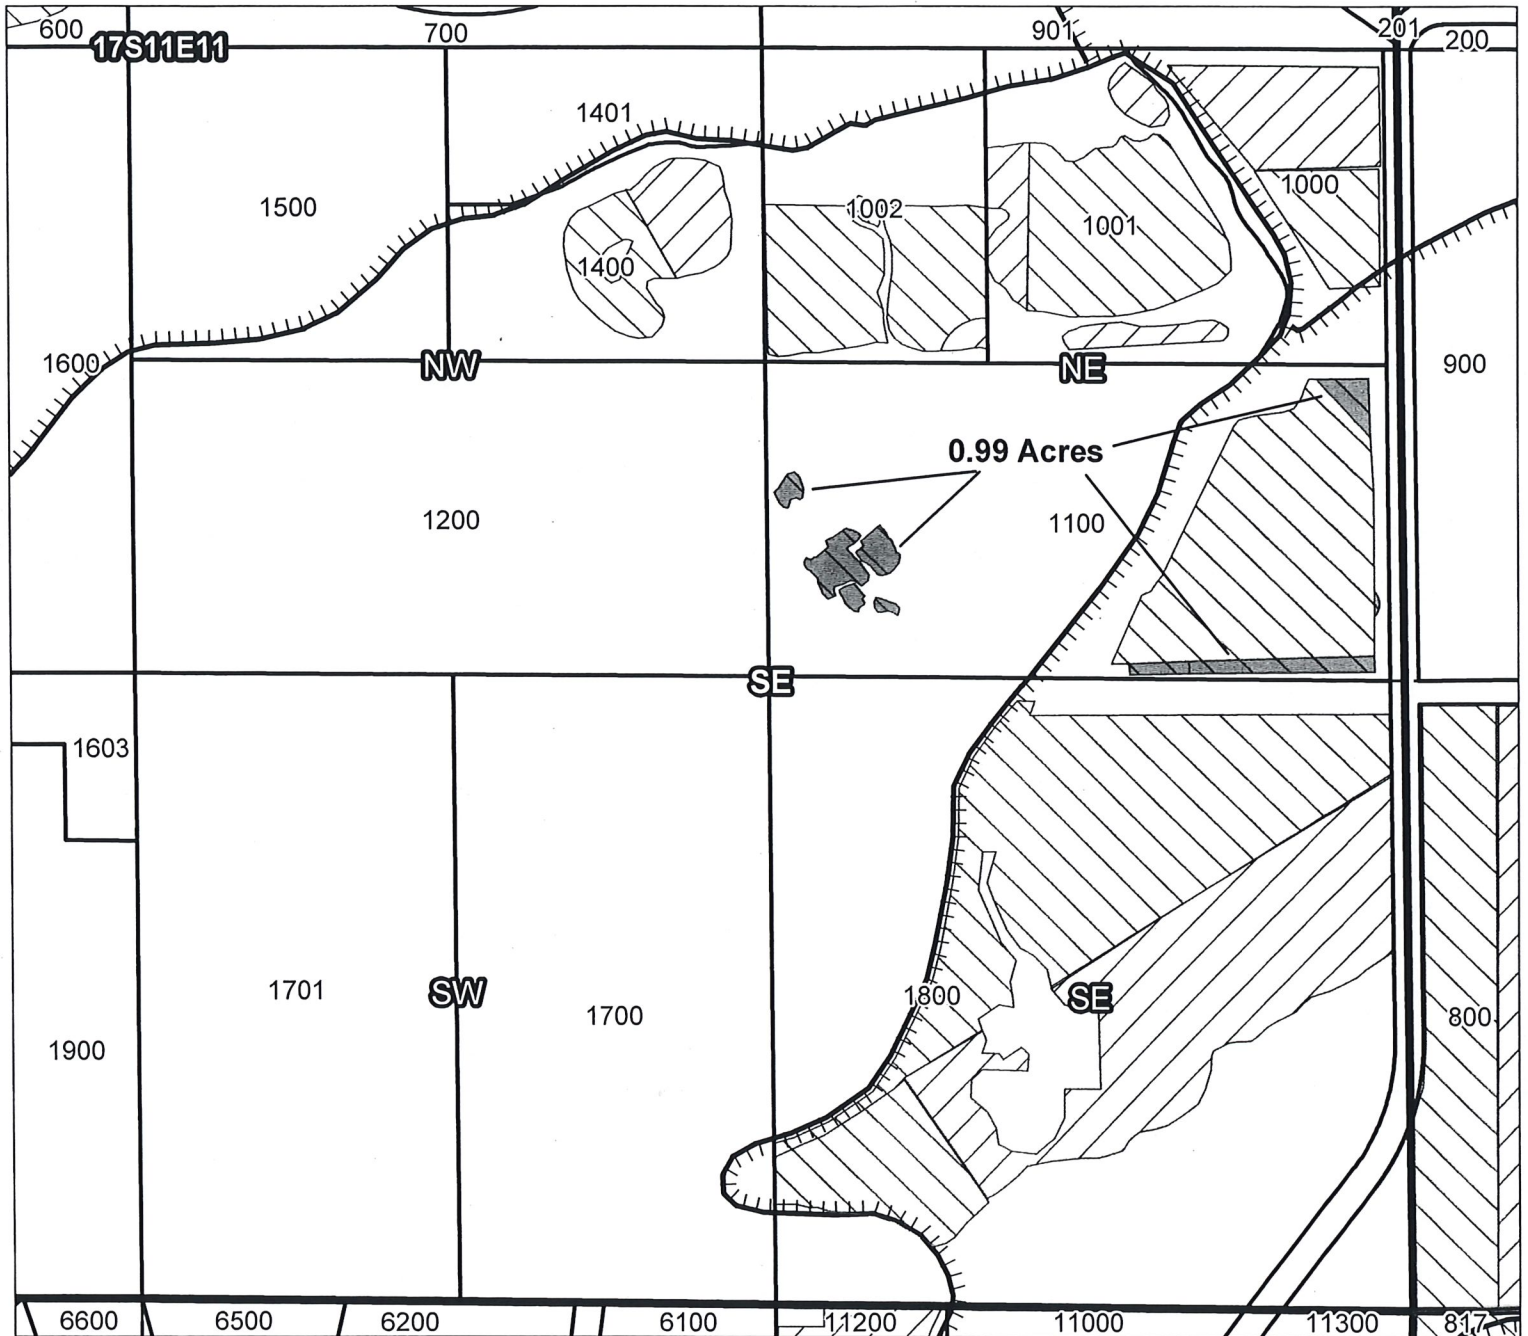

Taxlot 1100, 17S11E11NESE: 0.99 Acres ON (74146)

RECEIVED BY OWRD

FEB 25 2016

SALEM, OR

- Canals
- Taxlots
- Rights to Transfer
- Cert 74146, 74147
- Cert 76106
- All Other Certs




1 inch = 400 feet

Prepared by FireWhat Inc. | January 2016


Tumalo Irrigation District

Claim of Beneficial Use - T11701

N13.004

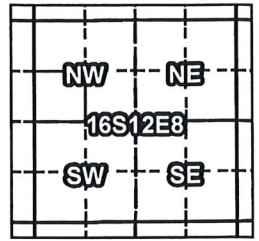

Certificates: * 74146 (P); 74147, 74148, 74149, 76520 (S)
for Ryan & Debbie Fred

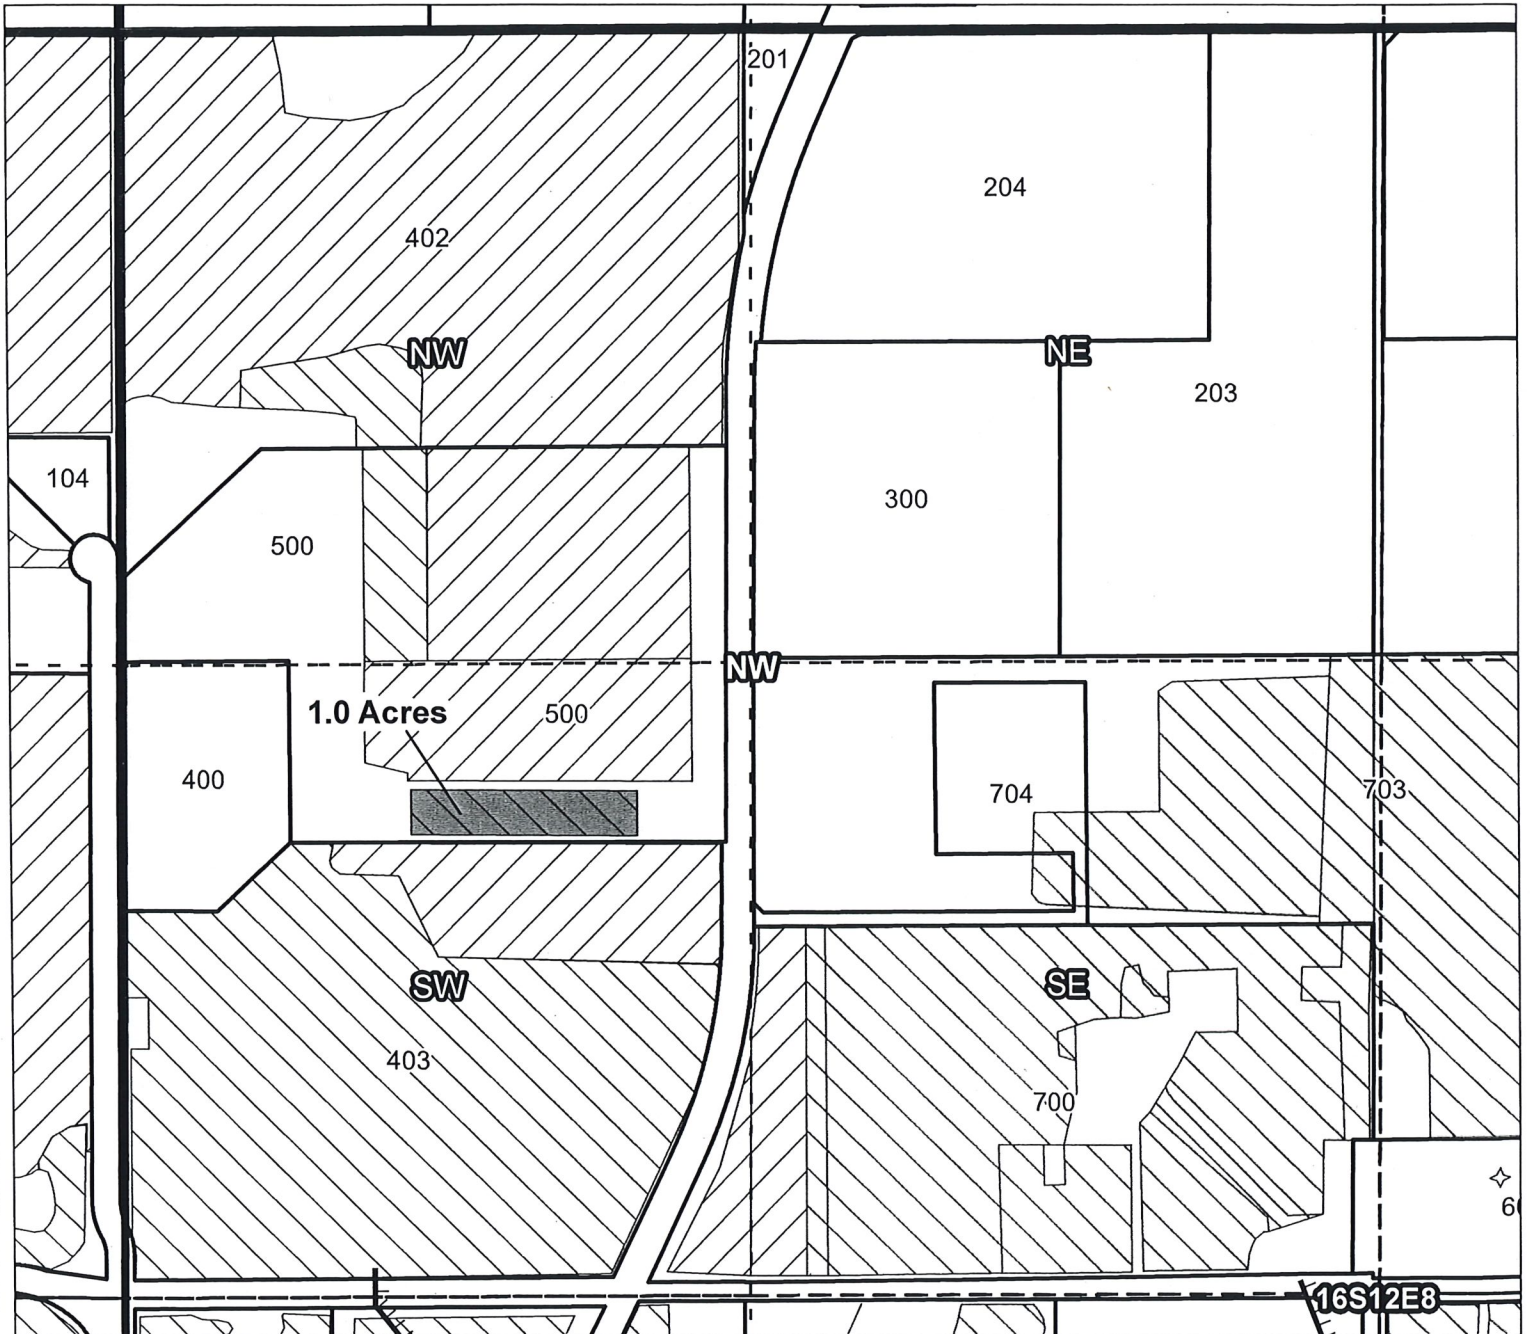

Taxlot 500, 16S12E8SWNW: 1.0 Acres ON (74146)

RECEIVED BY OWRD

FEB 25 2016

SALEM, OR

-  Canals
-  Taxlots
-  Rights to Transfer
-  Cert 74146, 74147
-  Cert 76106
-  All Other Certs




1 inch = 400 feet


Tumalo Irrigation District

Claim of Beneficial Use - T11701

N13.005

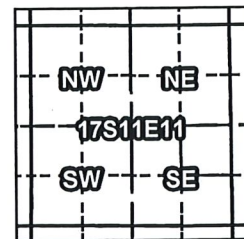

Certificates: 74146 (IR), 76106 (IR)
for James & Roberta Shannon

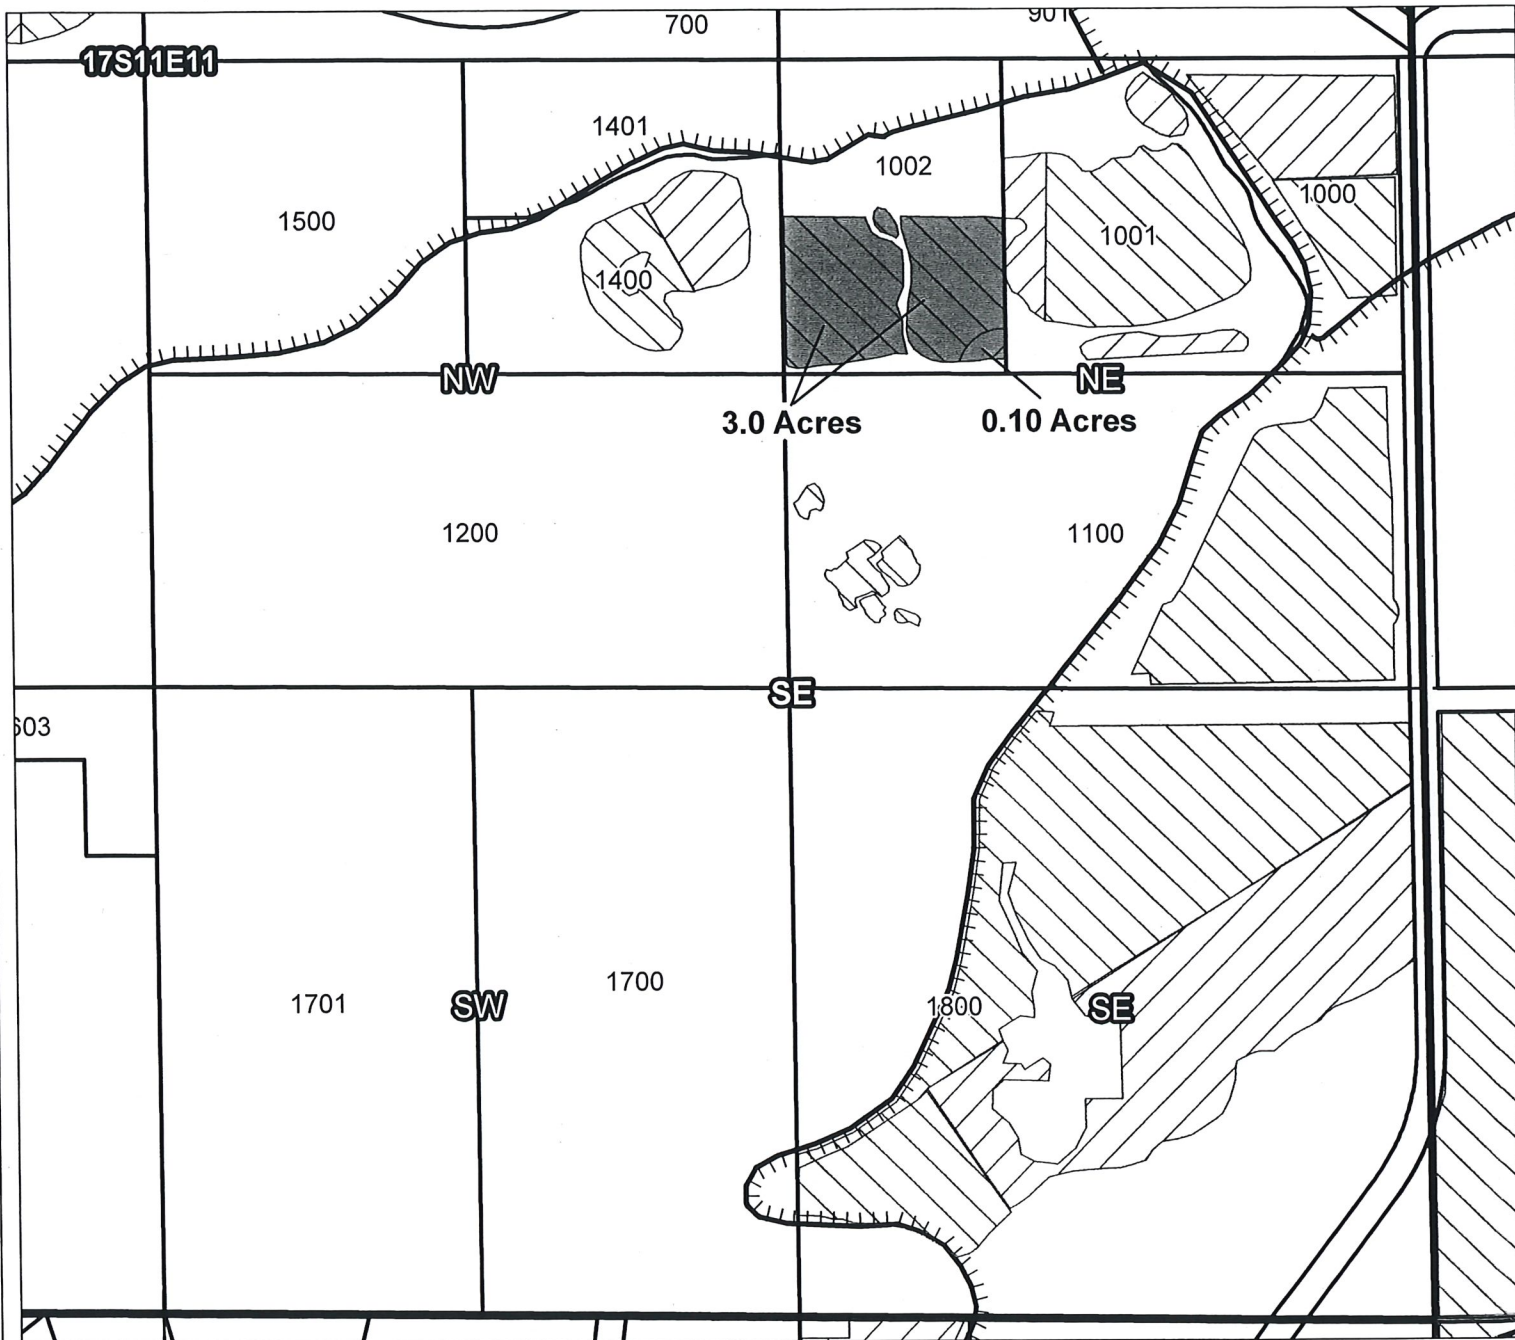

Taxlot 1002, 17S11E11NESE: 3.0 Acres ON (74146)
Taxlot 1002, 17S11E11NESE: 0.10 Acres ON (76106)

74146 (P); 74147, 74148, 74149, 76520 (S)

*

74146 (76106 CW-9) (P); 74148, 74149, 76520 (S)

RECEIVED BY OWRD

FEB 25 2016

SALEM, OR

- Canals
- Taxlots
- Rights to Transfer
- Cert 74146, 74147
- Cert 76106
- All Other Certs




1 inch = 400 feet


Tumalo Irrigation District

Claim of Beneficial Use - T11701

N13,006

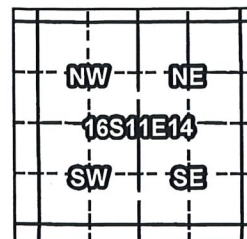

Certificates * 74146 (P); 74147, 74148, 74149, 76520 (S)
for Paul & Ellen Wagner

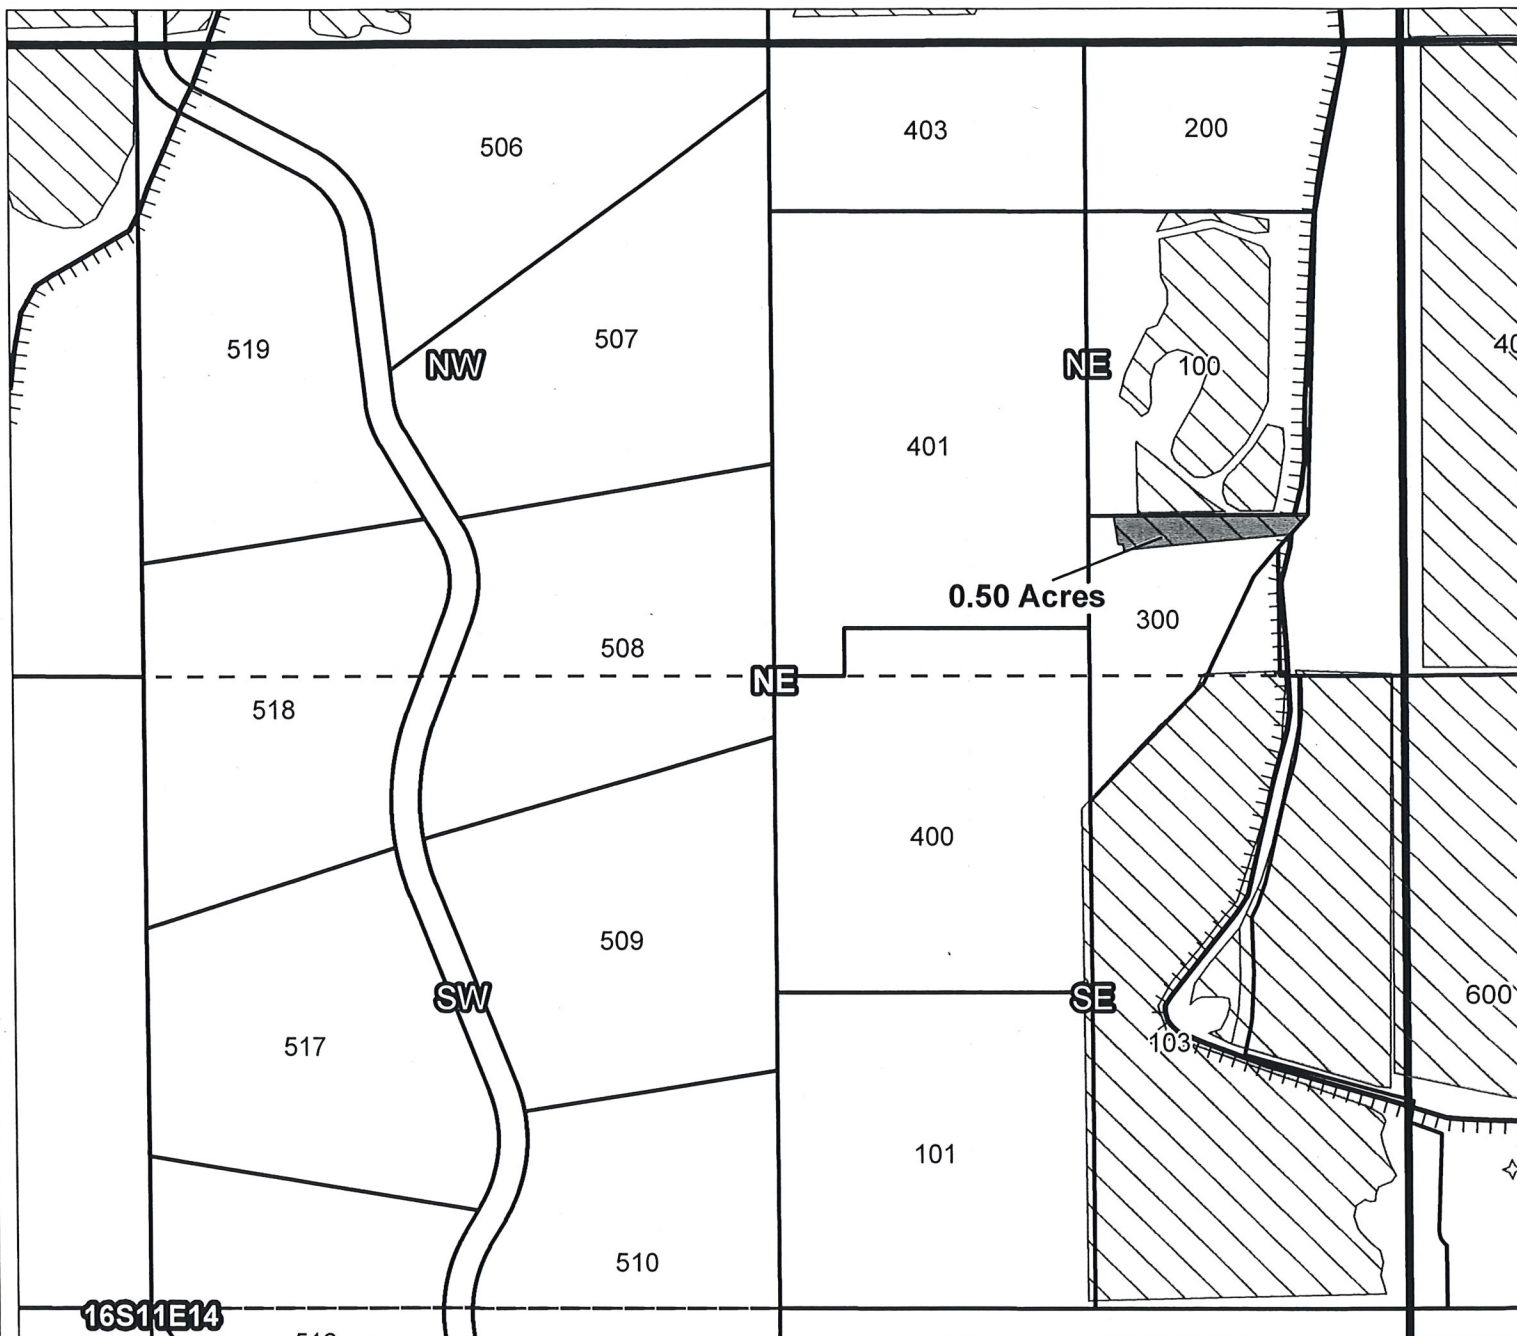

Taxlot 300, 16S11E14NENE: 0.50 Acres ON (74146)

RECEIVED BY OWRD

FEB 25 2016

SALEM, OR

- Canals
- Taxlots
- Rights to Transfer
- Cert 74146, 74147
- Cert 76106
- All Other Certs



1 inch = 400 feet