

DESCHUTES COUNTY
SEC.09 T14S R13E

SCALE - 1" = 400'




SE 1/4 OF THE SW 1/4

RECEIVED

JUN 20 2019

OWRD

OWRD #: T-12231

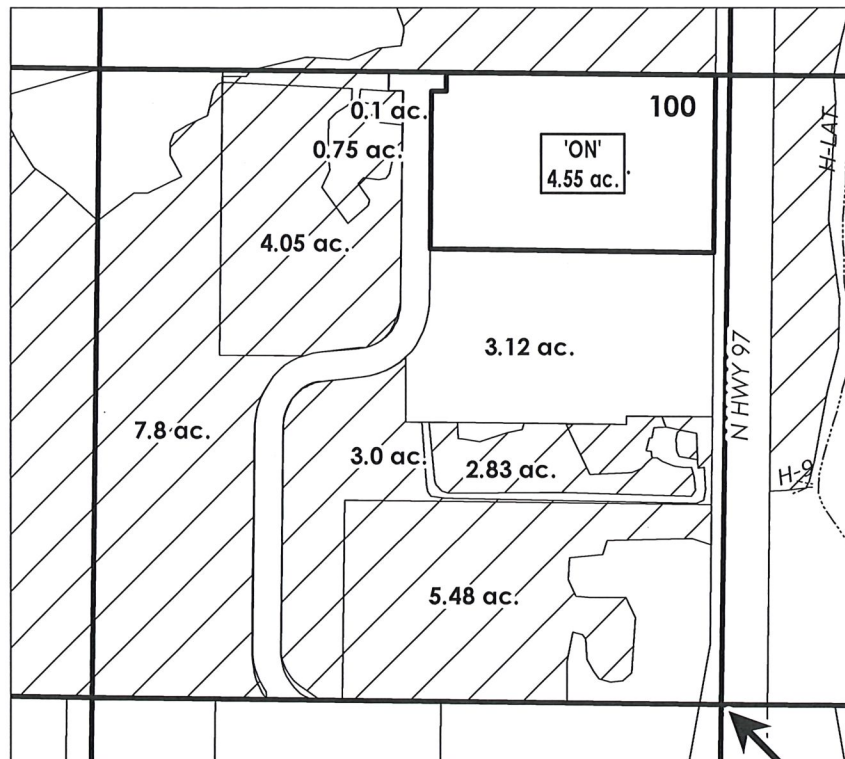

	EXISTING WATER RIGHTS
	'ON' LAND PARCELS
	PARCELS W/ WATER RIGHTS



FINAL PROOF MAP

NAME: Bolken, Olaf Torfinn/Michelle

TAXLOT #: 100

4.55 ACRES

Date: 06/13/2019

FILE: I:\TRANSFER\FINALPRF\P-201X-XXX\TRS_QQ

DESCHUTES COUNTY
SEC.09 T14S R13E

SCALE - 1" = 400'

RECEIVED


JUN 20 2019

OWRD



SE 1/4 OF THE SW 1/4

OWRD #: T-12231

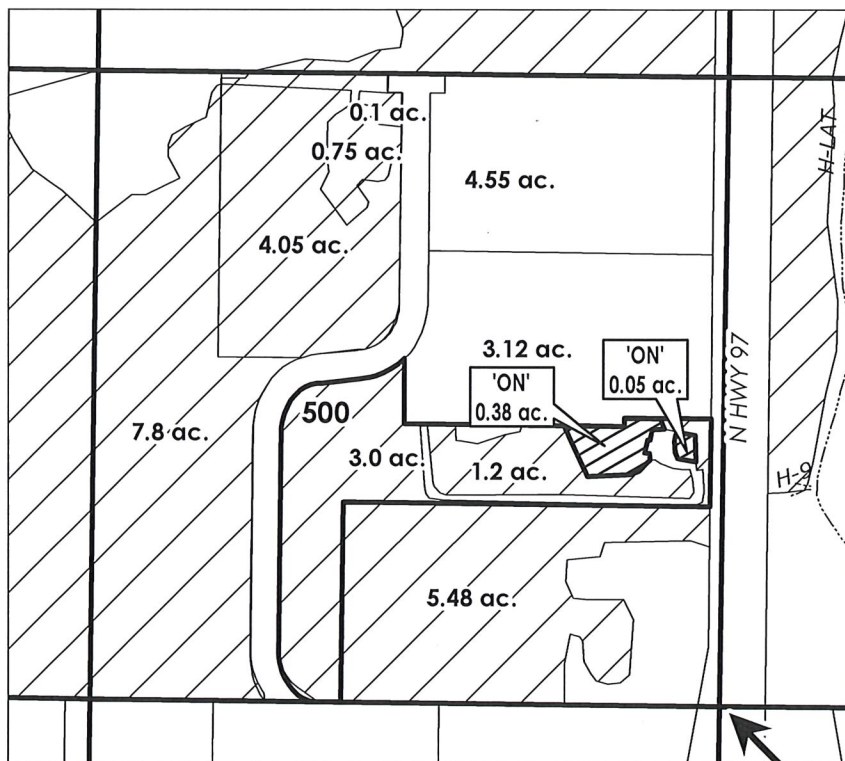

C 1/4 COR

	EXISTING WATER RIGHTS
	ON LANDS
# ac.	PARCELS W/ WATER RIGHTS



FINAL PROOF MAP

NAME: Hamlin, Brian/Sarah

TAXLOT #: 500

0.43 ACRES

Date: 06/13/2019

FILE: I:\TRANSFER\FINALPRF\P-201X-XXX\TRS_QQ

DESCHUTES COUNTY
SEC.18 T17S R13E


RECEIVED
JUN 20 2019
OWRD



SCALE - 1" = 400'




SE 1/4 OF THE SW 1/4

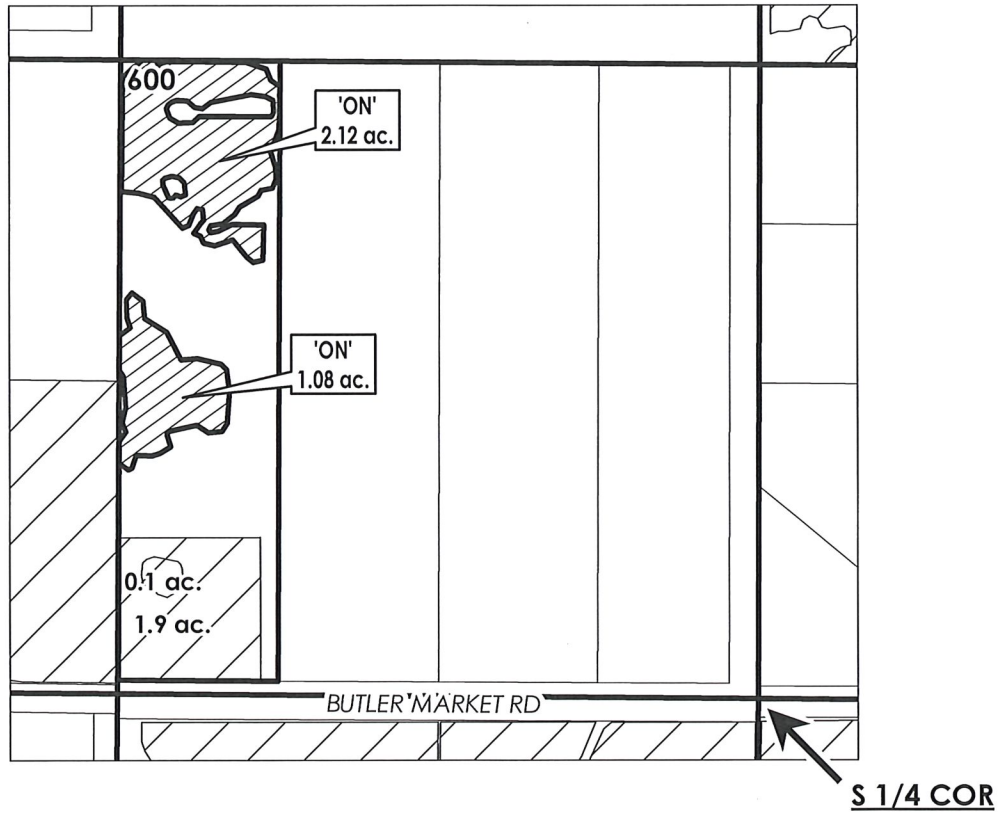OWRD #: T-12231



	EXISTING WATER RIGHTS
	'ON' LANDS

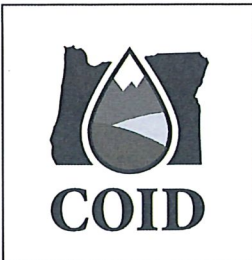

FINAL PROOF MAP

NAME: Turley, Brandon

TAXLOT #: 600

3.2 ACRES

Date: 06/14/2019

FILE: I:\TRANSFER\FINALPRF\P-201X-XXX\TRS_QQ

DESCHUTES COUNTY
SEC.31 T17S R13E


RECEIVED
JUN 20 2019
OWRD

SCALE - 1" = 400'




NE 1/4 OF THE NE 1/4

OWRD #: T-12231

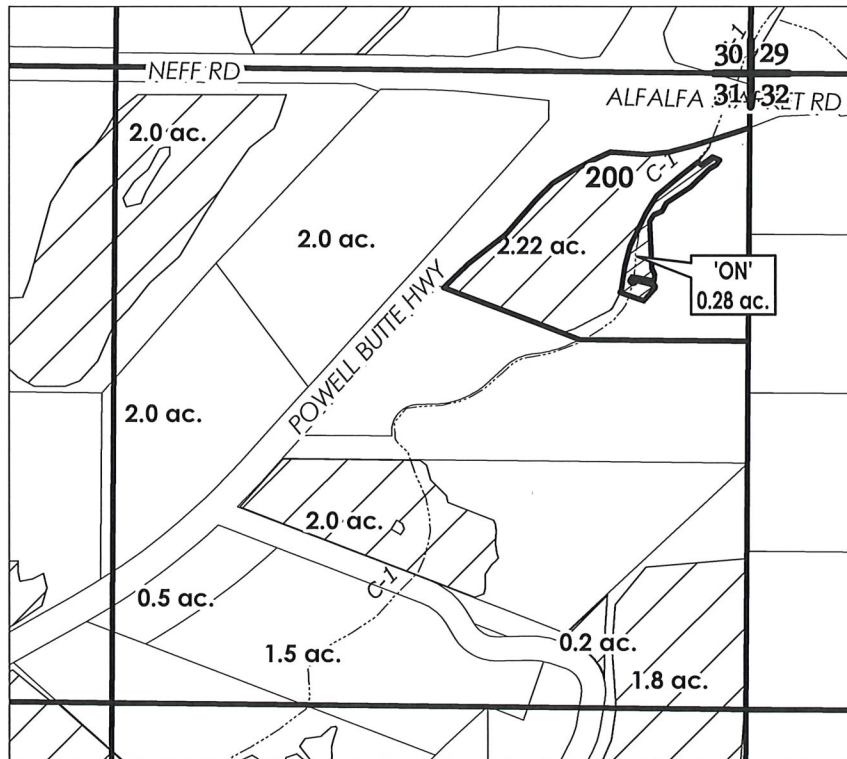

	EXISTING WATER RIGHTS
	'ON' LAND PARCELS
	PARCELS W/ WATER RIGHTS

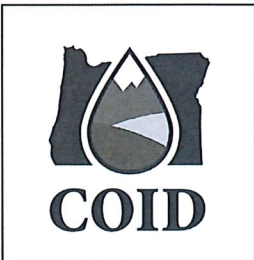

FINAL PROOF MAP

NAME: Bischoff, Chris & Marcia

TAXLOT #: 200

0.28 ACRES

Date: 06/13/2019

FILE: I:\TRANSFER\FINALPRF\P-201X-XXX\TRS_QQ

DESCHUTES COUNTY
SEC.33 T17S R14E

RECEIVED

JUN 20 2019


OWRD

SCALE - 1" = 400'



SE 1/4 OF THE NW 1/4; SW 1/4 OF THE NE 1/4

OWRD #: T-12231

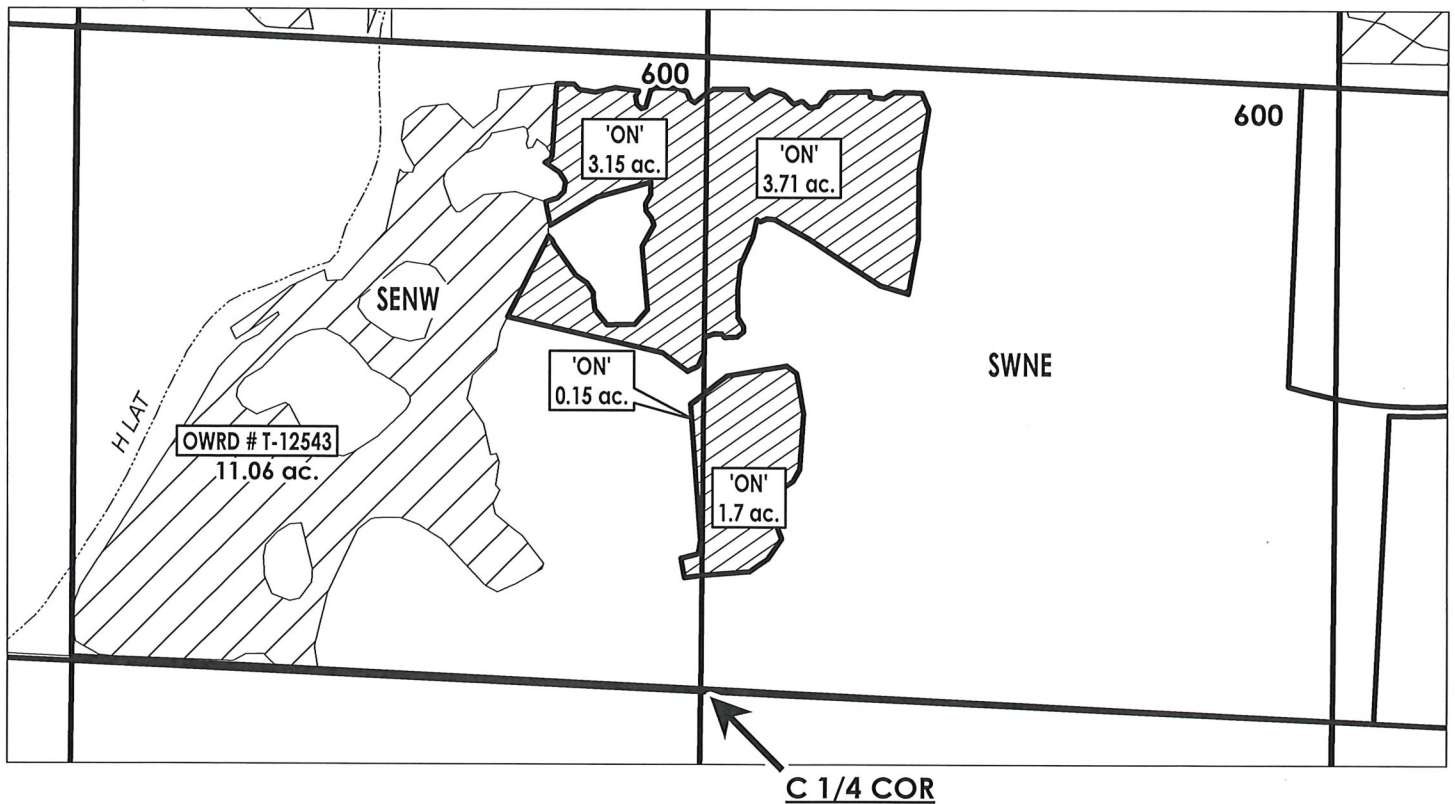

	WATER RIGHTS
	'ON' LANDS



FINAL PROOF MAP

NAME: 80 Acres, LLC

TAXLOT #: 600

8.71 ACRES

Date: 06/14/2019

FILE: I:\TRANSFER\FINALPRF\P-201X-XXX\TRS_QQ

DESCHUTES COUNTY
SEC.07 T18S R14E

RECEIVED

JUN 20 2019


OWRD

SCALE - 1" = 400'



SE 1/4 OF THE NW 1/4

OWRD #: T-12231

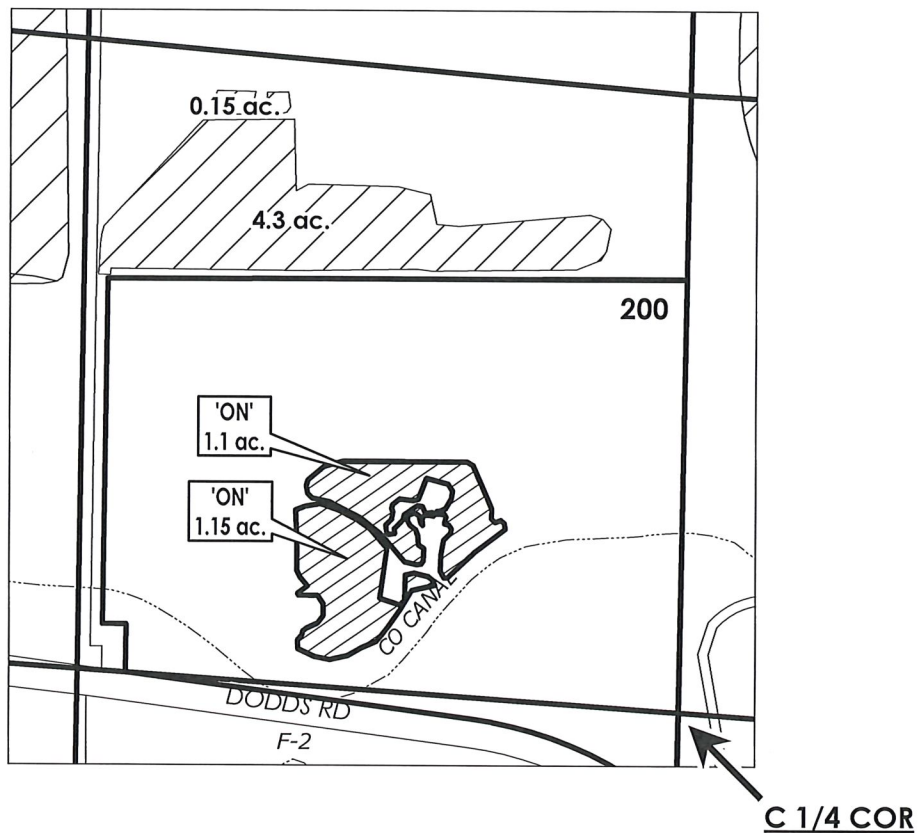

	EXISTING WATER RIGHTS
	'ON' LANDS



FINAL PROOF MAP

NAME: Swan, J. David

TAXLOT #: 200

2.25 ACRES

Date: 06/14/2019

FILE: I:\TRANSFER\FINALPRF\P-201X-XXX\TRS_QQ