


ISCC Nursery - GR 1535 - Groundwater Registration Modification - FROM

T5S, R1W

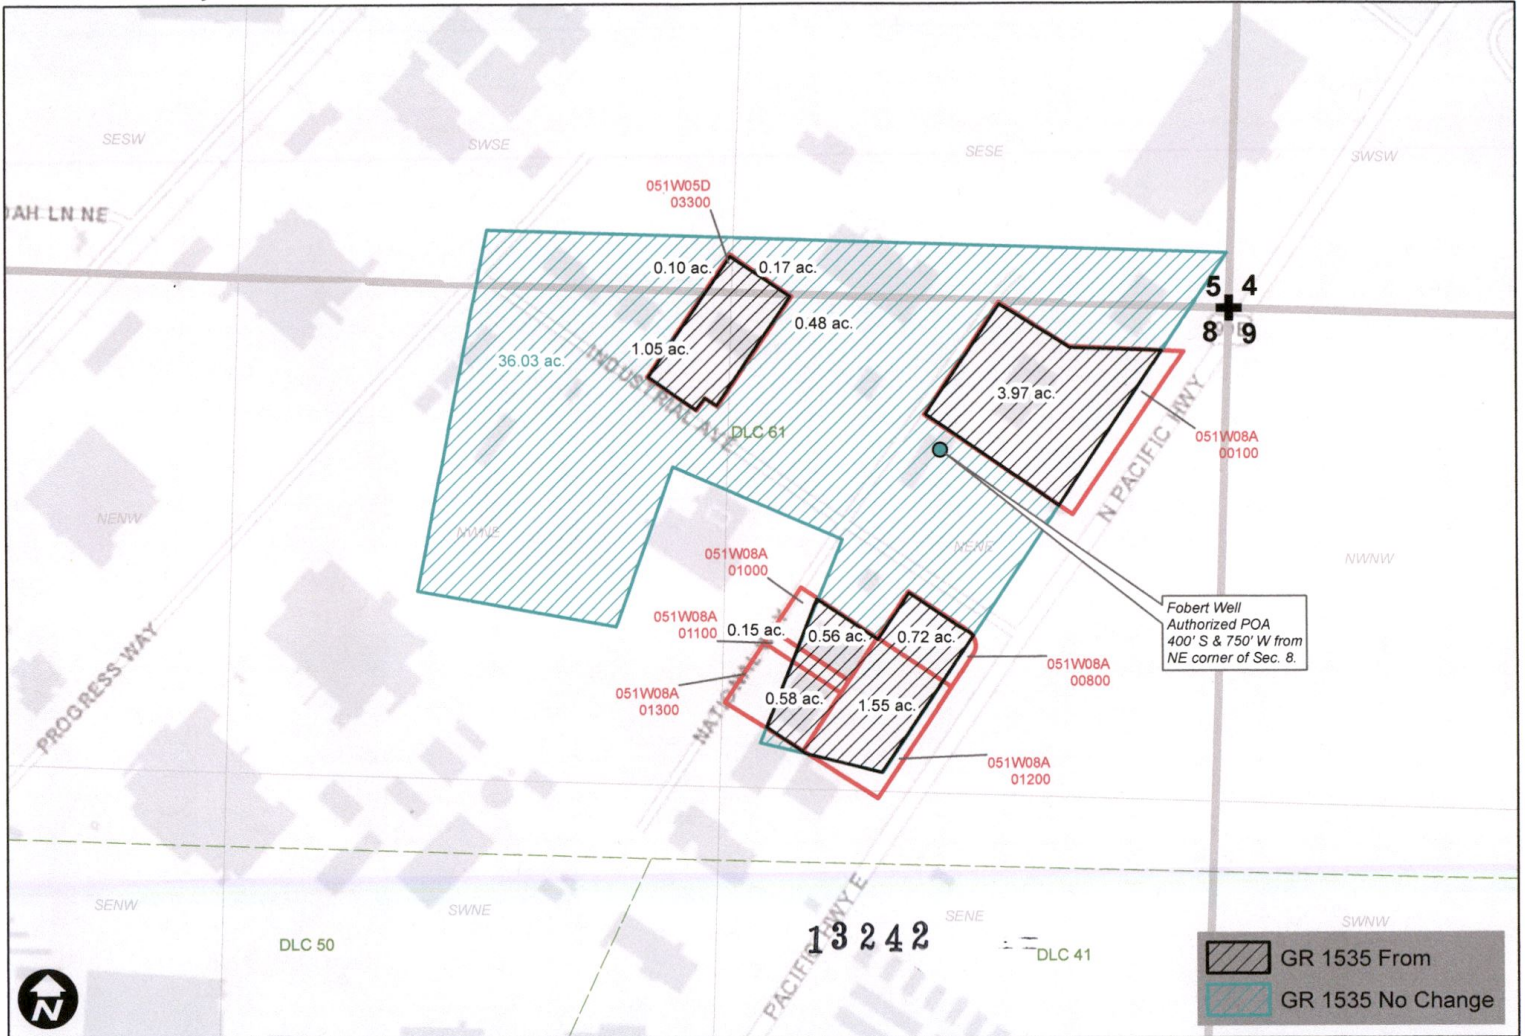

RECEIVED  
AUG 27 2019

WILL MCGILL SURVEYING, LLC

# ISCC Nursery - GR 1535 - Groundwater Registration Modification - T0

