


Received by OWRD
 SEP 26 2019
 Salem, OR

Traced: R.W.R. 4-17-53
 Checked: R.E. 6-20-55

DINN: 2018-05 OFF MAP Tax Lot 2000 22S46E13 SWNW OFF 1.4 Acres Total
 DINN: 2018-03 OFF MAP Tax Lot 2000 22S46E13 SENW OFF 5.0 Acres Total

Application Transfer Map
 SEC. 13, T.22 S., R.46 E. WM
 SCALE: 1" = 400'

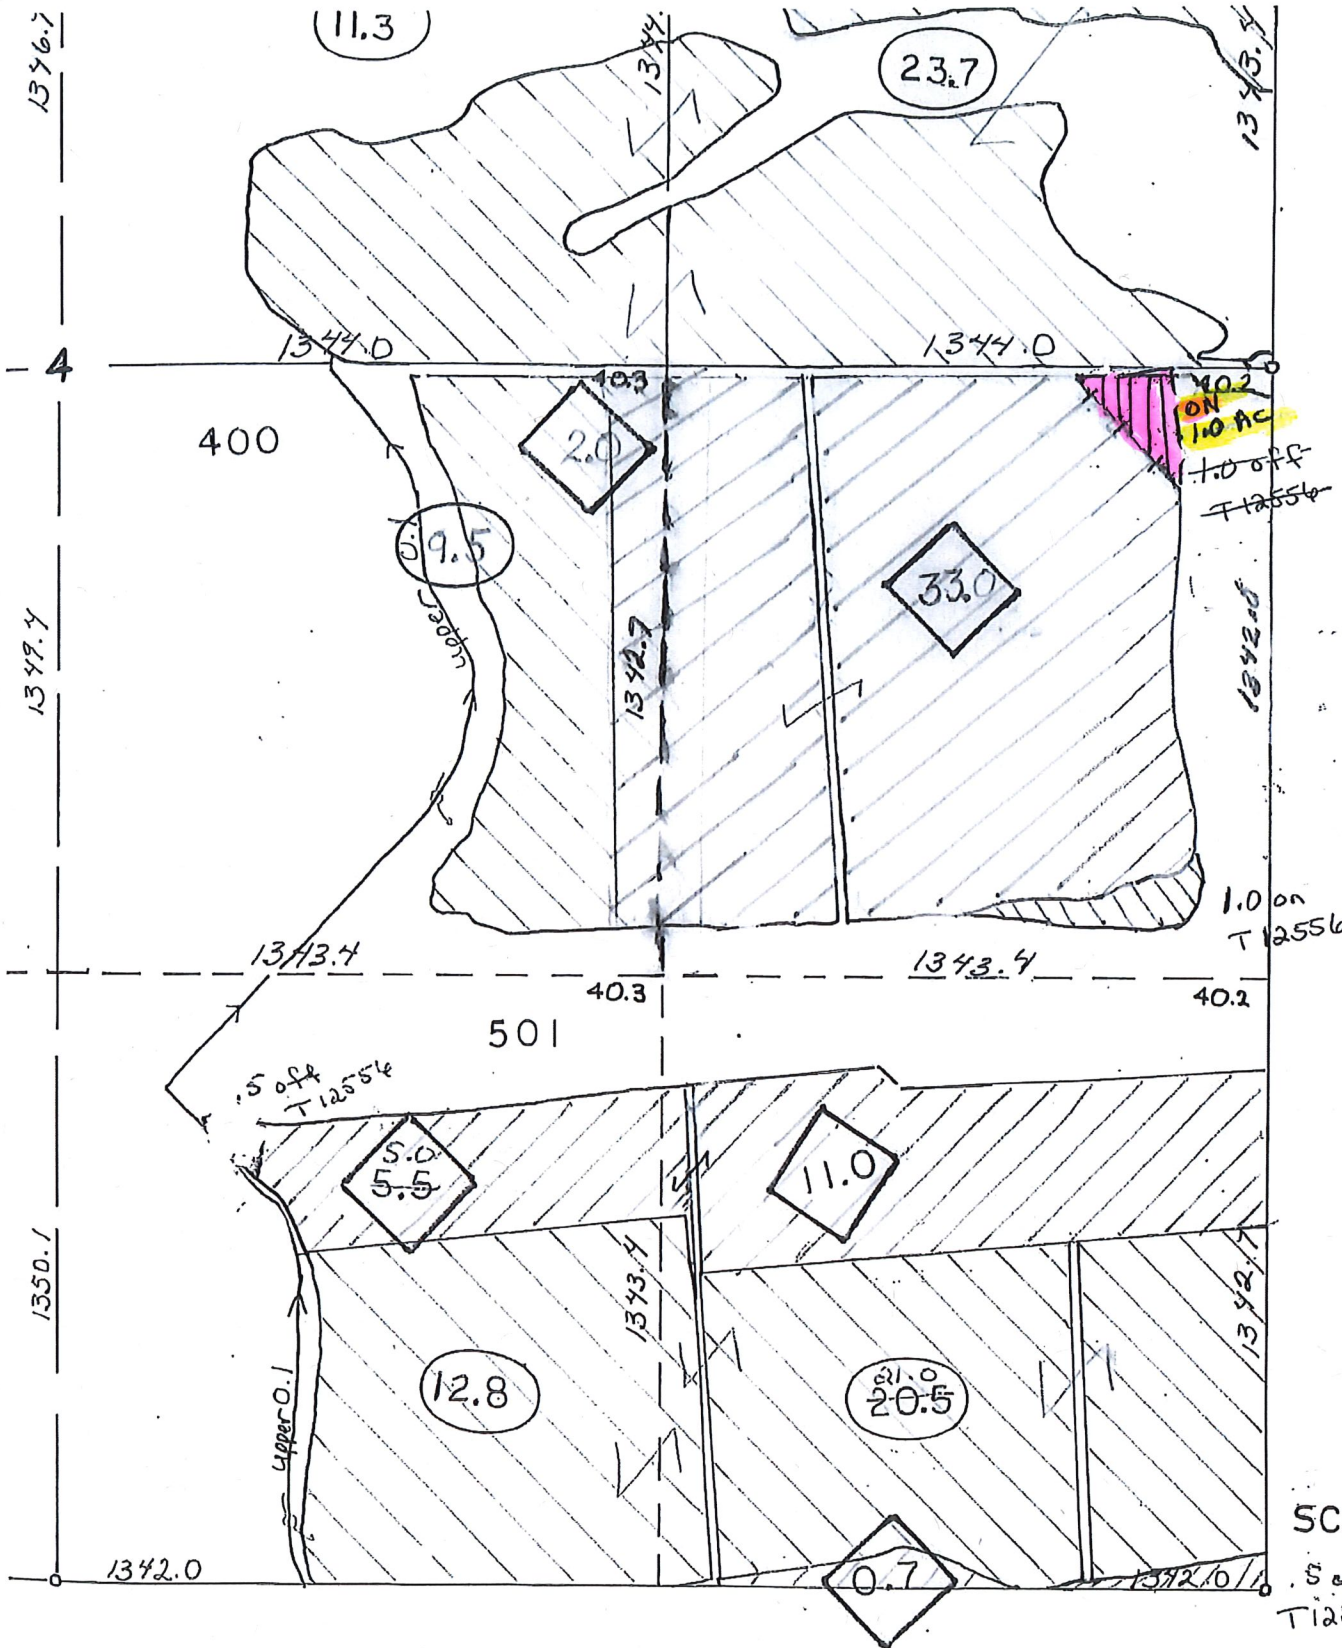

- (XX.X)
IRR. ACR
IN 1/4 1
- IRR. ACR
- (X.X)
PENDING
- PENDING A
- (X.X)
PRIVATE
- PRIVATE A
-
PROPERTY]
OTHER THAN



SCALE: 1" = 400'
5 on T12556

SEC. 4 , T.22 S., R.46 E., W.M.

48-102-158


DINN: 2018-02
ON MAP
Tax Lot 400 22S46E04 SESE
ON 1.0 Acres Total

Received by OWRD

SEP 26 2019

Salem, OR

TX Lot 200

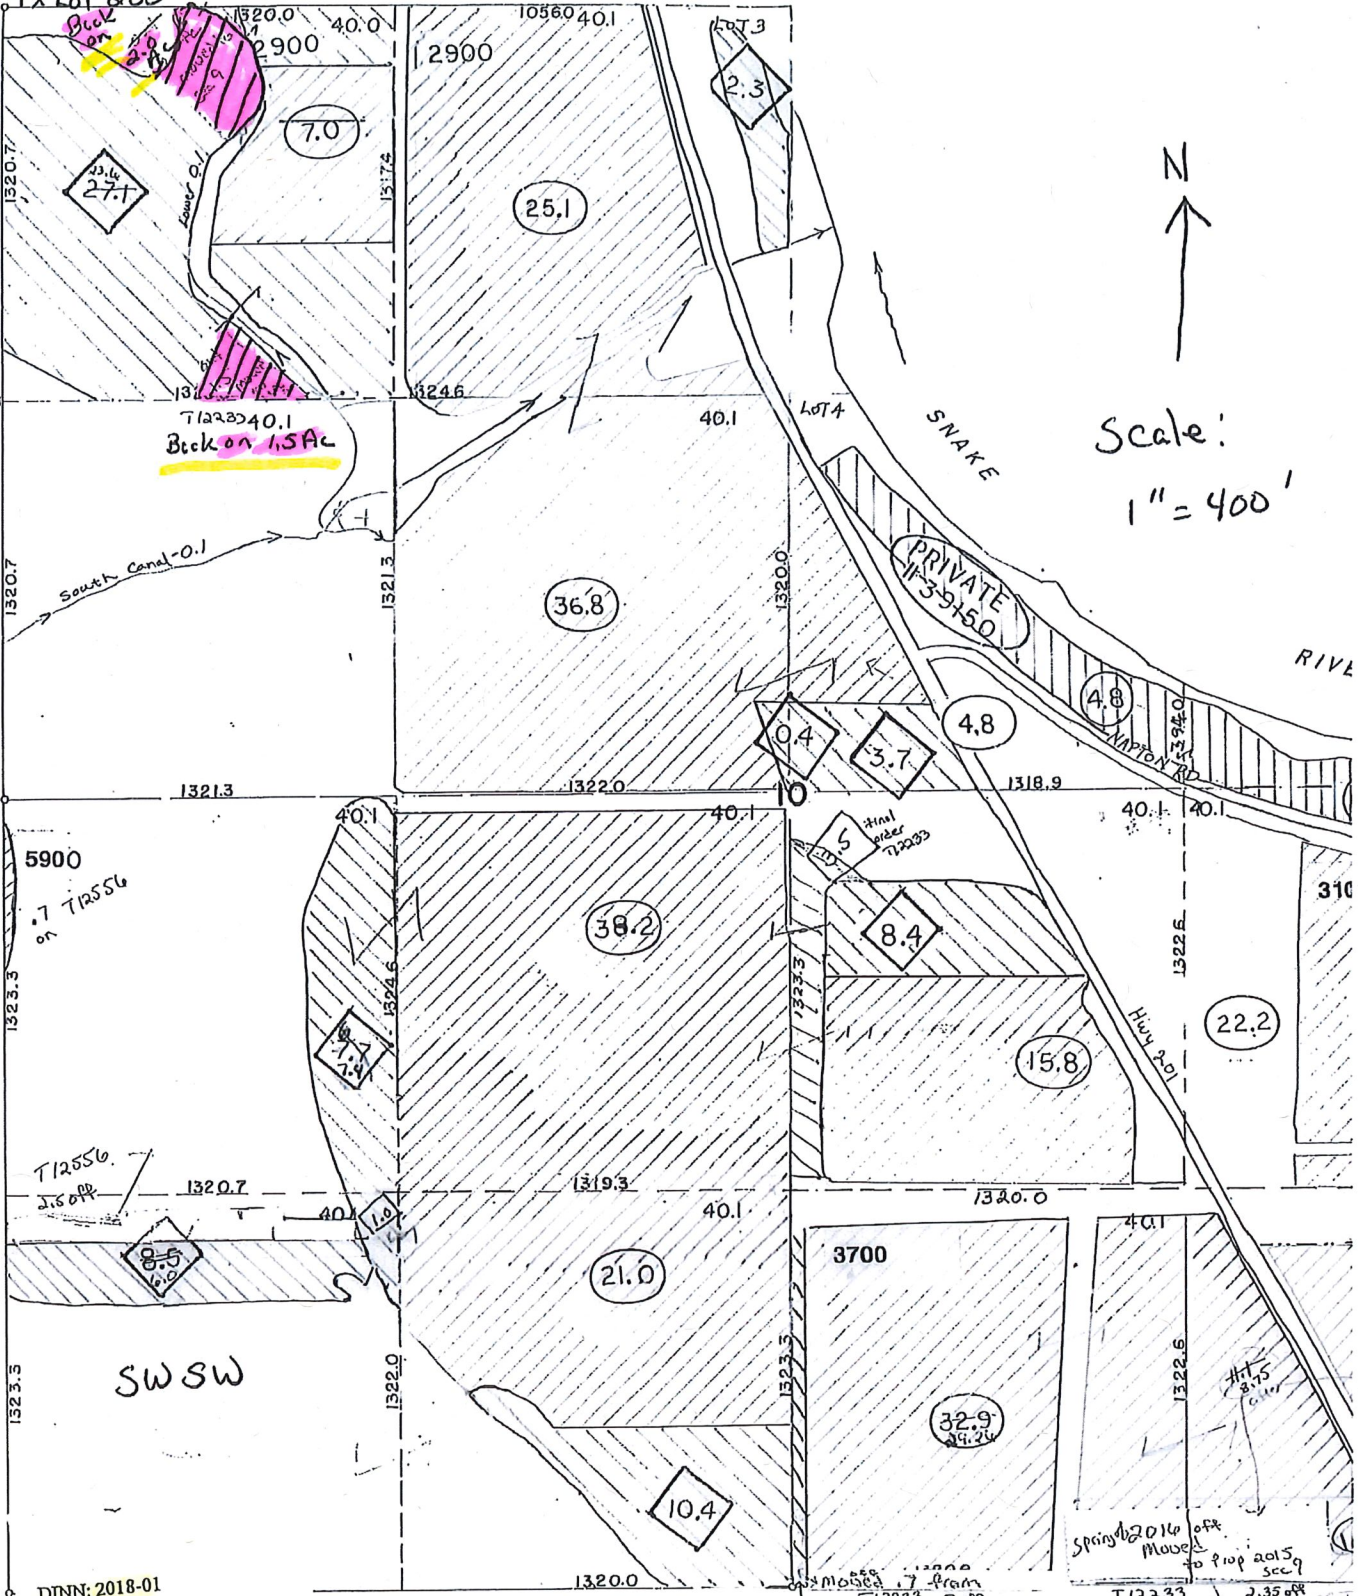

N
 Scale:
 1" = 400'

DINN: 2018-01
 ON MAP
 Tax Lot 200 22S46E10 NWNW
 ON 3.5 Acres Total


SEC. 10, T.22 S., R.46 E

Traced: R.W.R. 4-15-53
 Checked: R.E. 6-20-55

Received by OWRD

SEP 26 2019

Salem, OR

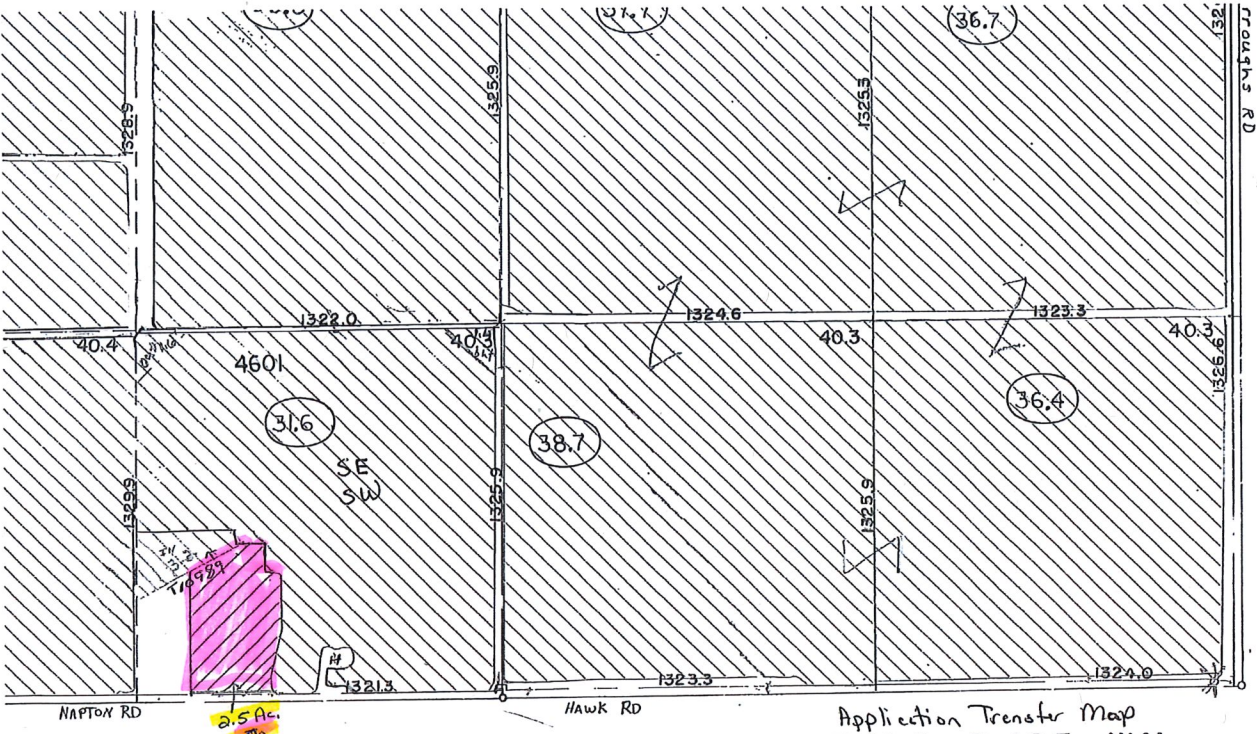

SCALE: 1" = 400'

Application Transfer Map
 SEC. 12, T. 22 S., R. 46 E., W.M. 48-102-1560


DINN: 2018-03
 ON MAP
 Tax Lot 2000 22S46E12 SESW
 ON 2.5 Acres Total

53
 -55

Received by OWRD

SEP 26 2019

Salem, OR

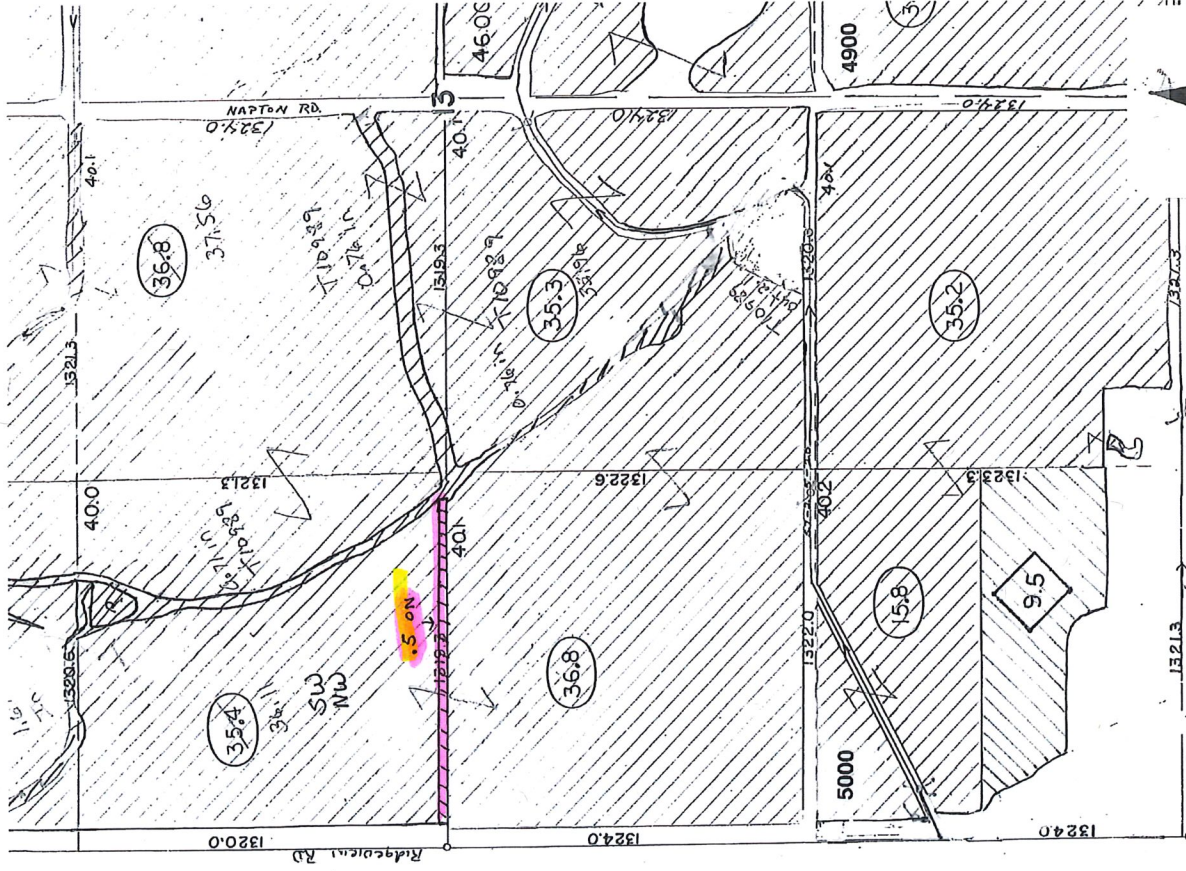

Received by OWRD

SEP 26 2019

Salem, OR


Traced: R.W.R. 4-17-53
 Checked: R.E. 6-20-55

Application
 Transfer Map

DINN: 2018-03
 ON MAP
 Tax Lot 2000 22546E13 SWNW
 ON .5 Acres Total

SCALE: 1" = 400'

SEC. 13, T.22 S., R.46 E., W.M.

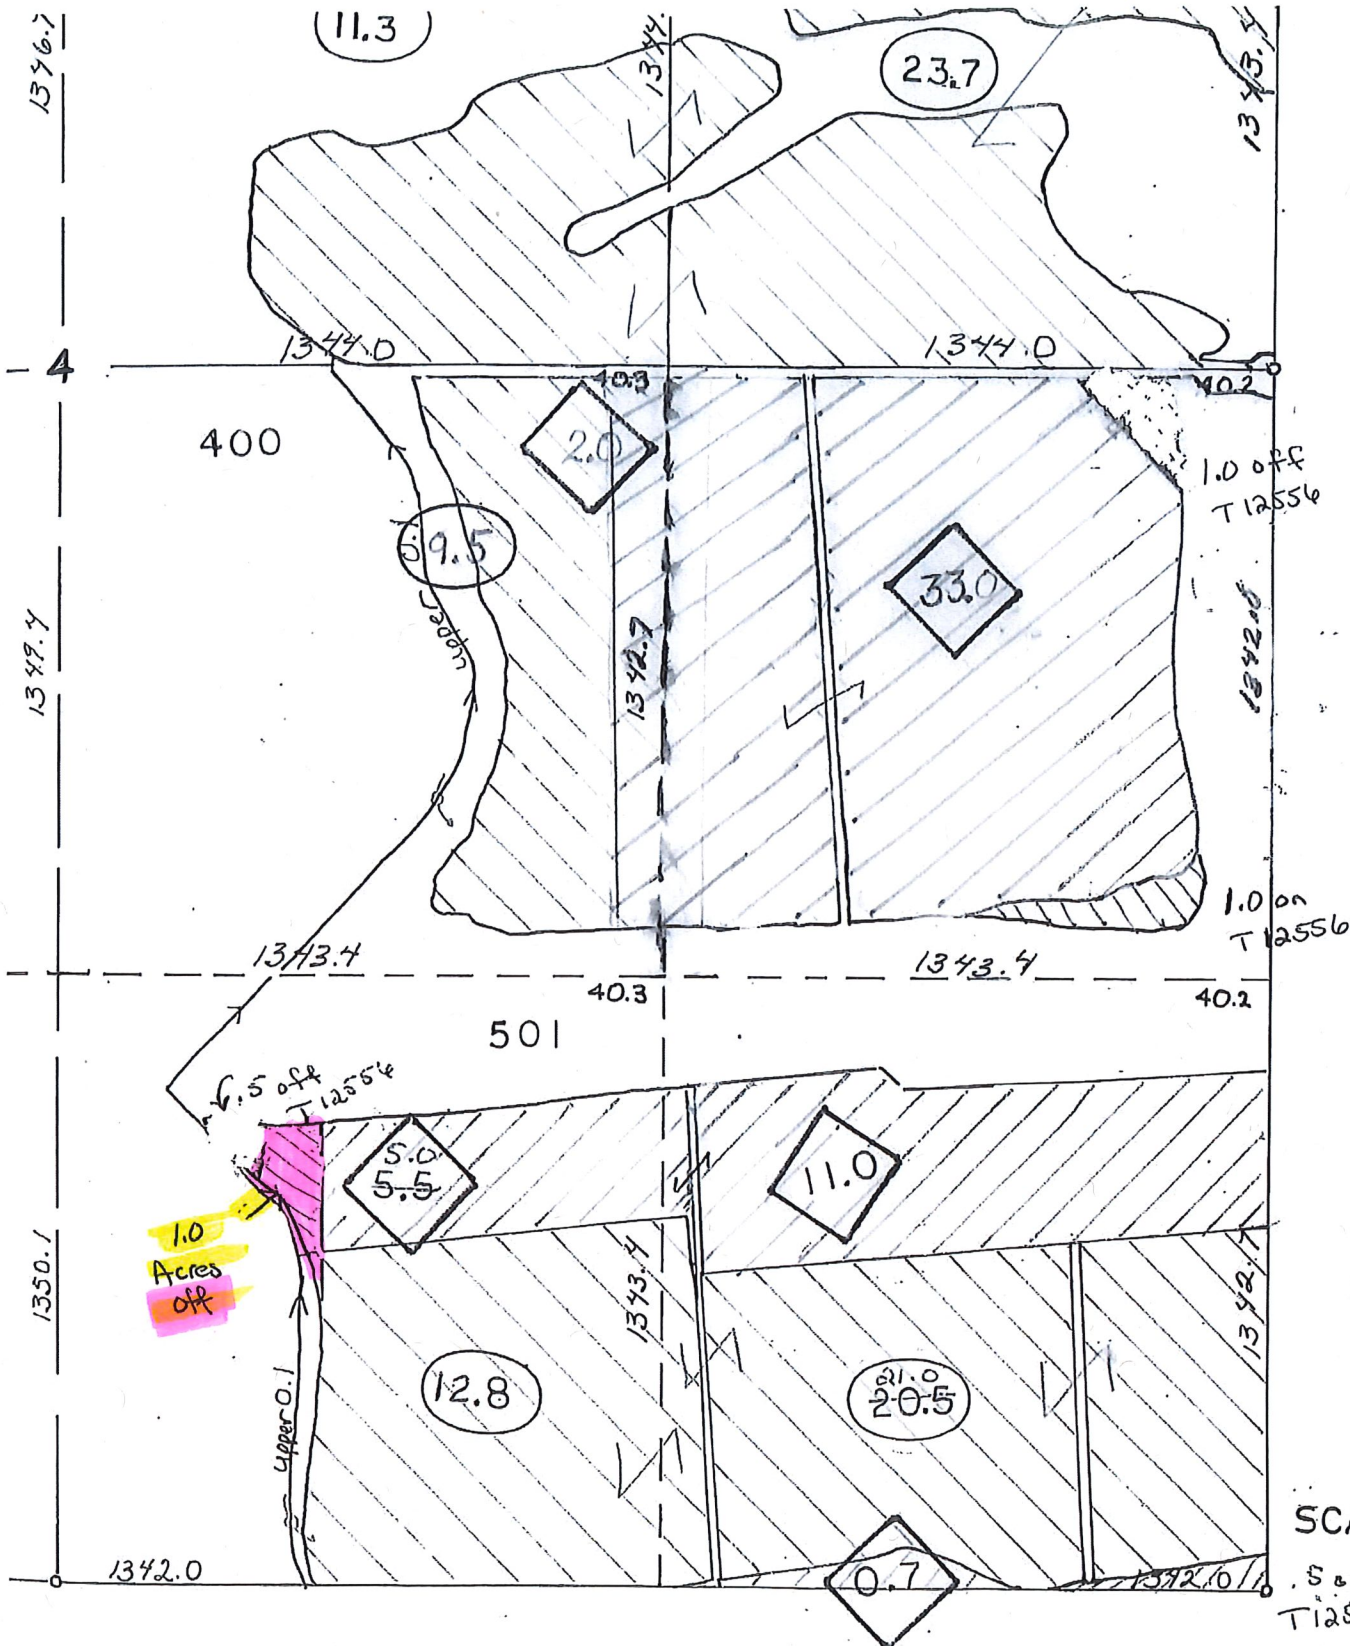

- xx.x
IRR. ACR
IN 1/4 1
- IRR. ACR.
- x.x
PENDING
- PENDING A
- x.x
PRIVATE
- PRIVATE A
- PROPERTY |
OTHER THAN



SCALE: 1" = 400'
5 on T12556

SEC. 4 , T.22 S., R.46 E., W.M.

48-102-158


DINN: 2018-02
OFF MAP
Tax Lot 501 22S46E04 SWSE
OFF 1.0 Acres Total

Received by OWRD

SEP 26 2019

Salem, OR

IRRIGATION DISTRICT

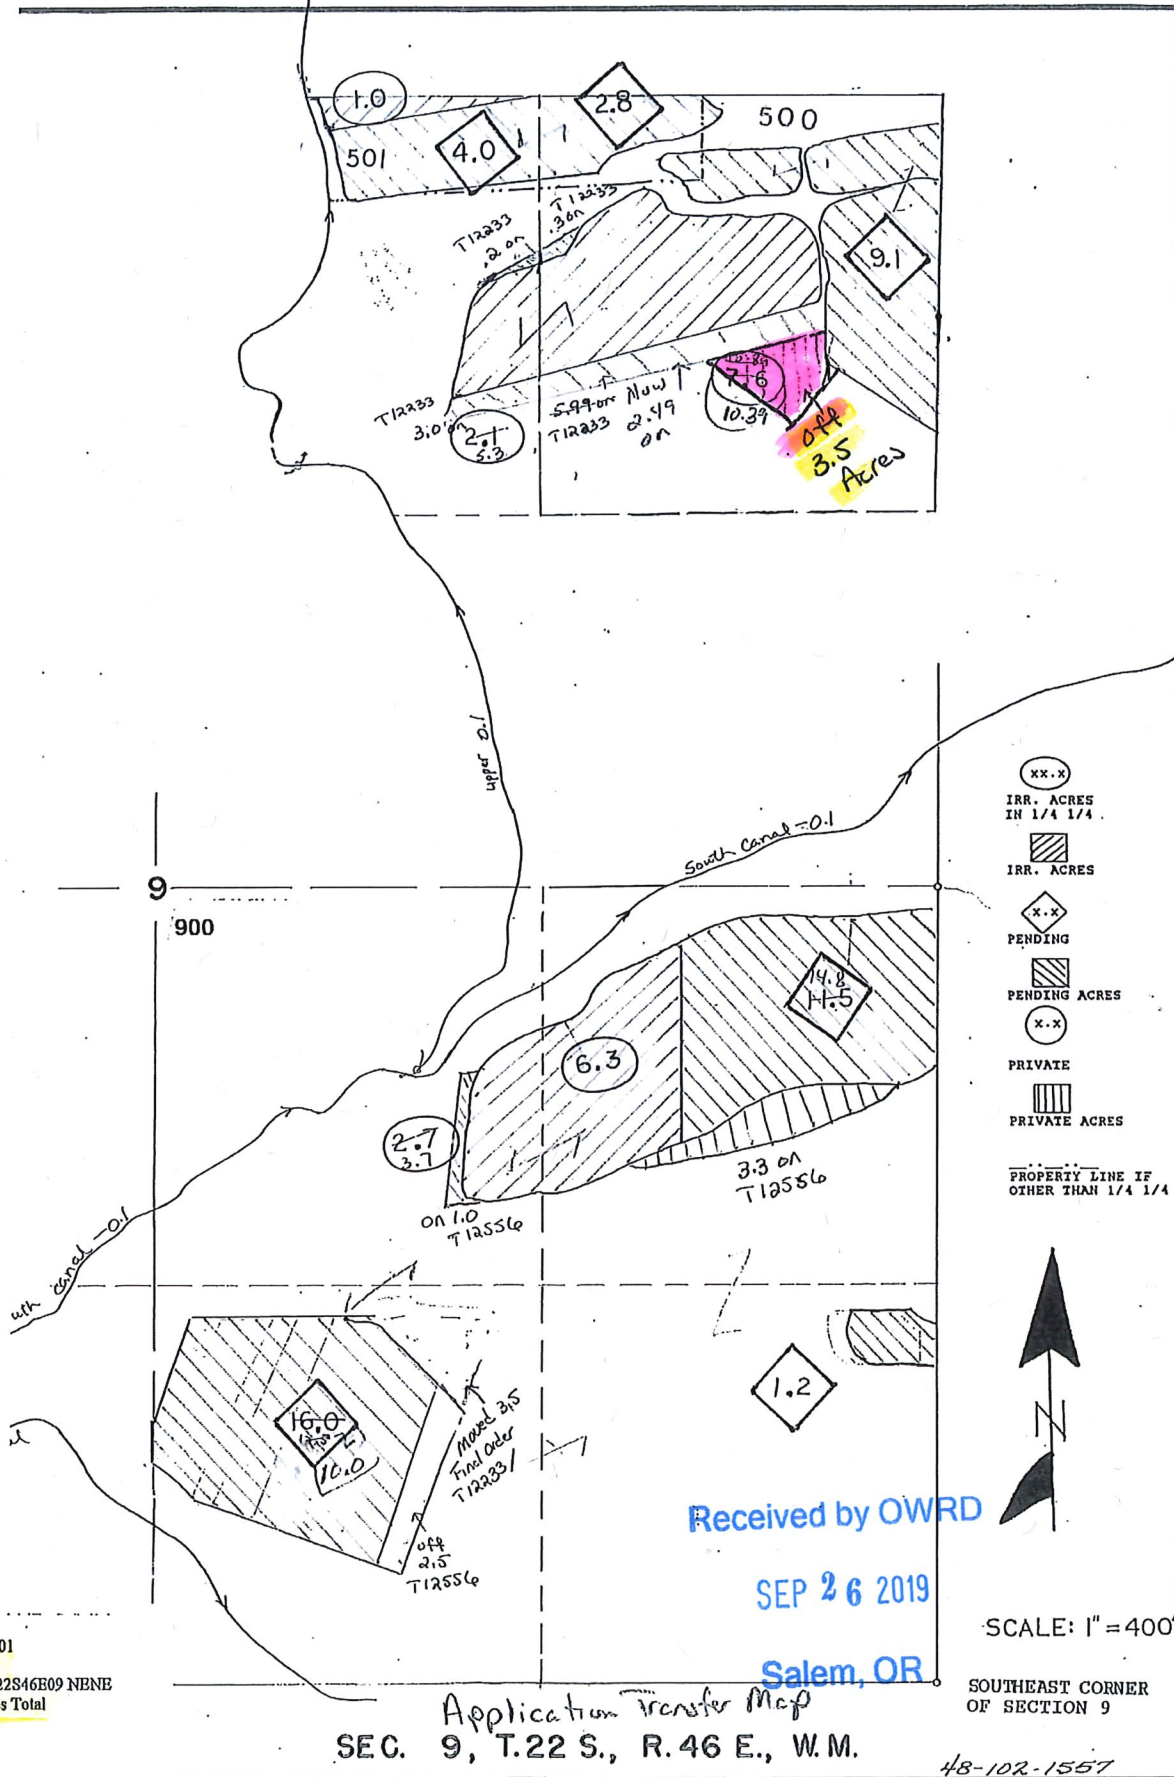

- (xx.x) IRR. ACRES IN 1/4 1/4
- [Hatched Box] IRR. ACRES
- (x.x) PENDING
- [Hatched Box] PENDING ACRES
- (x.x) PRIVATE
- [Solid Box] PRIVATE ACRES
- PROPERTY LINE IF OTHER THAN 1/4 1/4



Received by OWRD
 SEP 26 2019
 Salem, OR

SCALE: 1" = 400'
 SOUTHEAST CORNER OF SECTION 9

DINN: 2018-01
 OFF MAP
 Tax Lot 500 22S46E09 NENE
 OFF 3.5 Acres Total

Application Transfer Map
 SEC. 9, T.22 S., R.46 E., W.M.

48-102-1557