


Swalley Irrigation District

2016 District Transfer T-12547 Claim of Beneficial Use Map

Certificates: 74145
for Michelle Gelling

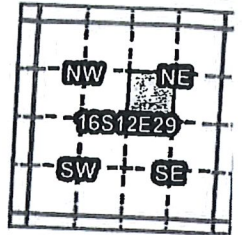

Taxlot 00303, 16S12E29SWNE: 0.05 ac. On,

OFF
T-12547

Received by OWRD

SEP 30 2019

Salem, OR

- Point of Diversion
- ▬ Canals
- ▭ Taxlots
- ▣ Transfer
- ▤ Cert 74145





1 inch = 400 feet

Swalley Irrigation District

2016 District Transfer *T-12547* Claim of Beneficial Use Map

Certificates: 74145

for Walter & Jacqueline Babcock

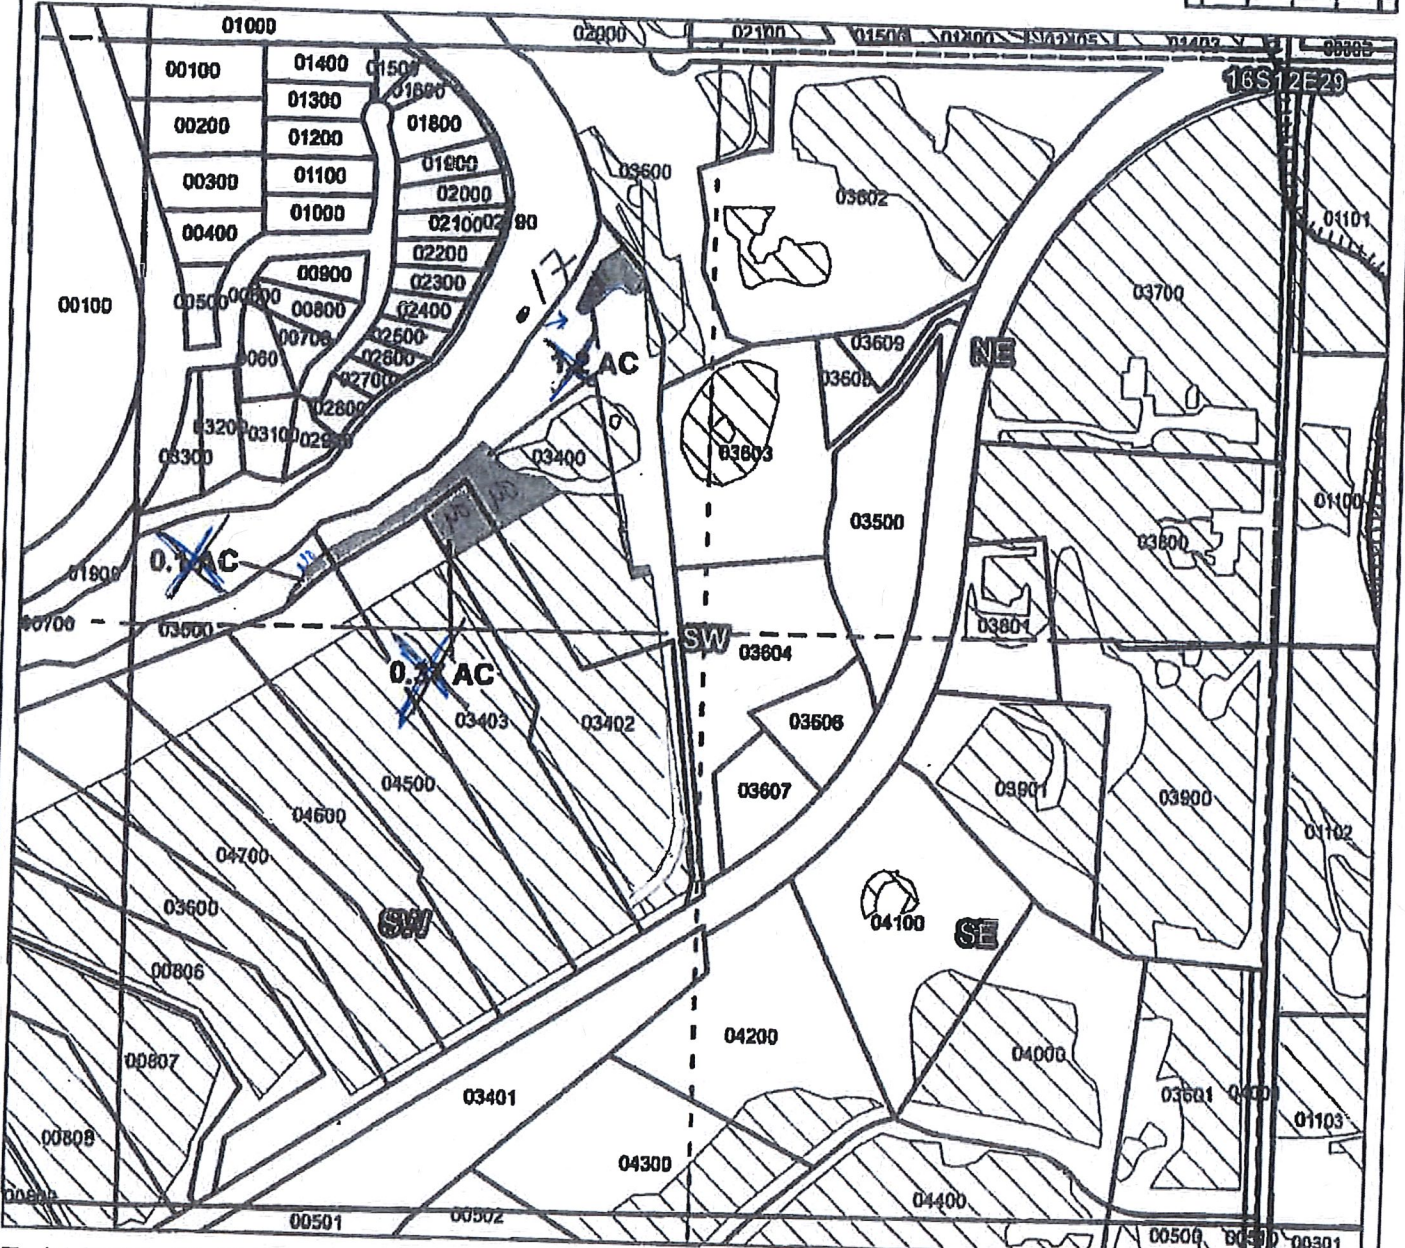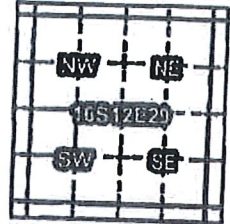

Taxlot 03400, 16S12E29NWSW: 1.03 ac. On, 7.73 ac. Total
 Taxlot 03400, 16S12E29NWSW: 0.17 ac. On, 6.87 ac. Total
 Taxlot 03402, 16S12E29NWSW: 0.37 ac. On, 8.10 ac. Total
 Taxlot 03500, 16S12E29NWSW: 0.1 ac. On, 12.40 ac. Total

with drawn 3/29/17

RECEIVED BY OWRD

Received by OWRD

DEC 28 2016

SEP 30 2019

SALEM, OR

Salem, OR

- Point of Diversion
- ▨ Canals
- ▭ Taxlots
- ▨ Transfer
- ▭ Cert 74145

T 12547




1 Inch = 400 feet

Swalley Irrigation District


2016 District Transfer . T-12547

Claim of Beneficial Use Map

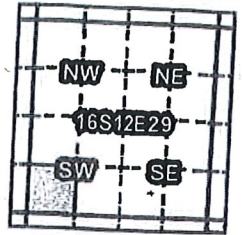

Certificates: 74145

for David & Beverly Summer

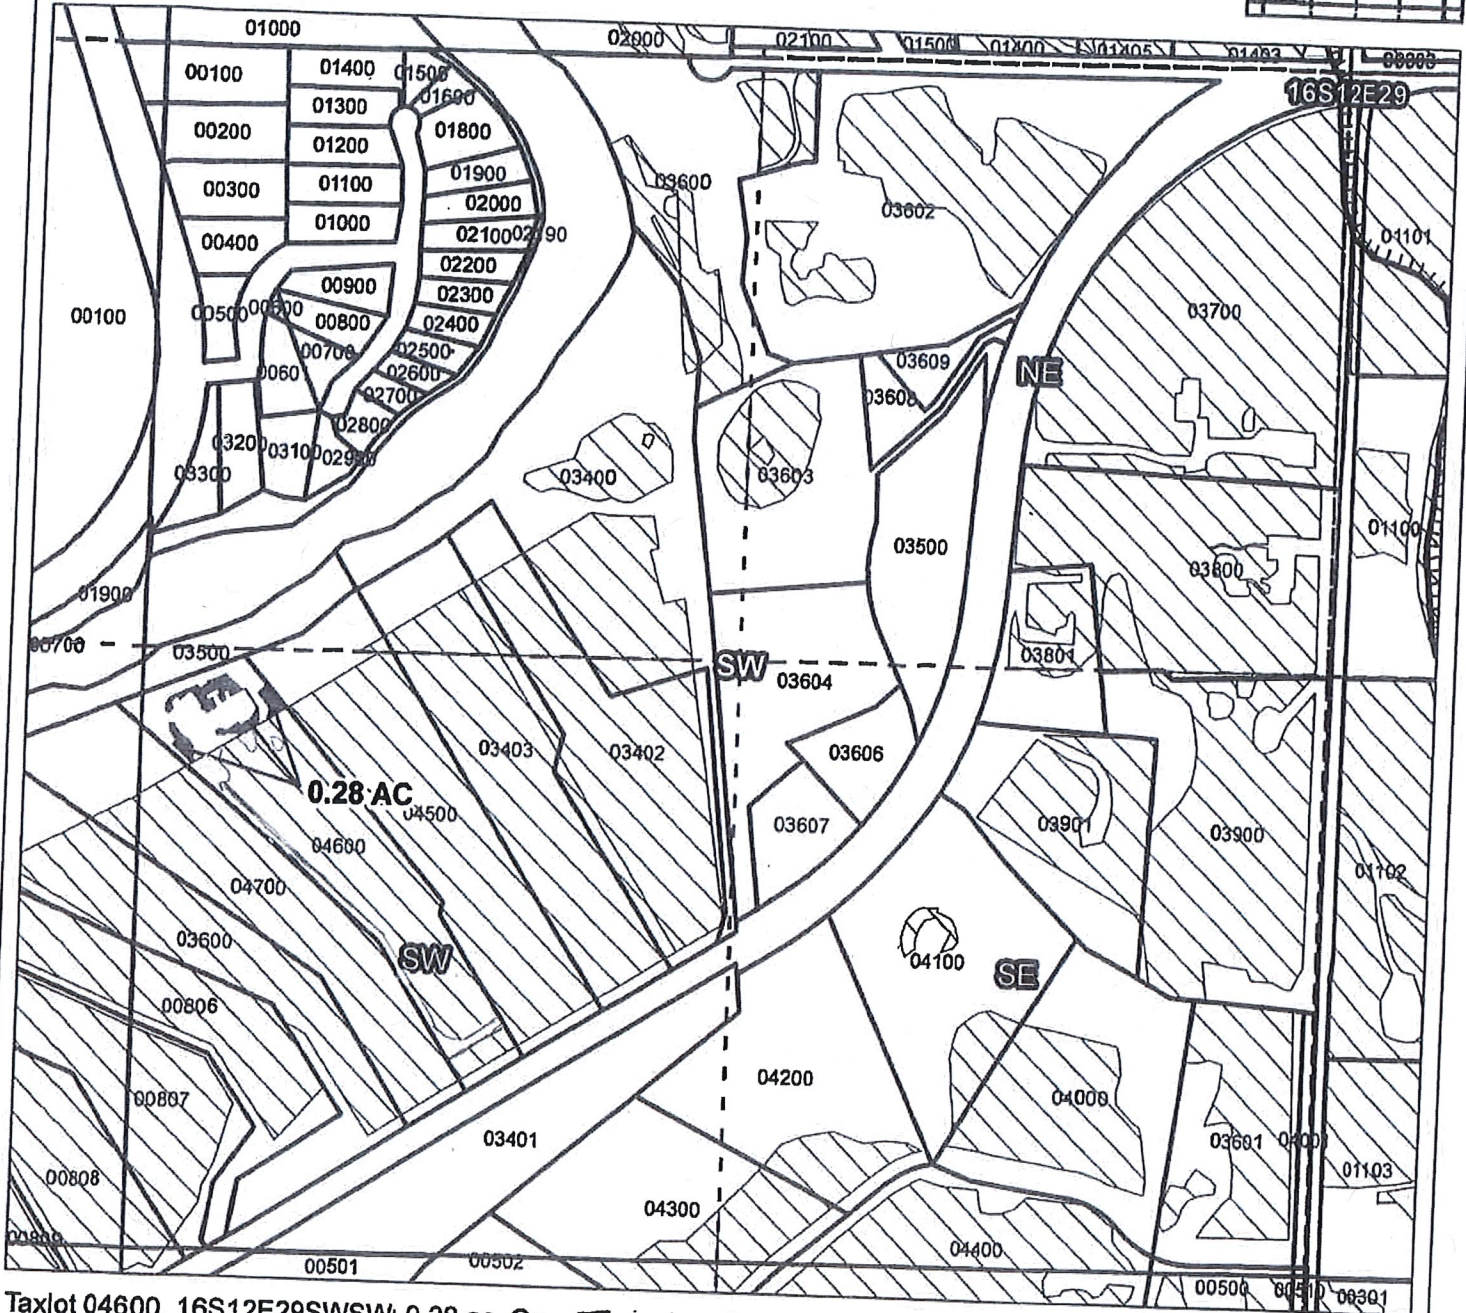

Taxlot 04600, 16S12E29SWSW: 0.28 ac. On, Total 3.90ac

Received by OWRD

SEP 30 2019

Salem, OR





1 inch = 400 feet

- Point of Diversion
- ▨ Canals
- ▭ Taxlots
- ▨ Transfer
- ▭ Cert 74145

Swalley Irrigation District

2016 District Transfer *T-12547* Claim of Beneficial Use Map

Certificates: 74145
for Tiffany Goodman

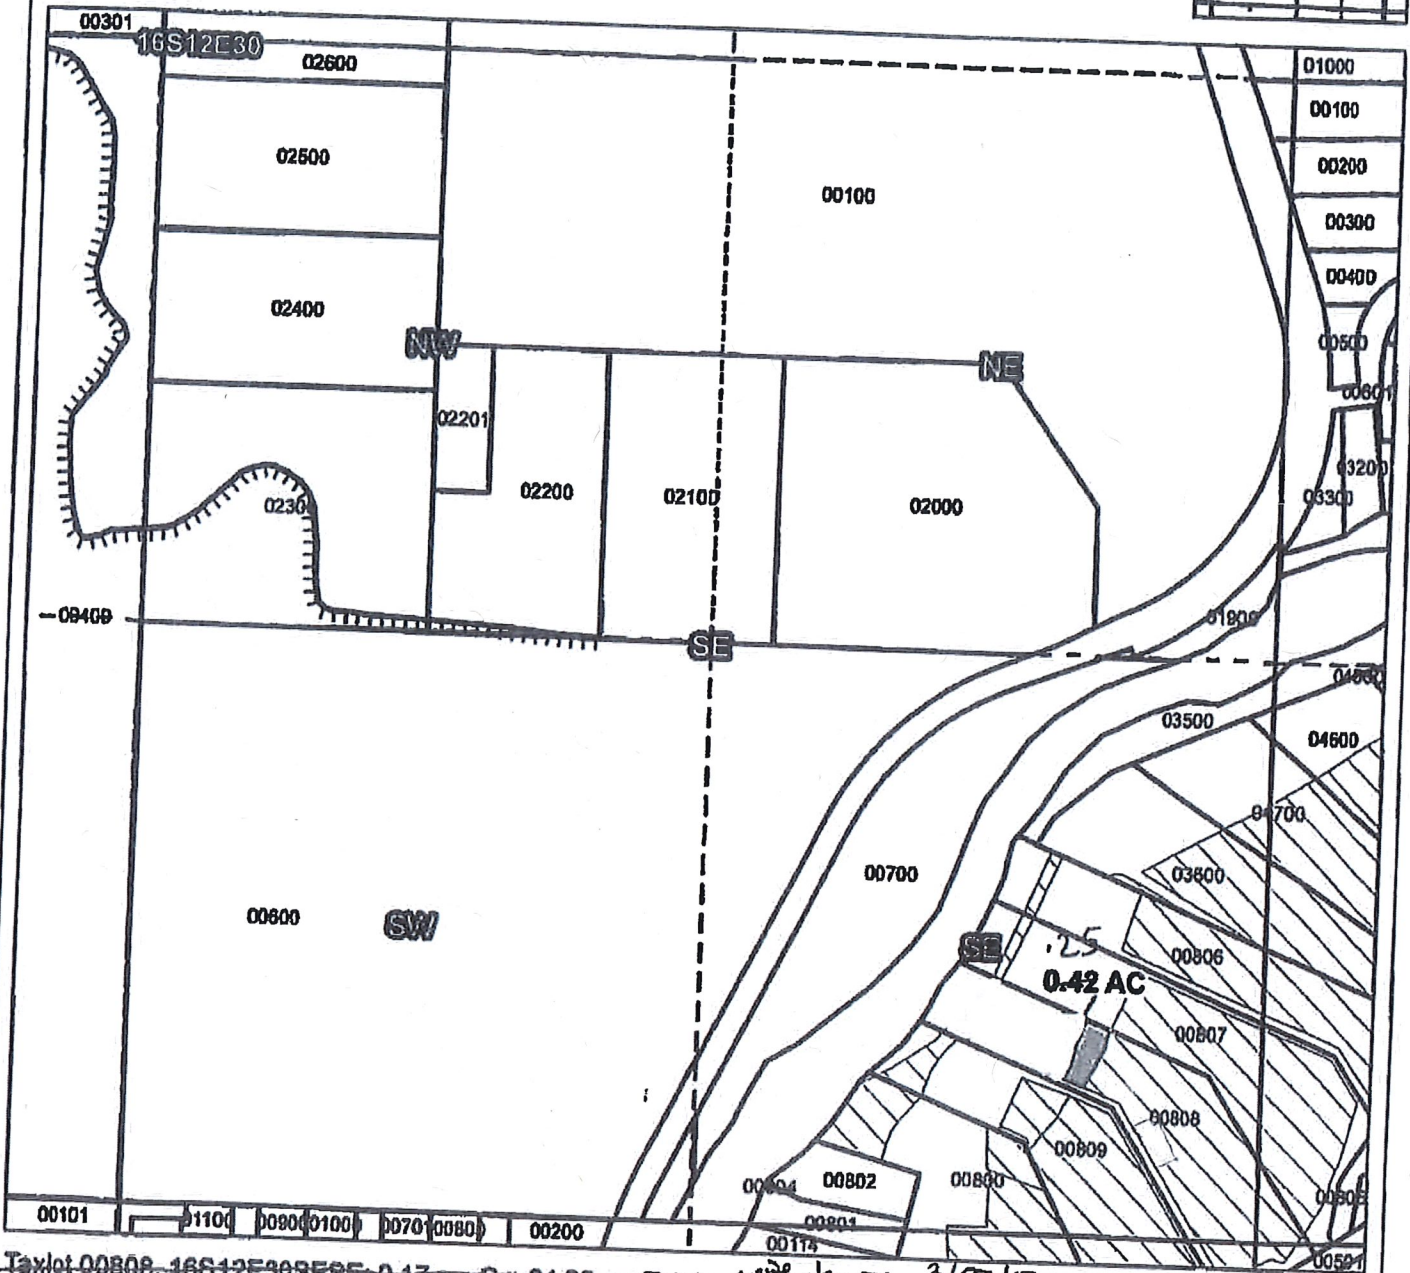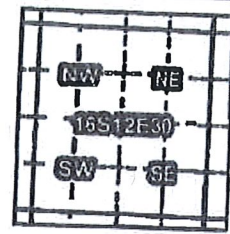

Taxlot 00808, 16S12E30SESE: 0.17 ac. On, 34.92 ac. Total *w/le drawn 3/27/17*
 Taxlot 00808, 16S12E30SESE: 0.25 ac. On, 35.17 ac. Total

Received by OWRD

RECEIVED BY OWRD

SEP 30 2019

DEC 28 2016

Salem, OR

SALEM, OR

- Point of Diversion
 - Canals
 - Taxlots
 - Transfer
 - Cert 74145
- T 12547**



1 inch = 400 feet



Swalley Irrigation District

2016 District Transfer T-12547

Claim of Beneficial Use Map

Certificates: 74145

for Kenneth Harrison

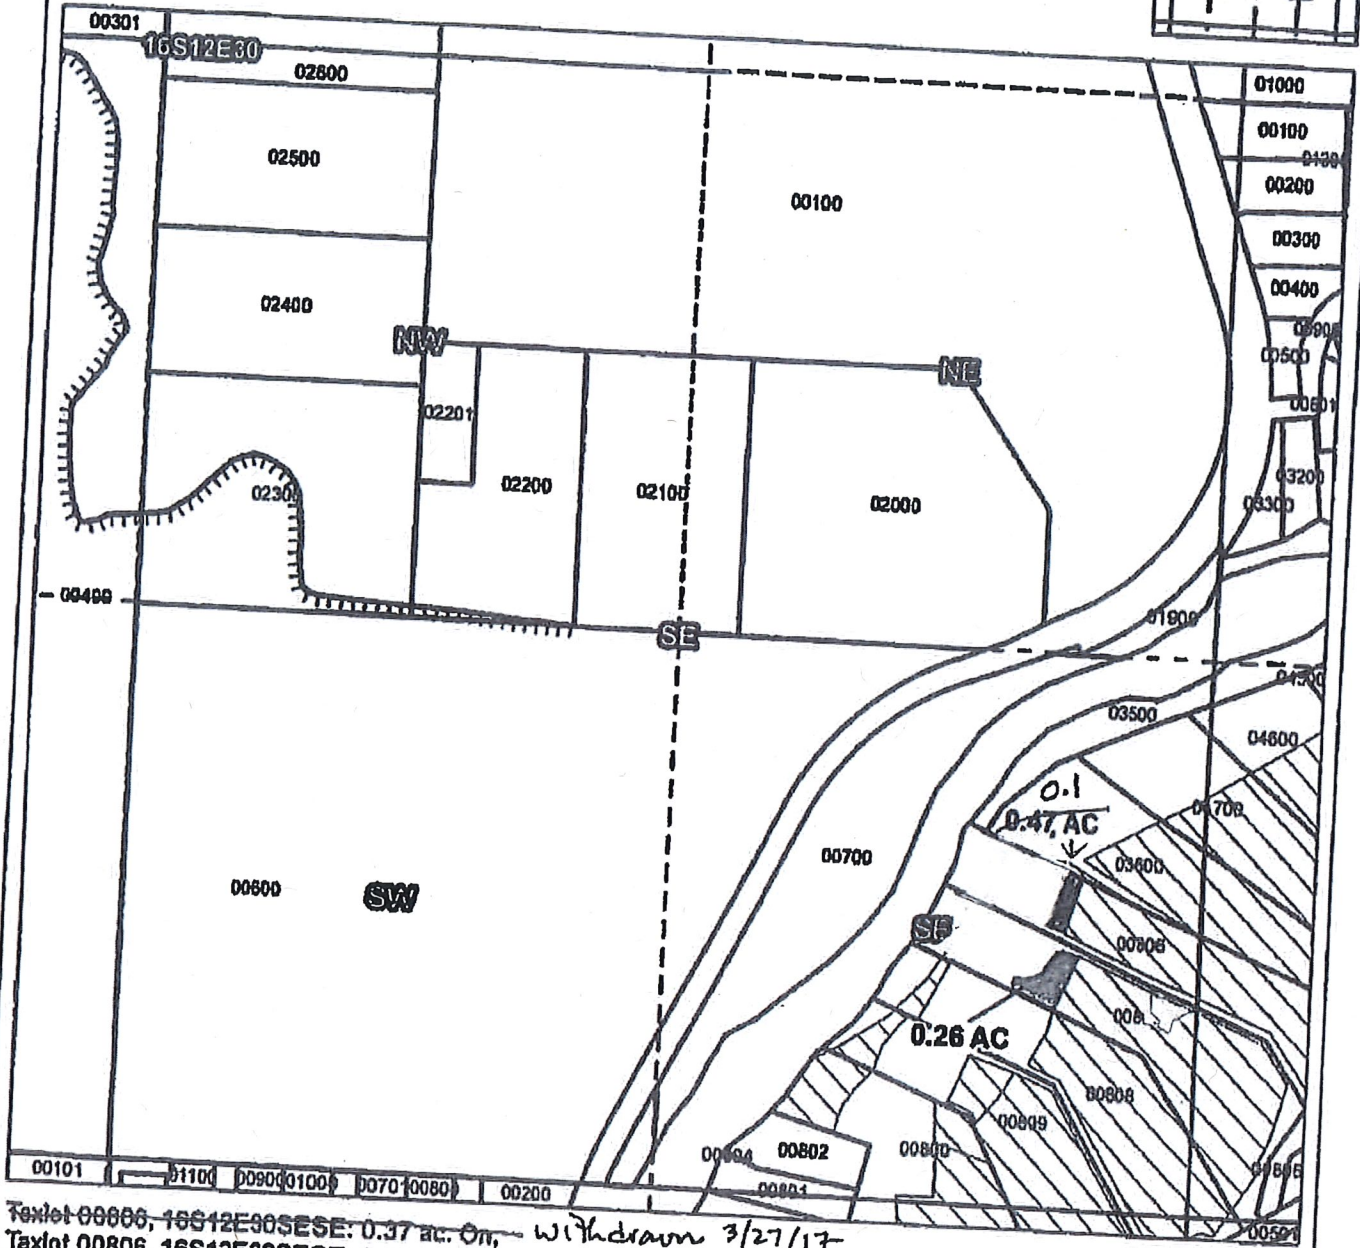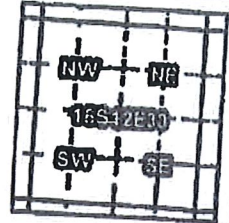

Taxlot 00806, 16S12E30SESE: 0.37 ac. On, *withdrawn 3/27/17*
Taxlot 00806, 16S12E30SESE: 0.1 ac. On,
Taxlot 00807, 16S12E30SESE: 0.26 ac. On,

- Point of Diversion
- ▬ Canals
- ▭ Taxlots
- ▨ Transfer
- ▩ Cert 74145

Received by OWRD

RECEIVED

SEP 30 2019

MAR 27 2017

Salem, OR

WATER RESOURCES DEPT
SALEM, OREGON



1 Inch = 400 feet



Prepared by FireWhat Inc. | December 2016

Swalley Irrigation District

2016 District Transfer T-12547 | Claim of Beneficial Use Map

Certificates: 74145

for Leroy & Sharon Schlecht

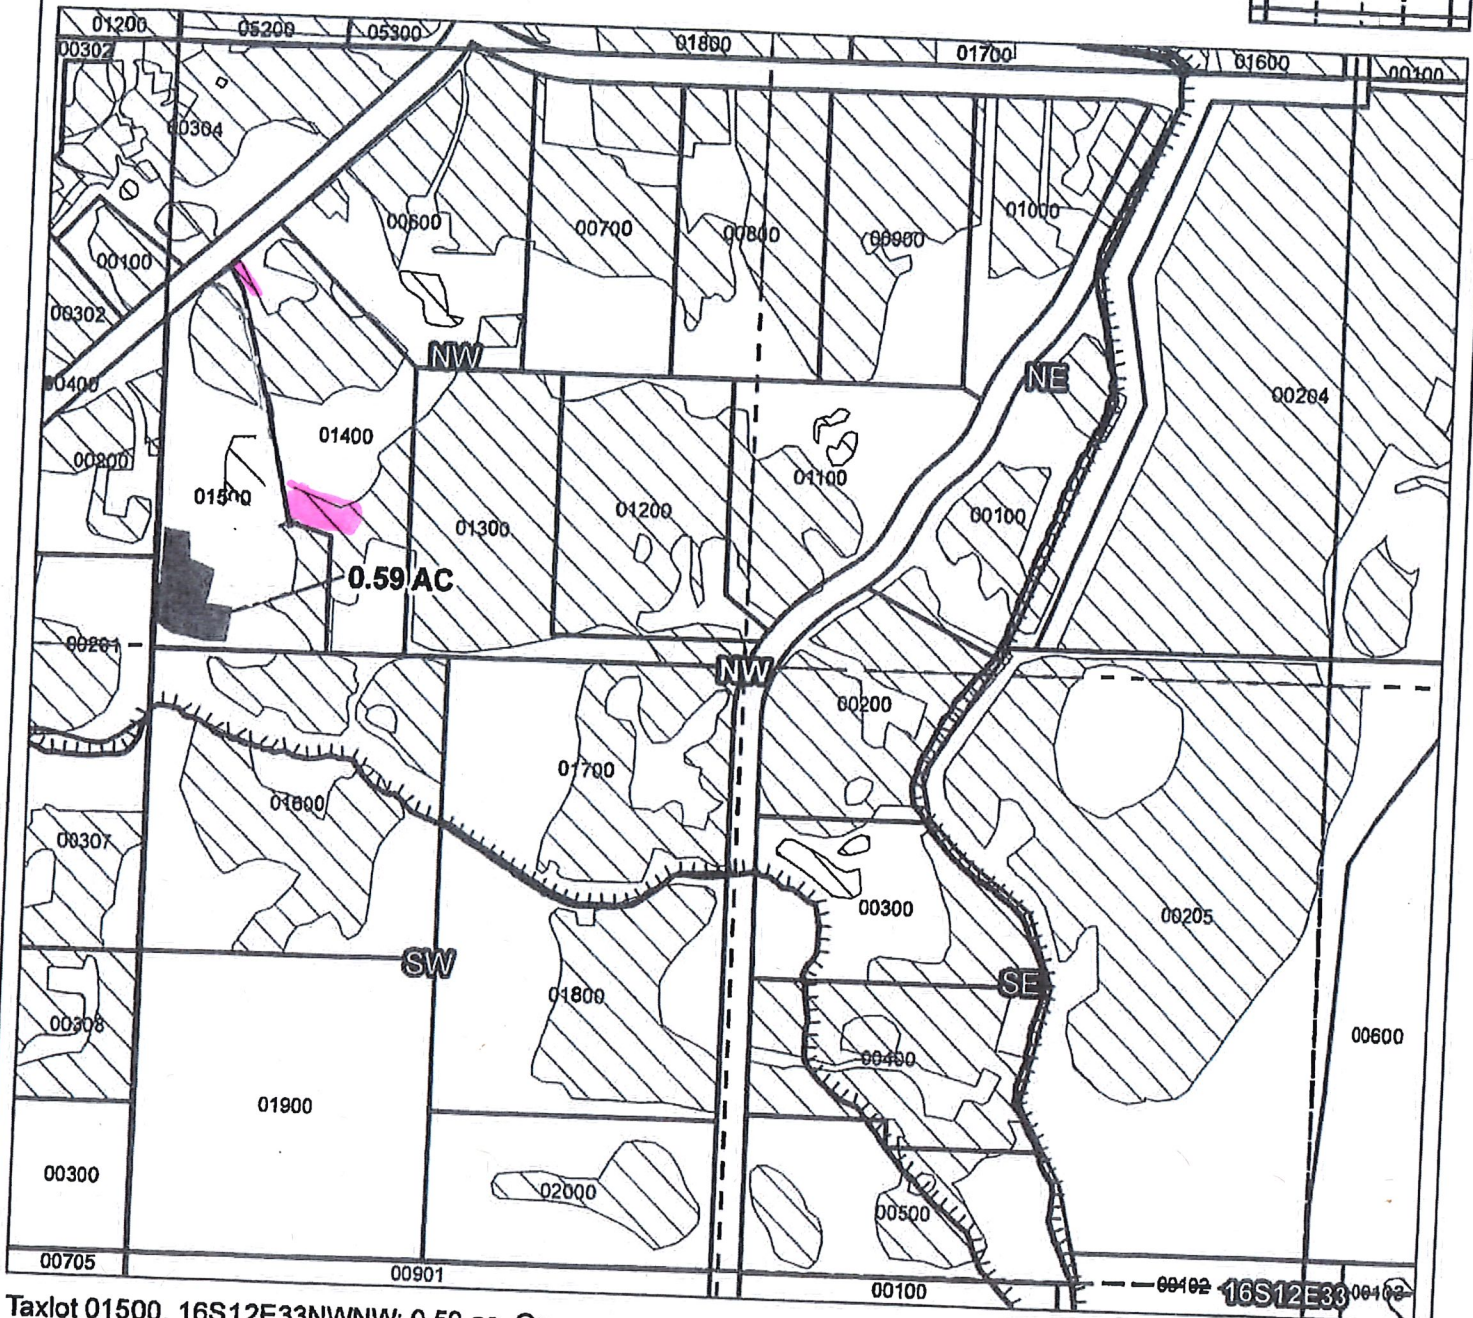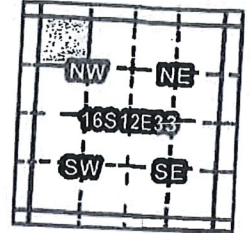






Taxlot 01500, 16S12E33NWNW: 0.59 ac. On,

 OFF T-12547

Received by OWRD

SEP 30 2019

Salem, OR

-  Point of Diversion
-  Canals
-  Taxlots
-  Transfer
-  Cert 74145




1 inch = 400 feet


Swalley Irrigation District

2016 District Transfer *IT-12547*

Claim of Beneficial Use Map

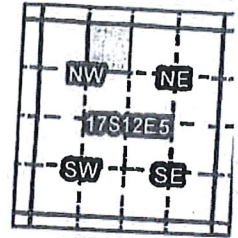

Certificates: 74145
for Daniel Faulkner

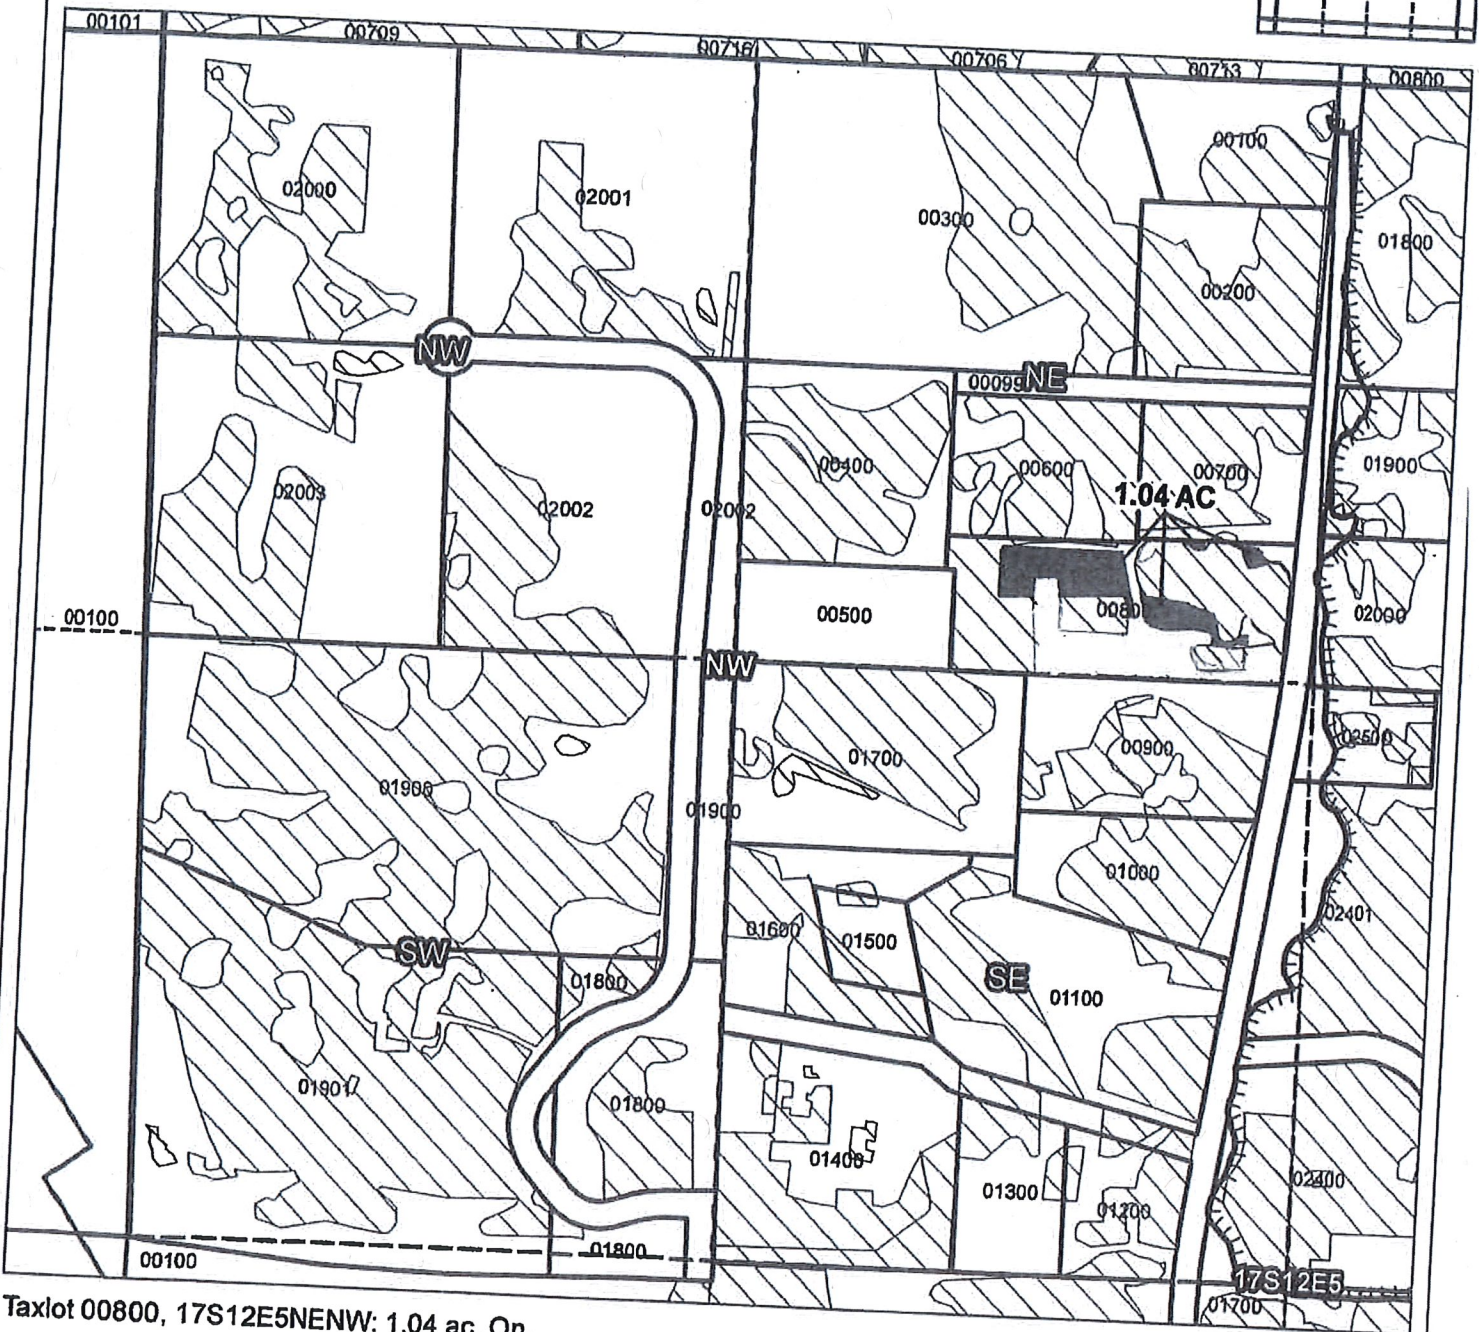

Taxlot 00800, 17S12E5NENW: 1.04 ac. On,

Received by OWRD

SEP 30 2019

Salem, OR

- Point of Diversion
- ▨ Canals
- ▭ Taxlots
- Transfer
- ▨ Cert 74145



1 inch = 400 feet



Swalley Irrigation District

2016 District Transfer T-12547 "On" Map

Certificates: 74145

for Rick Moeller & Carolyn Martin

CBU Map

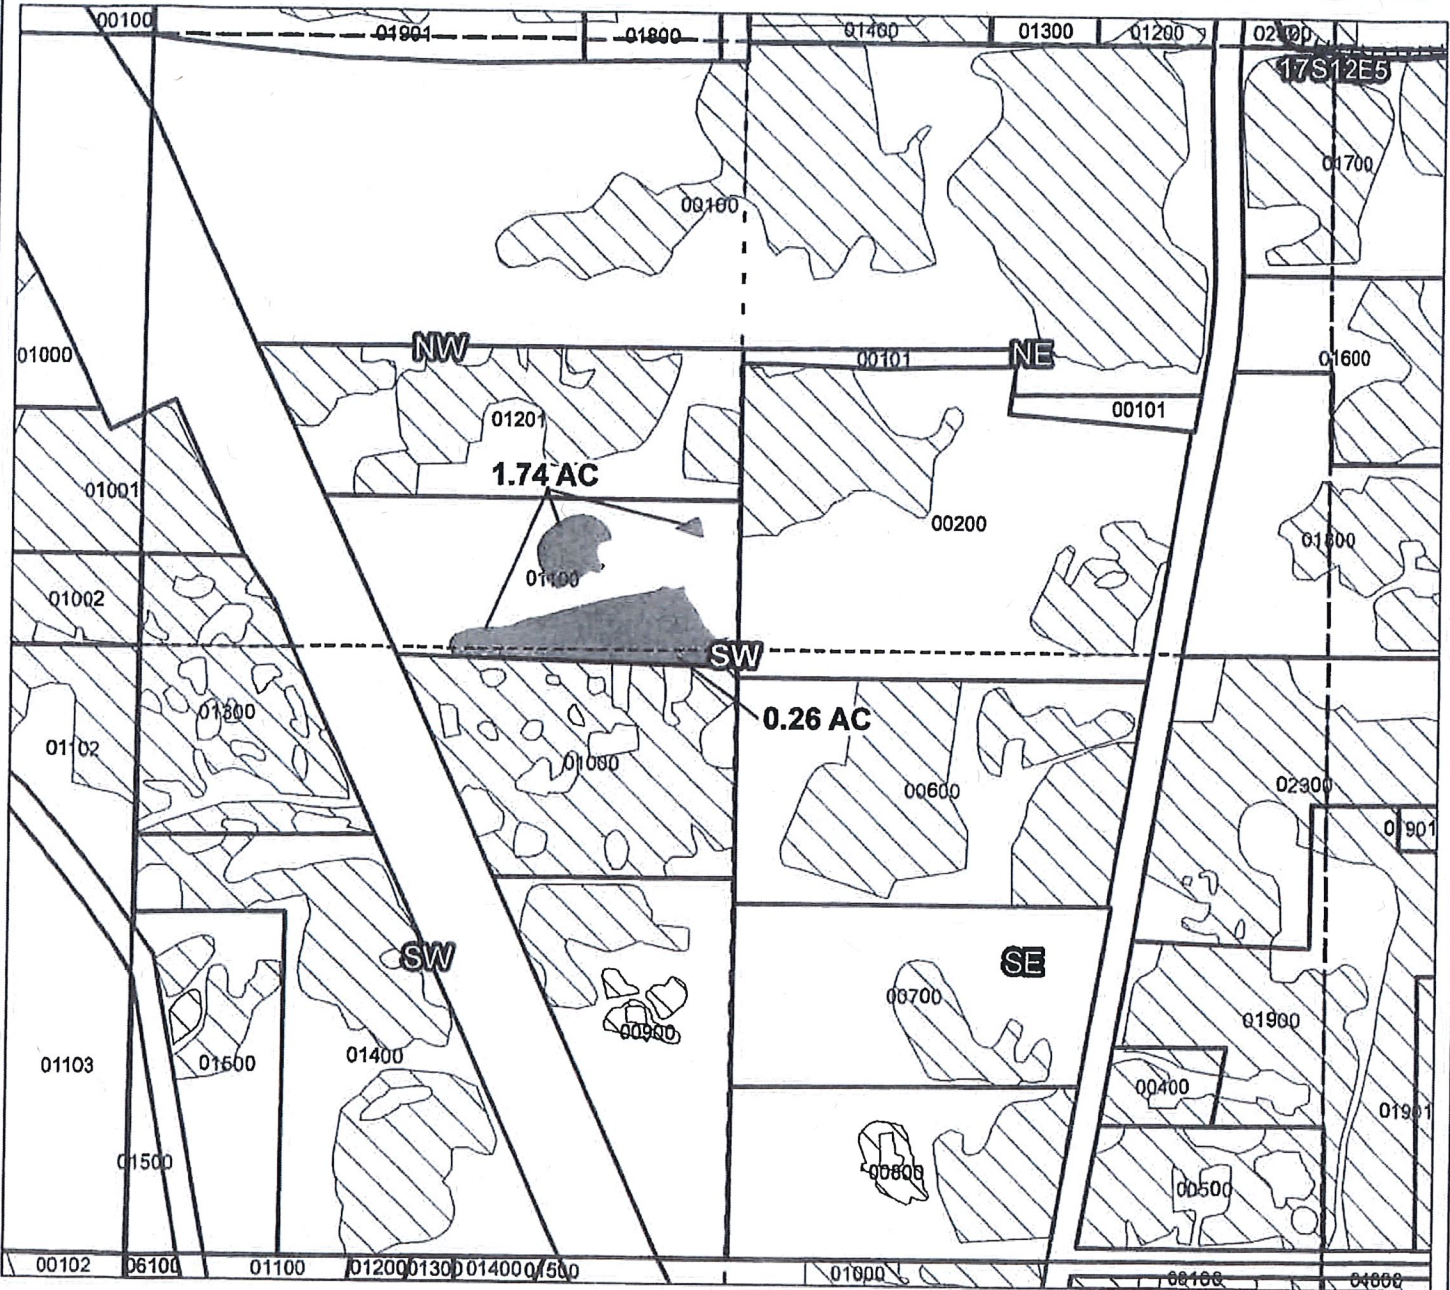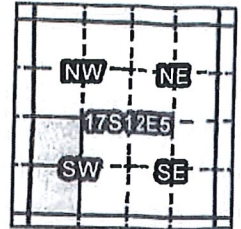

Taxlot 01100, 17S12E5NWSW: 1.74 ac. On, 10.64 ac. Total
Taxlot 01100, 17S12E5SWSW: 0.26 ac. On, 16.76 ac. Total

- Point of Diversion
- TTT Canals
- Taxlots
- Transfer
- ▨ Cert 74145

Received by OWRD

SEP 30 2019

Salem, OR




1 inch = 400 feet

Swalley Irrigation District


2016 District Transfer T-12547

Claim of Beneficial Use Map

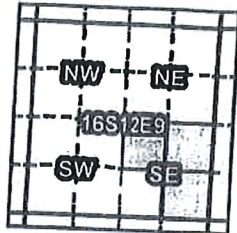

Certificates: 74145

for Shamrock Tarponaire, LLC

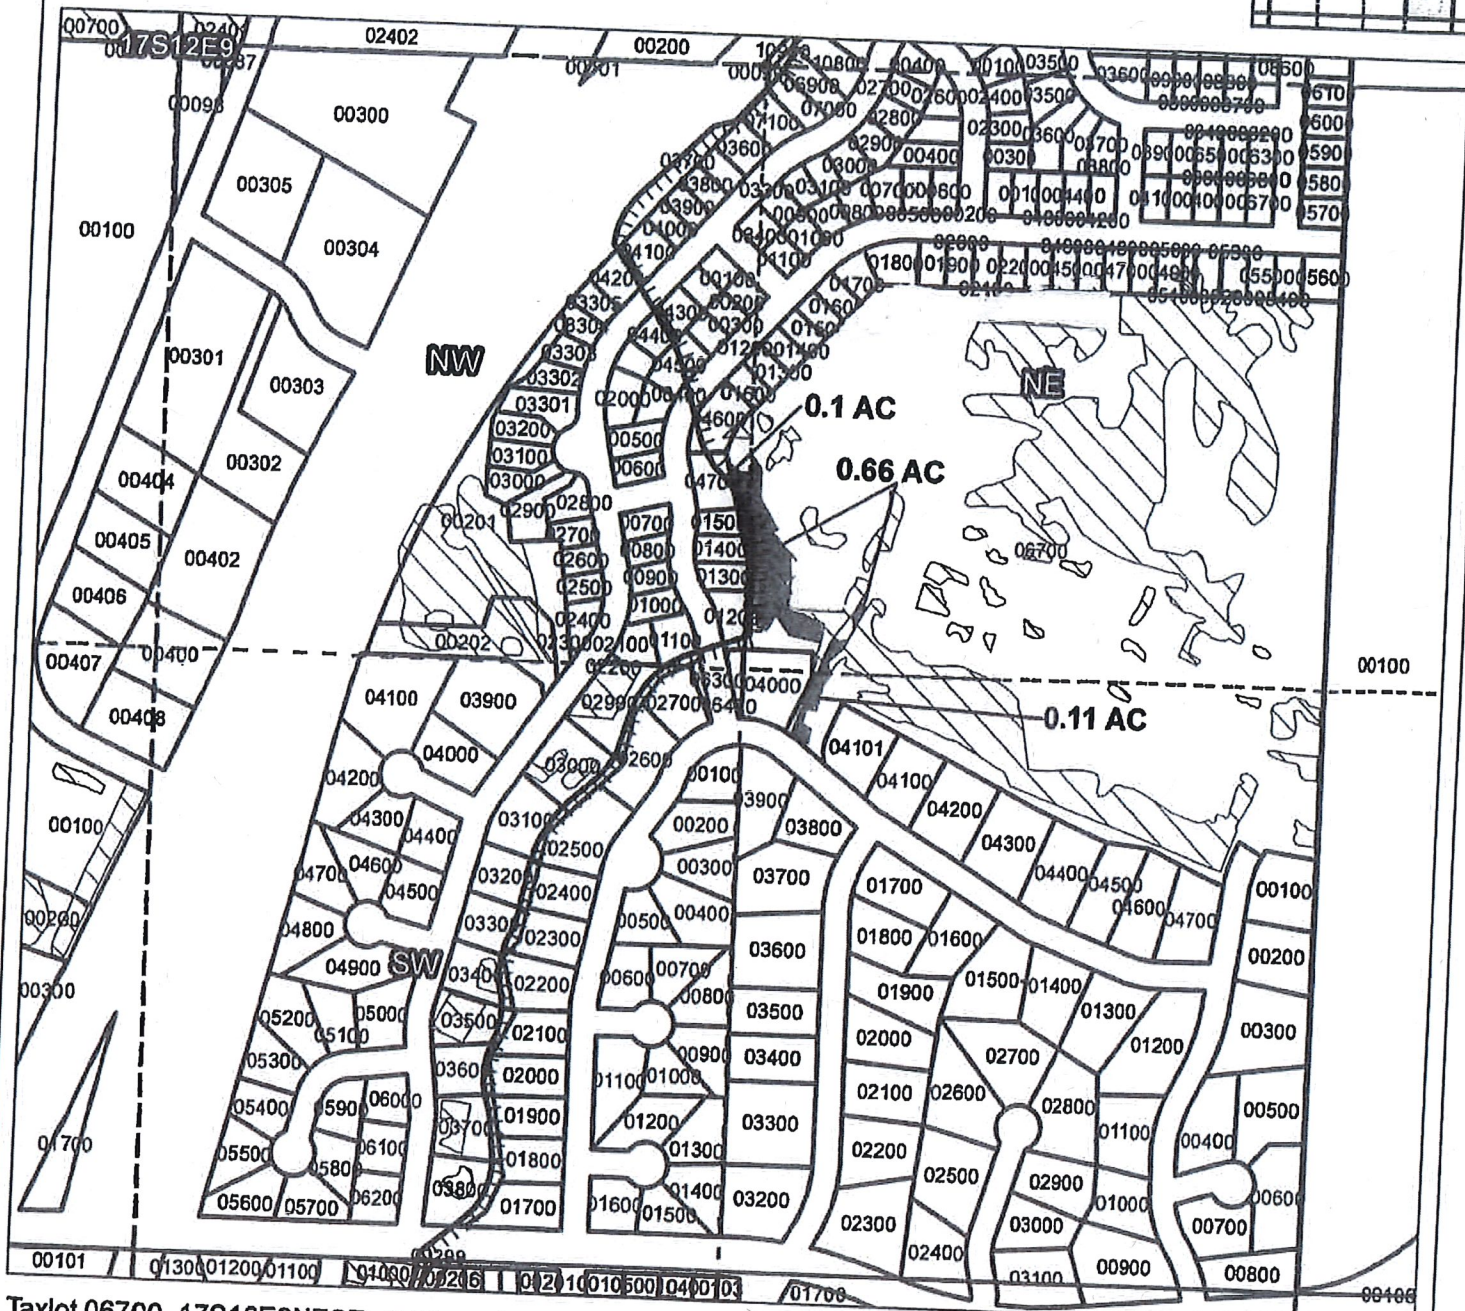

Taxlot 06700, 17S12E9NESE: 0.66 ac. On, 8.89 ac. Total
 Taxlot 06700, 17S12E9NWSE: 0.1 ac. On, 5.0 ac. Total
 Taxlot 06700, 17S12E9SESE: 0.11 ac. On, 2.21 ac. Total

Received by OWRD

SEP 30 2019

Salem, OR

- Point of Diversion
- Canals
- Taxlots
- Transfer
- Cert 74145



1 inch = 400 feet