



SECTION 30, T.1 S., R.3 W., W.M.  
WASHINGTON COUNTY OREGON

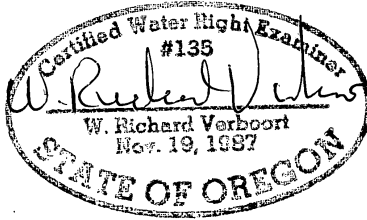

PREPARATION OF THIS MAP IS FOR THE PURPOSE OF IDENTIFYING THE LOCATION OF THE WATER RIGHT ONLY. THERE IS NO INTENT TO PROVIDE DIMENSIONS OR LOCATION OF PROPERTY OWNERSHIP LINES.

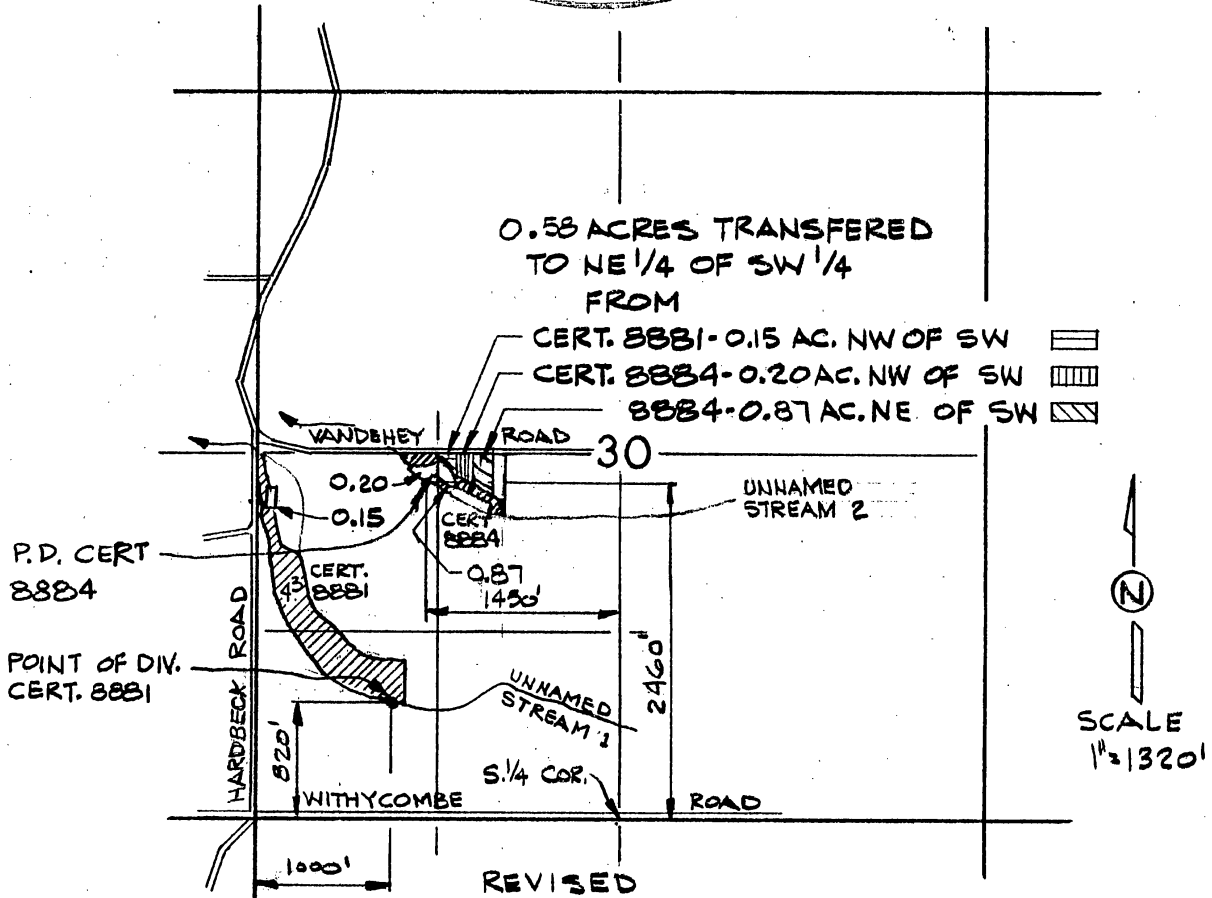

REVISED  
FINAL PROOF SURVEY  
FOR  
TRANSFER T-6065  
FISHER FARMS  
GASTON, OR

SURVEYED 8-6-96

PREPARED BY  
W. RICHARD VERBOORT, P.E.  
CIVIL ENGINEER  
HILLSBORO, OREGON

DRAWING # 96-A-04

RECEIVED

AUG 28 1996

WATER RESOURCES DEPT.  
SALEM, OREGON