


13301 -

RECEIVED
DEC 06 2019
OWRD

Application for Permanent Water Right Transfer Certificate 49788

Township 12S, Range 1W, W.M.

0 200 400 800 Feet

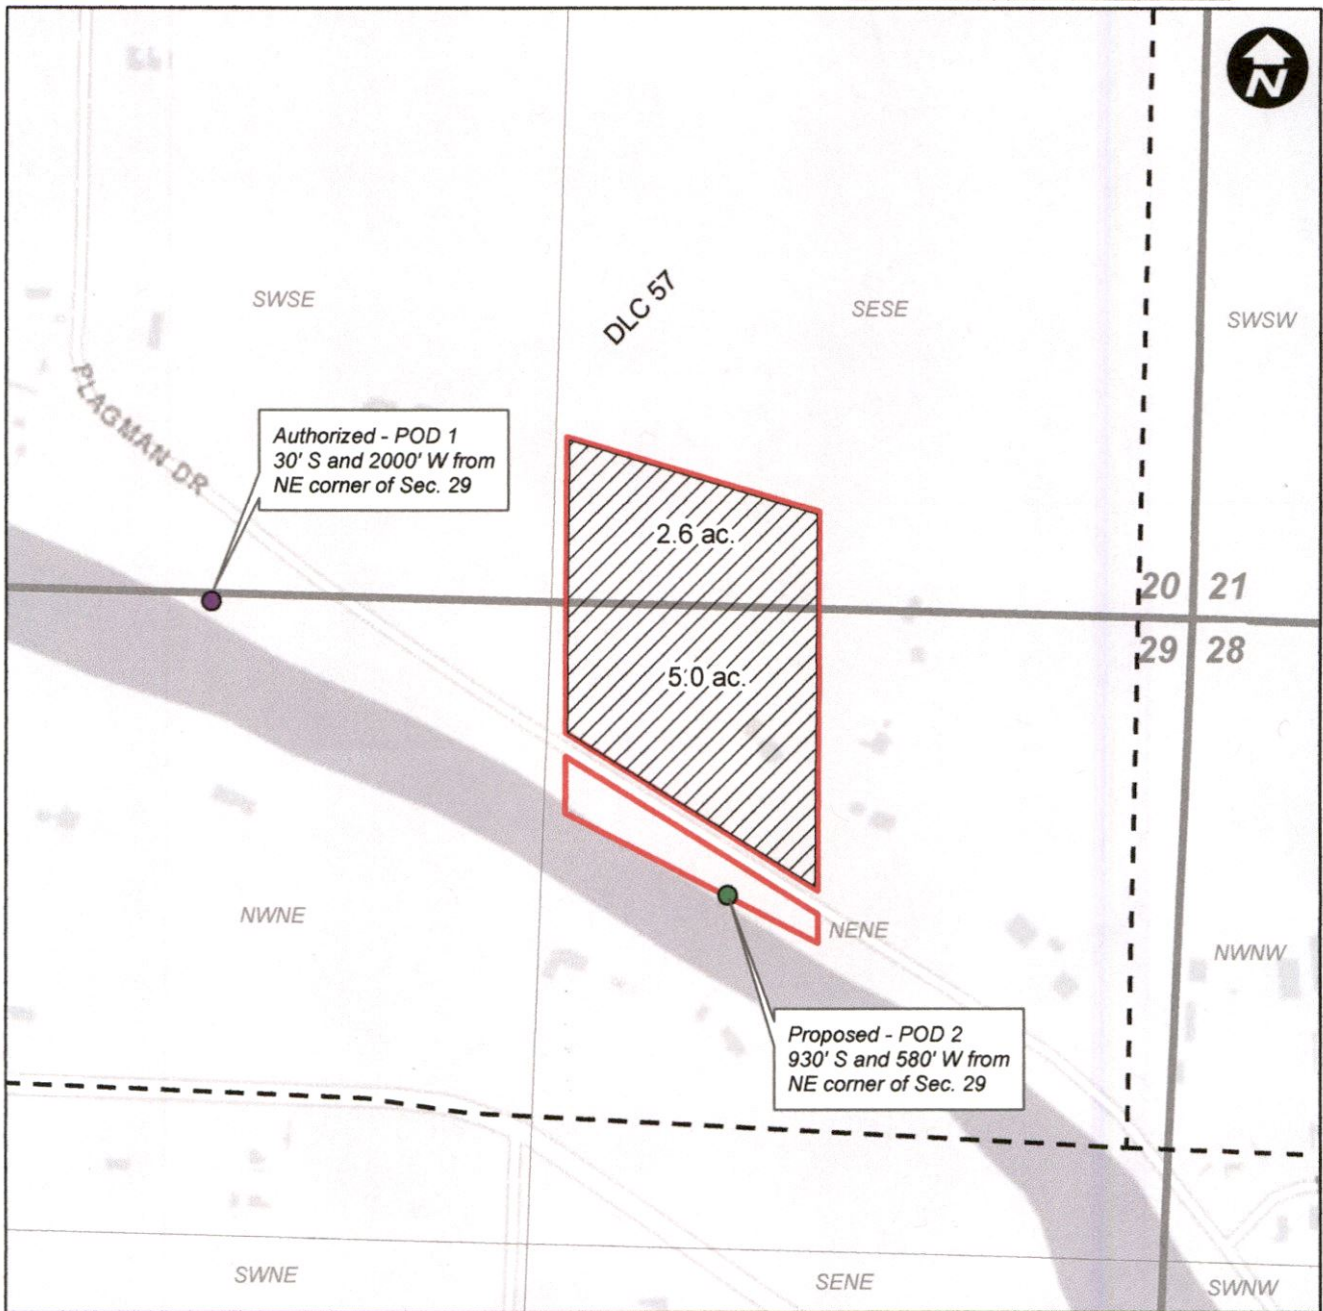

WILL MCGILL SURVEYING LLC

15333 Pletzer Rd. SE
Turner, OR 97392
503-510-3026
willmcgill.surveying@gmail.com



EXPIRES: 12/31/2020

Legend

- Cert. 49788 POU
- Taxlot 107
- DLC

RECEIVED

DEC 06 2019

OWRD

13301-