

# T.6S. R.2W. Sec. 8 & 9, W.M.

Proposed Well (MARI 4175) is located 860 feet north and 485 east from the SW corner, Section 9.


 "To" Area (15.7 Acres) to be irrigated under this right, priority date 8-1-58 affected by this transfer.

 Area (5.3 Acres) irrigated under Certificate 30812, priority date 8-1-58, not affected by this transfer.

----- Tax lot boundary

———— Donation Land Claim boundary

..... Water main line

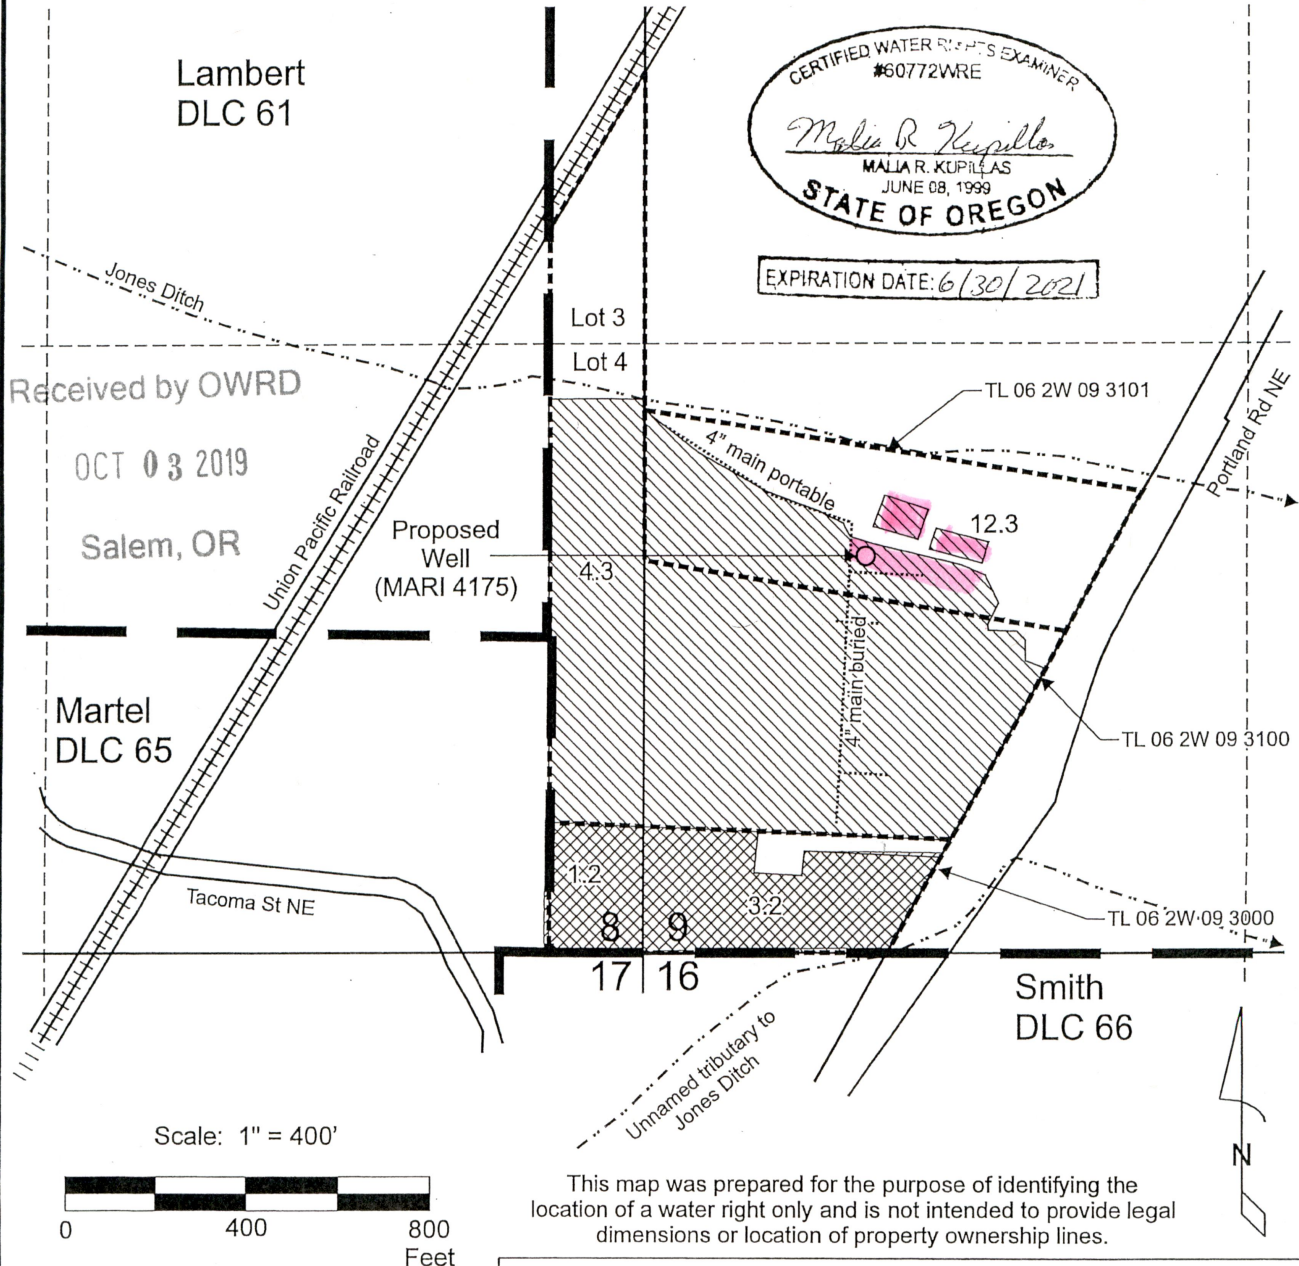

This map was prepared for the purpose of identifying the location of a water right only and is not intended to provide legal dimensions or location of property ownership lines.

Transfer Application "To" Map  
Certificate 30812

Brooks Tree Farm  
T.6S. R.2W. Sec. 8 & 9, W.M.

Pacific Hydro-Geology Inc.

06/2018  
Rev 09/2019


# T.6S. R.2W. Sec. 8 & 9, W.M.

Authorized Well (Unknown Well Log) is located 3.5 chains north and 4 chains east from the SW corner, Section 9.

 "From" Area (15.7 Acres) irrigated under Certificate 30812, priority date 8-1-58, affected by this transfer.

 Area (5.3 Acres) irrigated under Certificate 30812, priority date 8-1-58, not affected by this transfer.

----- Tax lot boundary      ——— Donation Land Claim boundary      ..... Water main line

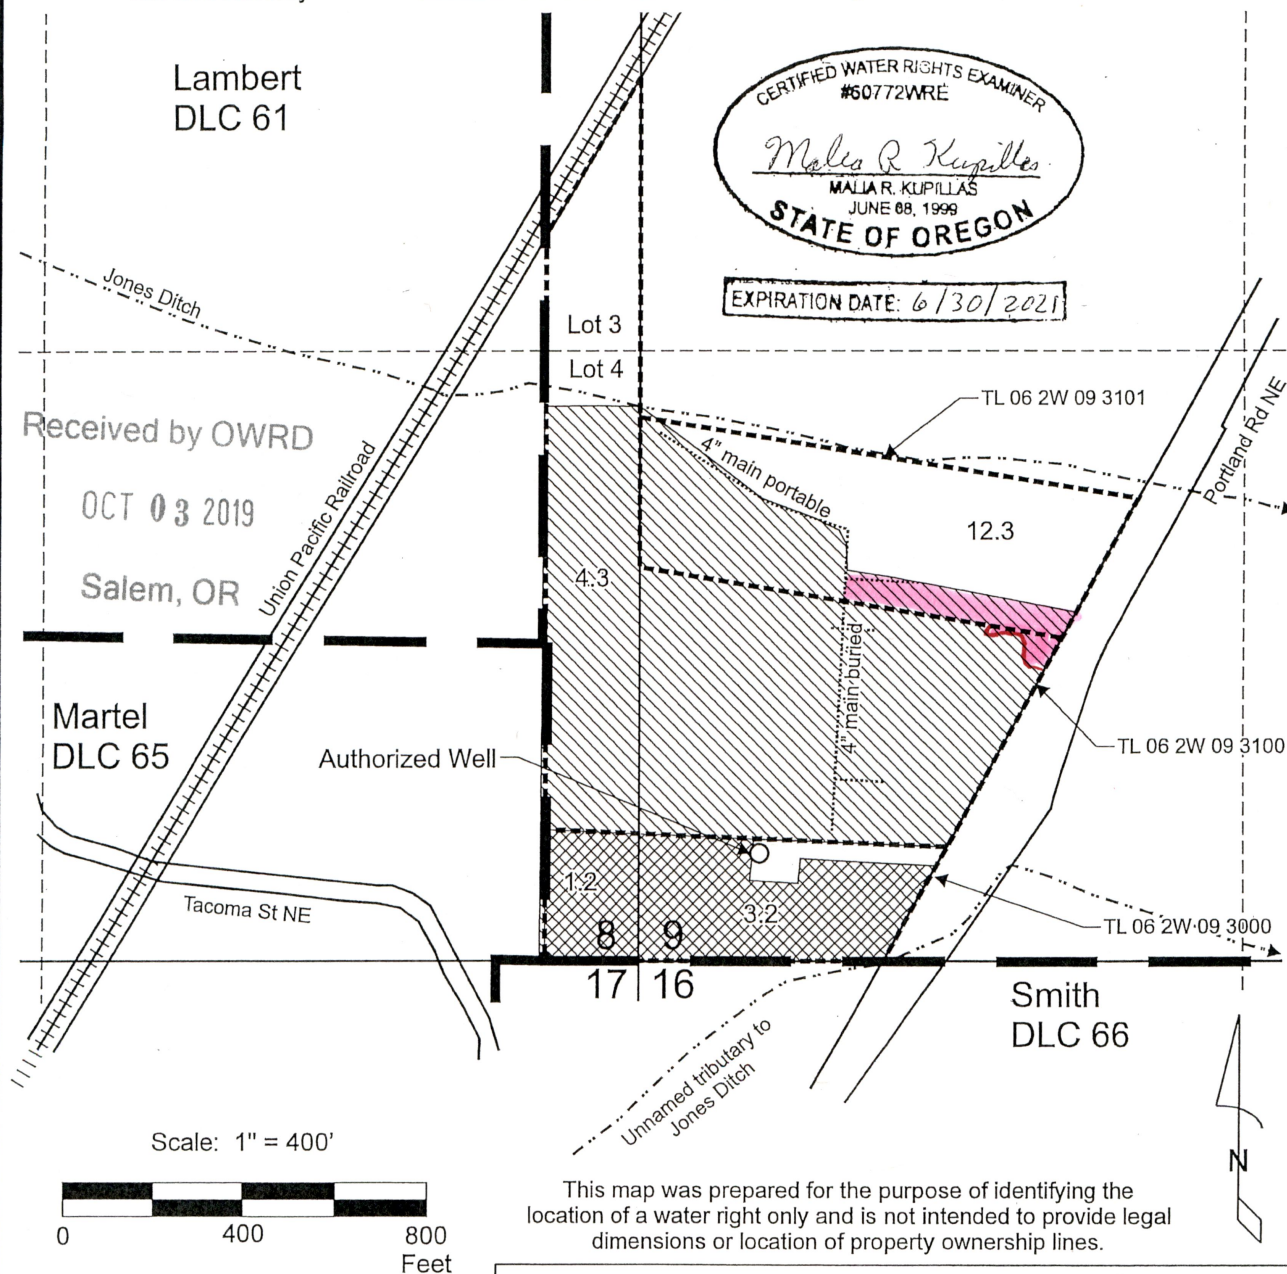

This map was prepared for the purpose of identifying the location of a water right only and is not intended to provide legal dimensions or location of property ownership lines.

Transfer Application "From" Map  
Certificate 30812

Pacific Hydro-Geology Inc.

06/2018  
Rev 09/2019

Brooks Tree Farm  
T.6S. R.2W. Sec. 8 & 9, W.M.