


**Claim of Beneficial Use Map - T-12656**  
 Middle Fork Irrigation District, (property owner = Lava Nursery)  
 Acreage Transferred ON: 2.0 ac.  
 Primary Certificate - 89317  
 Supplemental Certificate - 89320, 89321  
 Place of Use- 1 South, 10 East, Section 7, NWNW, taxlot 1502

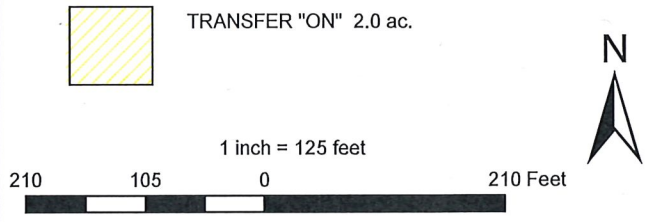

Received by OWRD  
 FEB 06 2020  
 Salem, OR