


Claim of Beneficial Use Map - T-13172
Middle Fork Irrigation District (property owner = Rice)

Primary Certificate: 74264
Supplementary Certificate: 89321, 89356
Township 1 South, Range 10 East, Section 20, NW/NW (taxlot 400 and 401)

TAXLOT 401 (NWNW):
0.9 ac = on

TAXLOT 401 (NENW):
8.35 ac = on

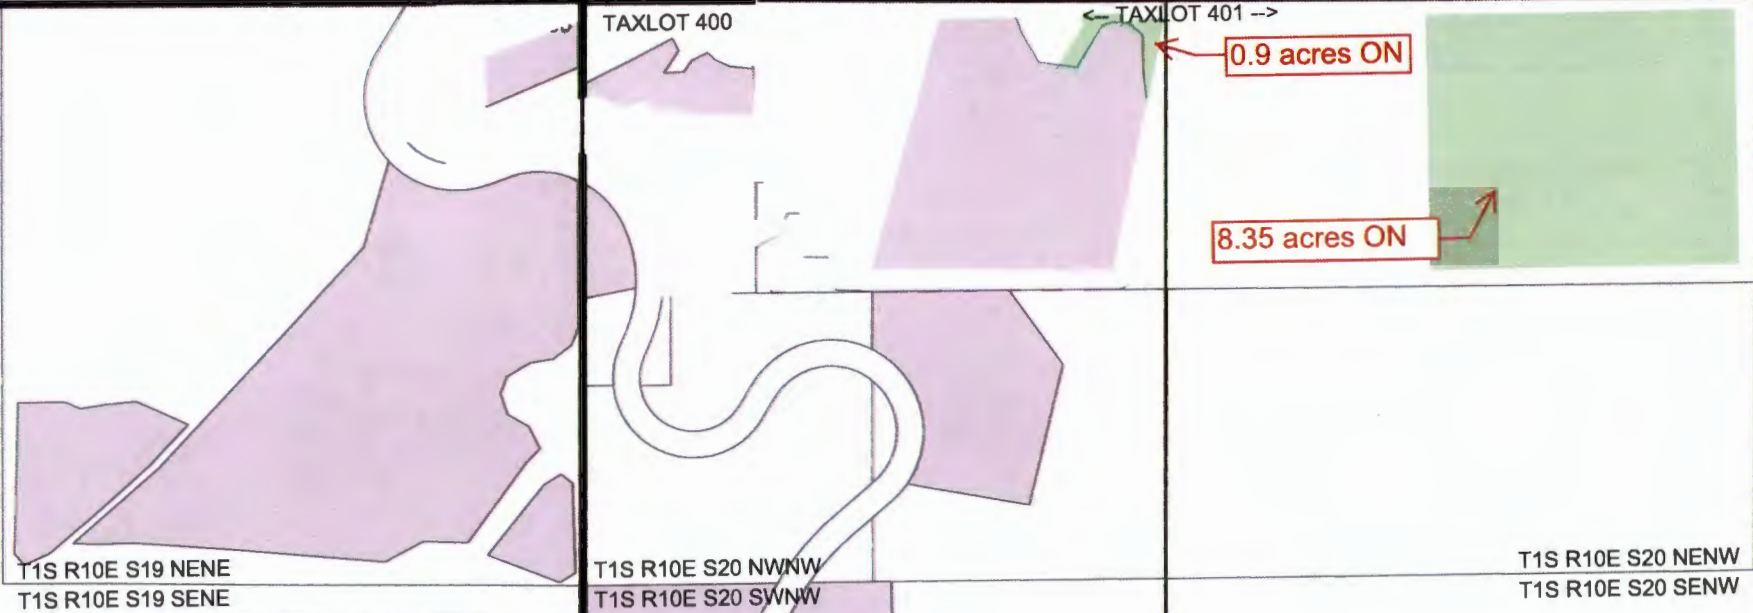

↑ North Scale (1" = 400')

EXISTING

ON

RECEIVED
JAN 23 2020
OWRD

Claim of Beneficial Use Map - T-13172
Middle Fork Irrigation District (property owner = Rice)

Primary Certificate: 89317
Supplementary Certificate: 89320, 89321
Township 1 South, Range 10 East, Section 20, NW/NW (taxlot 400)

TAXLOT 401 (NWNW):
0.2 ac = on

TAXLOT 100

TAXLOT 400

← TAXLOT 401 →

0.2 acres ON

T1S R10E S19 NENE
T1S R10E S19 SENE

T1S R10E S20 NWNW
T1S R10E S20 SWNW

T1S R10E S20 NENW
T1S R10E S20 SENW

↑ North Scale (1" = 400')

EXISTING

ON

RECEIVED
JAN 23 2020
OWRD