

T-12840 Claim of Beneficial Use Map

PREPARED FOR:
TUALATIN VALLEY IRRIGATION DISTRICT
2330 ELM STREET
FOREST GROVE, OR 97116

PREPARED FOR:
KEVIN & CARRIE DUYCK TRUST
37995 NW HARRINGTON RD
CORNELIUS, OR 97113

SECTION 11, T1N, R4W, WM
TAX MAP 1N 4W 11
WITHIN THE LOUSIGNOUT DLC #52
WASHINGTON COUNTY, OREGON

CERTIFICATE 53836

18 ACRES IN THE NW OF SE AND
12 ACRES IN THE NE OF THE SE QTR

CERTIFICATE 88122 (P)

22 ACRES IN THE SW OF
NW AND 8 ACRES IN THE SE OF THE
NW FOR REMAINING RIGHT SEE
TUALATIN VALLEY IRRIGATION DISTRICT

CERTIFICATE 81270 (S) (C)

22 ACRES IN THE SW
OF THE NW QTR AND 8.0 ACRES IN
THE SE OF THE NW

CERTIFICATE 88122 PRIME
Remaining Right

CERTIFICATE 53836 (P)-CF
VANDEHAY

RECEIVED


Received by OWRD
FEB 14 2018

FEB 14 2018 OWRD

Salem, OR



Project: 315-067
By: JEFFREY KEE
Date: JAN 26, 2018

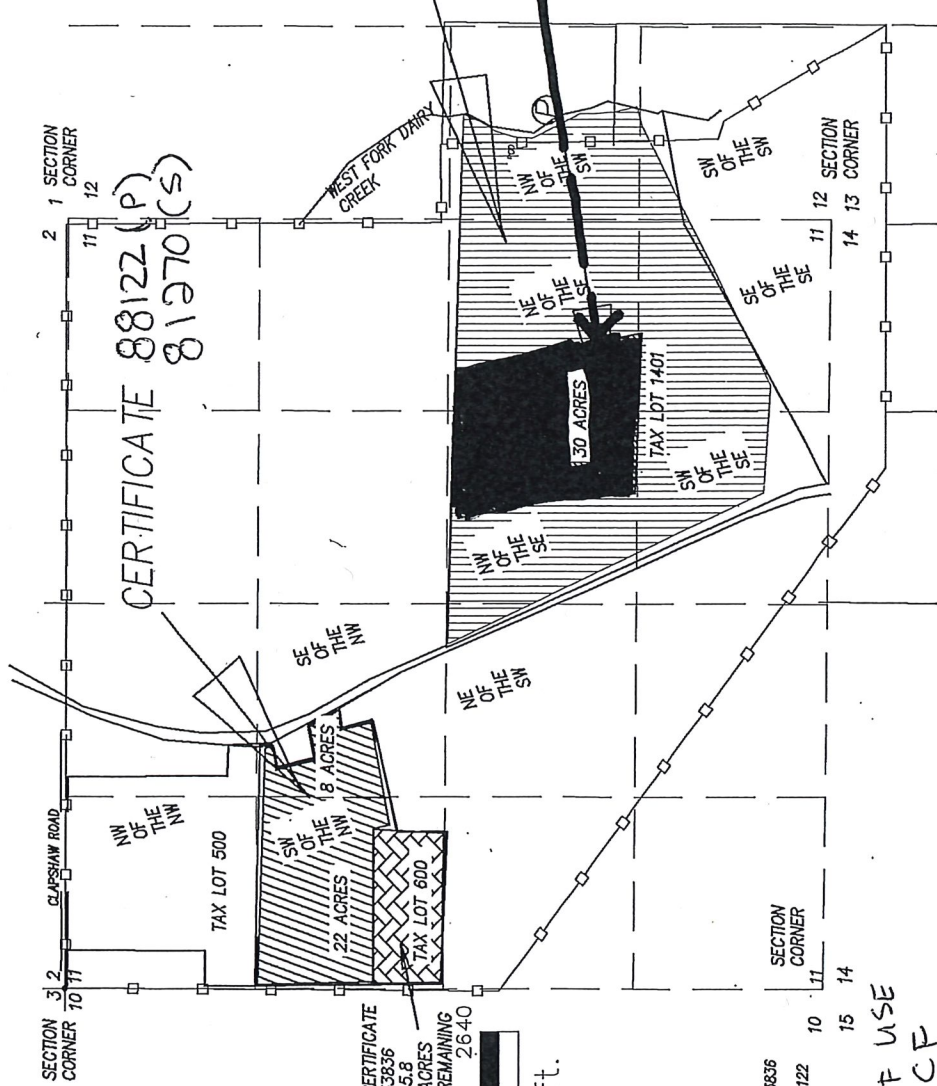

1 inch = 1320 ft.

- LEGEND
- (P) POINT OF APPROPRIATION
 - PROPERTY BOUNDARY LINE
 - 1/16TH SECTION LINE
 - [Cross-hatched box] REMAINING ACREAGE CERT 53836
 - [Diagonal lines box] NEW PLACE OF USE CERT 88122
 - [Dotted box] DONATION LAND CLAIM # 52 LOUSIGNOUT
 - [Black box] NEW PLACE OF USE 53836-CF

THIS DRAWING IS INTENDED TO PROVIDE AN APPROXIMATE LOCATION FOR WATER RIGHTS.
IT IS NOT INTENDED, NOR DOES IT DEPICT PROPERTY BOUNDARIES.

T-12840