


CLAIM OF BENEFICIAL USE MAP FOR T-12605  
 IN THE NAME OF WILLOW CREEK DISTRICT IMPROVEMENT CO.  
 FOR MEADOWBROOK FARM, LLC  
 INVOLVING A CHANGE IN PLACE OF USE FOR PORTIONS OF  
 CERT 82490, CERT 82491, PERMIT S-54980 & PERMIT G-15586  
 T1&T2S, R25E W.M., MORROW COUNTY

RECEIVED

JAN 08 2019

OWRD

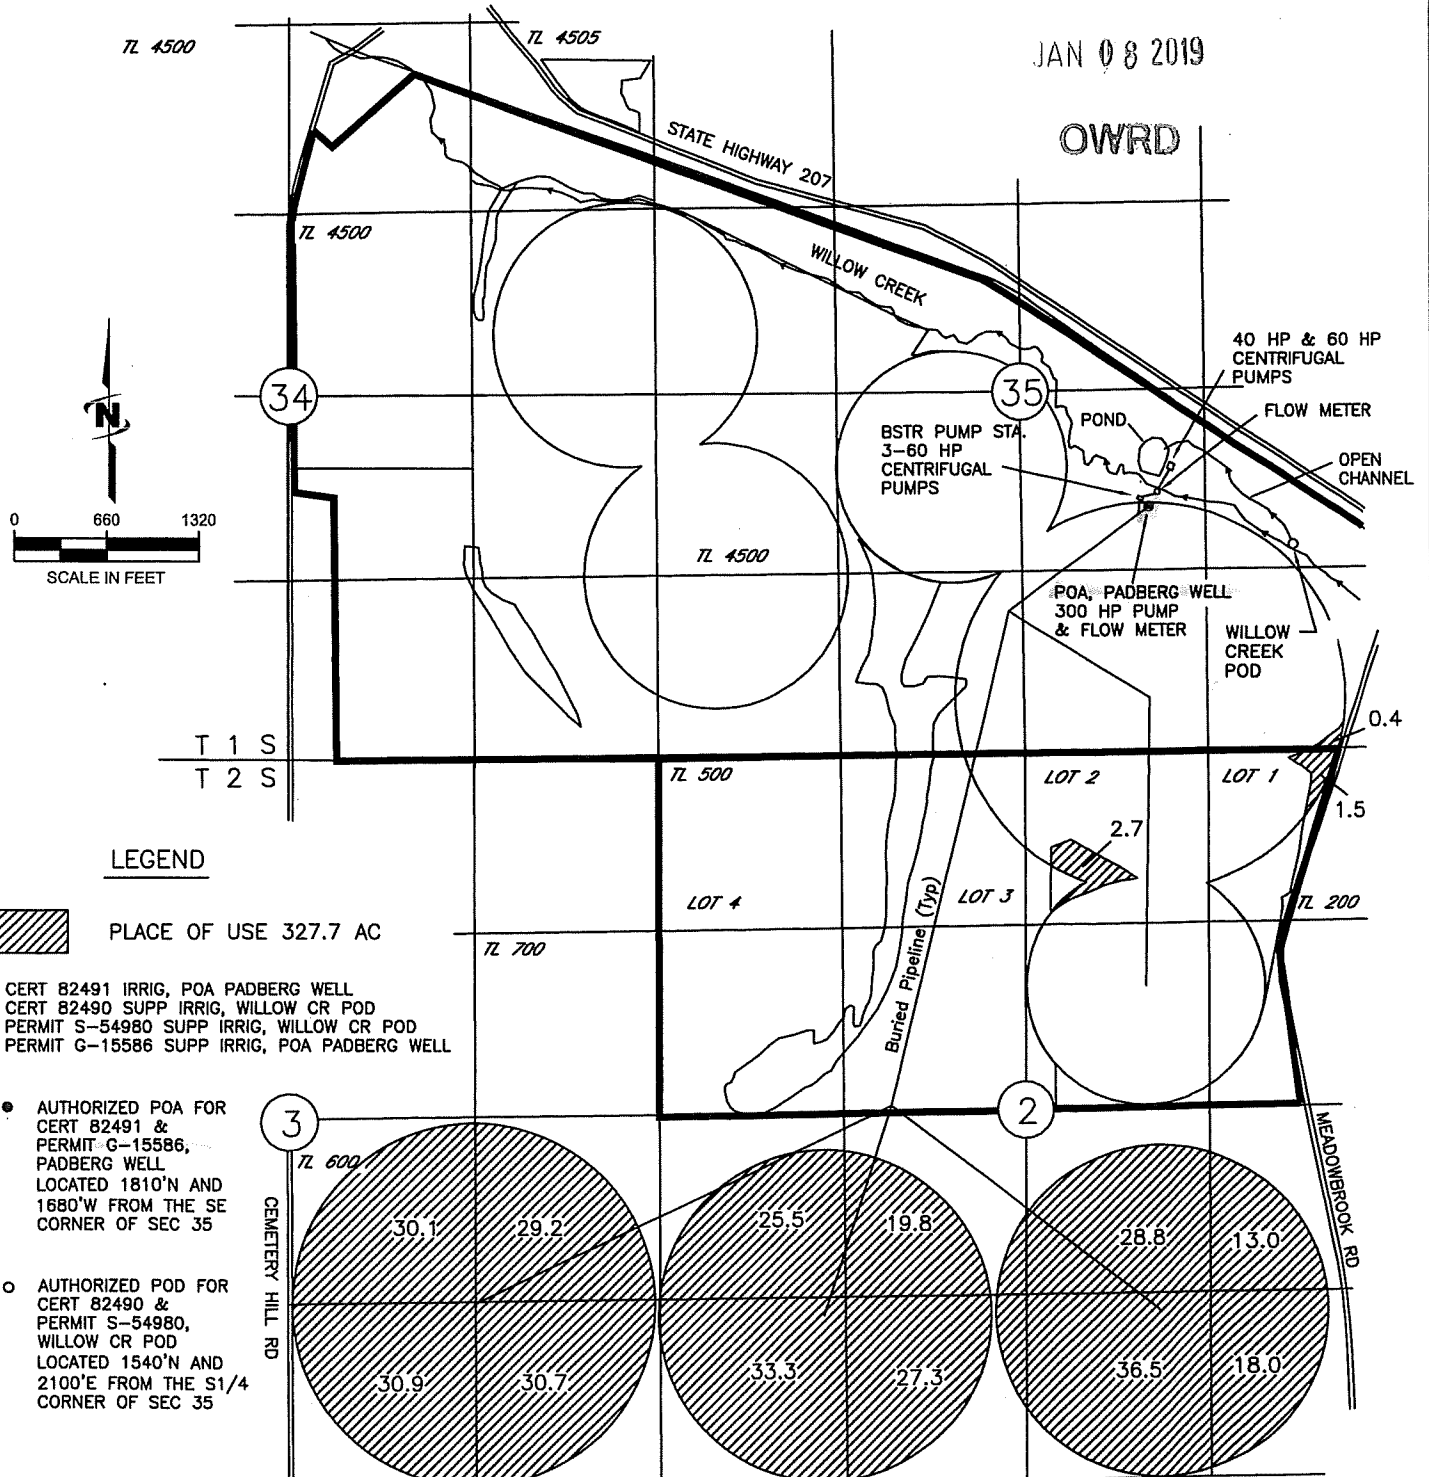

NOTE:  
 THE PURPOSE OF THIS MAP IS TO IDENTIFY THE APPROXIMATE LOCATION OF THE WATER RIGHT. IT IS NOT INTENDED TO PROVIDE INFORMATION RELATIVE TO THE LOCATION OF PROPERTY OWNERSHIP BOUNDARY LINES.

Map Prepared  
 12/21/2018  
 DGV Consulting, PLLC