


T.40S.R.12E.W.M.

FROM LAND

RECEIVED
APR 27 2020
OWRD

Start River Wells

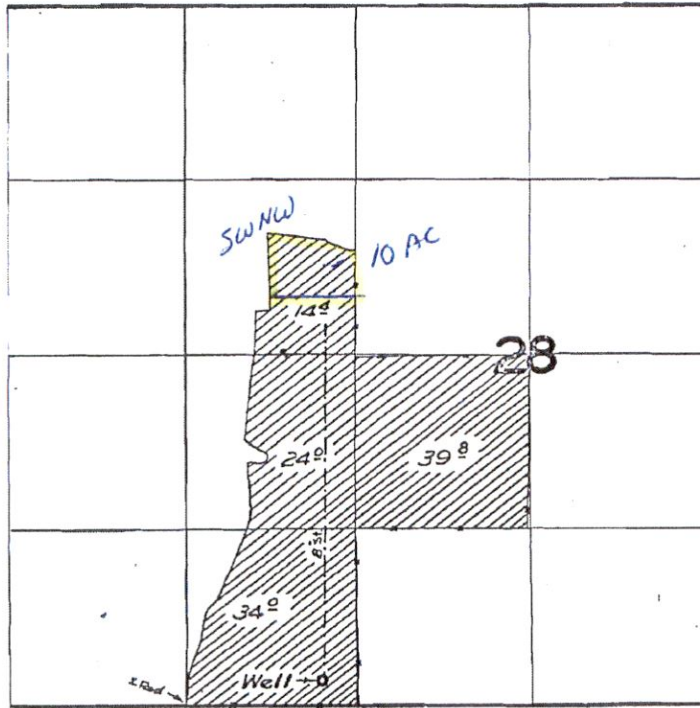

FINAL PROOF SURVEY

UNDER

Application No. G-379... Permit No. G-255

IN NAME OF

ALICE PEREIRA

Surveyed 21 Oct. 19 59., by *Paul B. Bish*

CNO-62K-36

MAP TO ACCOMPANY GROUND WATER APPLICATION

SITUATED IN THE SW1/4 NW1/4 AND SW1/4 OF SECTION 28,
AND THE W1/2 NW1/4 OF SECTION 33, T40S, R12EWM,
KLAMATH COUNTY, OREGON

MARCH 1992

APR 6 1992


Application No. 6-12860
Permit No. C12228

RECEIVED


APR 27 202

OWRD

MAP PREPARED FOR
-- WEYERHAEUSER CO. --

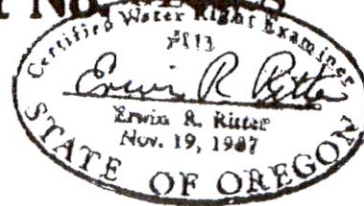

FROM
LAND

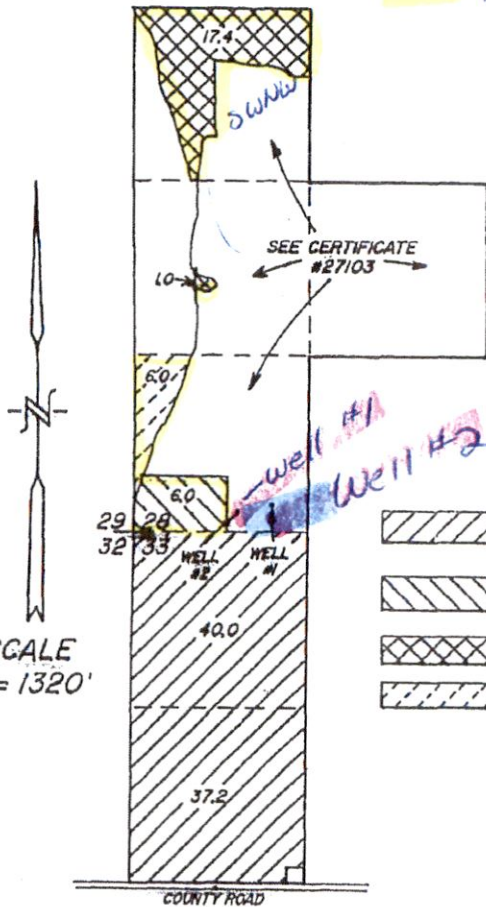

LOCATION OF WELL #1 BY CERTIFICATE #27103

200 FEET NORTH & 1040 FEET EAST OF
THE SOUTHWEST CORNER OF SECTION 28

LOCATION OF WELL #2 BY PERMIT #G-6345 (CANCELLED)

150 FEET NORTH & 790 FEET EAST OF
THE SOUTHWEST CORNER OF SECTION 28

LAND SUPPLEMENTAL TO SHASTA VIEW IRRIGATION DISTRICT, IRRIGATED FROM WELL #1	77.2 Ac.
LAND SUPPLEMENTAL TO PERMIT #G-255, IRRIGATED FROM WELL #2	6.0 Ac.
PRIMARY LAND FOR WELL #1	18.4 Ac.
PRIMARY LAND FROM WELL #2	6.0 Ac.

TOTAL AREA THIS APPLICATION

-- 107.6 Ac. --

MAP PREPARED FROM MAP OF PERMIT #G-6345, MAP OF PERMIT #G-255, AND AERIAL PHOTO.

ACREAGE OF LAND SUPPLEMENTAL TO SHASTA VIEW IRRIGATION DISTRICT ARE SHOWN AS QUOTED FROM DISTRICT OFFICE

THE PURPOSE OF THIS MAP IS TO IDENTIFY THE LOCATION OF THE WATER RIGHT. IT IS NOT INTENDED TO PROVIDE INFORMATION RELATIVE TO THE LOCATION OF PROPERTY OWNERSHIP BOUNDARY LINES.

TRU-LINE SURVEYING
2333 SUMMERS LANE
KLAMATH FALLS, OR. 97603

REVISED 03-03-14
THIS MAP WAS PREPARED FOR
ASSESSMENT PURPOSE ONLY

SECTION 33 T.40S. R.12E. W.M.
KLAMATH COUNTY
1"-400'

Map 4 of 4

RECEIVED

APR 27 2020

OWRD

NORTH

T40S R12E

Sec 33


Tax lot
801

13427

Musson

Scale

1"=880'

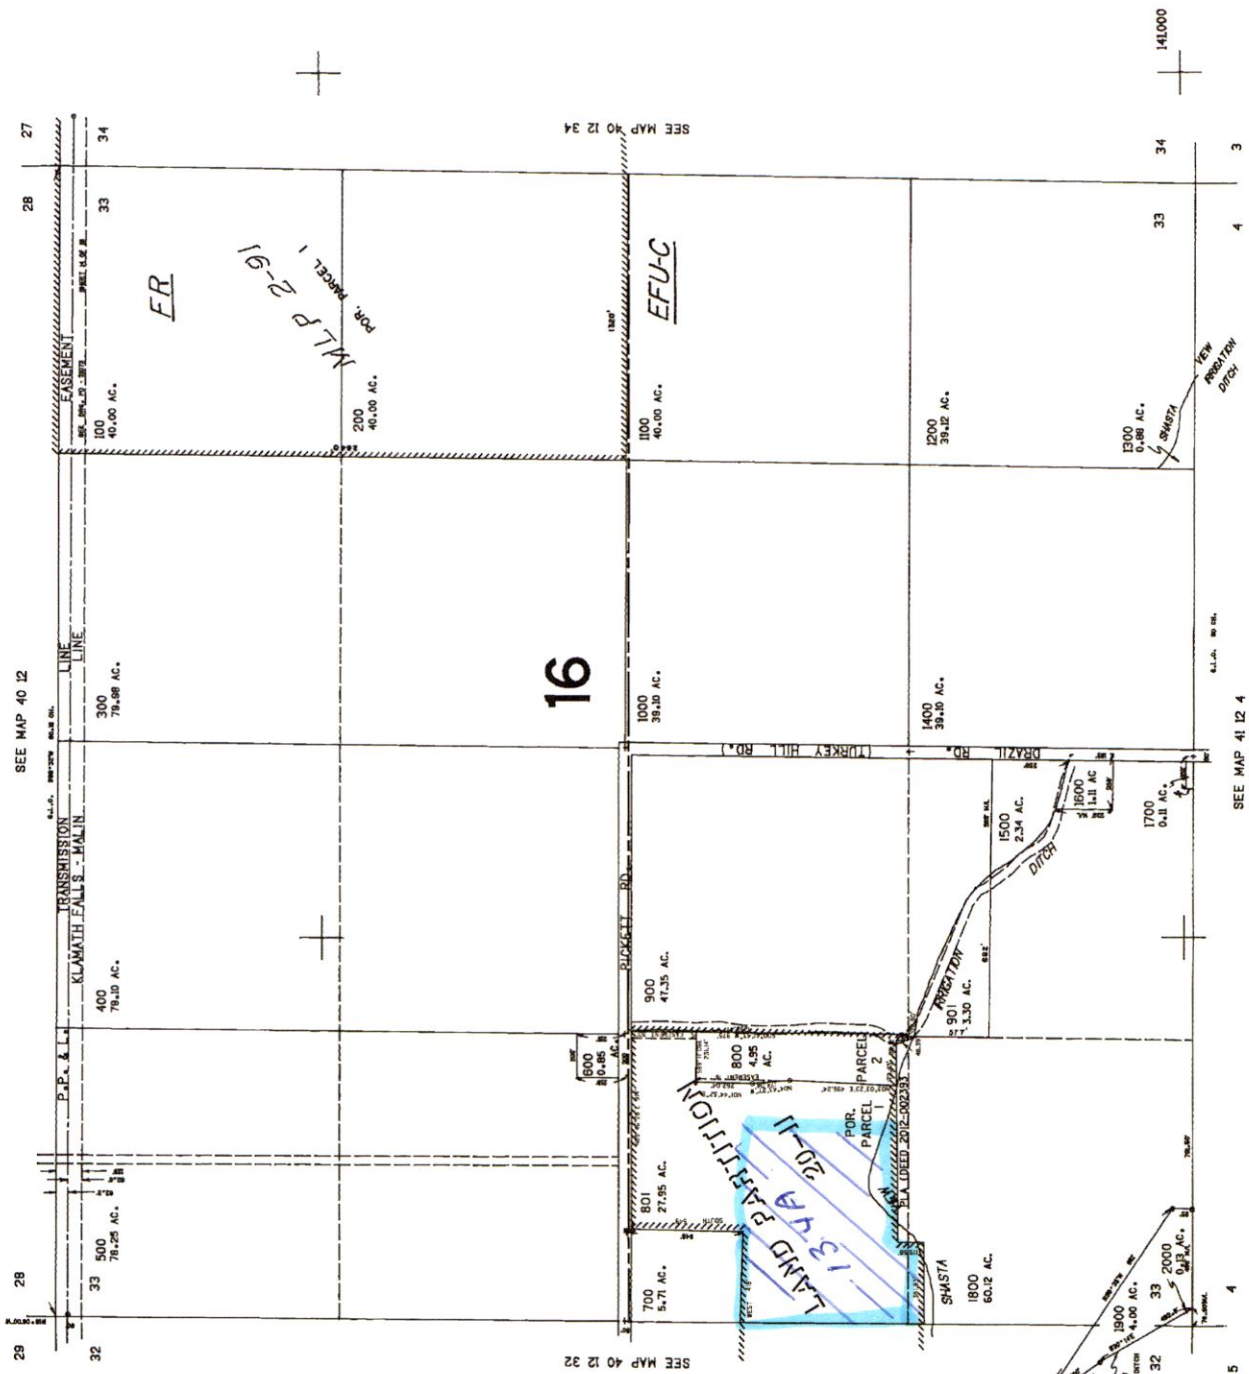

1750.000

40 12 33

40 12 33

