

RECEIVED


APR 27 2020


OWRD

Fiegel-Spaar Evidence of Use

Irrigated pasture July 2017 Imagery

Legend

 Evidence of Use, image 2017

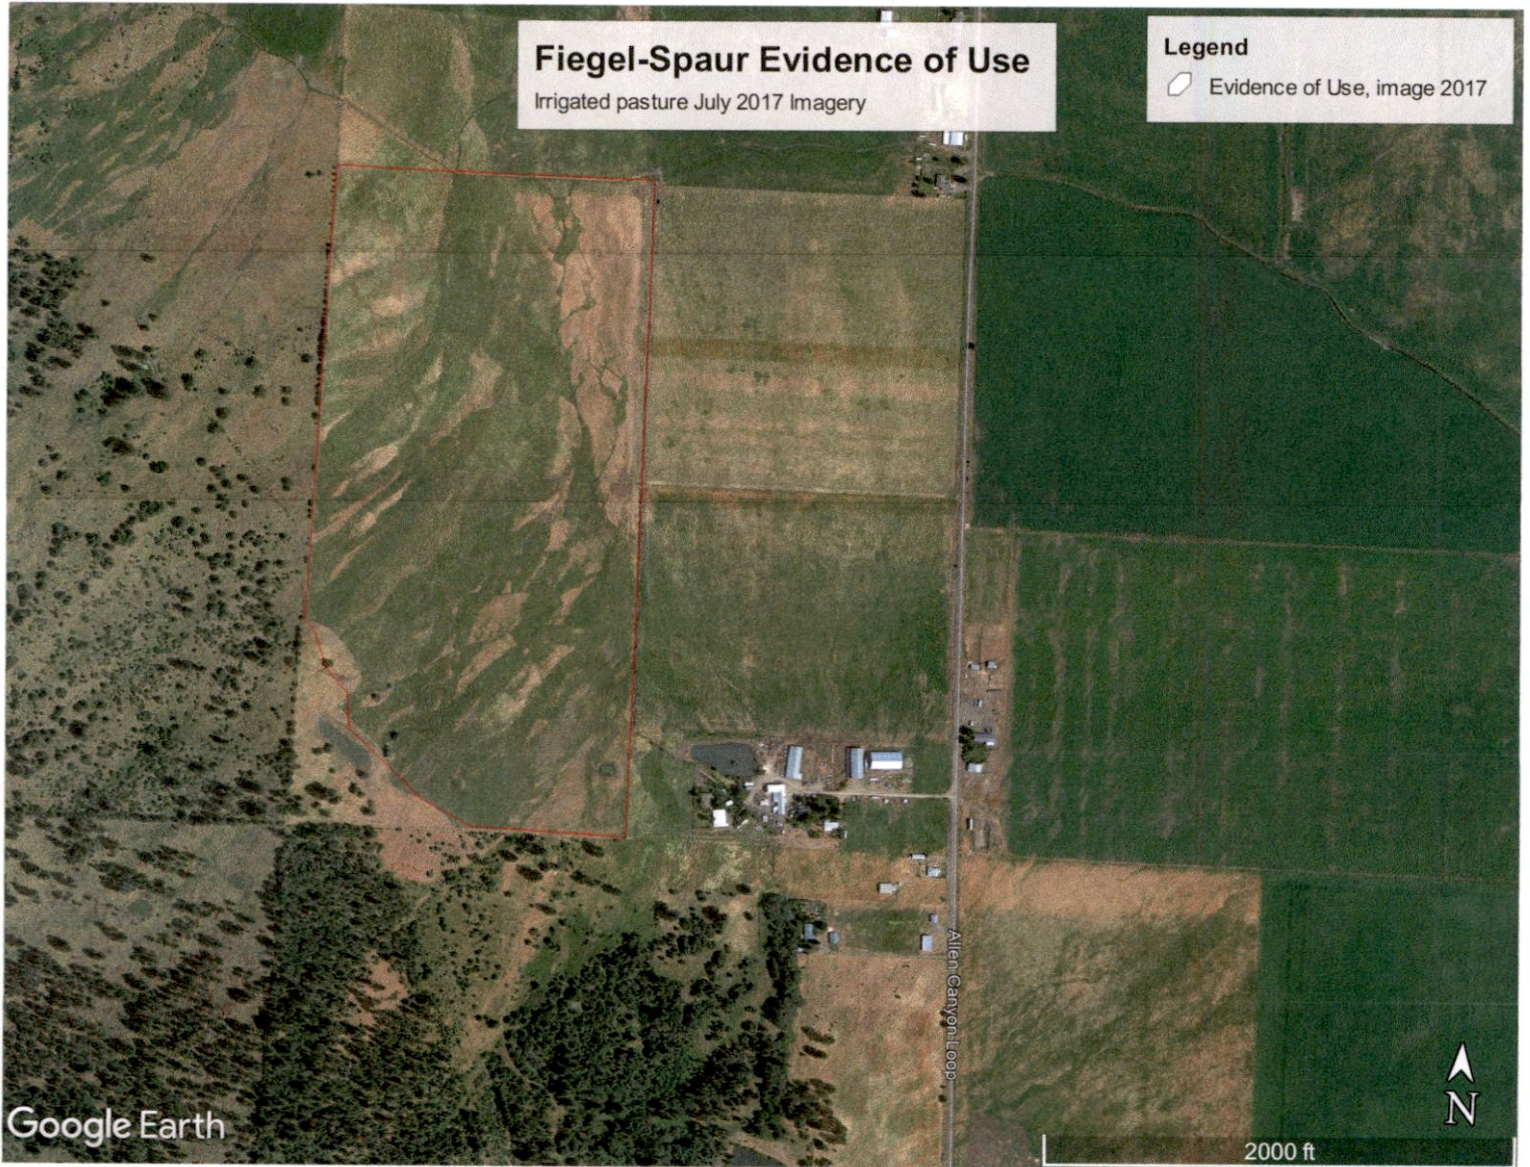

13428


RECEIVED

APR 27 2020

OWRD

Township 1 North Range 43 East

Note
This water will be divid
through the West side di
as it has been for 100 y
5 year pump transfer
Same Ditch
Point and di. vor

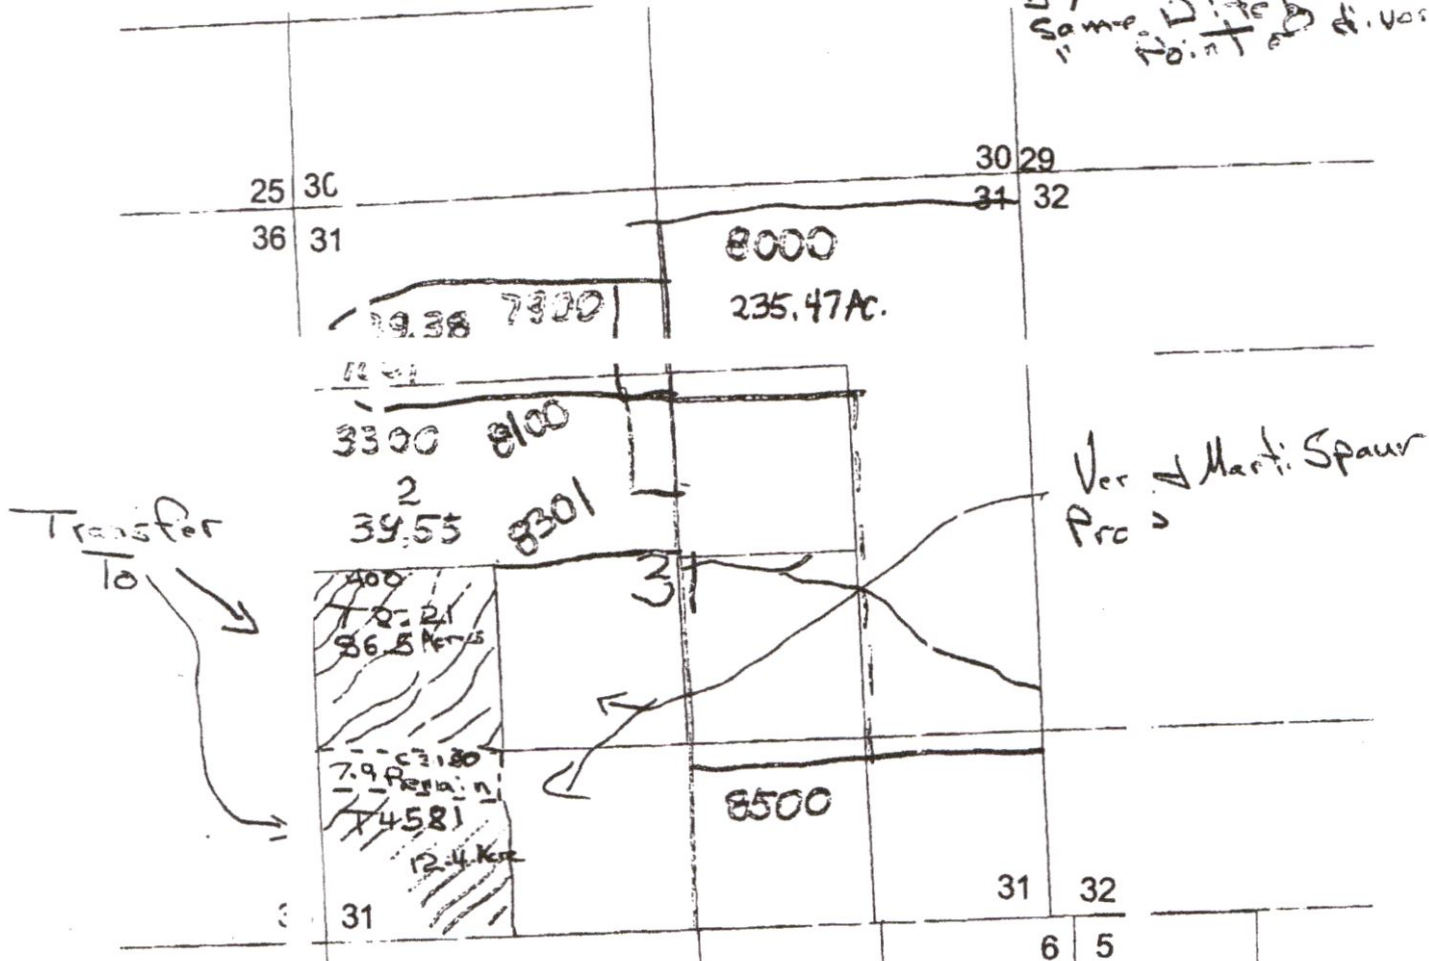


Legend Transfer to

This is the exact transfer as
last year only now a 5 year
transfer
Last year 749186

148.9

13428

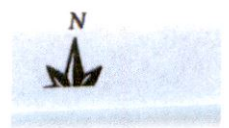

Map



FROM

T. 15., R. 43E., W. M.

RECEIVED

APR 27 2020

OWRD

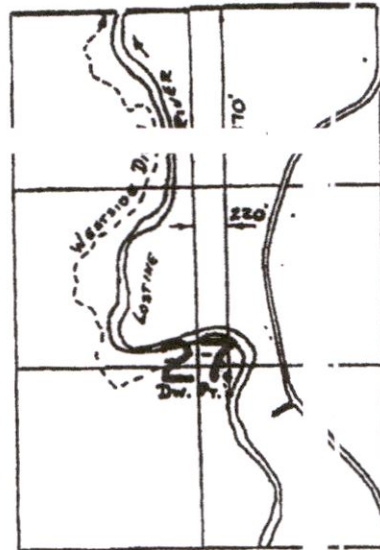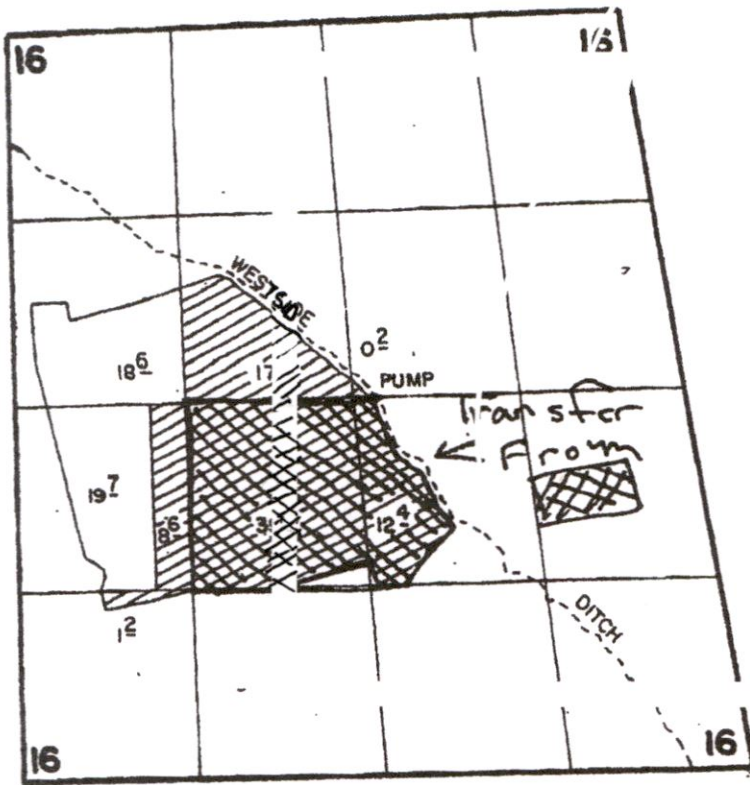

Tran #
T 9186



SCALE: 1" = 1320'

FINAL PROOF SURVEY
UNDER

51.7


Application No. **58547**. Permit No. **44274**

IN NAME OF

Kirby Fiegel
ARNILDO J. LIPPANO

Surveyed ..8..13..... 1985.., by ..X.L. CHURCH.....

13428

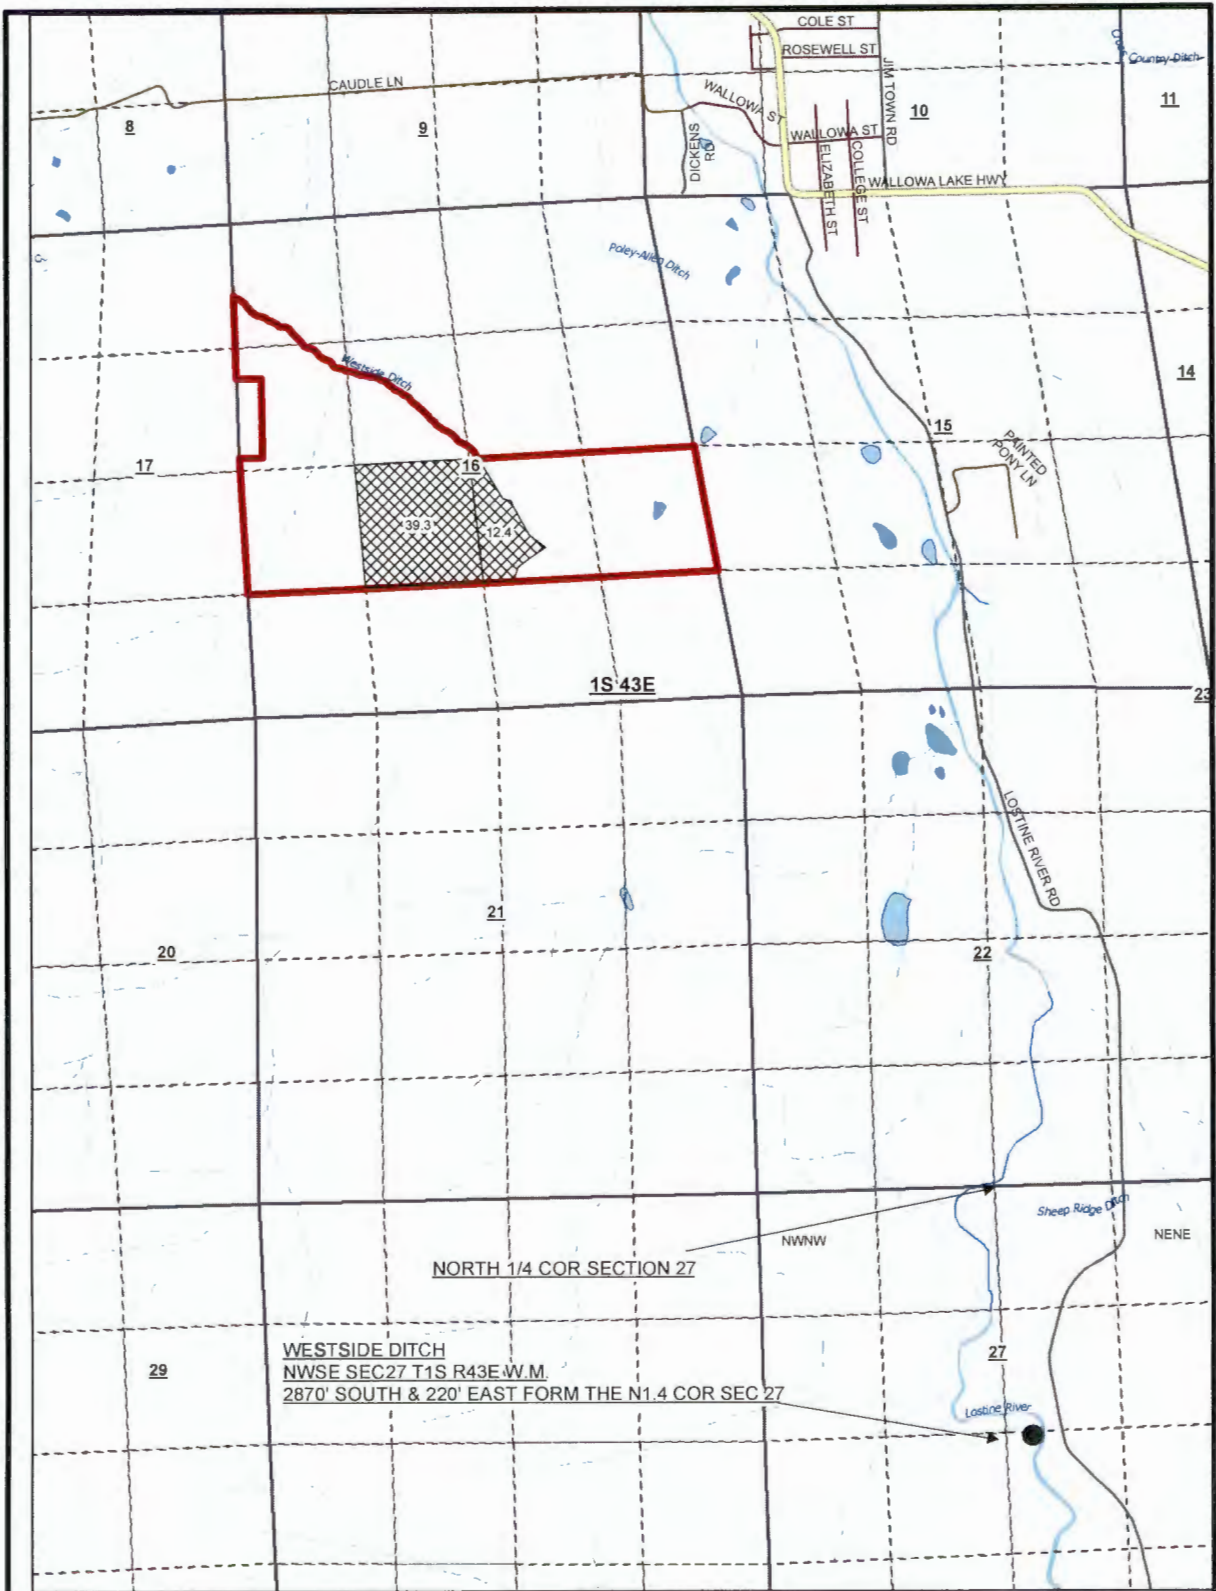


Fiegel Temp Transfer 2020

Map Disclaimer:
 This product is for informational purposes and may not have been prepared for, or be suitable for legal, engineering, or surveying purposes. Users of this information should review or consult the primary data and information sources to ascertain the usability of the information.
 This map is not intended to display property lines

Legend

	C66831 OFF 51.7ac		D7_Roads		TOWNSHIPS
	TL 2305		HWY		SECTIONS
			LN		D7_QQ
			RD		Stream, perennial
			ST		Stream, intermittent
					Stream, ephemeral
					Canal
					Connector
					Lake

SCALE 1in=1/4mile

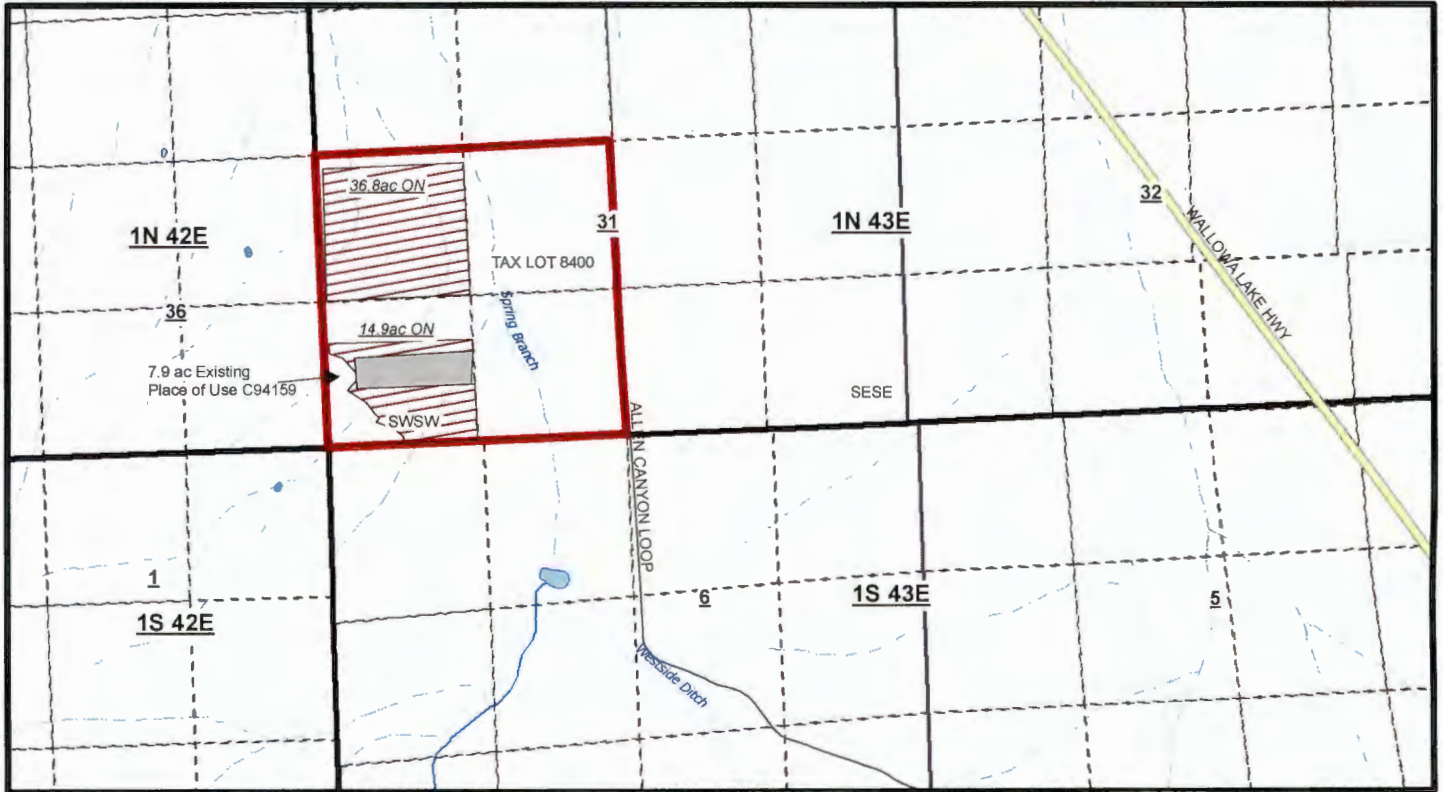

Fiegel 2020 Temp Transfer "ON Lands"

MAP 2 OF 2 SCALE 1in=1/4mile

Map Disclaimer:
 This product is for informational purposes and may not have been prepared for, or be suitable for legal, engineering, or surveying purposes. Users of this information should review or consult the primary data and information sources to ascertain the usability of the information.
 This map is not intended to display property lines

Disclaimer: This listing is the result of a manual search of the records of the Watermaster's Plat Cards and the WRUS database. The listing has not been field checked. That a right is of record is no guarantee that it has not been abandoned under the conditions of ORS 540.610. The plat card records of listed by the 40.0 acre quarter-quarter within a section. If the water right listed within a quarter-quarter is on more than one tax lot, this office has not identified that water rights for each tax lot - only a survey could accurately depict how much of the water rights are on each tax lot.

Legend

- | | | | |
|-----------|----------|----------------------|-------------------|
| C88831 ON | D7_Roads | Tax Lot Lines | TOWNSHIPS |
| C94159 | HWY | SESE | SECTIONS |
| | LOOP | QUARTER-QUARTERS | Stream, perennial |
| | | Stream, intermittent | Canal |
| | | Connector | Lake |

