


TOWNSHIP 5 SOUTH, RANGE 1 EAST, W.M.

MAR 15 1999

SALES TREASURY

WATER RIGHTS UNIT

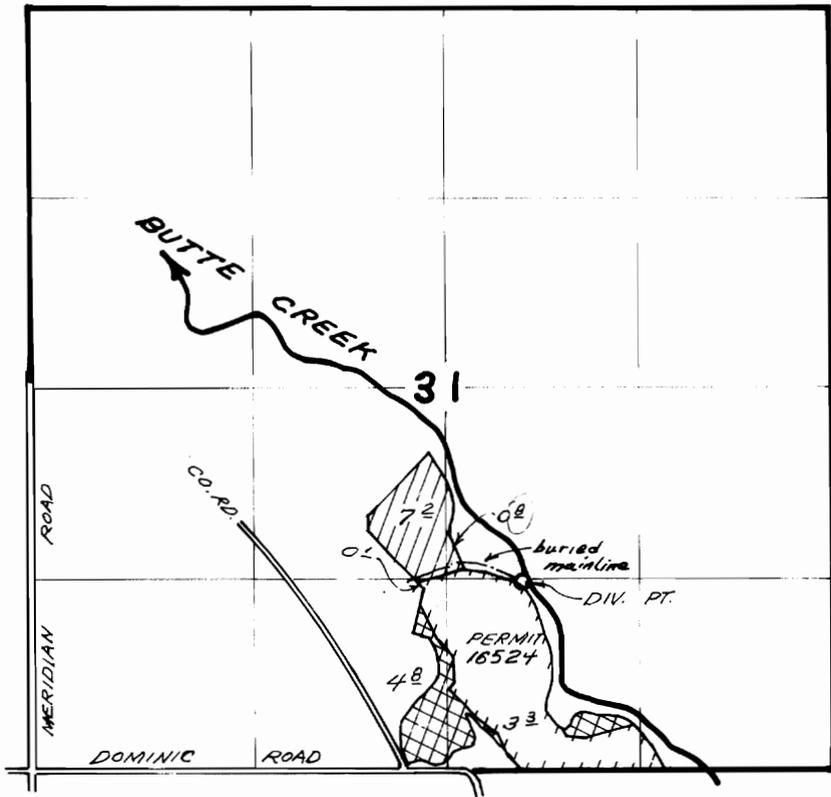

DIV. PT. LOCATED 1300' N. AND 500' E. FROM S. 1/4 COR. SEC. 31

FROM  TO  REMAINING 

FINAL PROOF SURVEY


UNDER

TRANSFER 6919

IN THE NAME OF

DICKMAN FARMS, INC.

FEB. 3, 1999

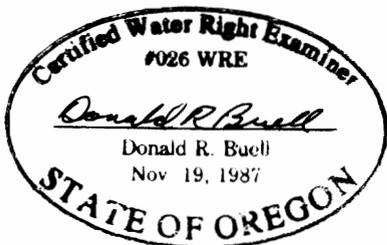


THIS MAP WAS PREPARED FOR THE PURPOSE OF IDENTIFYING THE LOCATION OF A WATER RIGHT ONLY AND IS NOT INTENDED TO PROVIDE LEGAL DIMENSIONS OR LOCATION OF PROPERTY OWNERSHIP LINES.

TOWNSHIP 5 SOUTH, RANGE 1 EAST, W.M.

RECEIVED

MAR 15 1999

WATER RESOURCES DEPT.
SALEM, OREGON

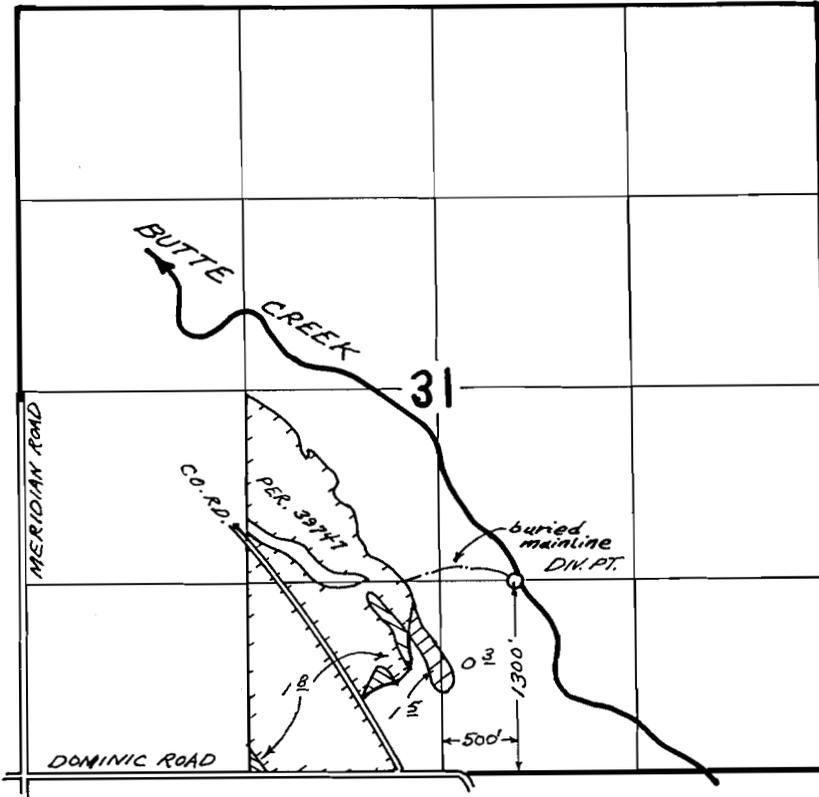


1" = 1320'

FROM  TO  REMAINING 

FINAL PROOF SURVEY
 UNDER
 TRANSFER 6919
 IN THE NAME OF
 DICKMAN FARMS, INC.

FEB. 3, 1999

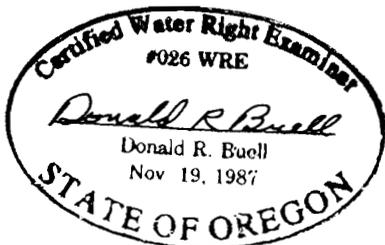

THIS MAP WAS PREPARED FOR THE PURPOSE OF IDENTIFYING THE LOCATION OF A WATER RIGHT ONLY AND IS NOT INTENDED TO PROVIDE LEGAL DIMENSIONS OR LOCATION OF PROPERTY OWNERSHIP LINES.