



Groundwater Registration Modification - GR 2192

Full Harvest Agricultural Holdco II, LLC

Township 10S, Range 3W, W.M.

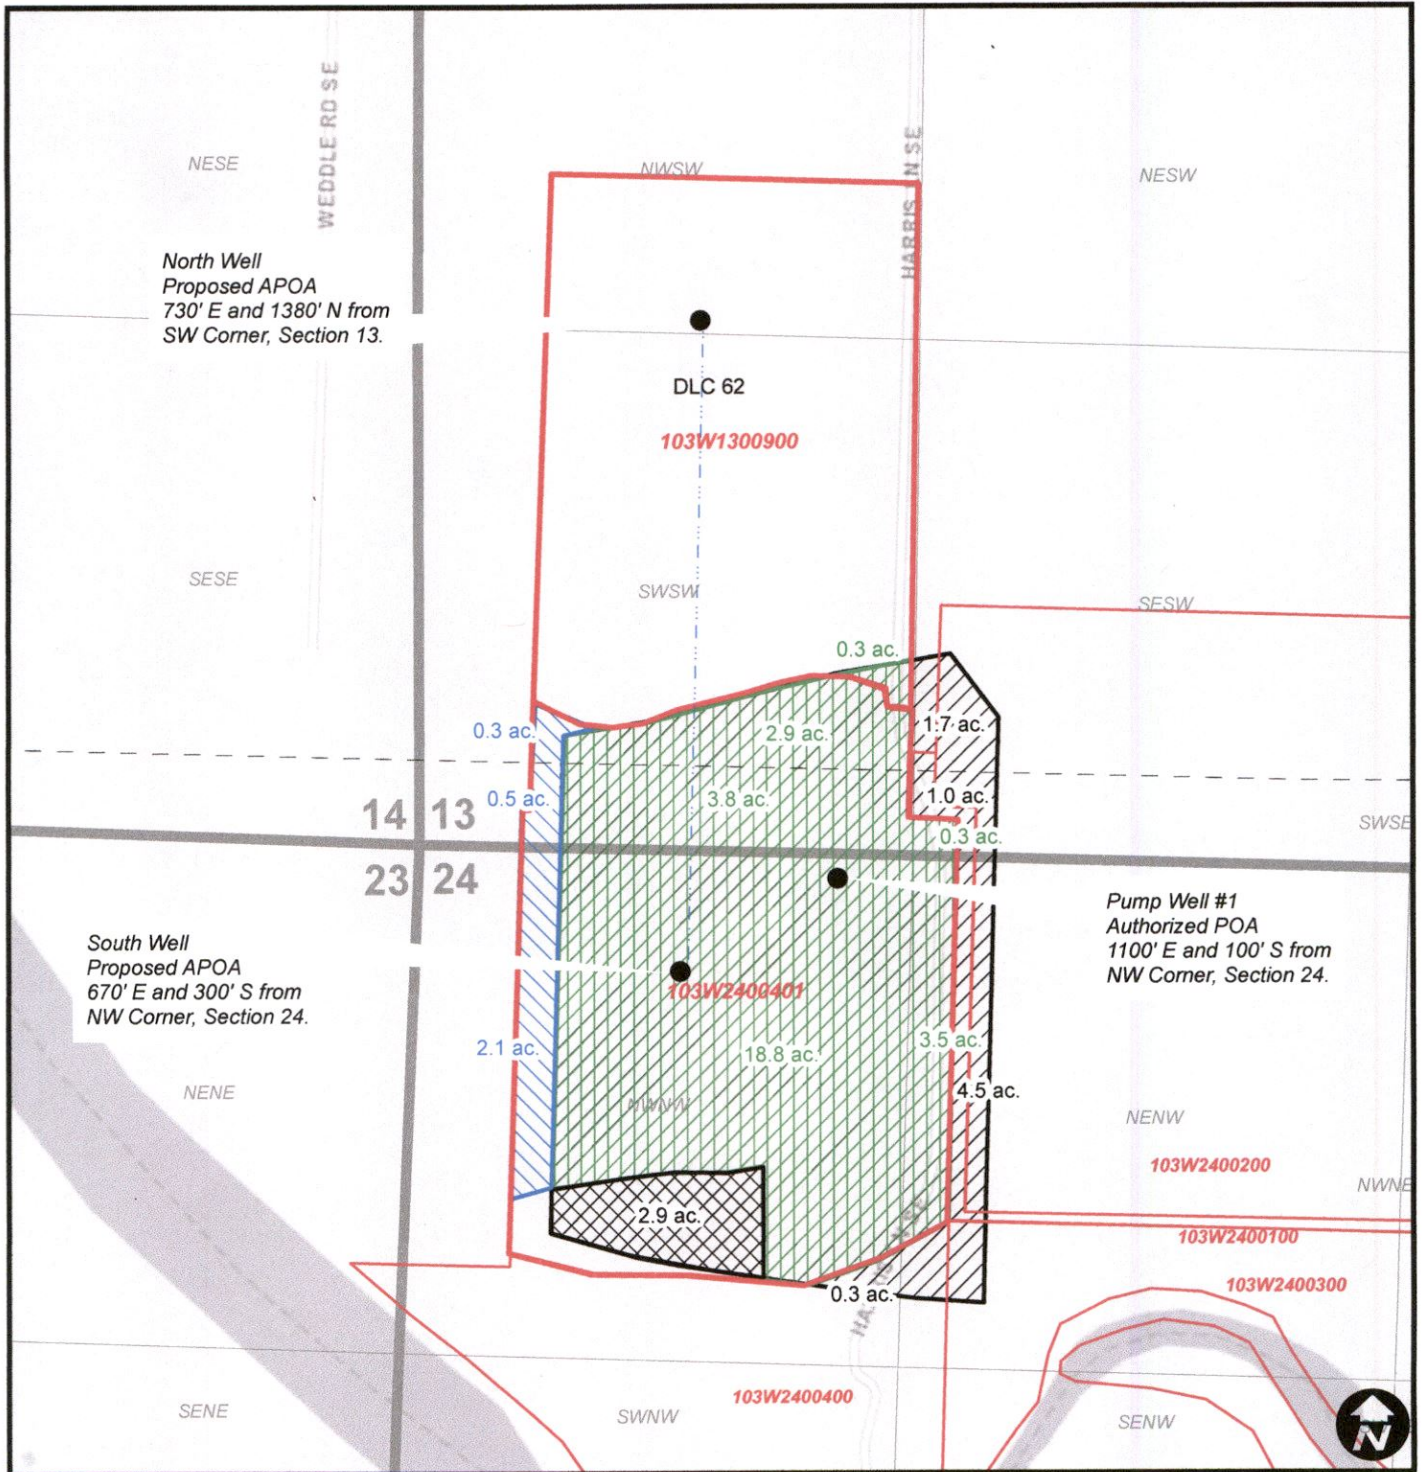

-  GR 2192 From
-  GR 2192 To
-  GR 2192 APOA Change Only
-  GR 2192 No Change
-  Mainline
-  Taxlot
-  DLC

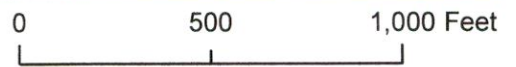

13415

RECEIVED
APR 09 2020
OWRD