




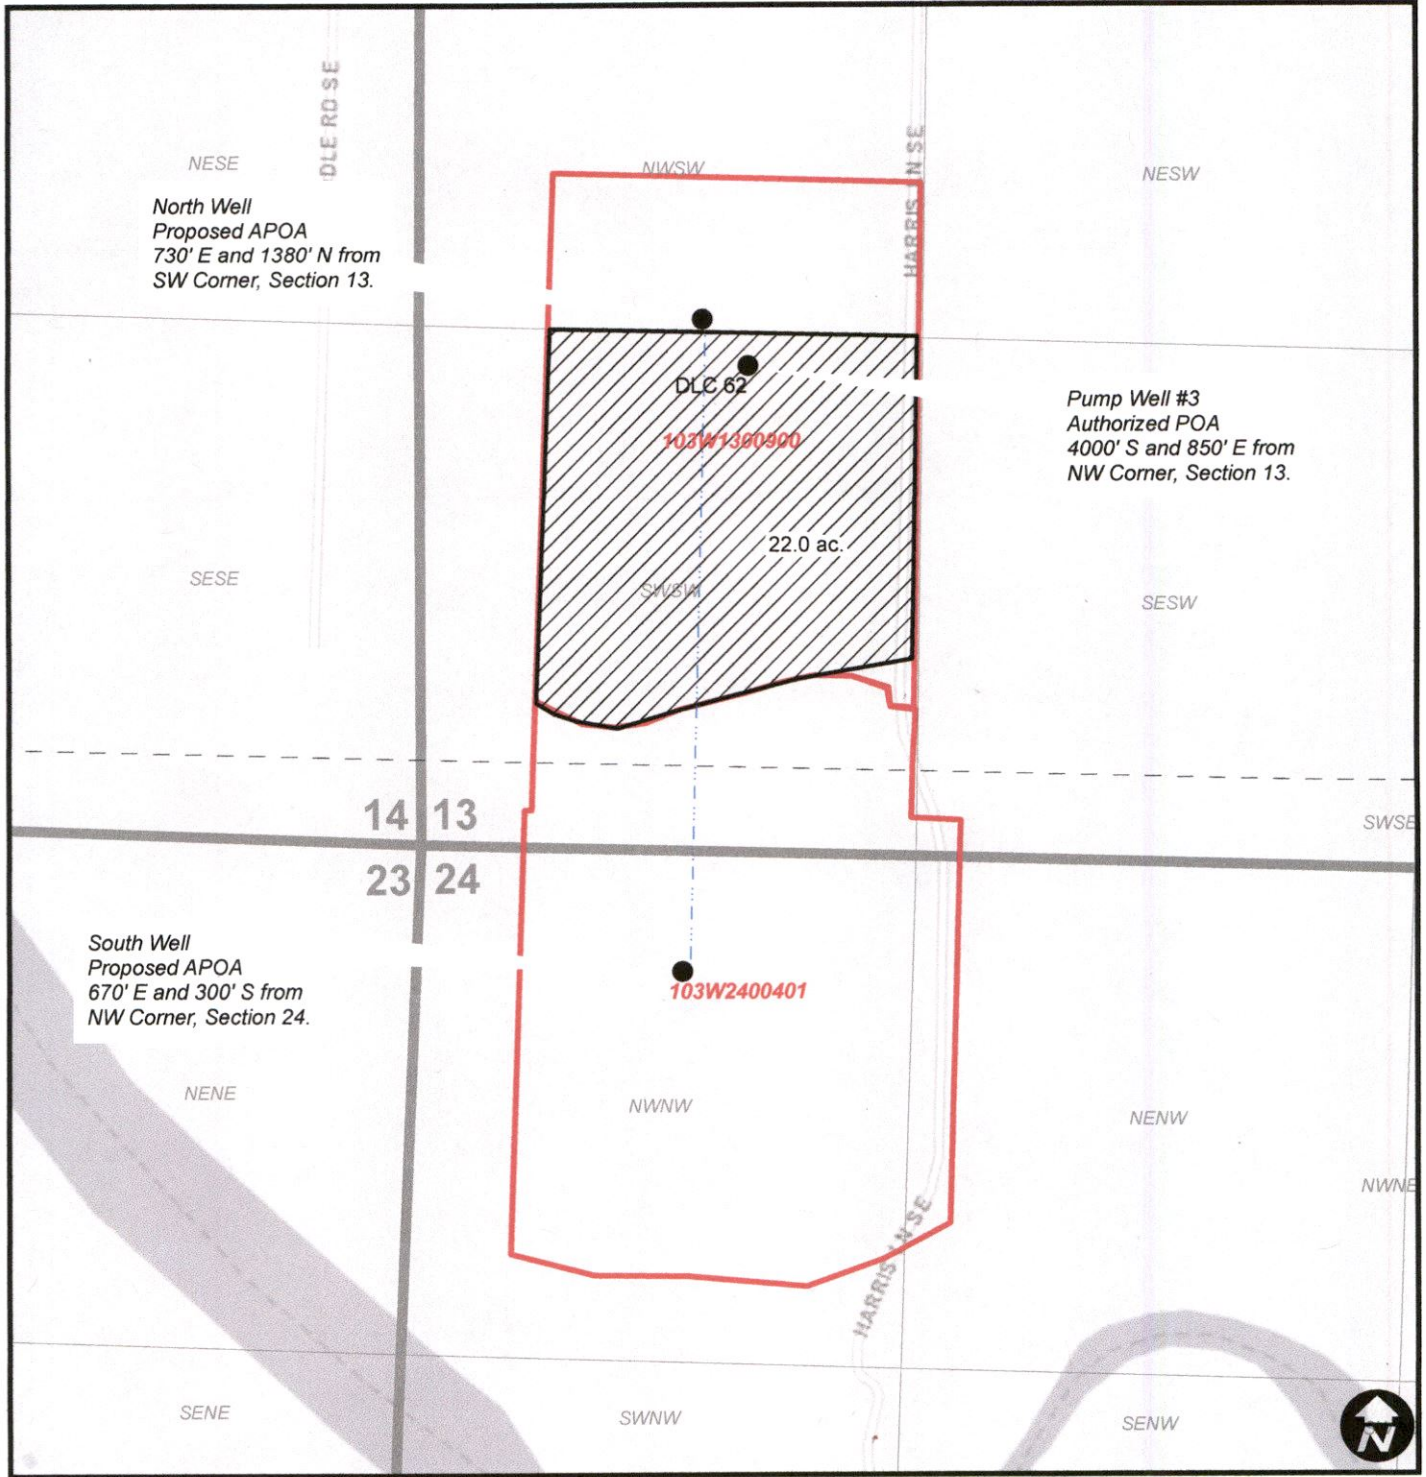

Groundwater Registration Modification - GR 1220

Full Harvest Agricultural Holdco II, LLC

Township 10S, Range 3W, W.M.



-  GR 1220
-  DLC
-  Mainline
-  Taxlot

0 500 1,000 Feet

13416

RECEIVED
APR 09 2020
OWRD