


Sections 3, 4, 9 & 10, T17S, R20E, W.M.,
Crook County, Oregon

RECEIVED




JUN 12 2020


PERMIT AMENDMENT MAP
Application G-18112, Permit G-17700
Shotgun Ranch LLC

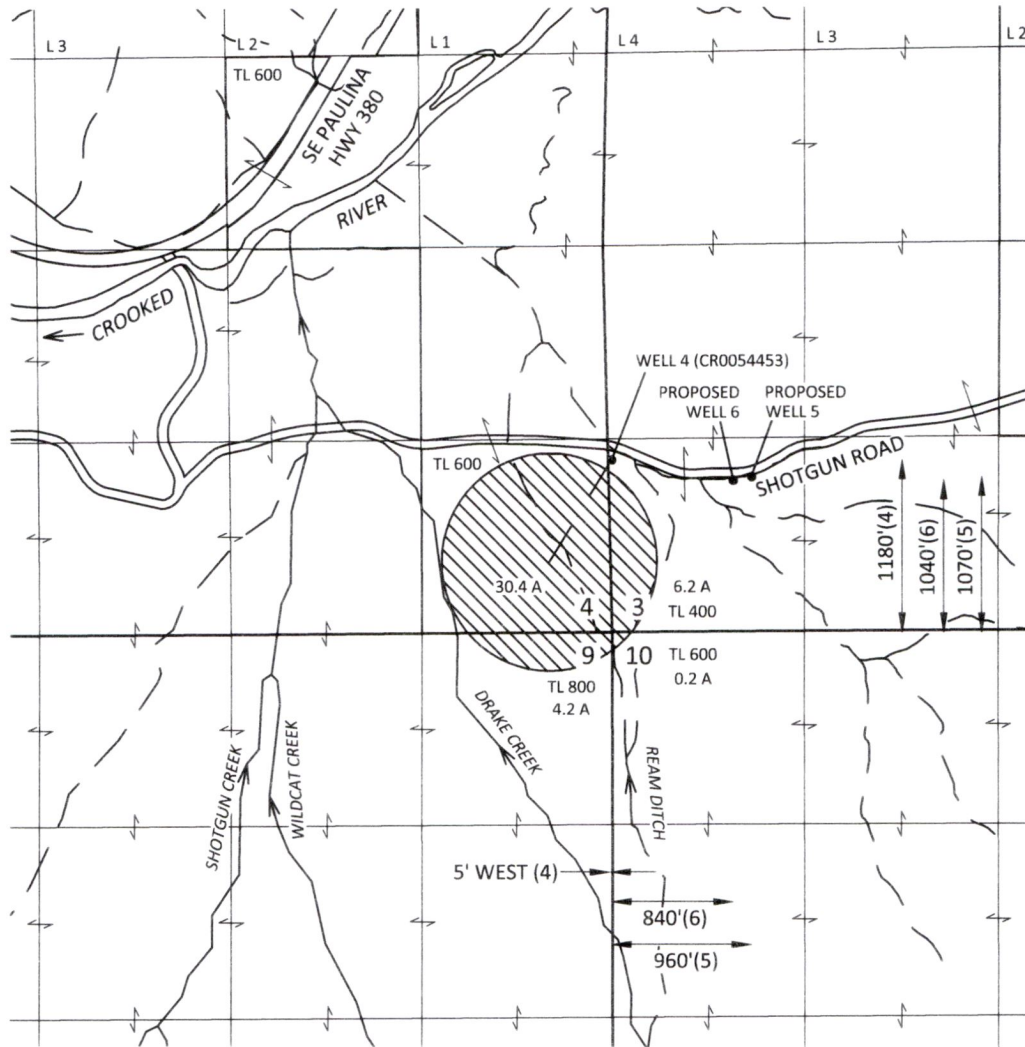OWRD



EXPLANATION

-  SUPPLEMENTAL IRRIGATION
41.0 ACRES
PRIORITY: 6/29/2015
-  WELL
-  PIPE

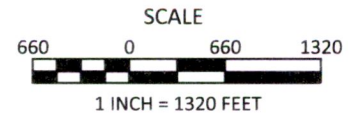

SKOOKUM
WATER ASSOCIATES INC

1626 VICTORIAN WAY
EUGENE, OR 97401
(503) 319-8926

June 3, 2020

This map is not intended to provide legal
dimensions or locations of property
ownership lines

Figure 1


Sections 3, 4, 9 & 10, T17S, R20E, W.M.,
Crook County, Oregon

RECEIVED





JUN 12 2020

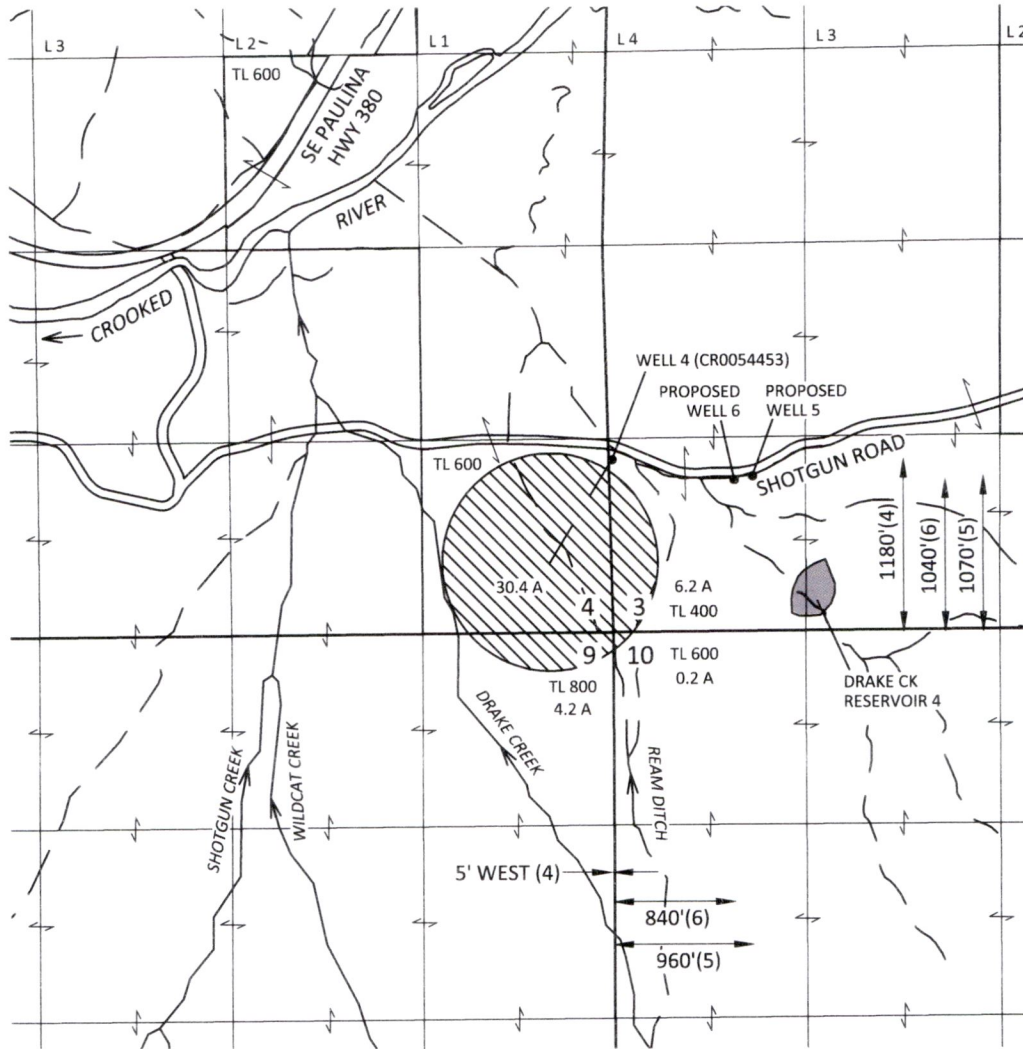
PERMIT AMENDMENT MAP
Application G-18604, Permit G-18245
Shotgun Ranch LLC

OWRD



EXPLANATION

-  SUPPLEMENTAL IRRIGATION
41.0 ACRES
PRIORITY: 1/31/2018
-  STORAGE
PRIORITY: 1/31/2018
-  WELL
-  PIPE

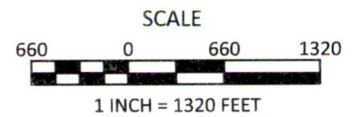

June 3, 2020

This map is not intended to provide legal
dimensions or locations of property
ownership lines

Figure 2



1626 VICTORIAN WAY
EUGENE, OR 97401
(503) 319-8926