


# T.3S.,R.9W.,W.M.

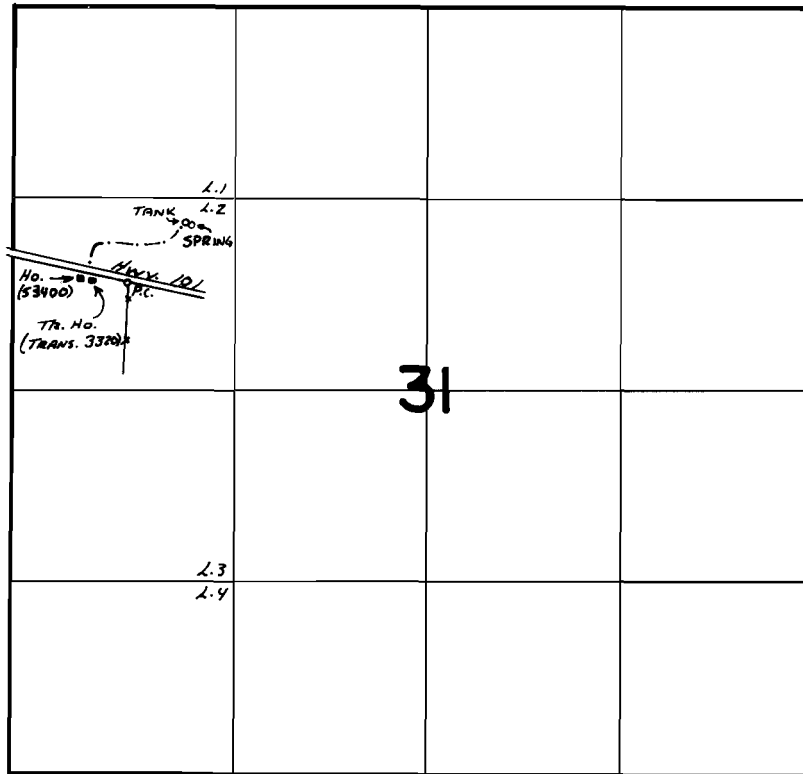

SPRING Loc: 1130' N AND 1220' E FROM W 1/4 Cor. Sec. 31

## FINAL PROOF SURVEY UNDER

Transfer No. 3320  
Application No. 53400.. Permit No. 39596..  
IN NAME OF

ROBERT E. & VICTORIA M. DUBOIS

Surveyed July 1, 1976, by L. Tott