

JEFFERSON COUNTY
SEC.33 T13S R13E

RECEIVED

JUL 24 2020

SCALE - 1" = 400'



OWRD



NW 1/4 OF THE SE 1/4

OWRD #: T-13089

C 1/4 COR

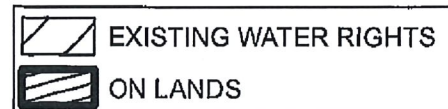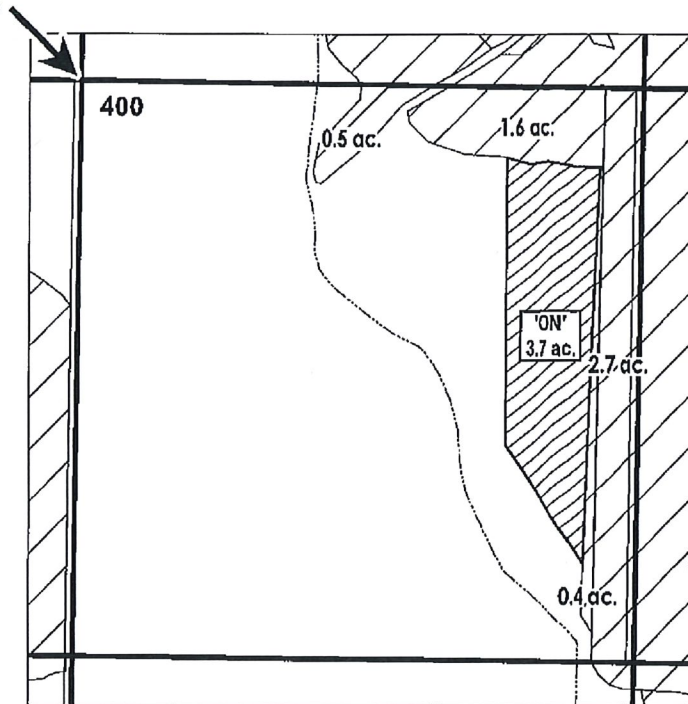

FINAL PROOF MAP

KNIGHT, PHILIP/PENELOPE

TAXLOT #: 400

3.7 ACRES

Date: 7/10/2020

DESCHUTES COUNTY
SEC.20 T14S R13E

RECEIVED

SCALE - 1" = 400'


JUL 24 2020





OWRD

SE 1/4 OF THE SE 1/4

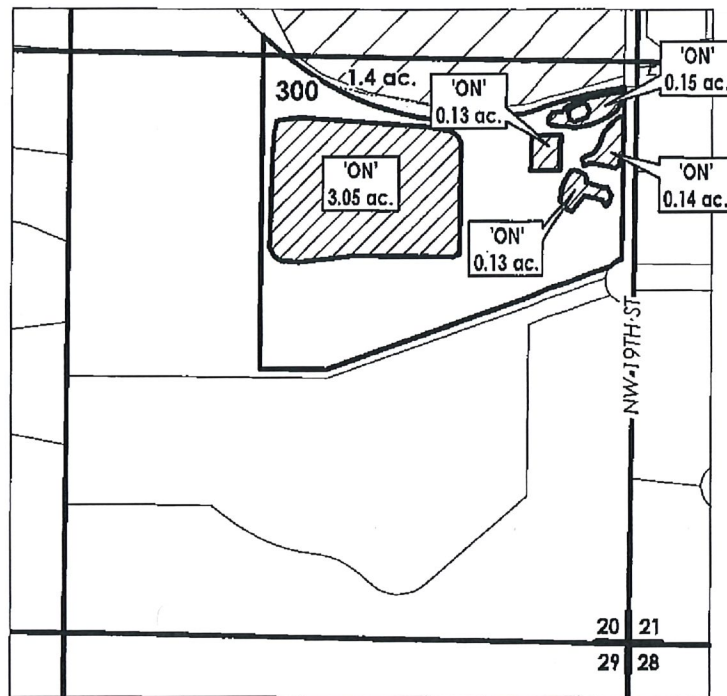OWRD #: T-13089



	EXISTING WATER RIGHTS
	'ON' LANDS



FINAL PROOF MAP

NAME: Hollander, Alexandra

TAXLOT #: 300

3.6 ACRES

Date: 09/27/2019

FILE: I:\TRANSFER\FINALPRF\P-201X-XXX\TRS_QQ

**DESCHUTES COUNTY
SEC.12 T15S R12E**

RECEIVED

JUL 24 2020


SCALE - 1" = 400'



OWRD

SE 1/4 OF THE SE 1/4

OWRD #: T-13089

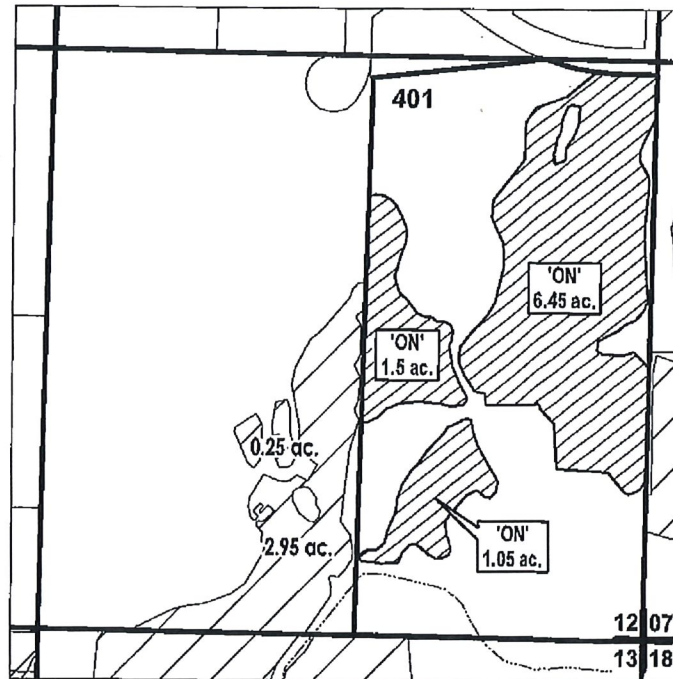

	EXISTING WATER RIGHTS
	ON LANDS



Date: 7/10/2020

FINAL PROOF MAP

LARKIN, JEFFREY A. & JULIE M.

TAXLOT #: 401

9.0 ACRES

**DESCHUTES COUNTY
SEC.13 T15S R12E**

SCALE - 1" = 400'




NE 1/4 OF THE SE 1/4



RECEIVED

JUL 24 2020

OWRD

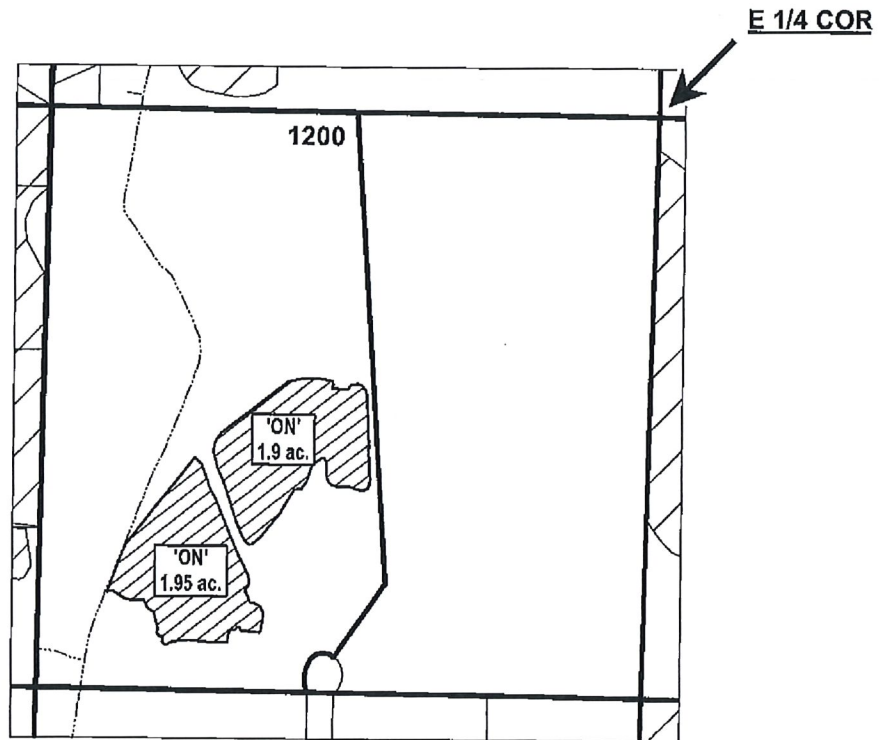OWRD #: T-13089



	EXISTING WATER RIGHTS
	ON LANDS



FINAL PROOF MAP

CRANE, EVAN

TAXLOT #: 1200

3.85 ACRES

Date: 7/10/2020

**CROOK COUNTY
SEC.18 T15S R15E**

RECEIVED

JUL 24 2020


SCALE - 1" = 400'

OWRD



SE 1/4 OF THE NW 1/4

OWRD #: T-13089

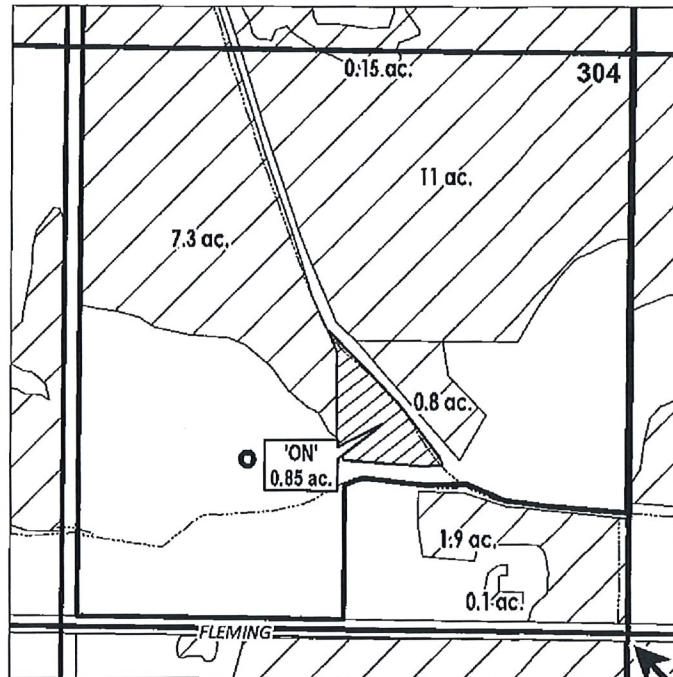

C 1/4 COR

	EXISTING WATER RIGHTS
	ON LANDS



FINAL PROOF MAP

WHITE, JOHN/LEANA

TAXLOT #: 304

0.85 ACRES

Date: 7/10/2020

CROOK COUNTY
SEC.28 T16S R14E

RECEIVED

JUL 24 2020


SCALE - 1" = 400'

OWRD



SE 1/4 OF THE NW 1/4

OWRD #: T-13089

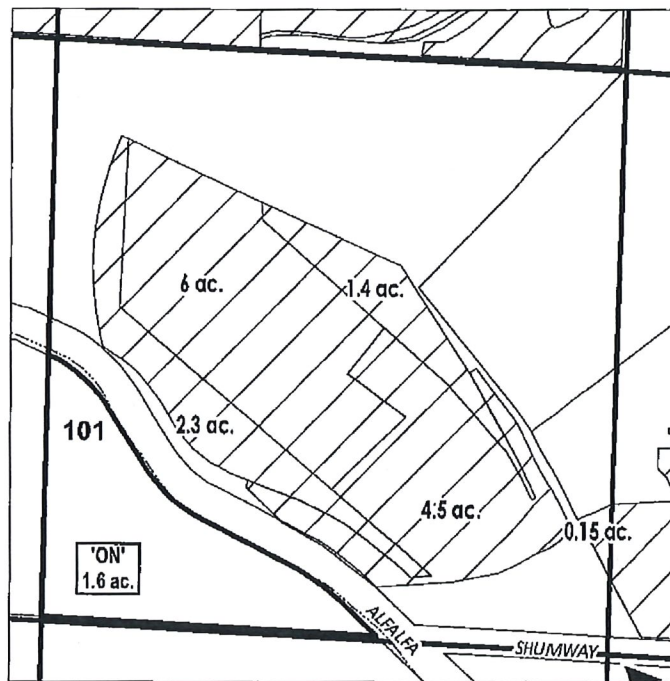

C 1/4 COR

	EXISTING WATER RIGHTS
	'ON' LAND PARCELS



FINAL PROOF MAP

FOSS, BRADY A.

TAXLOT #: 101

1.6 ACRES

Date: 7/10/2020

**DESCHUTES COUNTY
SEC.22 T17S R13E**

RECEIVED

JUL 24 2020



SCALE - 1" = 400'



OWRD

SW 1/4 OF THE SW 1/4

OWRD #: T-13089

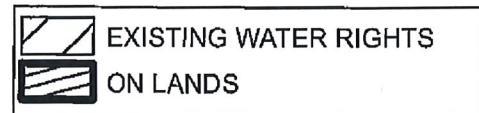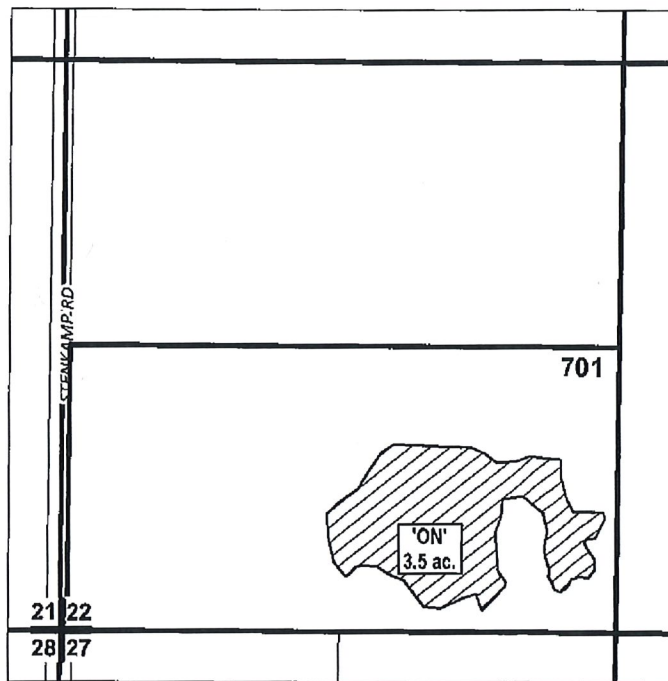

FINAL PROOF MAP

ADAMS, AARON/EMILY

TAXLOT #: 701

3.5 ACRES

Date: 7/10/2020

**DESCHUTES COUNTY
SEC.24 T17S R14E**

RECEIVED

JUL 24 2020


SCALE - 1" = 400'



OWRD



SW 1/4 OF THE SW 1/4

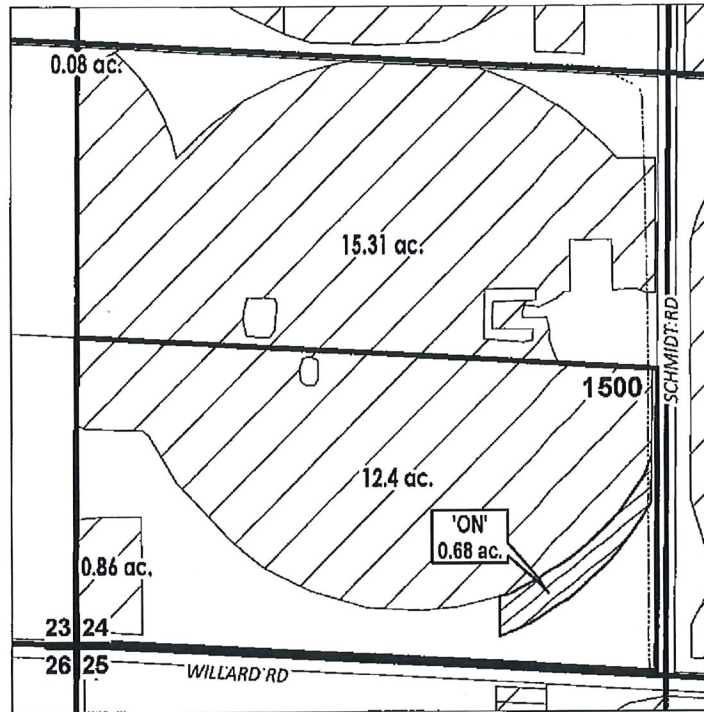OWRD #: T-13089



	EXISTING WATER RIGHTS
	ON LANDS



FINAL PROOF MAP

MEYER, WEYLIN TRUSTEE

TAXLOT #: 1500

0.68 ACRES

Date: 7/13/2020