


T. 2S., R. 2W., W.M.

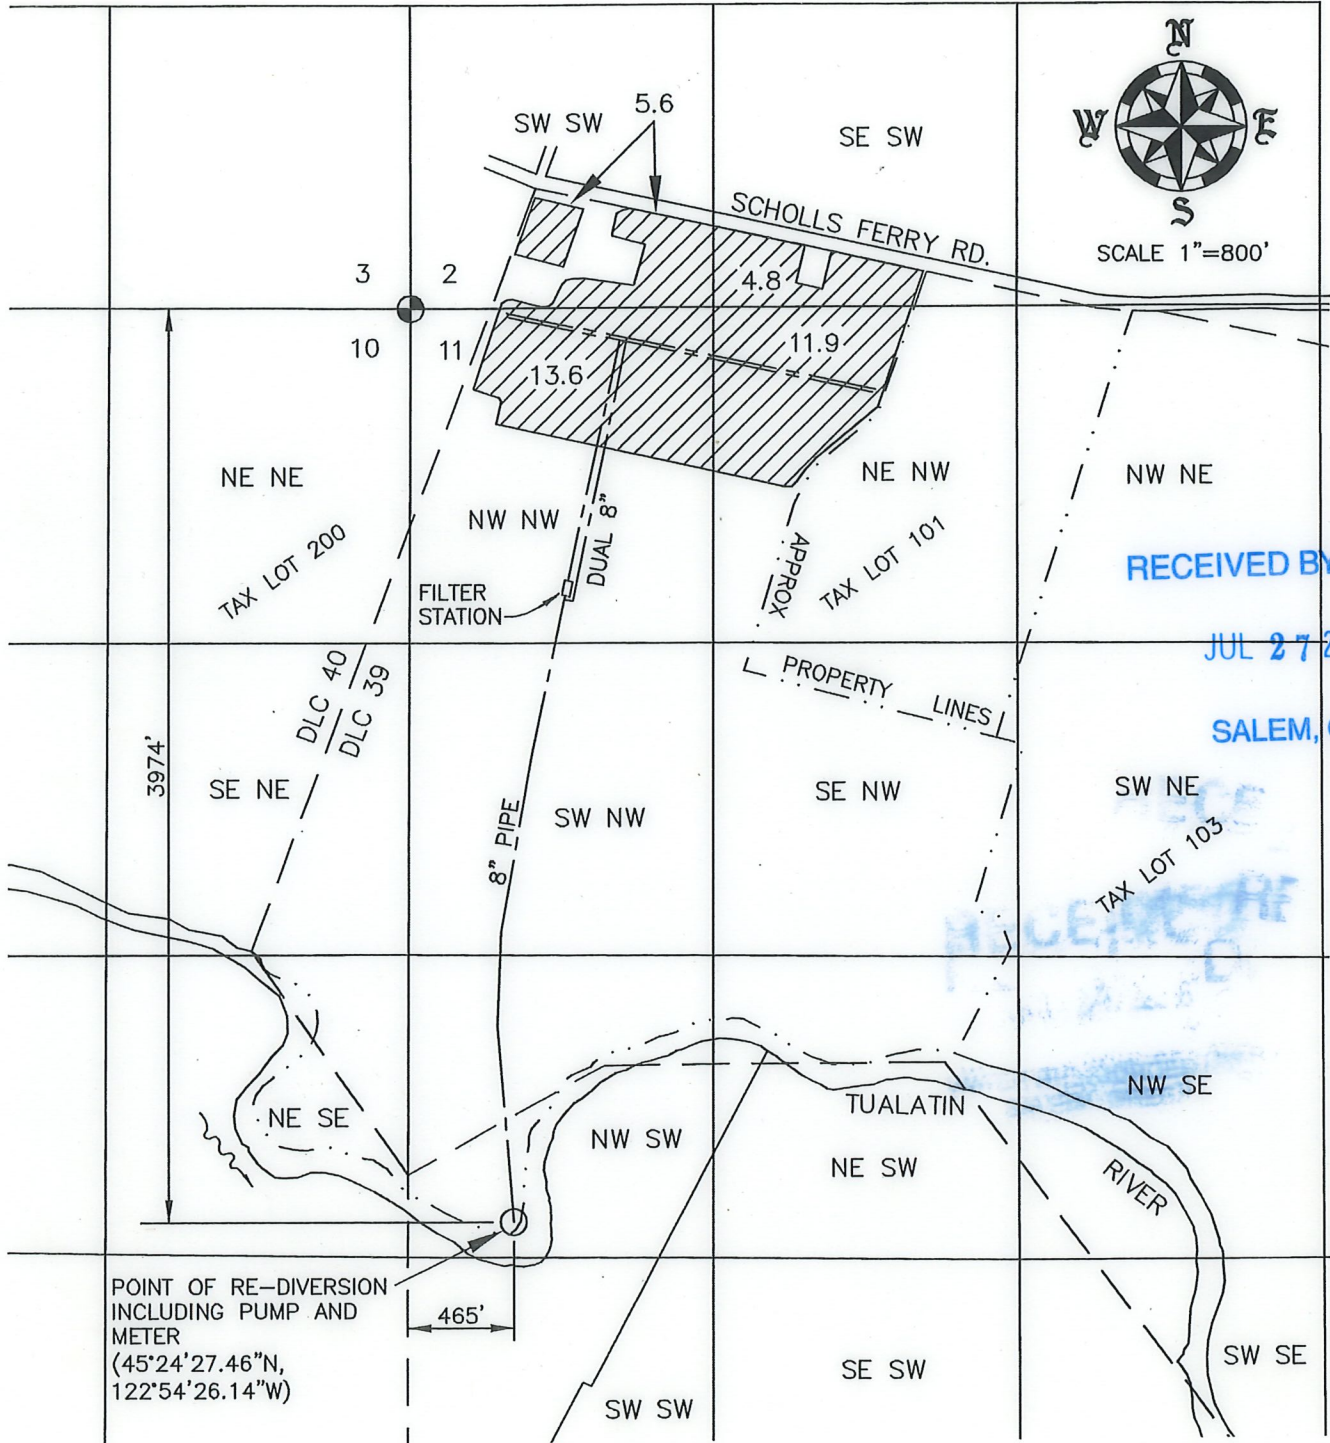

RECEIVED BY OWRD
 JUL 27 2016
 SALEM, OR

FINAL PROOF SURVEY
 Under Application No.: T-11071 Permit No.: S-35792
 IN NAME OF: Jay Hoffman
 Surveyed: 5/9/2016

LEGEND:
 IRRIGATION AREA:

PREPARED BY:
 SPEAR SURVEYING SERVICES
 947 NE BIRCHAIRE LN.
 HILLSBORO, OR 97124
 (503) 648-2879

- NOTES:
1. THIS MAP IS NOT INTENDED TO PROVIDE LEGAL DIMENSIONS OR LOCATIONS OF PROPERTY OWNERSHIP LINES.
 2. TAX MAP: 2S 2 11



7/21/2016