



**FINAL PROOF SURVEY
UNDER
TRANSFER T8018
IN THE NAME OF
DESCHUTES RIVER RANCH**


**AUGUST 29, 2001
TOWNSHIP 16 SOUTH, RANGE 12 EAST, W.M.
NW 1/4, SW 1/4, SWCTION 16
DESCHUTES COUNTY OREGON**

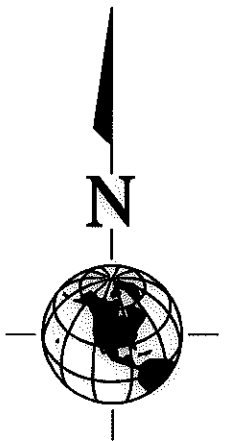

SCALE 1"=400'

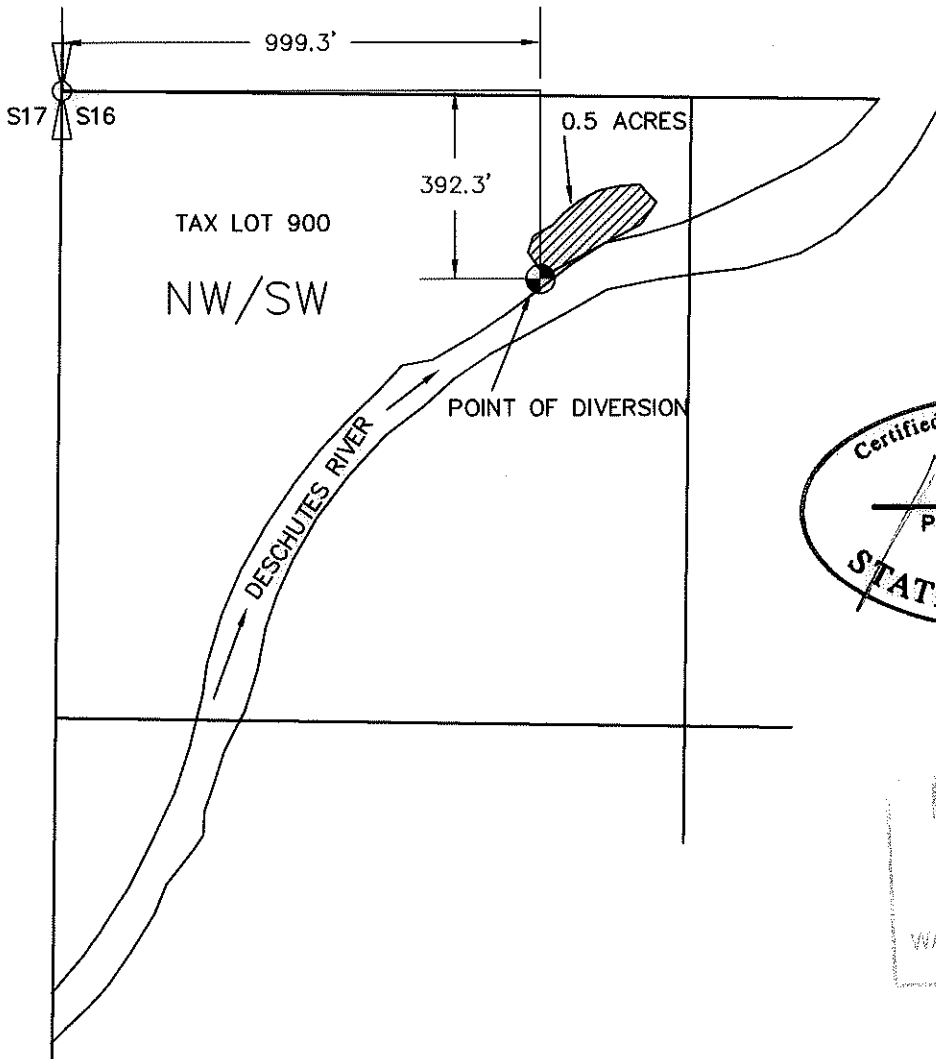

9-5-2001

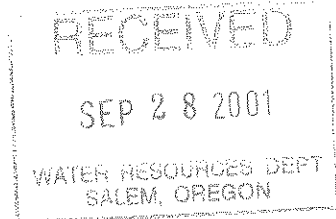

THIS MAP WAS PREPARED FOR THE PURPOSE OF IDENTIFYING THE LOCATION OF A WATER RIGHT ONLY AND IS NOT INTENDED TO PROVIDE LEGAL DIMENSIONS OR LOCATION OF PROPERTY OWNERSHIP LINES.

DESIGNED BY: _____ CHECKED BY: _____
 DRAWN BY: PJP APPROVED BY: _____
 LAST EDIT: _____ PLOT DATE: 8-31-2001

DATE	BY	REV#	REVISION	CK'D	APPR.

**ONE-HALF ACRE TRANSFER
FINAL PROOF SURVEY
DESCHUTES RIVER RANCH**

SCALE: 1"=400'	PROJECT NO. 830725.001	DRAWING FILE NAME: DDRFINAL.DWG	1 SHEET 1/1
-------------------	---------------------------	------------------------------------	-------------