
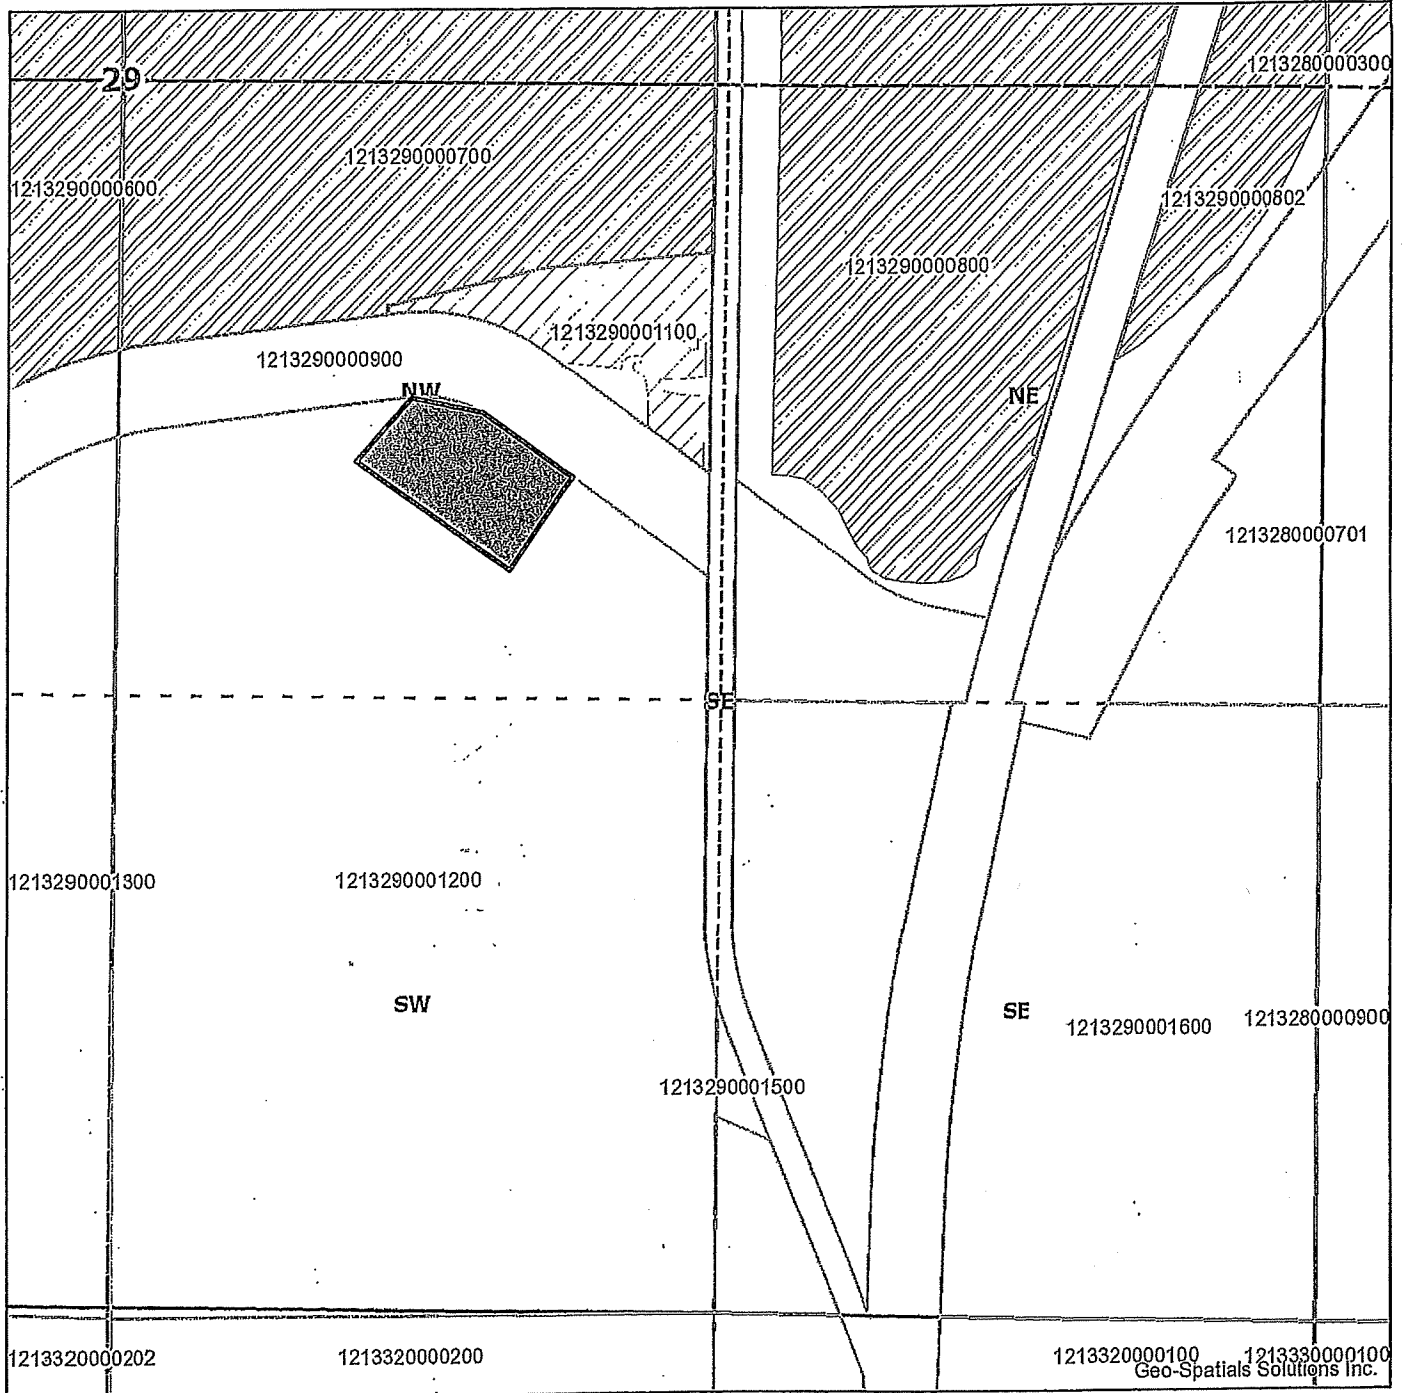


Claim of Beneficial Use – T12816

2017-02 NUID Water Right Transfer 'ON' Hostetler

North Unit Irrigation District
 2024 NW Beech Street
 Madras, OR 97741
 Phone: (541) 475-3625
 Fax: (541) 475-3905
 email: pwatson@northunitid.com

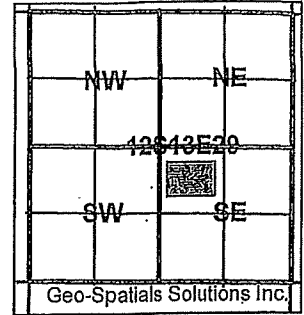

1213290001200 NWSE 2.0 acres 72279 & 72281 'ON'

Received by OWRD

N
 1" = 400'
 1 in = 400 ft

SEP 19 2020





COBU

Claim of Beneficial Use - T12816

2017-04-A NUID WRT Backsen Family Trust 'ON' Map 2

North Unit Irrigation District
 2024 NW Beech Street
 Madras Oregon 97741
 Phone: (541) 475-3625
 Fax: (541) 475-3905
 email: pwatson@northunitid.com

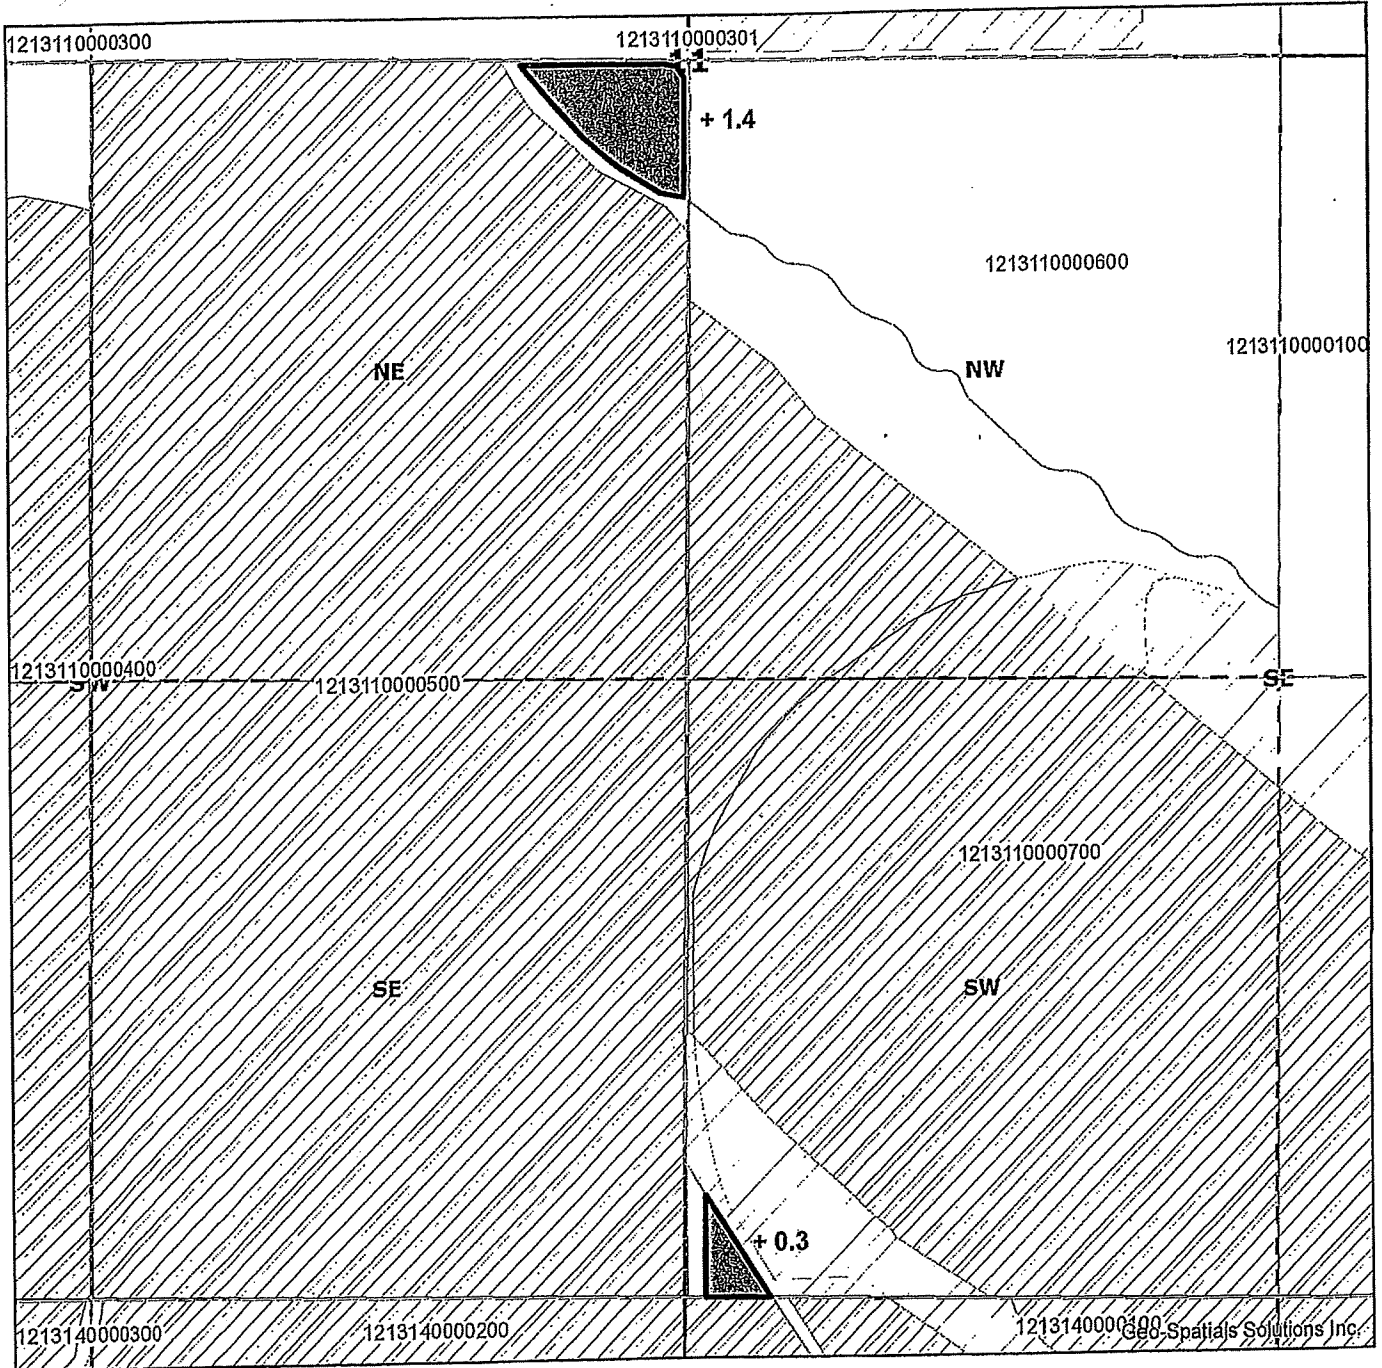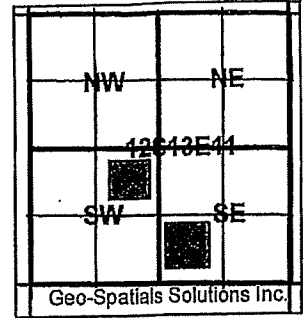

1213110000500 NESW Transfer 'ON' 1.4 acres 72279 & 72281
 1213110000500 SWSE Transfer 'ON' 0.3 acres 72279 & 72281

 *COBU*
 Received by OWRD

SEP 12 2020

Salem, OR





1 inch = 400 feet

Claim of Beneficial Use – T12816

2017-04-A NUID WRT Backsen Family Trust 'ON' Map 1

North Unit Irrigation District
2024 NW Beech Street
Madras Oregon 97741
Phone: (541) 475-3625
Fax: (541) 475-3905
email: pwatson@northunitid.com

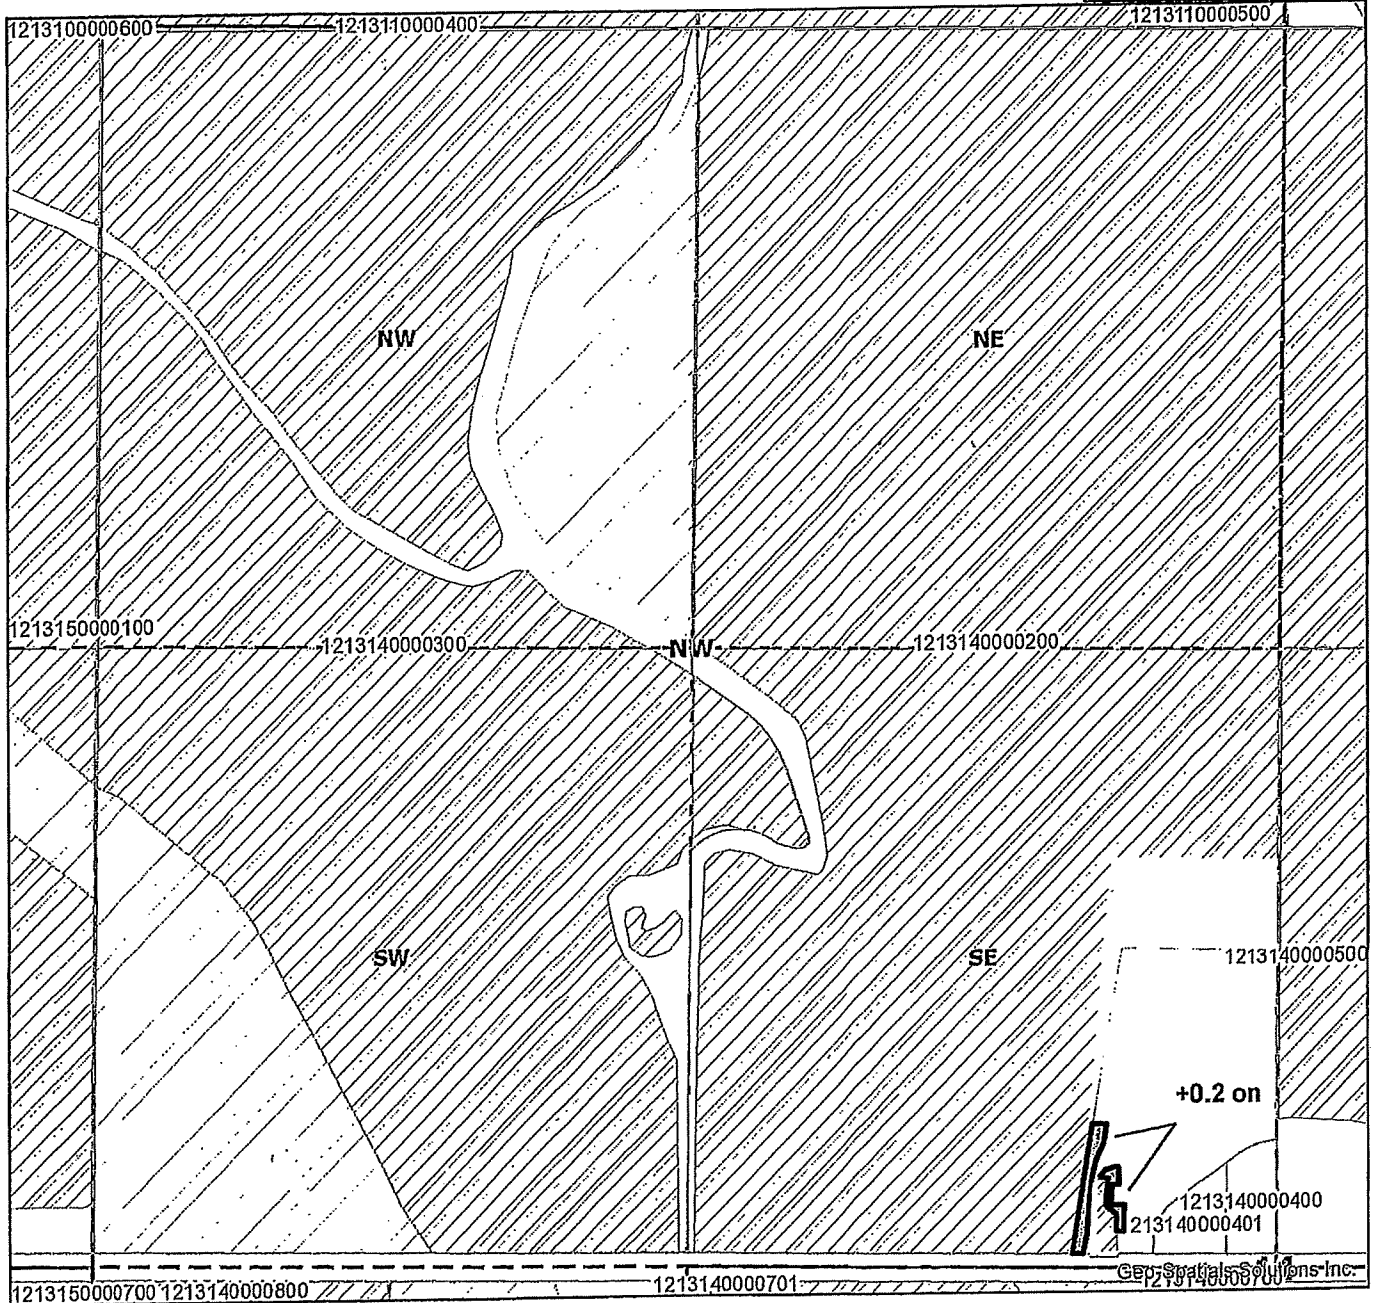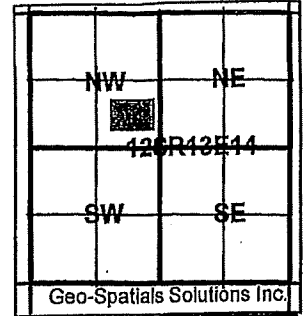

1213140000200 SENW Transfer 'ON' 0.2 acres 72279 & 72281
Received by NWRD

SEP 12 2020

Salem, OR

 COBU





1 inch = 400 feet

Claim of Beneficial Use - T12816

2017-04-B NUID WRT Backsen Family Trust 'ON'

North Unit Irrigation District
2024 NW Beech Street
Madras Oregon 97741
Phone: (541) 475-3625
Fax: (541) 475-3905
email: pwatson@northunitid.com

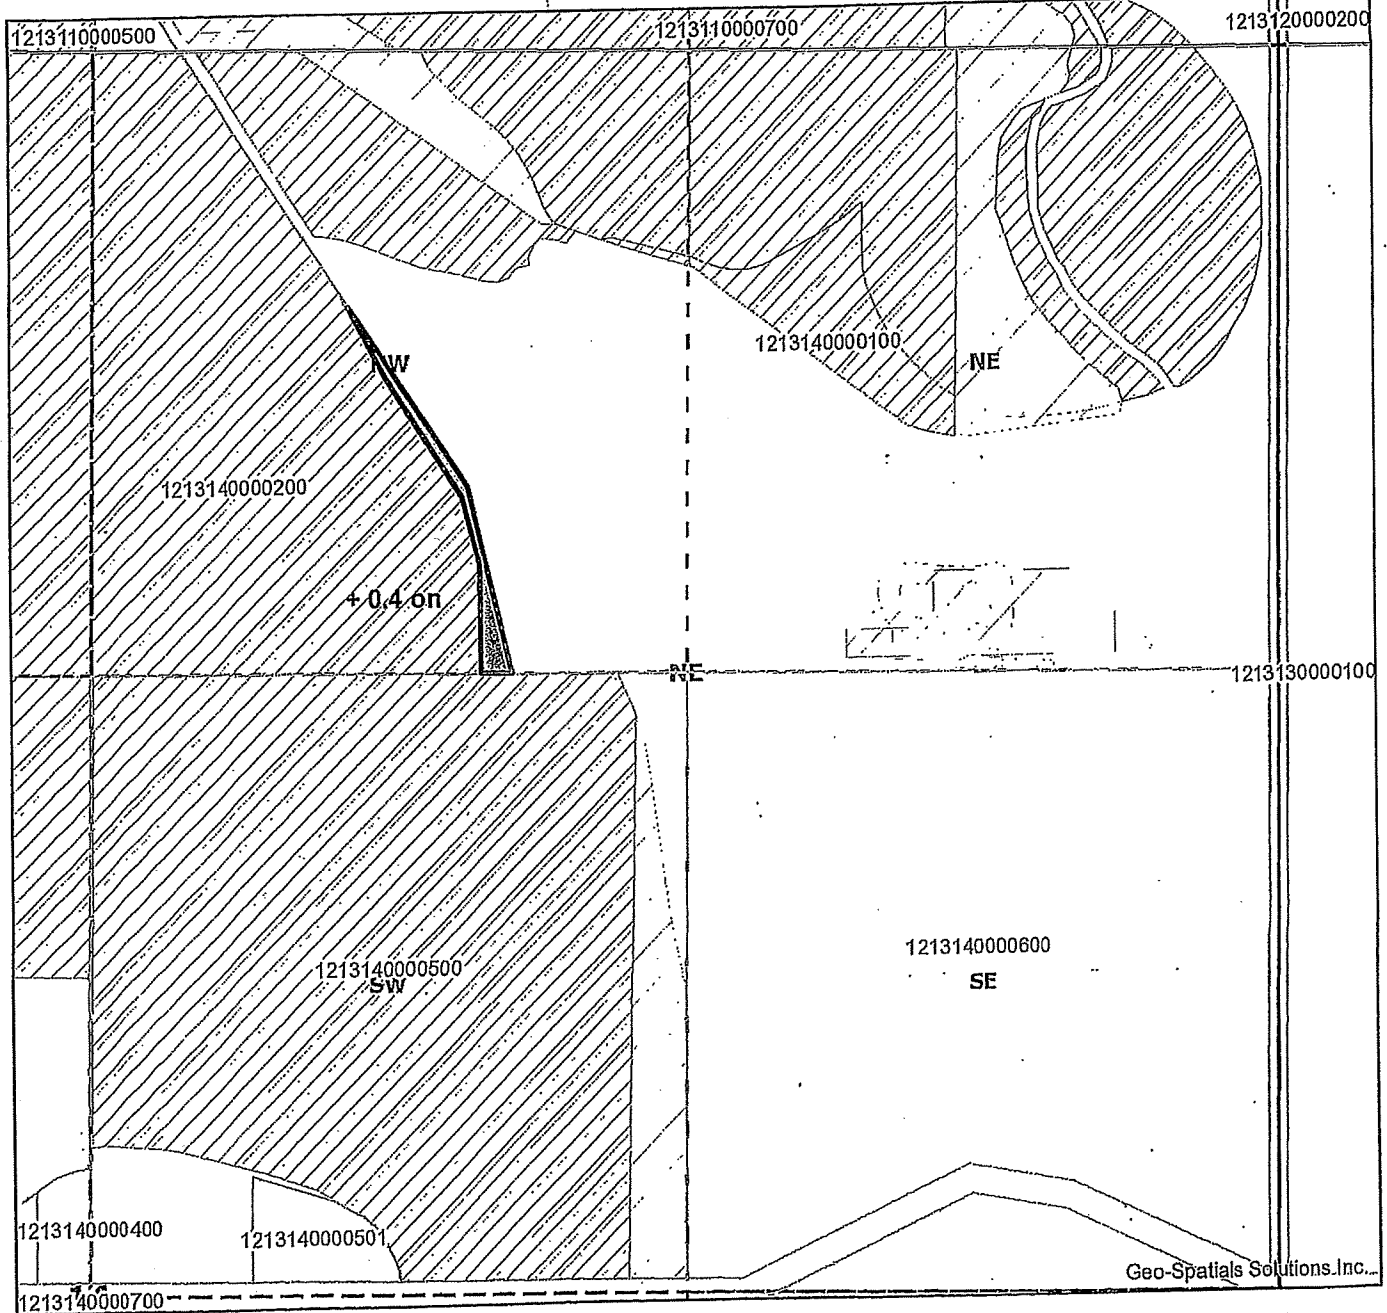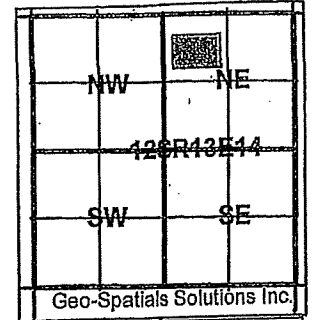

1213140000200 NWNE Transfer 'ON' 0.4 acres 72279 & 72281
Received by OWRD

SEP 12 2020



COBU





1 inch = 400 feet

Salem, OR

Claim of Beneficial Use – T12816

2017-04-C NUID WRT Backsen Enterprises 'ON'

North Unit Irrigation District
 2024 NW Beech Street
 Madras Oregon 97741
 Phone: (541) 475-3625
 Fax: (541) 475-3905
 email: pwatson@northunitid.com

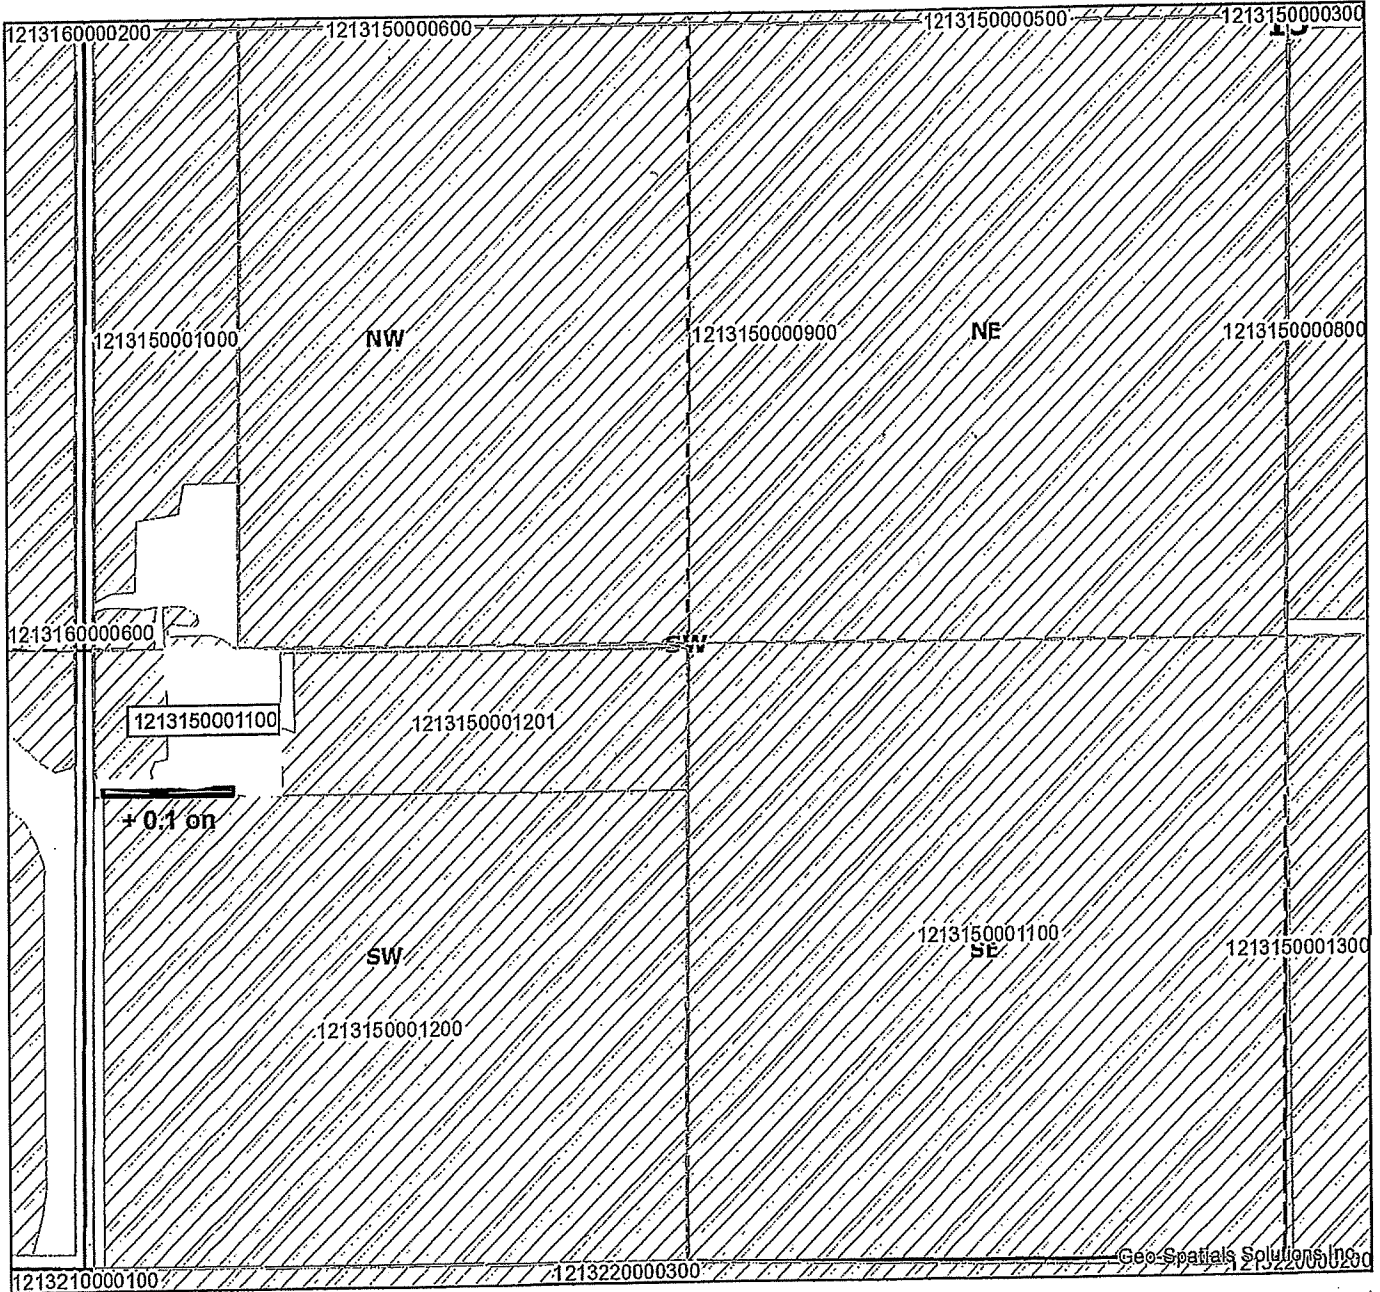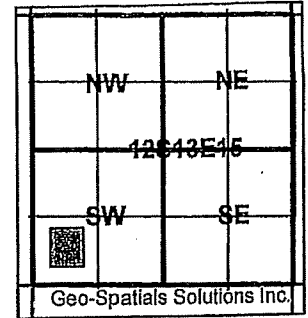

1213150001100 SWSW Transfer 'ON' 0.1 acres 72279 & 72281

Received by QWRD

SEP 12 2020



COBU

Salem, OR





1 inch = 400 feet

Claim of Beneficial Use - T12816

17-05 NUID WRT 'ON' Crocker

North Unit Irrigation District
2024 NW Beech Street
Madras, OR 97741
Phone: (541) 475-3625
Fax: (541) 475-3905
email: pwatson@northunitid.com

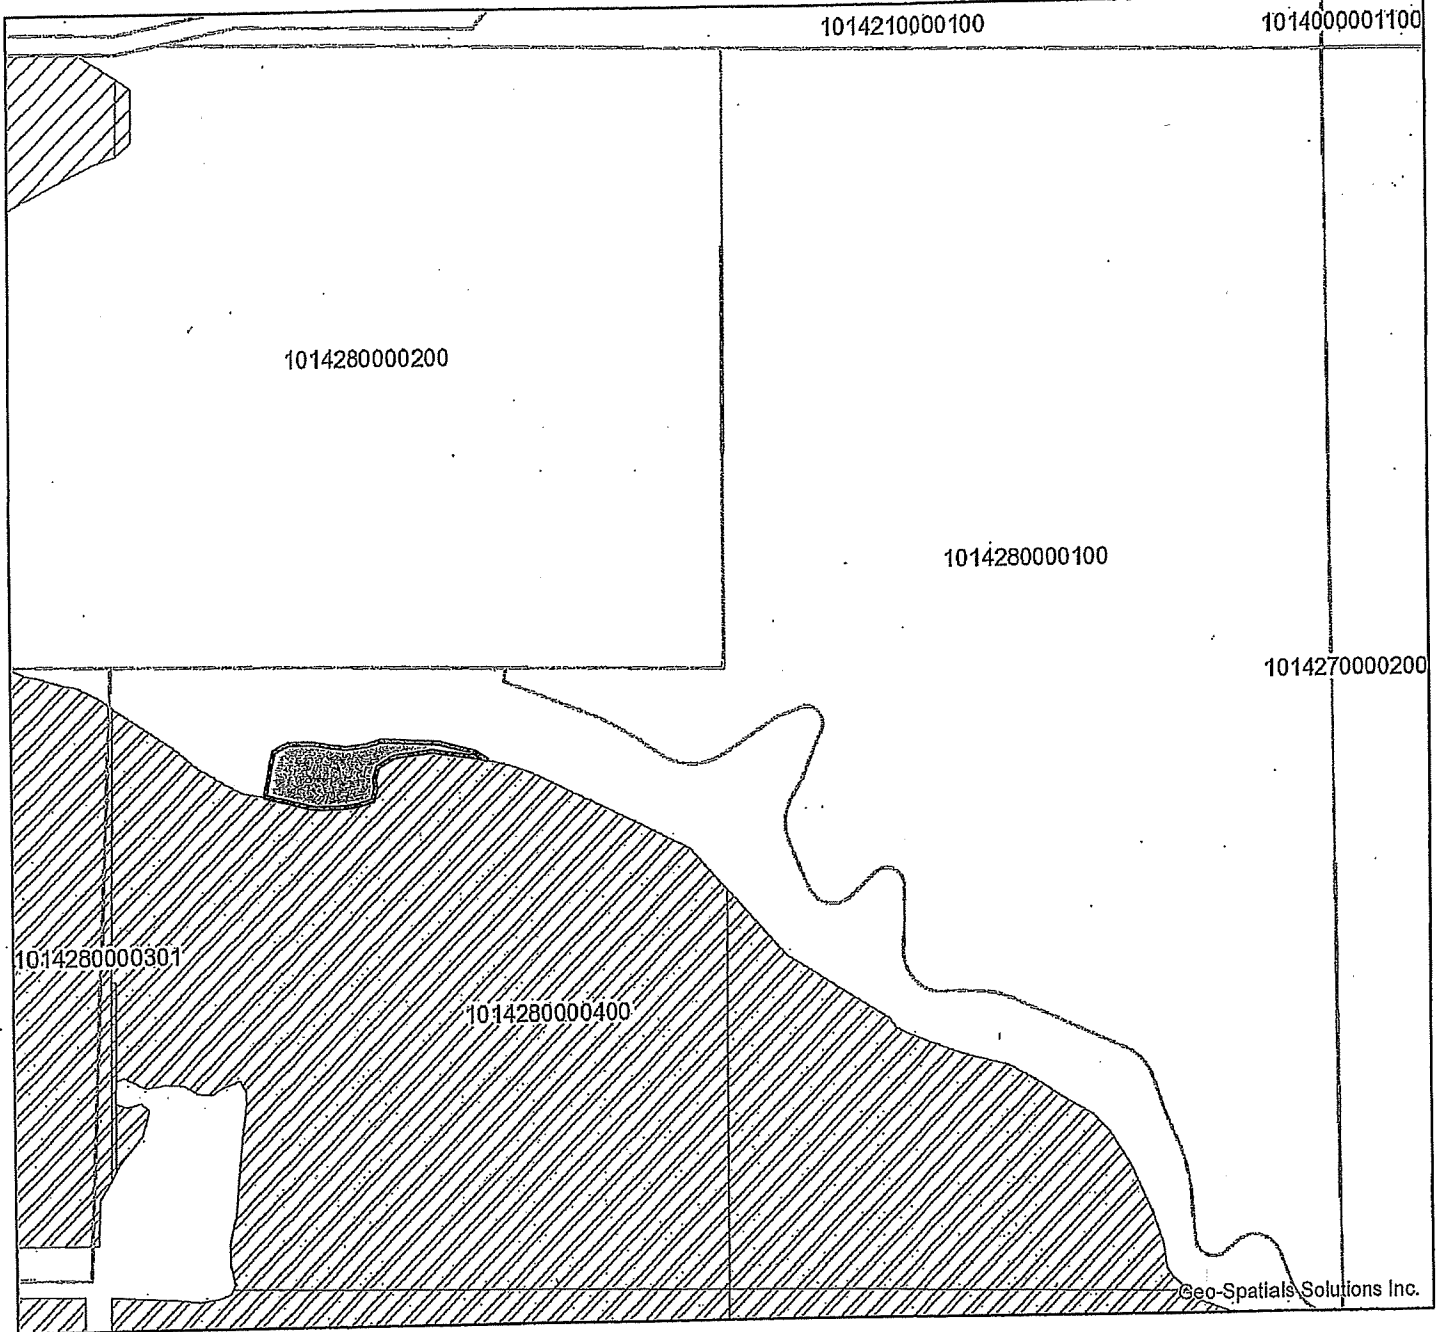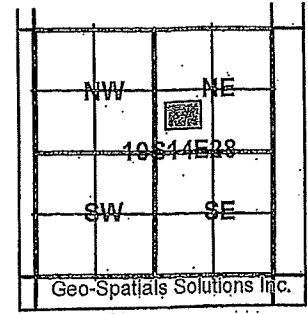

1014280000400 SWNE 0.8 acres 72279 & 72281 'ON'


Received by QWRD

SEP 12 2020

Salem, OR



COBU


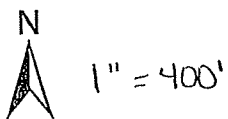


1 inch = 400 feet

Claim of Beneficial Use - 112010


2017-06 NUID Water Right Transfer 'ON' Baggett

North Unit Irrigation District
2024 NW Beech Street
Madras Oregon 97741
Phone: (541) 475-3625
Fax: (541) 475-3905
email: pwatson@northunitid.com

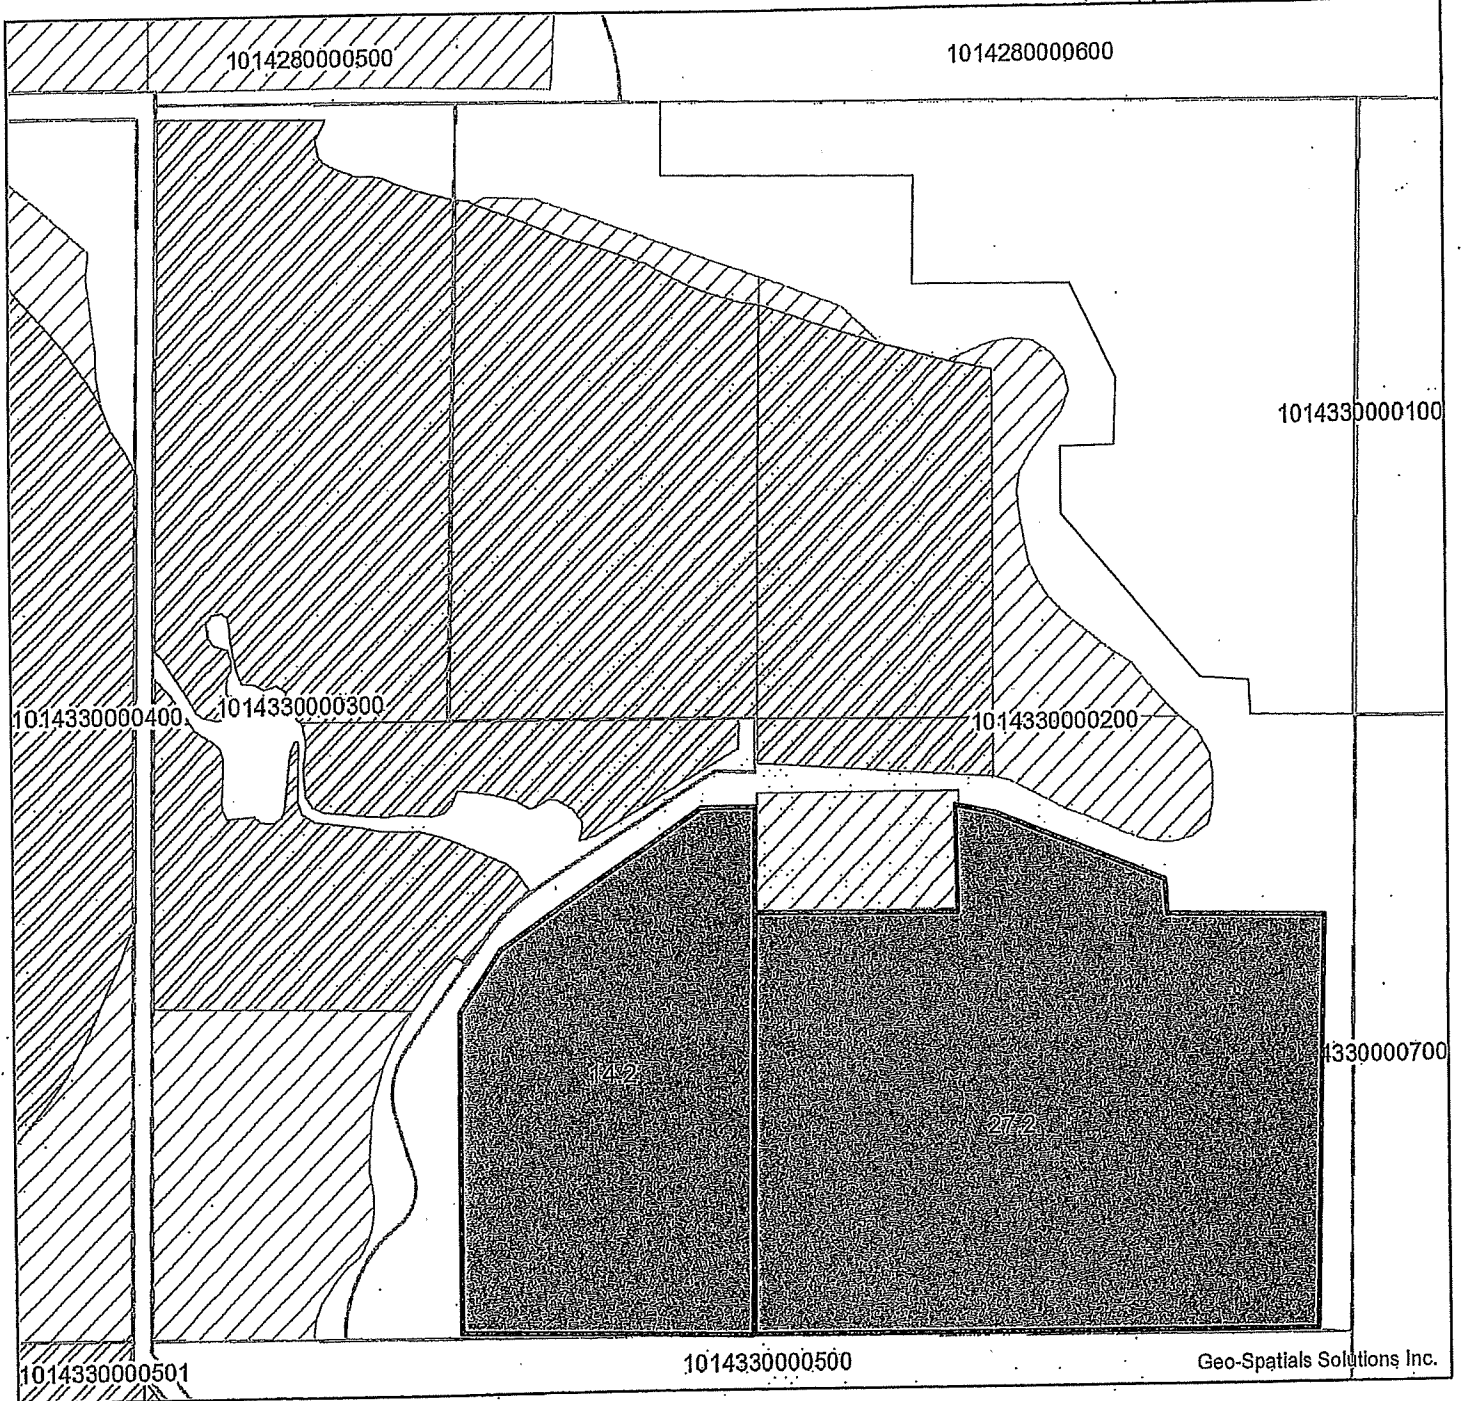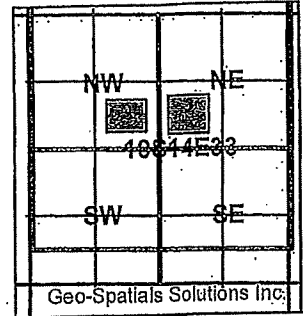

1014330000200 SENW 14.2 acres 72279 & 72281 'ON'
1014330000200 SWNE 27.2 acres 72279 & 72281 'ON'

received by OWRD

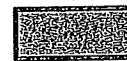

COBU

SEP 12 2020



Salem, OR

N 1" = 400'
1 inch = 400 feet

Claim of Beneficial Use – 112816

2017-07 NUID WRT 'ON' Koolhas, Jerry

North Unit Irrigation District
2024 NW Beech Street
Madras Oregon 97741
Phone: (541) 475-3625
Fax: (541) 475-3905
email: pwatson@northunitid.com

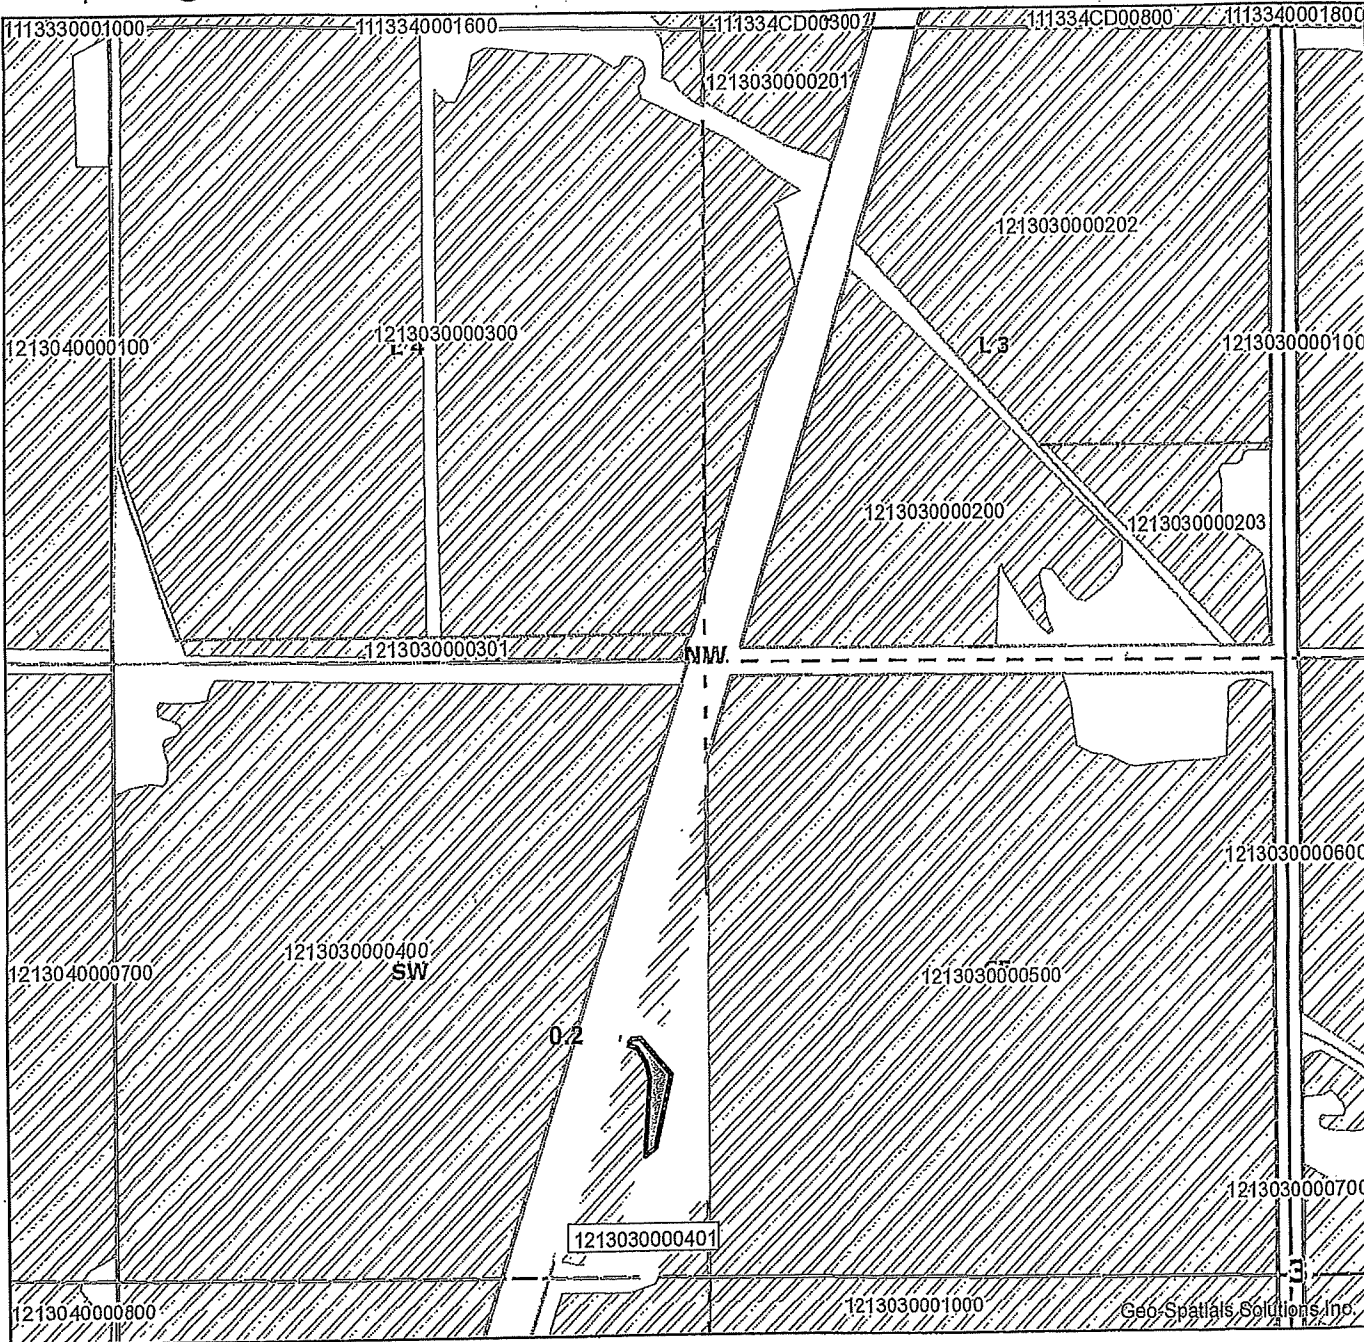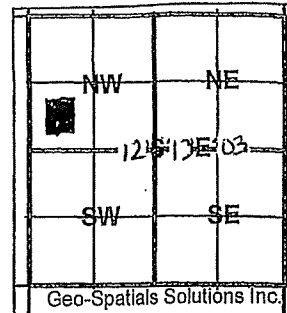

1213030000401 SWNW 0.2 acres 72279 & 72281 'ON'
Received by OWRD



COBU



1 inch = 400 feet



SEP 12 2020

Salem, OR

Claim of Beneficial Use – T12816

2017-10 NUID WRT 'ON' Koolhaas Trust

North Unit Irrigation District
2024 NW Beech Street
Madras Oregon 97741
Phone: (541) 475-3625
Fax: (541) 475-3905
email: pwatson@northunitid.com

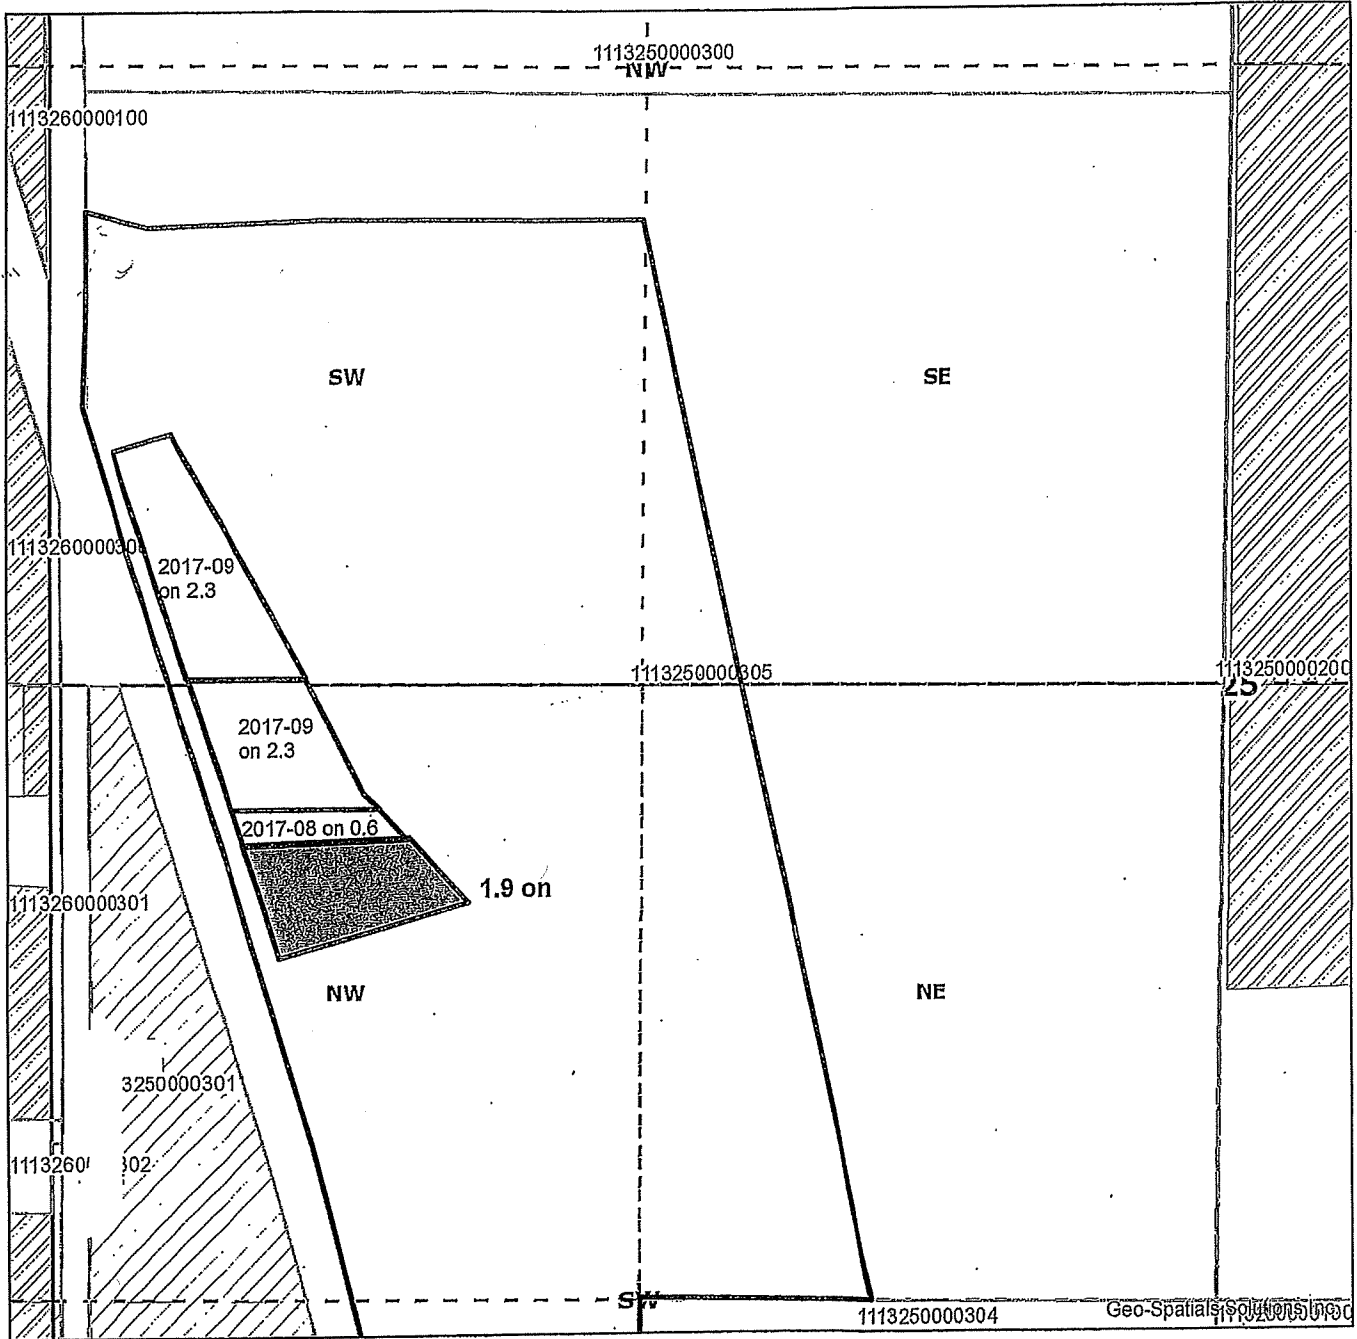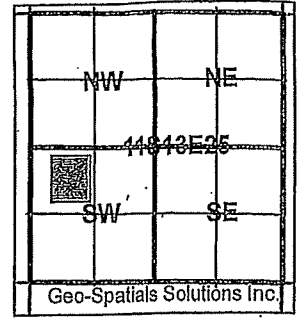

1113250000305 NWSW 1.9 acres 72279 & 72281 'ON'

Received by OWRD

SEP 18 2020



COBU



1 inch = 400 feet



Salem, OR

Claim of Beneficial Use – T12816

Corrected map from
Original Transfer Map

2017-14 NUID Water Right Transfer 'ON' Olivas

North Unit Irrigation District
2024 NW Beech Street
Madras, OR 97741
Phone: (541) 475-3625
Fax: (541) 475-3905
email: pwatson@northunitid.com

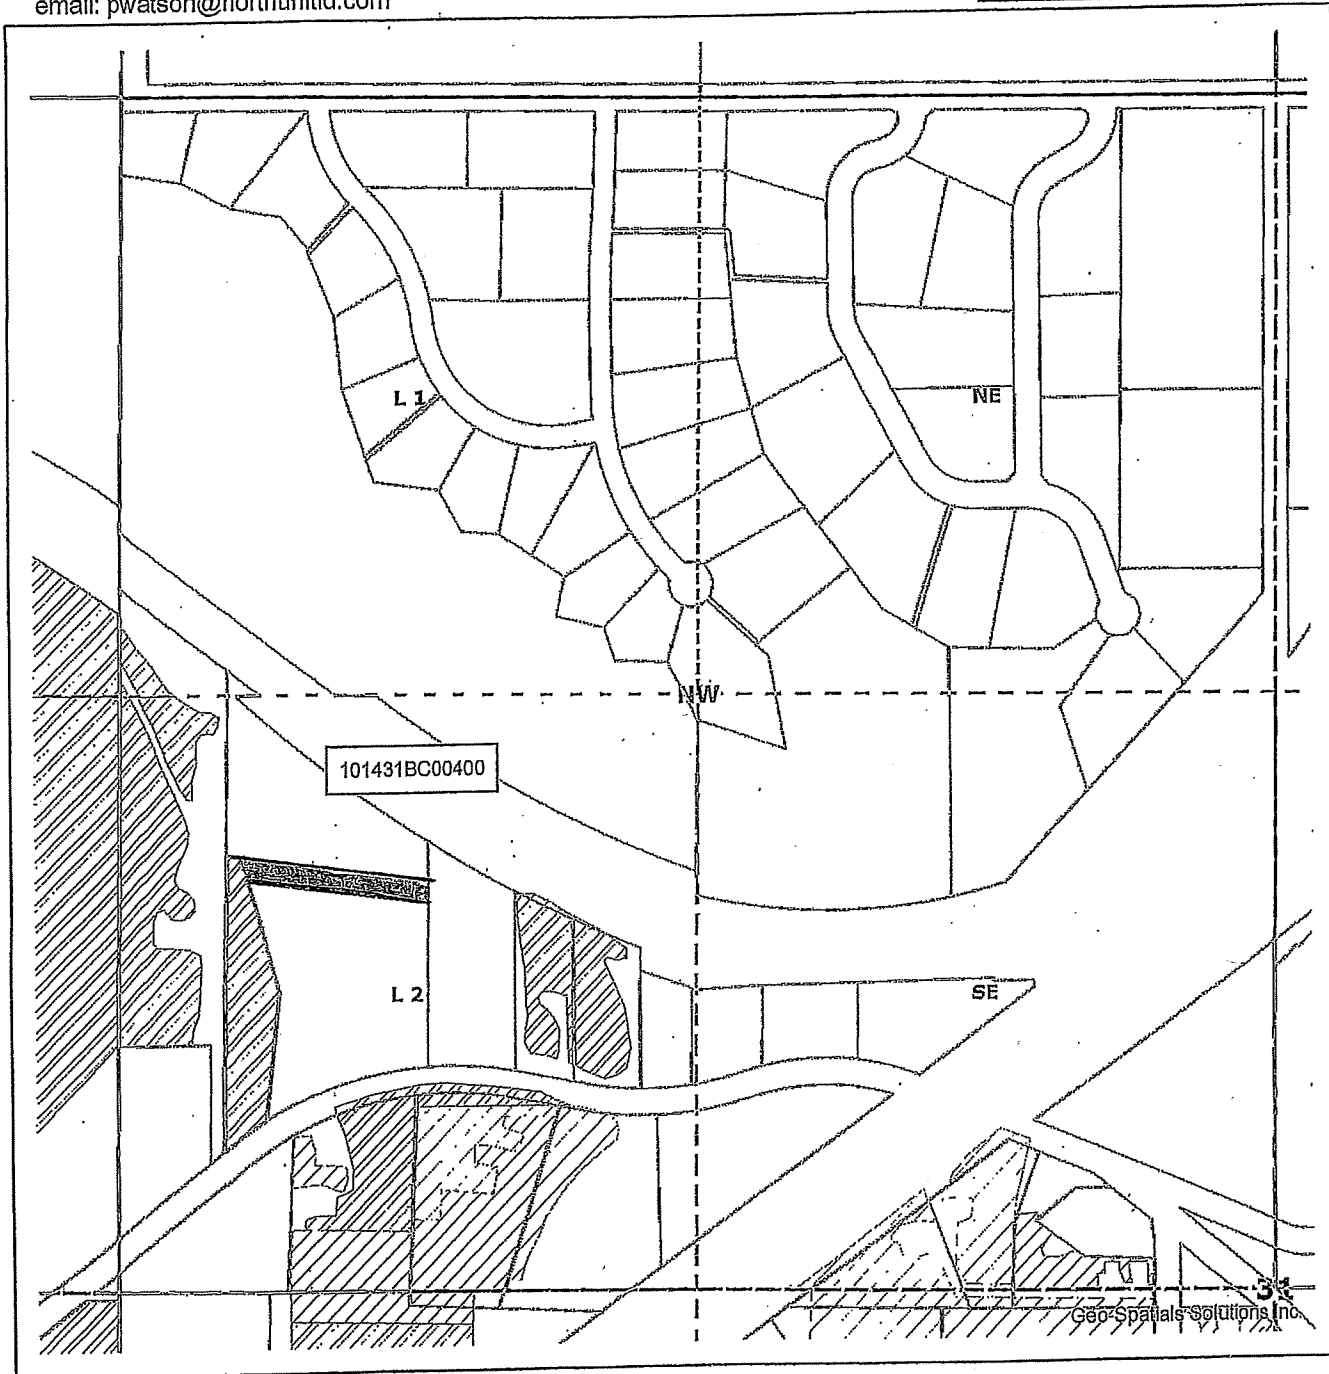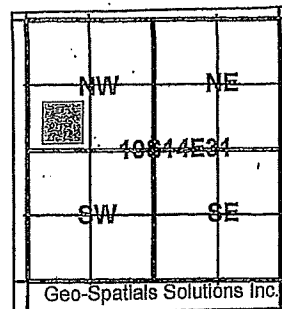

101431BC00400 SWNW 0.5 acres 72279 & 72281

Received by CVRD



1 inch = 400 feet

SEP 12 2020

Salem, OR




COBU

Claim of Beneficial Use – T12816

2017-15 NUID WRT Galyen 'ON'

North Unit Irrigation District
2024 NW Beech Street
Madras, OR 97741
Phone: (541) 475-3625
Fax: (541) 475-3905
email: pwatson@northunitid.com

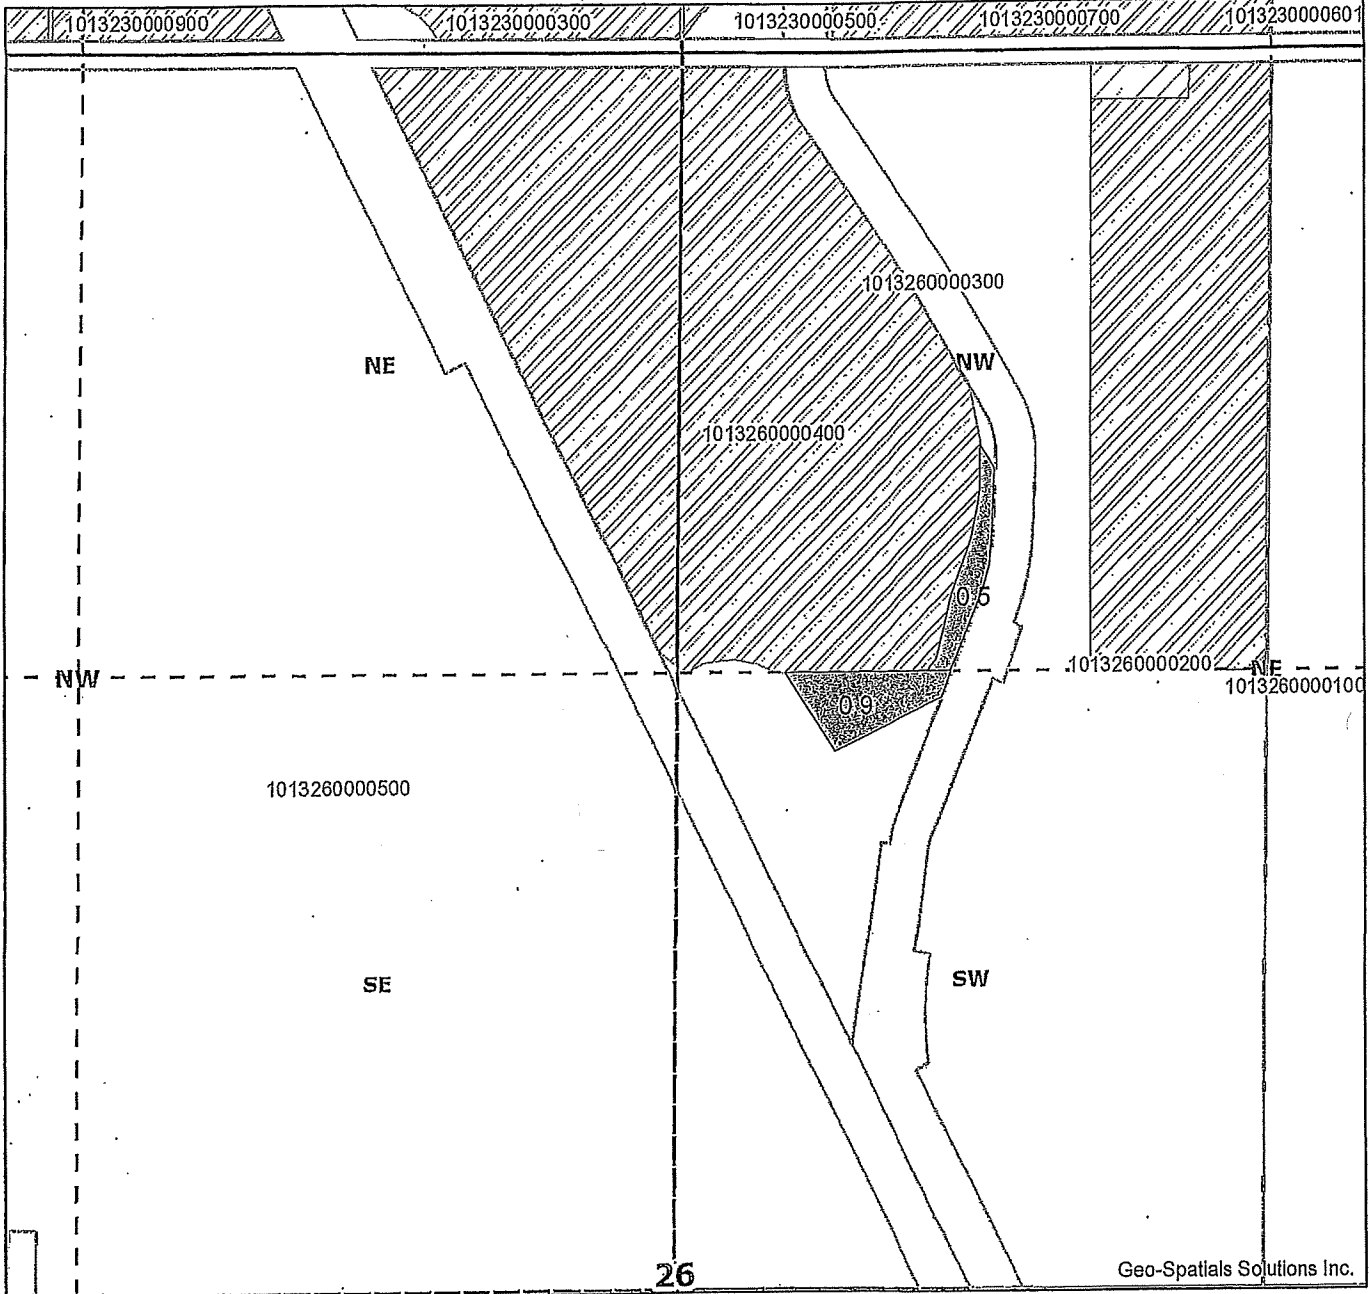

1013260000400 SWNE Transfer 'ON' 0.9 acres 72279 & 72281
1013260000400 NWNE Transfer 'ON' 0.5 acres 72279 & 72281

Received by OVI

COBU



1 inch = 400 feet



SEP 12 2020

Salem, OR

Claim of Beneficial Use – T12816

2017-08 NUID WRT 'ON' Koolhaas Trust

North Unit Irrigation District
2024 NW Beech Street
Madras Oregon 97741
Phone: (541) 475-3625
Fax: (541) 475-3905
email: pwatson@northunitid.com

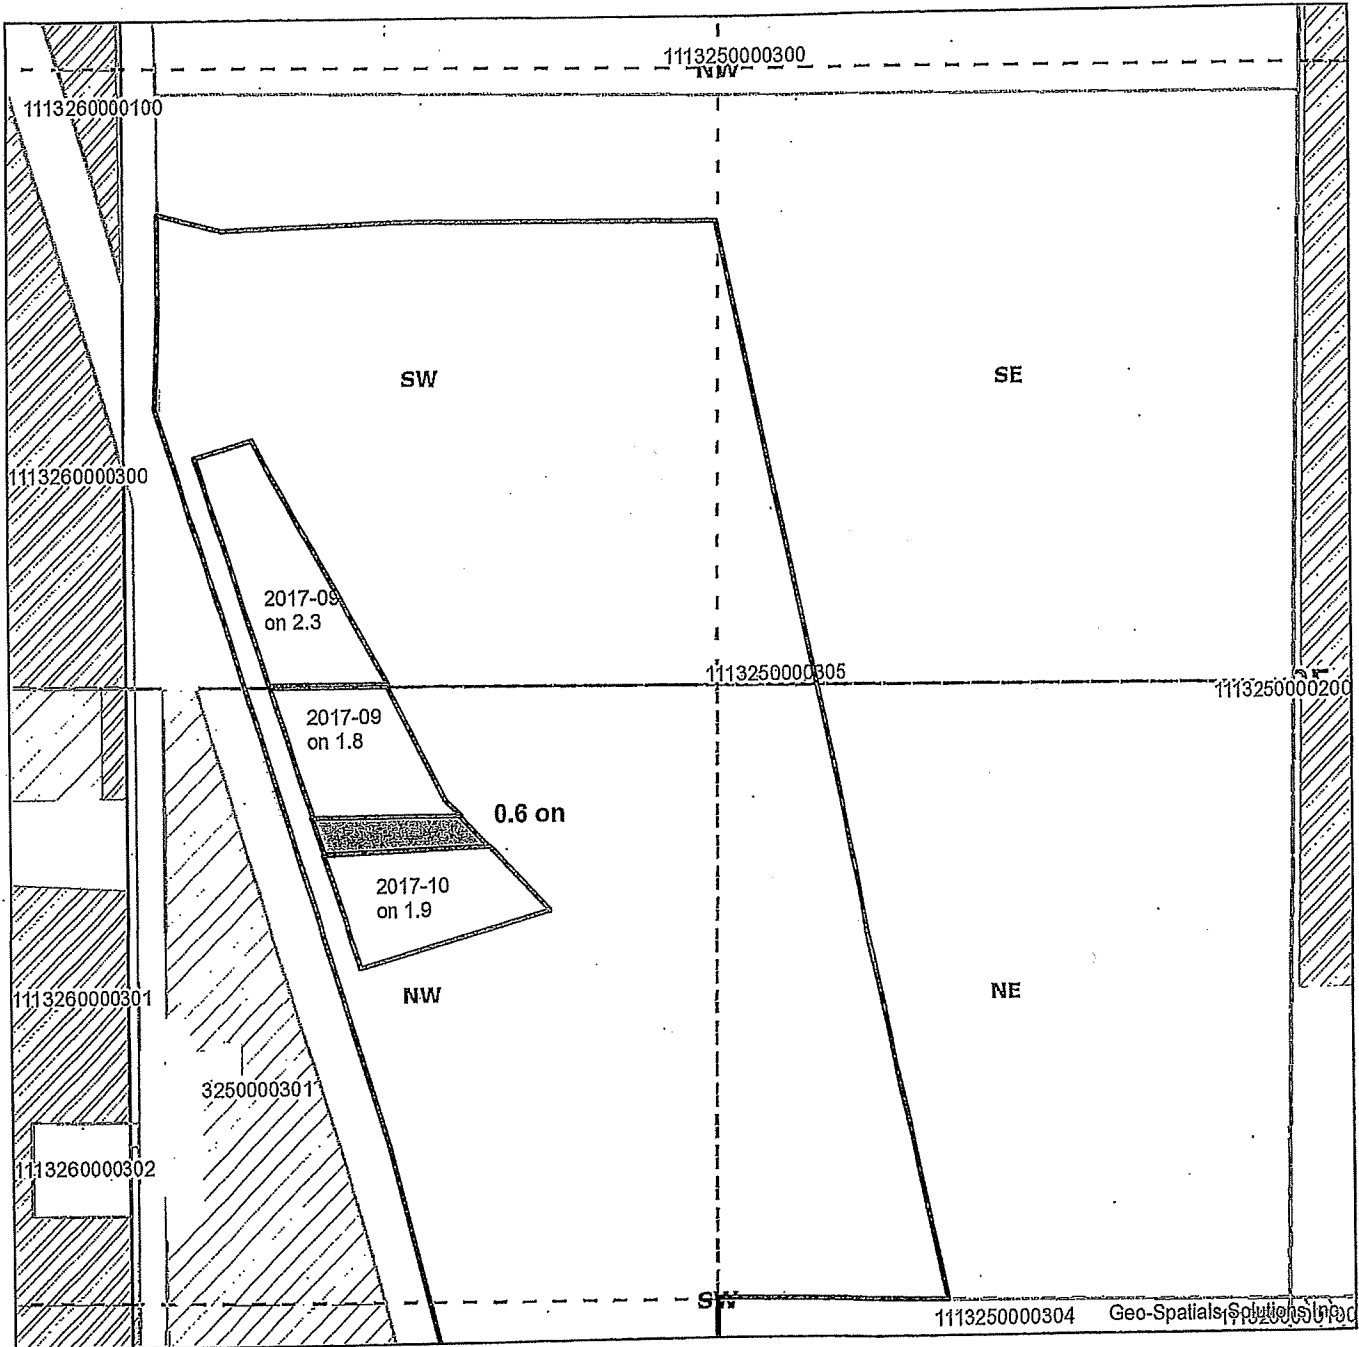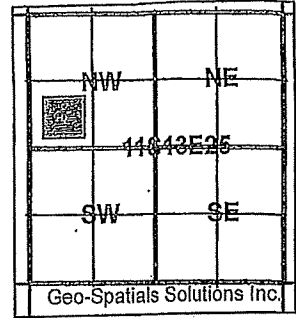

Received by: DWRD

1113250000305 NWSW 0.6 acres 90177 'ON'

SEP 12 2020

Salem, OR



COBU





1 inch = 400 feet

Claim of Beneficial Use – T12816

2017-09 NUID WRT 'ON' Koolhaas Trust

North Unit Irrigation District
 2024 NW Beech Street
 Madras Oregon 97741
 Phone: (541) 475-3625
 Fax: (541) 475-3905
 email: pwatson@northunitid.com

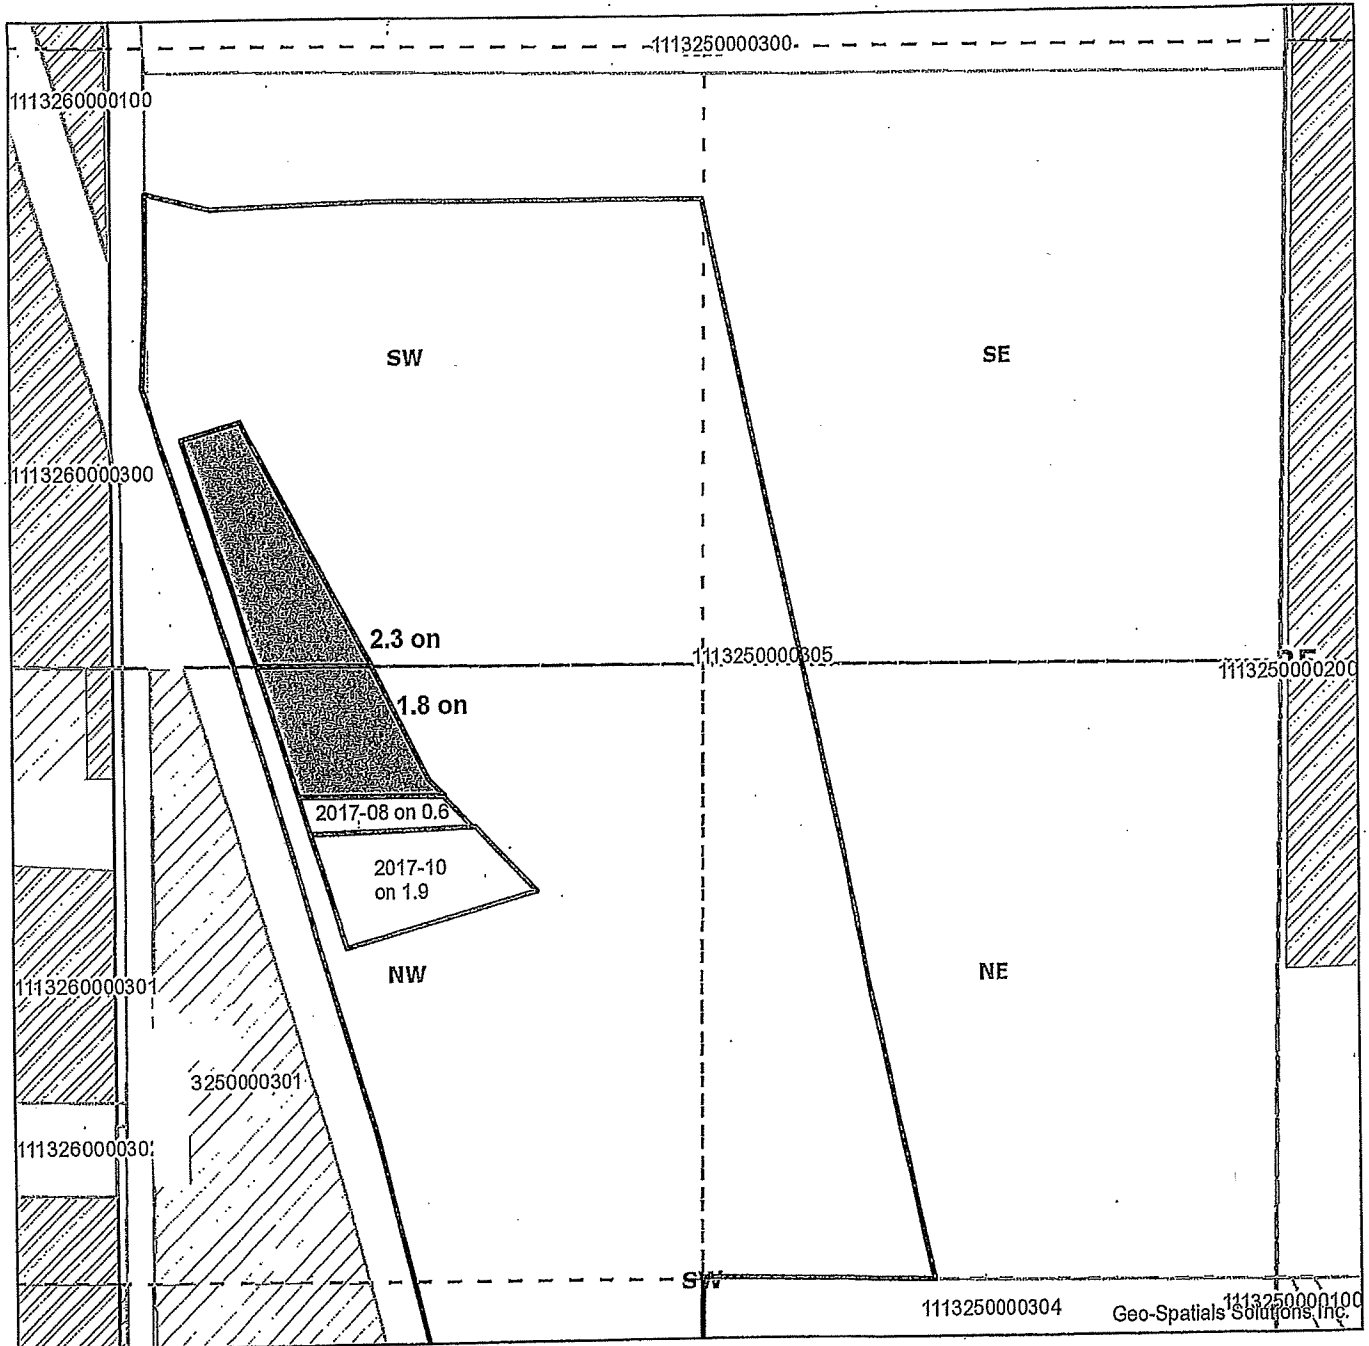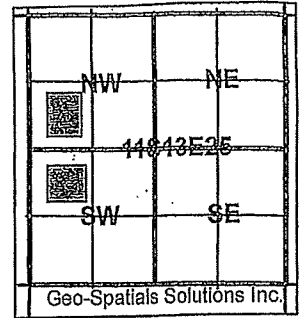

1113250000305 SWNW 2.3 acres 90177 'ON'
 1113250000305 NWSW 1.8 acres 90177 'ON'

Handwritten notes and a circular stamp.



COBU

SEP 12 2020

Salem, OR



1 inch = 400 feet



CLAIM OF BENEFICIAL USE
Site Report

Transfer Number: T - 12816 District Internal Notice #: 17-09

User Name: Koolhaas Family Trust

Place of Use:

Table with 10 columns: USE, POD #, TWP, RNG, SEC, QQ, DLC, GOVT LOT, TAX LOT, ACRES. Handwritten entry: IR, 11, 13, 23, 30S, 4.1

District Conveyance System:

Description of Delivery System:

Headgate: 51-D-3 Canal:

Beneficial Use:

Description of Beneficial Use: Grass Hay

Method Used to Apply Water: Sprinkler

Method Used to Calculate Beneficial Use: on site + maps

User Interviewed: (x) Yes () No

Beneficial Use Made as Authorized: (x) Yes () No

Description of Beneficial Use if Less than Authorized:

Inspected By: G Calhoun

Date: 9/26/2019

Received by OWRD

Instructions: Attach and label the corresponding final proof map.

SEP 1 2 2020

Salem, OR Aug. 2009