
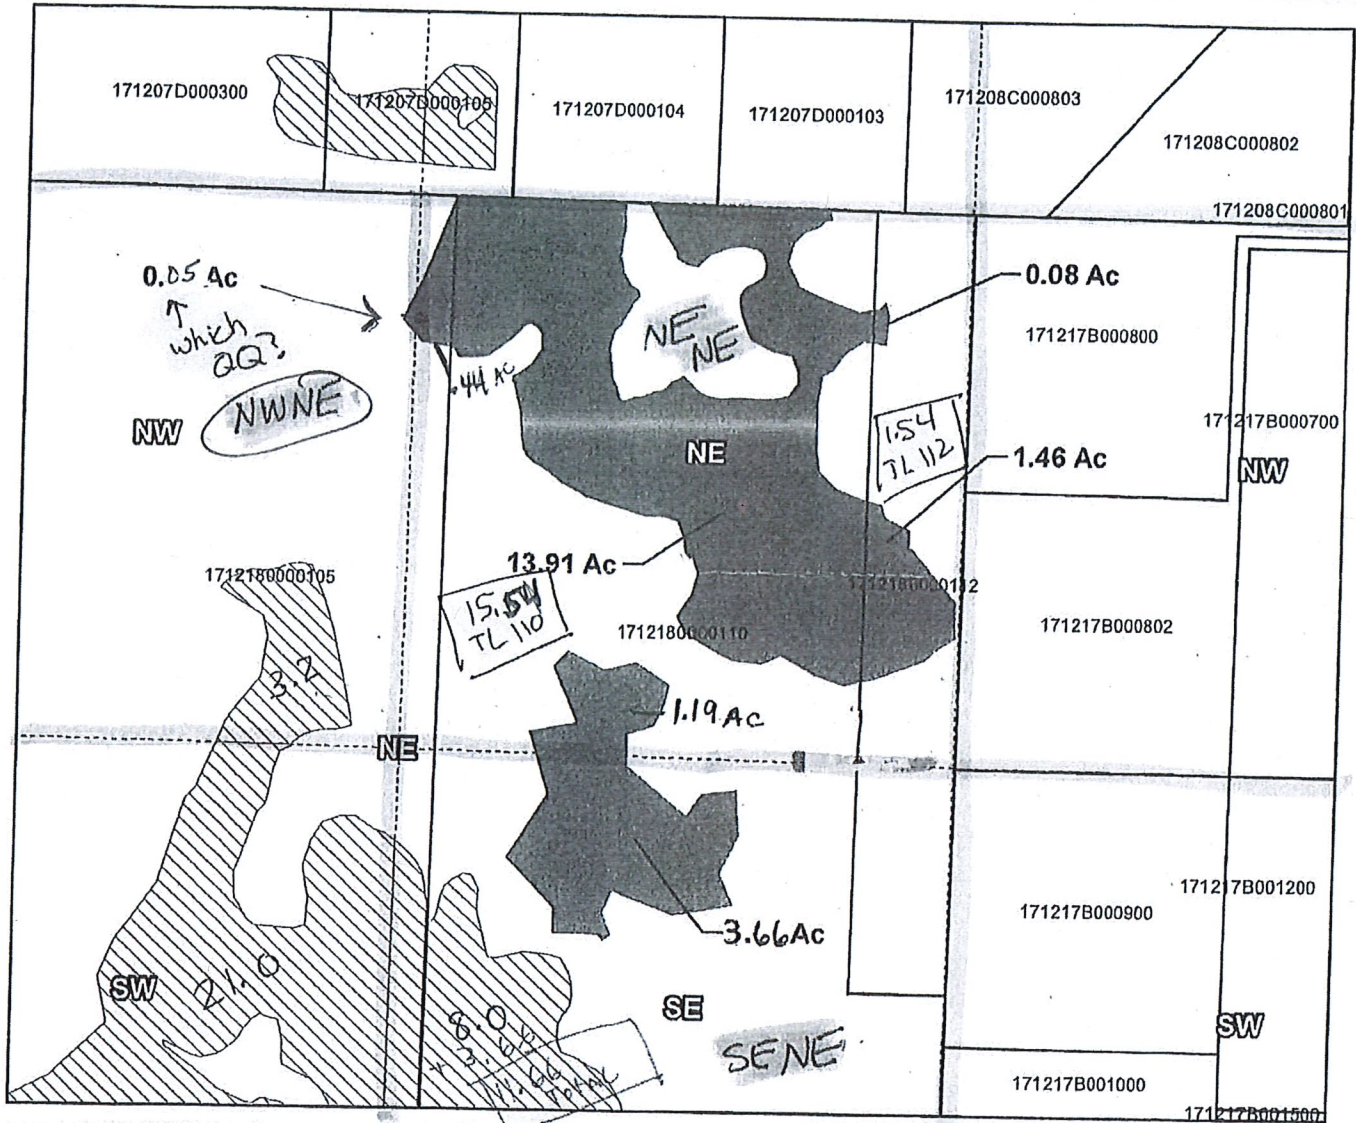


Swalley Irrigation District

2018 District Transfer Application "On" Map 2

Certificates: 74145

for Elkins, Ed

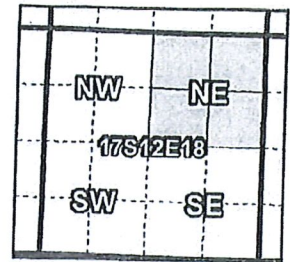

Taxlot 1712180000105, T17S R12E 18 NWNE 0.05 Acres On, 3.25 Acres Total (Cert # 74145)*
 Taxlot 1712180000110, T17S R12E 18 NE/NE: 15.54 Acres On, 15.54 Acres Total (Cert # 74145)
 Taxlot 1712180000112, T17S R12E 18 NE/NE: 1.54 Acres On, 1.54 Acres Total (Cert # 74145)
 Taxlot 1712180000110 T17S R12E 18 NE/SE: 3.66 Acres On, 11.66 Acres Total

- Pipelines and Canals
- Transfer
- Primary Water Right
- Taxlots

RECEIVED

MAY 29 2018

OWRD



Received by OWRD

1 inch = 400 feet

SEP 17 2018

Salem, OR

Prepared by Swalley Irrigation District | APRIL 2018



T-12939

Swalley Irrigation District

2018 District Transfer Application "On" Map 1

Certificates: 74145

for Elkins, Ed

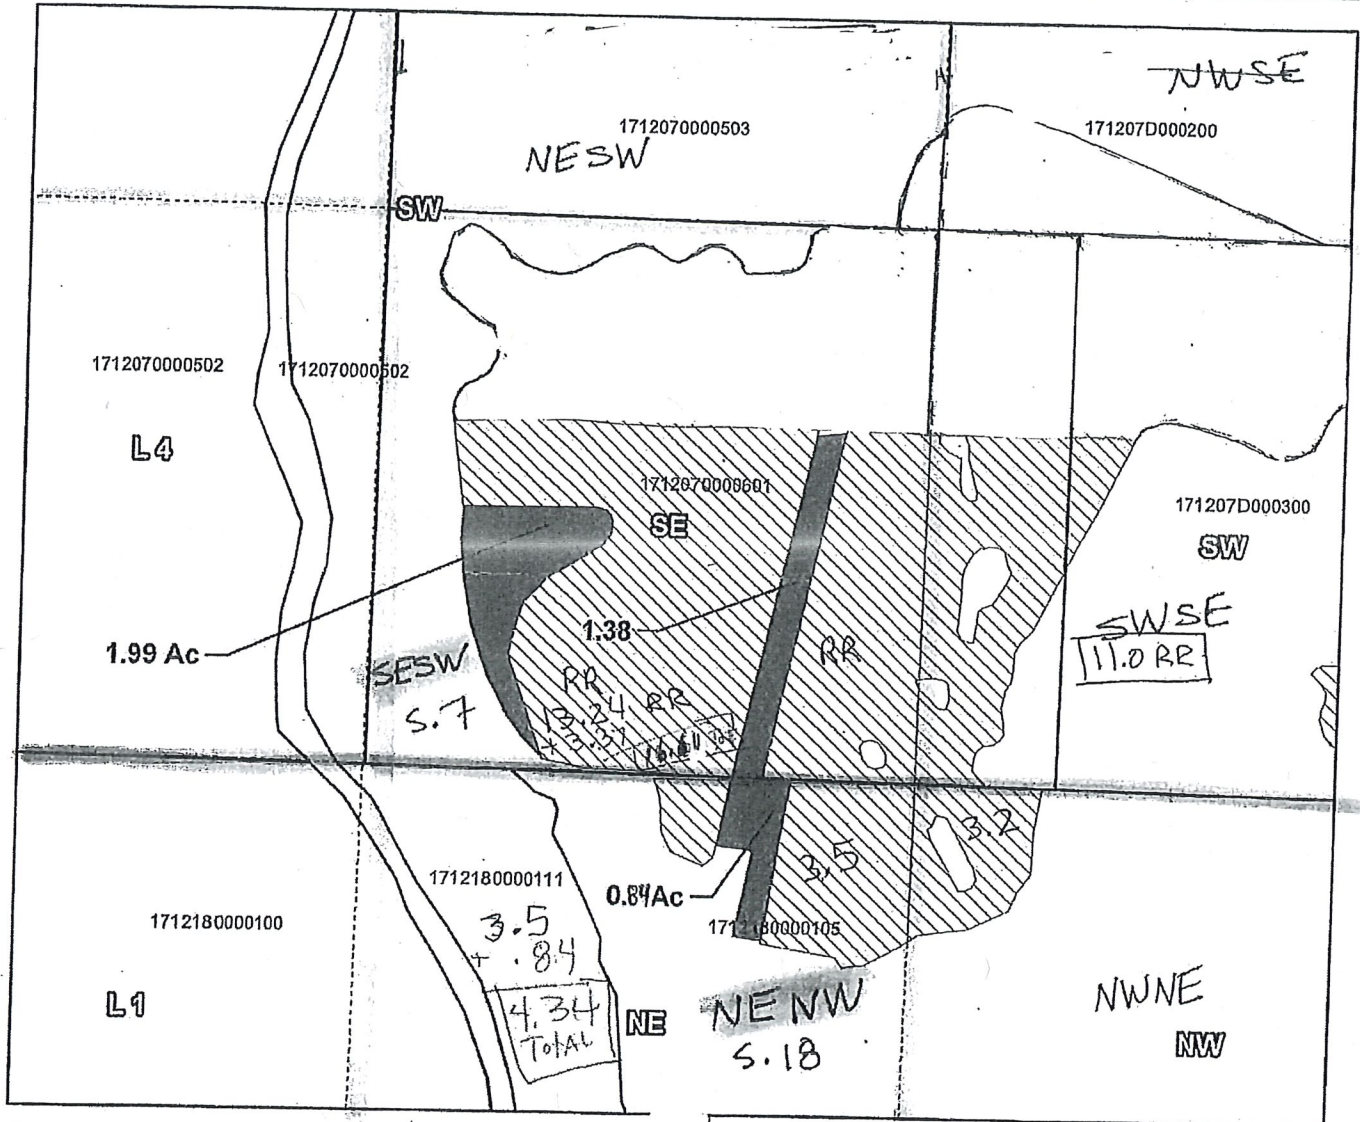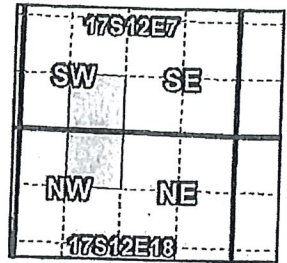

Taxlot 1712070000601, T17S R12E 07 SW/SE: 3.37 Acres On, 16.61 Acres Total (Cert # 74145)
 Taxlot 1712180000105, T17S R12E 18 NENW: 0.84 Acres On, 4.34 Acres Total (Cert # 74145)*
 * Includes ON acres from Map 2

- Pipelines and Canals
- Transfer
- ▨ Primary Water Right
- Taxlots

1 inch = 400 feet

Received by OWRD
SEP 17 2018
Salem, OR

RECEIVED
 MAY 29 2018
 OWRD

Prepared by Swalley Irrigation District | APRIL 2018



T-12939

Swalley Irrigation District

2018 District Transfer Application "Off" Map

Certificates: 74145

for Elkins, Ed

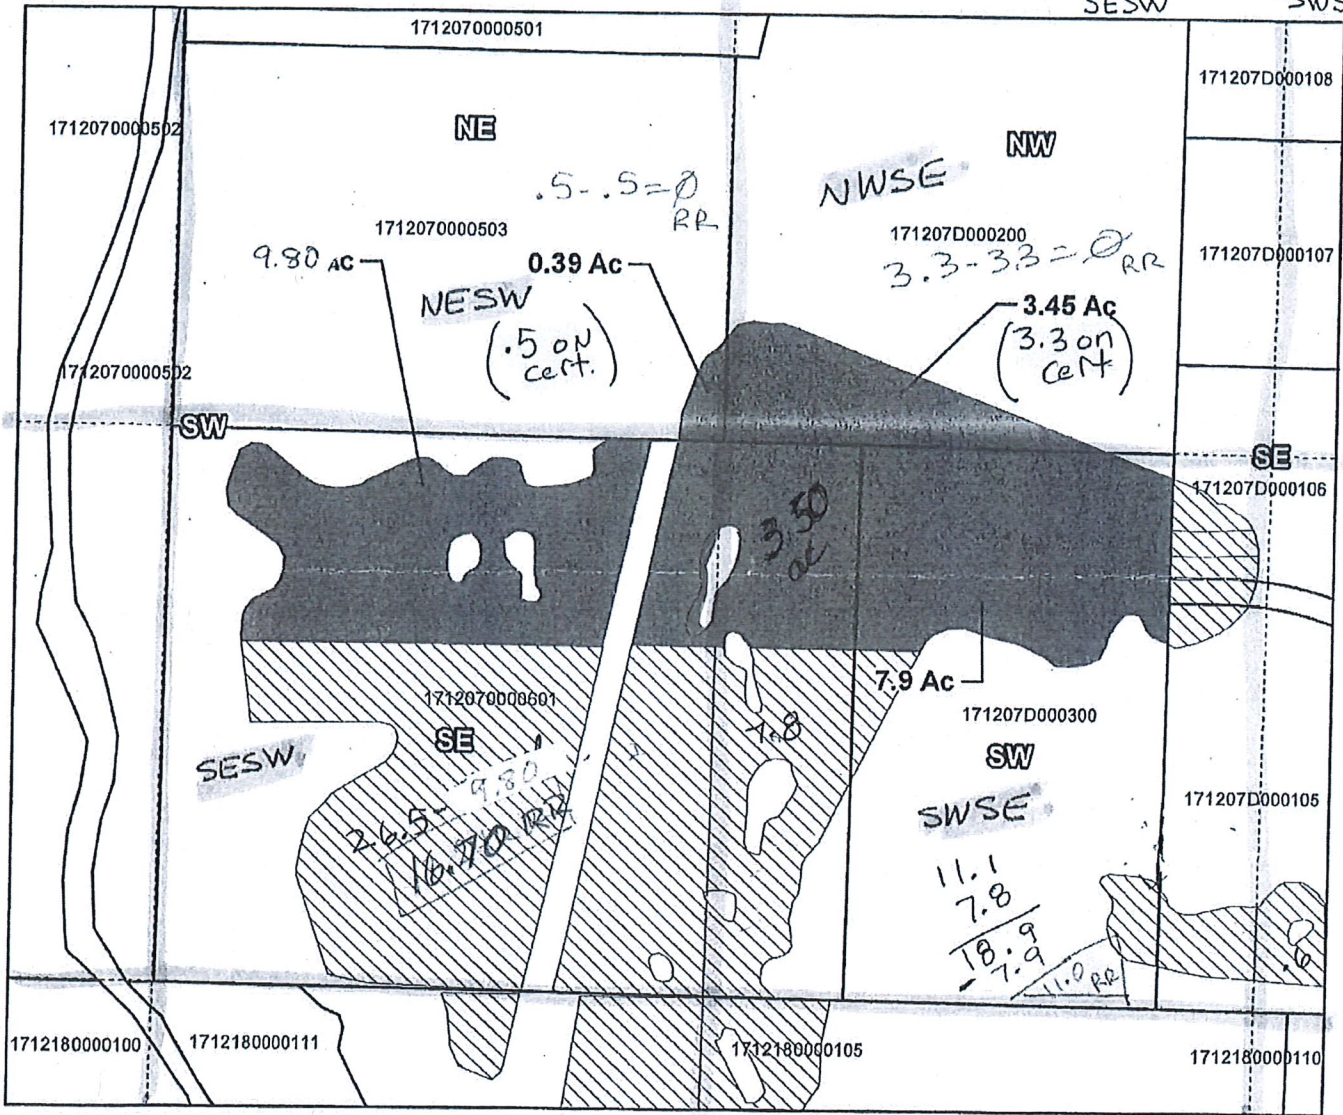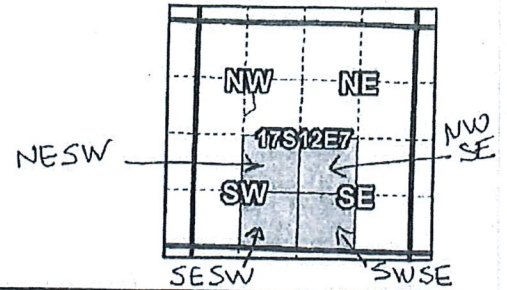

Taxlot 1712070000503, T17S R12E 07 SW/WNE: 0.50 Acres Off, 0.00 Acres Remaining (Cert # 74145)
 Taxlot 171207D000200, T17S R12E 07 SW/NW: 3.30 Acres Off, 0.00 Acres Remaining (Cert # 74145)
 Taxlot 1712070000601, T17S R12E 07 SW/SE: 9.80 Acres Off, 16.70 Acres Remaining (Cert # 74145)
 Taxlot 171207D000300, T17S R12E 07 SW/SW: 7.9 Acres Off, 11.00 Acres Remaining (Cert # 74145)
 Taxlot 171207D000601, T17S R12E 07 SW/SE: 3.50 Acres Off, 4.30 Acres Remaining

- Pipelines and Canals
- Transfer
- Taxlots
- Primary Water Right



1 inch = 400 feet

Received by OWRD RECEIVED

SEP 17 2018

MAY 29 2018

Salem, OR

OWRD

Prepared by Swalley Irrigation District | APRIL 2018

T-12939