


ACMPC Oregon 2, LLC
 Halls Ferry Farms
 Groundwater Registration Modification - GR 1510

Township 8S, Range 4W

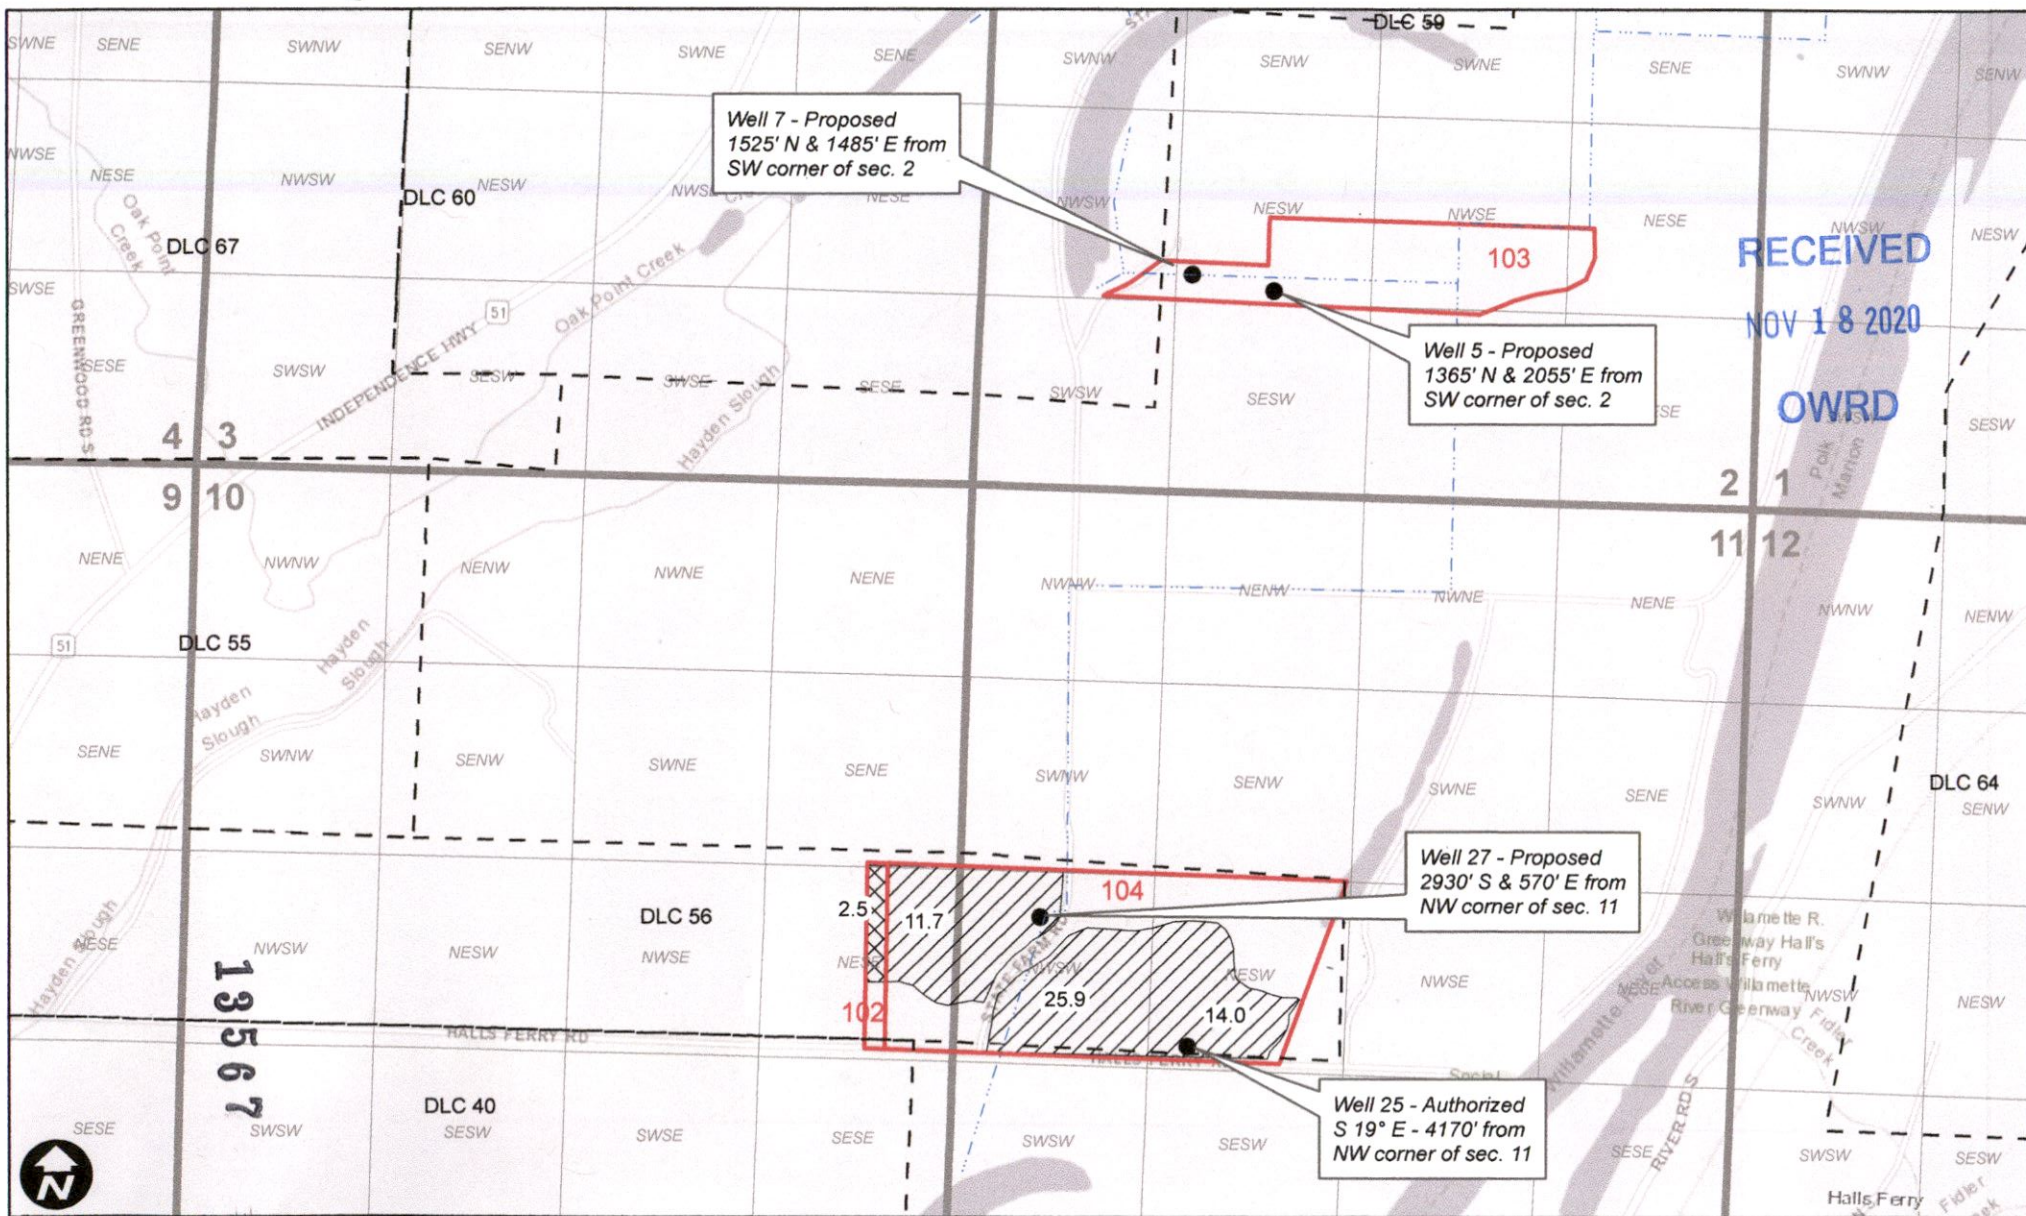

Legend

- GR 1510 APOA
- GR 1510 No Change
- Irrigation Mainline
- Tax Lot
- DLC