


T.6S. R.5W. W.M.

POLK COUNTY, OREGON

Page 1 of 5

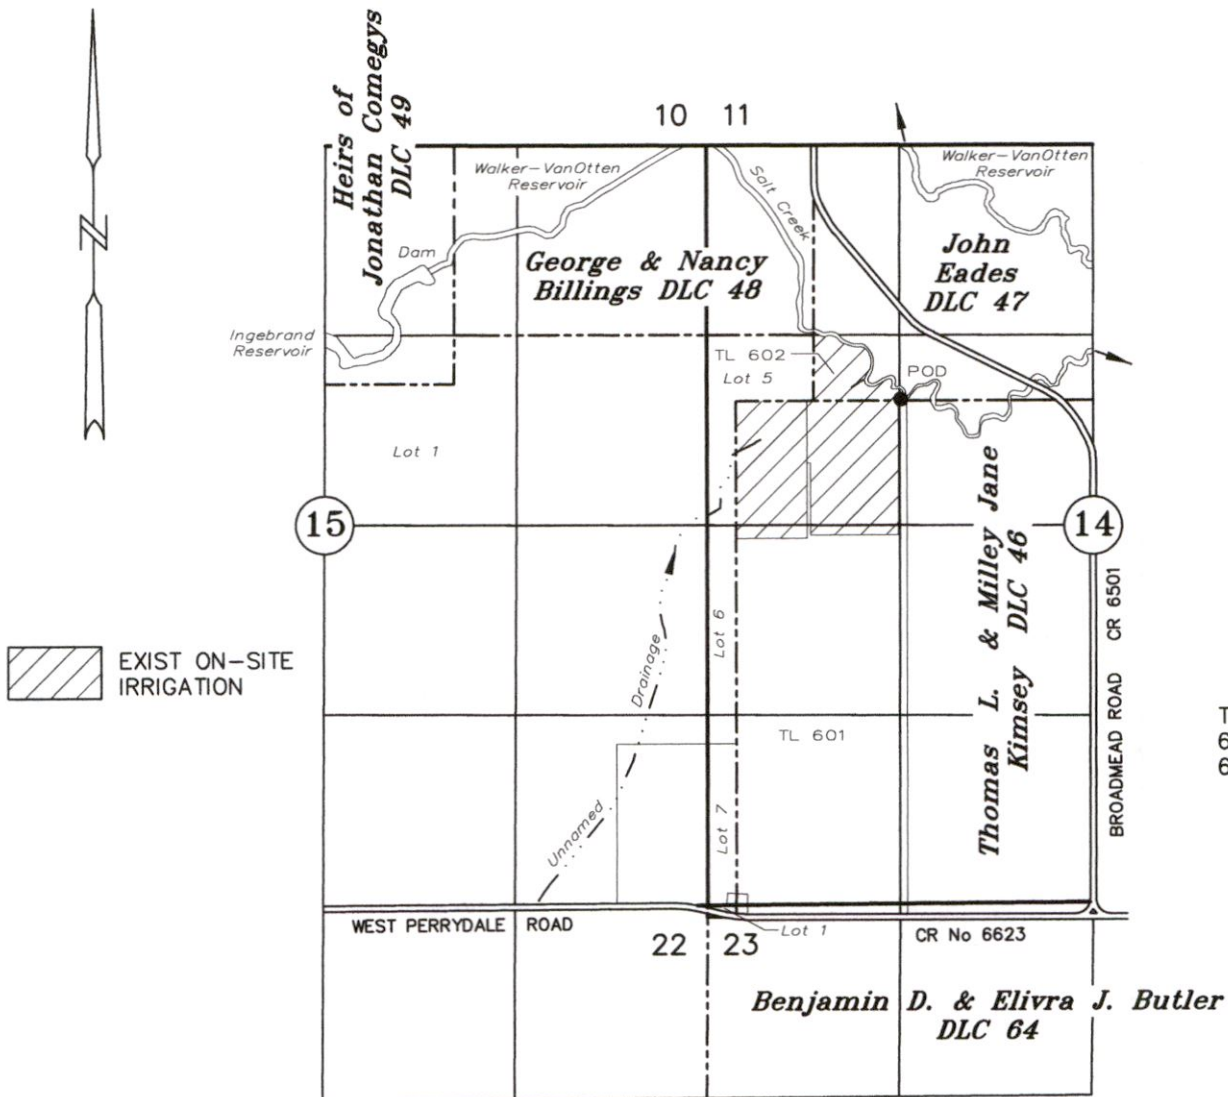

TAX LOTS
6 5 14 601
6 5 14 602

POD: 10' NORTH AND 1100' EAST OF NW COR KIMSEY DLC 46

Transfer of a Water Right

PLACE OF USE

Certificates No. 29946, 32695 & 39204 Application No. T-

Perrydale Hills Vineyard, LLC

November 11, 2020

SCALE 1" = 1320'

RECEIVED

NOV 19 2020

OWRD



13561


Renews: 12-31-2021

NOTE: This map is for the purpose of identifying the location of water rights and has no intent to dimension or locate property ownership lines.

T.6S. R.5W. W.M.

POLK COUNTY, OREGON

Page 2 of 5

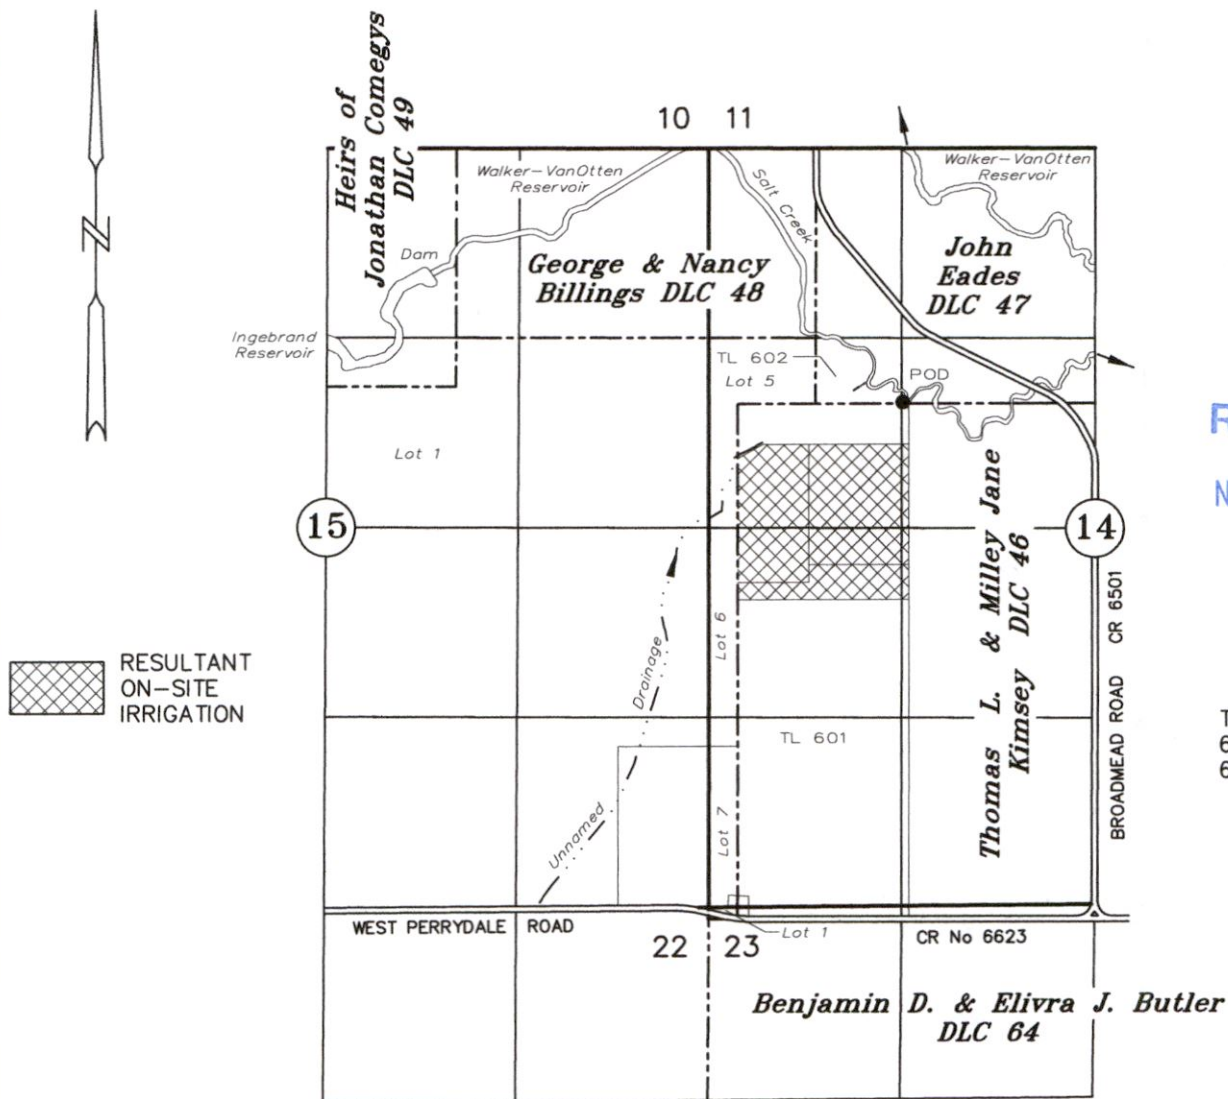

RECEIVED

NOV 19 2020

OWRD

TAX LOTS
6 5 14 601
6 5 14 602

POD: 10' NORTH AND 1100' EAST OF NW COR KIMSEY DLC 46

Transfer of a Water Right


PLACE OF USE

Certificates No. 29946, 32695 & 39204 Application No. T-

Perrydale Hills Vineyard, LLC

November 11, 2020

SCALE 1" = 1320'

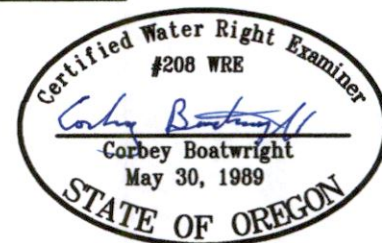

NOTE: This map is for the purpose of identifying the location of water rights and has no intent to dimension or locate property ownership lines.


Renews: 12-31-2021

13561

T.6S. R.5W. W.M.

POLK COUNTY, OREGON

Page 3 of 5

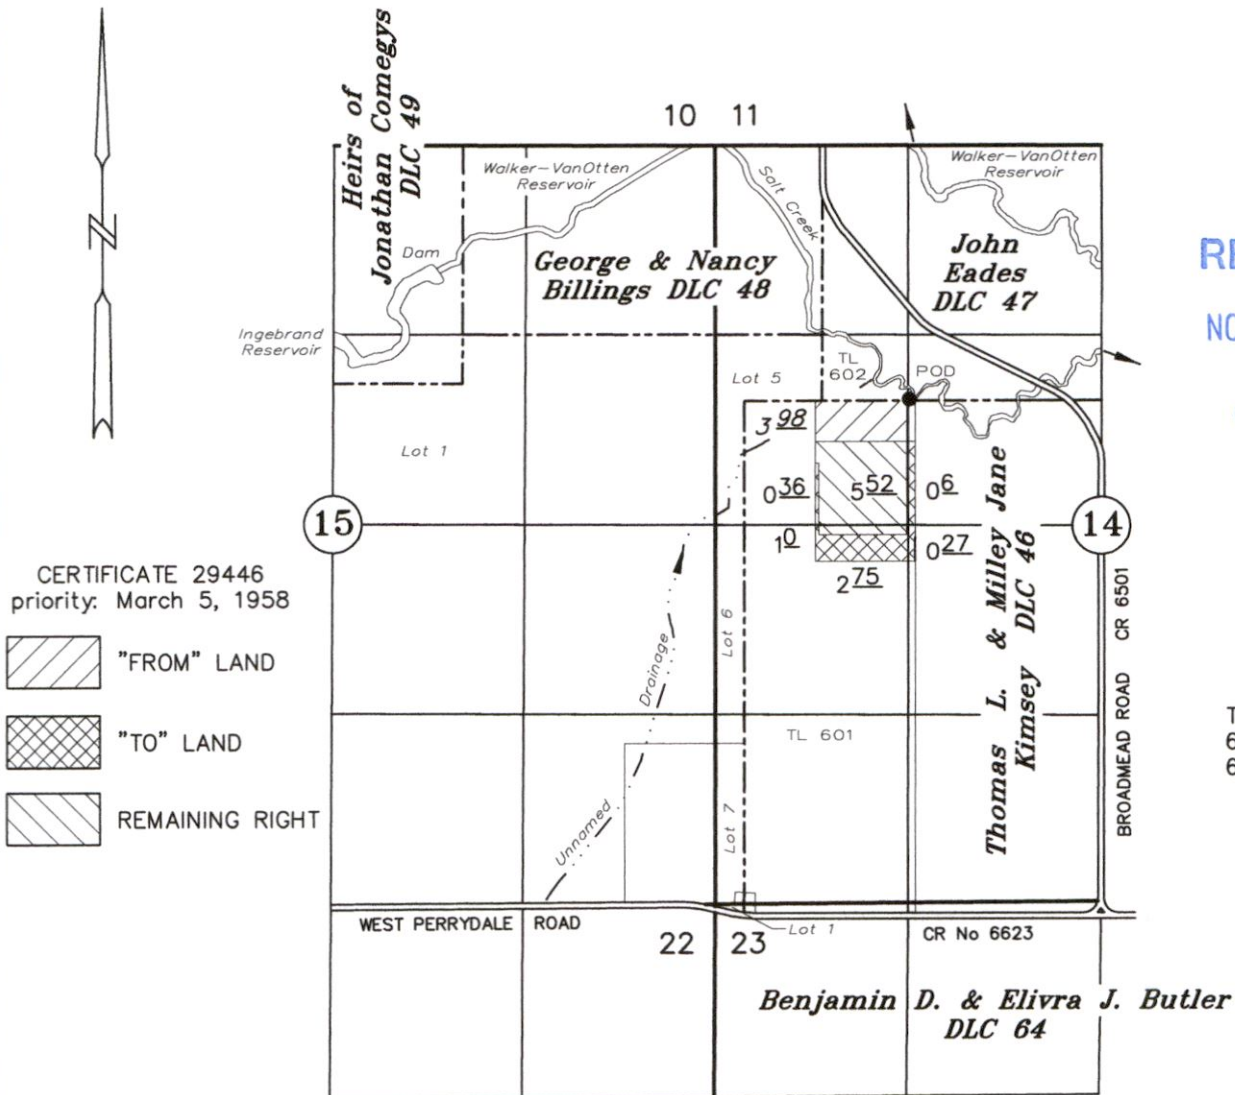

RECEIVED

NOV 19 2020

OWRD

POD: 10' NORTH AND 1100' EAST OF NW COR KIMSEY DLC 46

Transfer of a Water Right


PLACE OF USE

Certificates No. 29946, 32695 & 39204 Application No. T-

Perrydale Hills Vineyard, LLC

November 11, 2020

SCALE 1" = 1320'

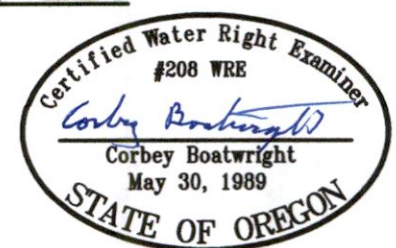

NOTE: This map is for the purpose of identifying the location of water rights and has no intent to dimension or locate property ownership lines.


Renews: 12-31-2021

13561

T.6S. R.5W. W.M.


POLK COUNTY, OREGON

Page 4 of 5

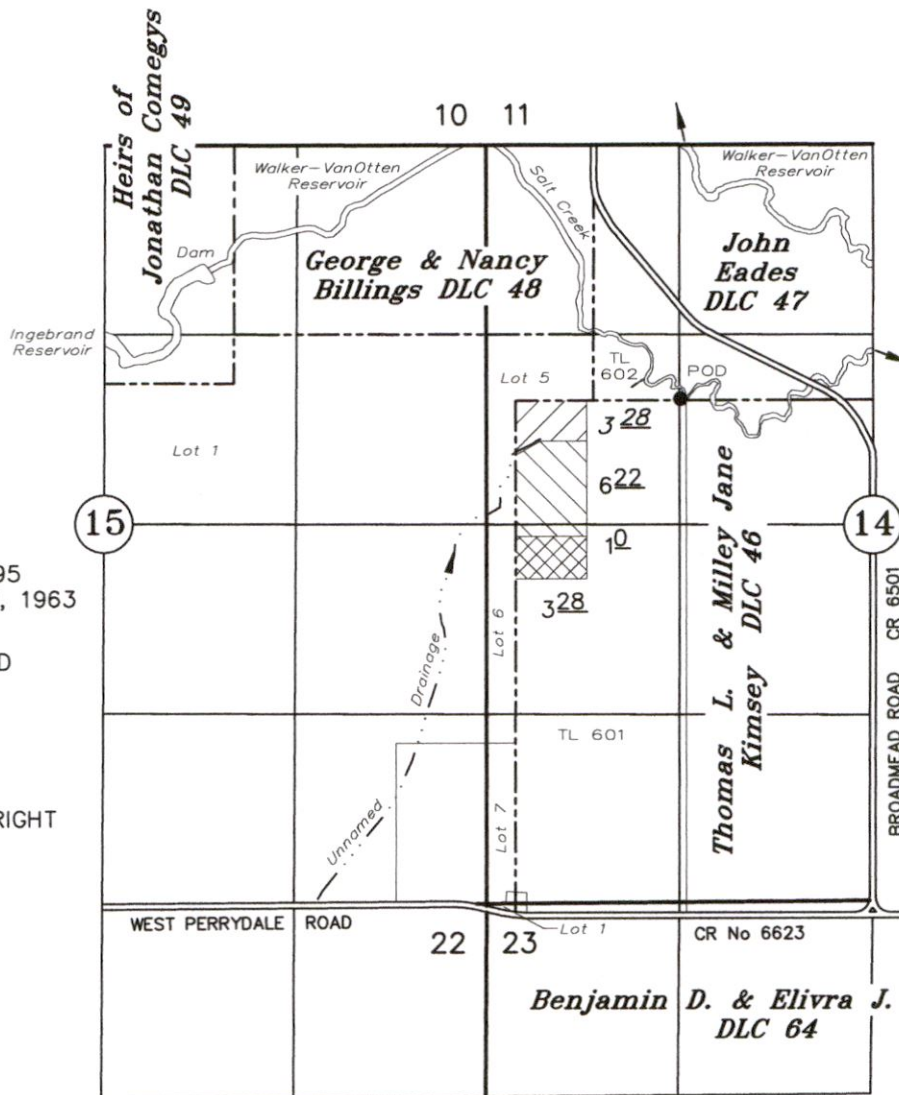

RECEIVED
NOV 19 2020
OWRD

CERTIFICATE 32695
priority: December 27, 1963

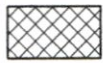-  "FROM" LAND
-  "TO" LAND
-  REMAINING RIGHT

TAX LOTS
6 5 14 601
6 5 14 602

POD: 10' NORTH AND 1100' EAST OF NW COR KIMSEY DLC 46

Transfer of a Water Right

PLACE OF USE

Certificates No. 29946, 32695 & 39204 Application No. T-

Perrydale Hills Vineyard, LLC

November 11, 2020

SCALE 1" = 1320'



NOTE: This map is for the purpose of identifying the location of water rights and has no intent to dimension or locate property ownership lines.


13561

Renews: 12-31-2021

T.6S. R.5W. W.M.

POLK COUNTY, OREGON

Page 5 of 5

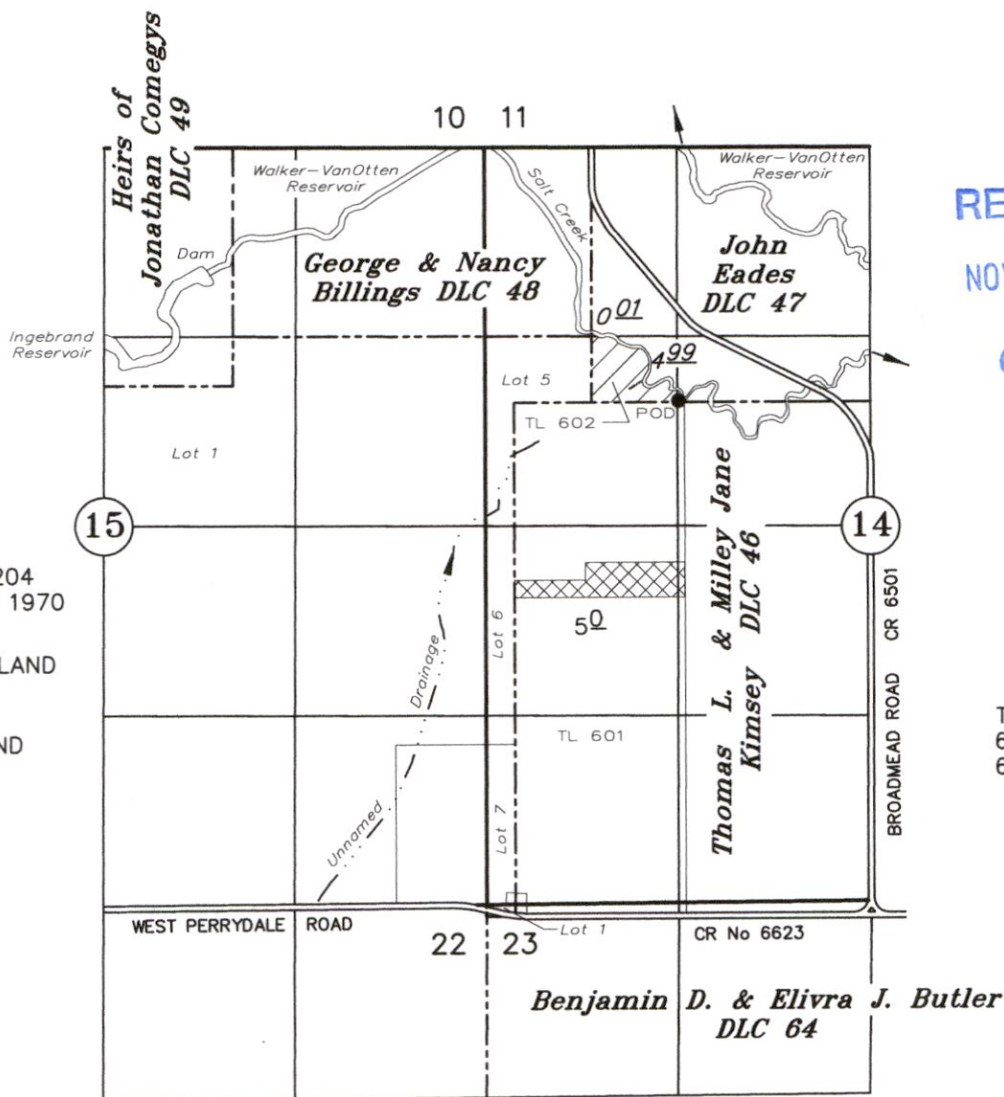

RECEIVED

NOV 19 2020

OWRD

CERTIFICATE 39204
priority August 27, 1970



"FROM" LAND



"TO" LAND

TAX LOTS
6 5 14 601
6 5 14 602

POD: 10' NORTH AND 1100' EAST OF NW COR KIMSEY DLC 46

Transfer of a Water Right

PLACE OF USE

Certificates No. 29946, 32695 & 39204 Application No. T-


Perrydale Hills Vineyard, LLC

November 11, 2020

SCALE 1" = 1320'

NOTE: This map is for the purpose of identifying the location of water rights and has no intent to dimension or locate property ownership lines.

13561

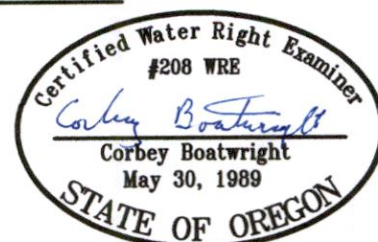

Renews: 12-31-2021