

RECEIVED

DEC 21 2020

OWRD

1346.7

1349.4

1350.1

200

40.3

40.3

11.3

23.7

1343.4

1344.0

1344.0

1344.0

400

40.3

40.2

2.0

Back  
LO on  
T13099 in  
2016

9.5

33.0

1.0 off  
T12556  
2016

1342.7

1342.8

1.0 on  
T12556

1343.4

1343.4

40.3

40.2

501

1.5 off  
T12556

5.0

11.0

1.0  
Ac off  
T13099

5.5

1342.7

12.8

21.0  
20.5

1343.4

upper 0.1



SCALE:  
1" = 400'

5 on  
T12556

48-102-

T-13099  
Final Order  
Tax Lot 400 22S46E04 NESE  
ON 1.0 Acres


SEC. 4 , T.22 S., R.46 E., W.M.

RECEIVED

DEC 21 2020

OWRD

NW NW

  
 N  
 Scale 1" = 400'  
 Sec 10  
 T22S R46 E

T-13099  
 Final Order  
 Tax Lot 200 22S46E10 NWNW  
 ON 3.5 Acres



T12556

1320.7

13



CLAIM OF BENEFICIAL USE
Site Report

RECEIVED

DEC 21 2020

OWRD

Transfer Number: T - 13099 District Internal Notice #: 2018-03

User Name: Garold Johnston

Place of Use:

Table with 10 columns: USE, POD #, TWP, RNG, SEC, QQ, DLC, GOV'T LOT, TAX LOT, ACRES. Contains two rows of data for 'Irr' use.

District Conveyance System:

Description of Delivery System: Gravity

Headgate: 13.5.2 Canal: 5.7-2.5 Lateral

Beneficial Use:

Description of Beneficial Use: Crops

Method Used to Apply Water: Sprinklers

Method Used to Calculate Beneficial Use: Flow Meter

User Interviewed: [X] Yes ( ) No

Beneficial Use Made as Authorized: [X] Yes ( ) No

Description of Beneficial Use if Less than Authorized:

Inspected By: [Signature] Date: 9/28/2

Instructions: Attach and label the corresponding final proof map.


Sec 13 T22S R46E

NAPTON RD

RECEIVED

DEC 21 2020

OWRD

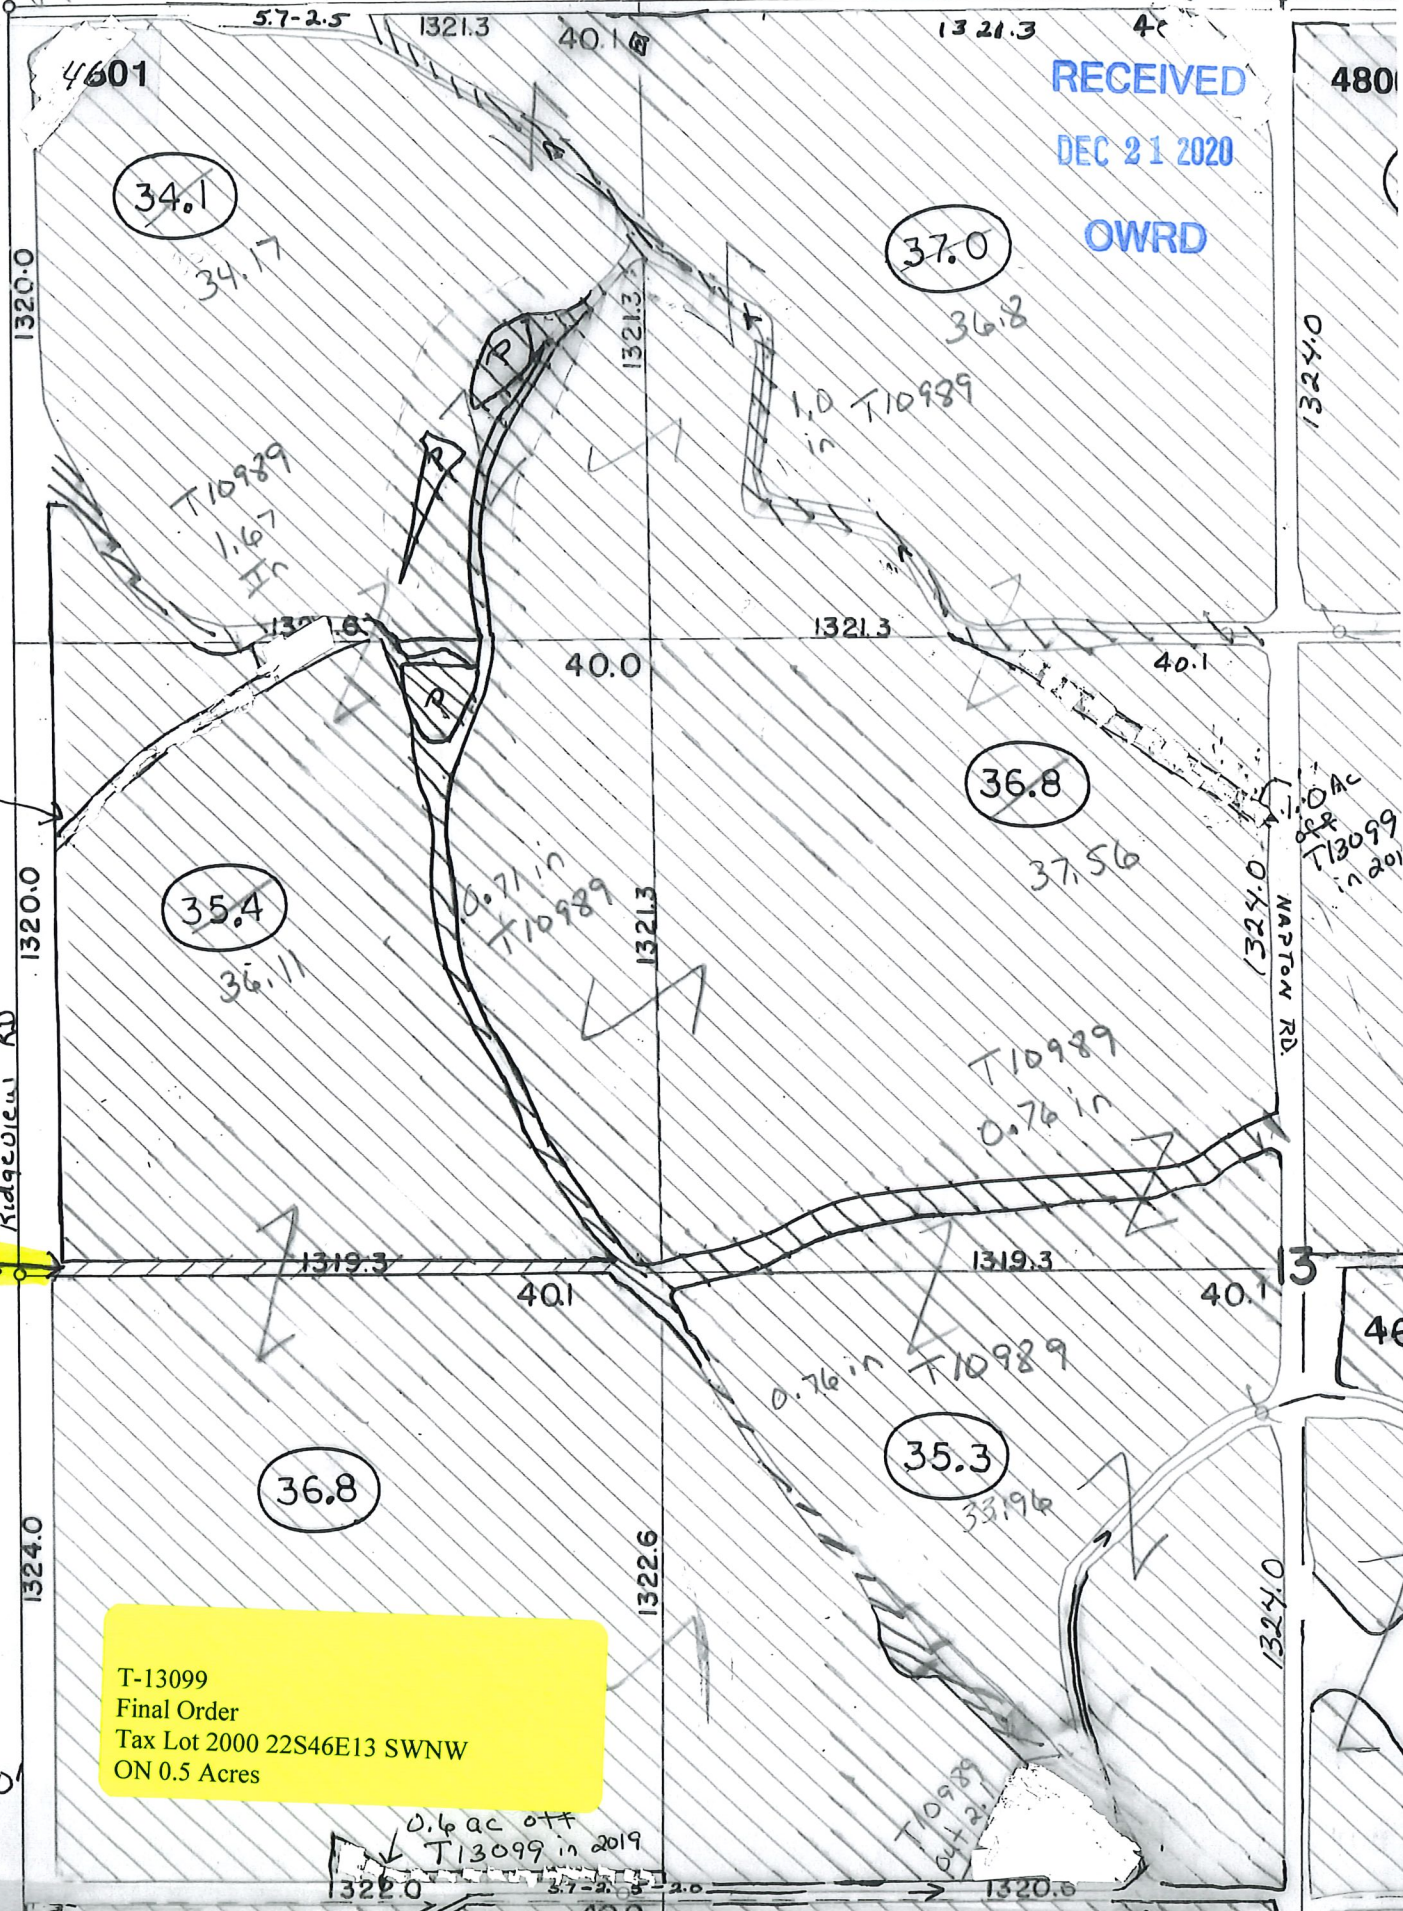

T-13099  
 Final Order  
 Tax Lot 2000 22S46E13 SWNW  
 ON 0.5 Acres

0.4 ac  
 off  
 T13099  
 in 2019

0.5 ac  
 T13099  
 in 2019


Scale  
 1" = 400'

0.6 ac off  
 T13099 in 2019

0.10 ac  
 off  
 T13099  
 in 2019

T10989  
 0.4 ac  
 off

NAPTON RD

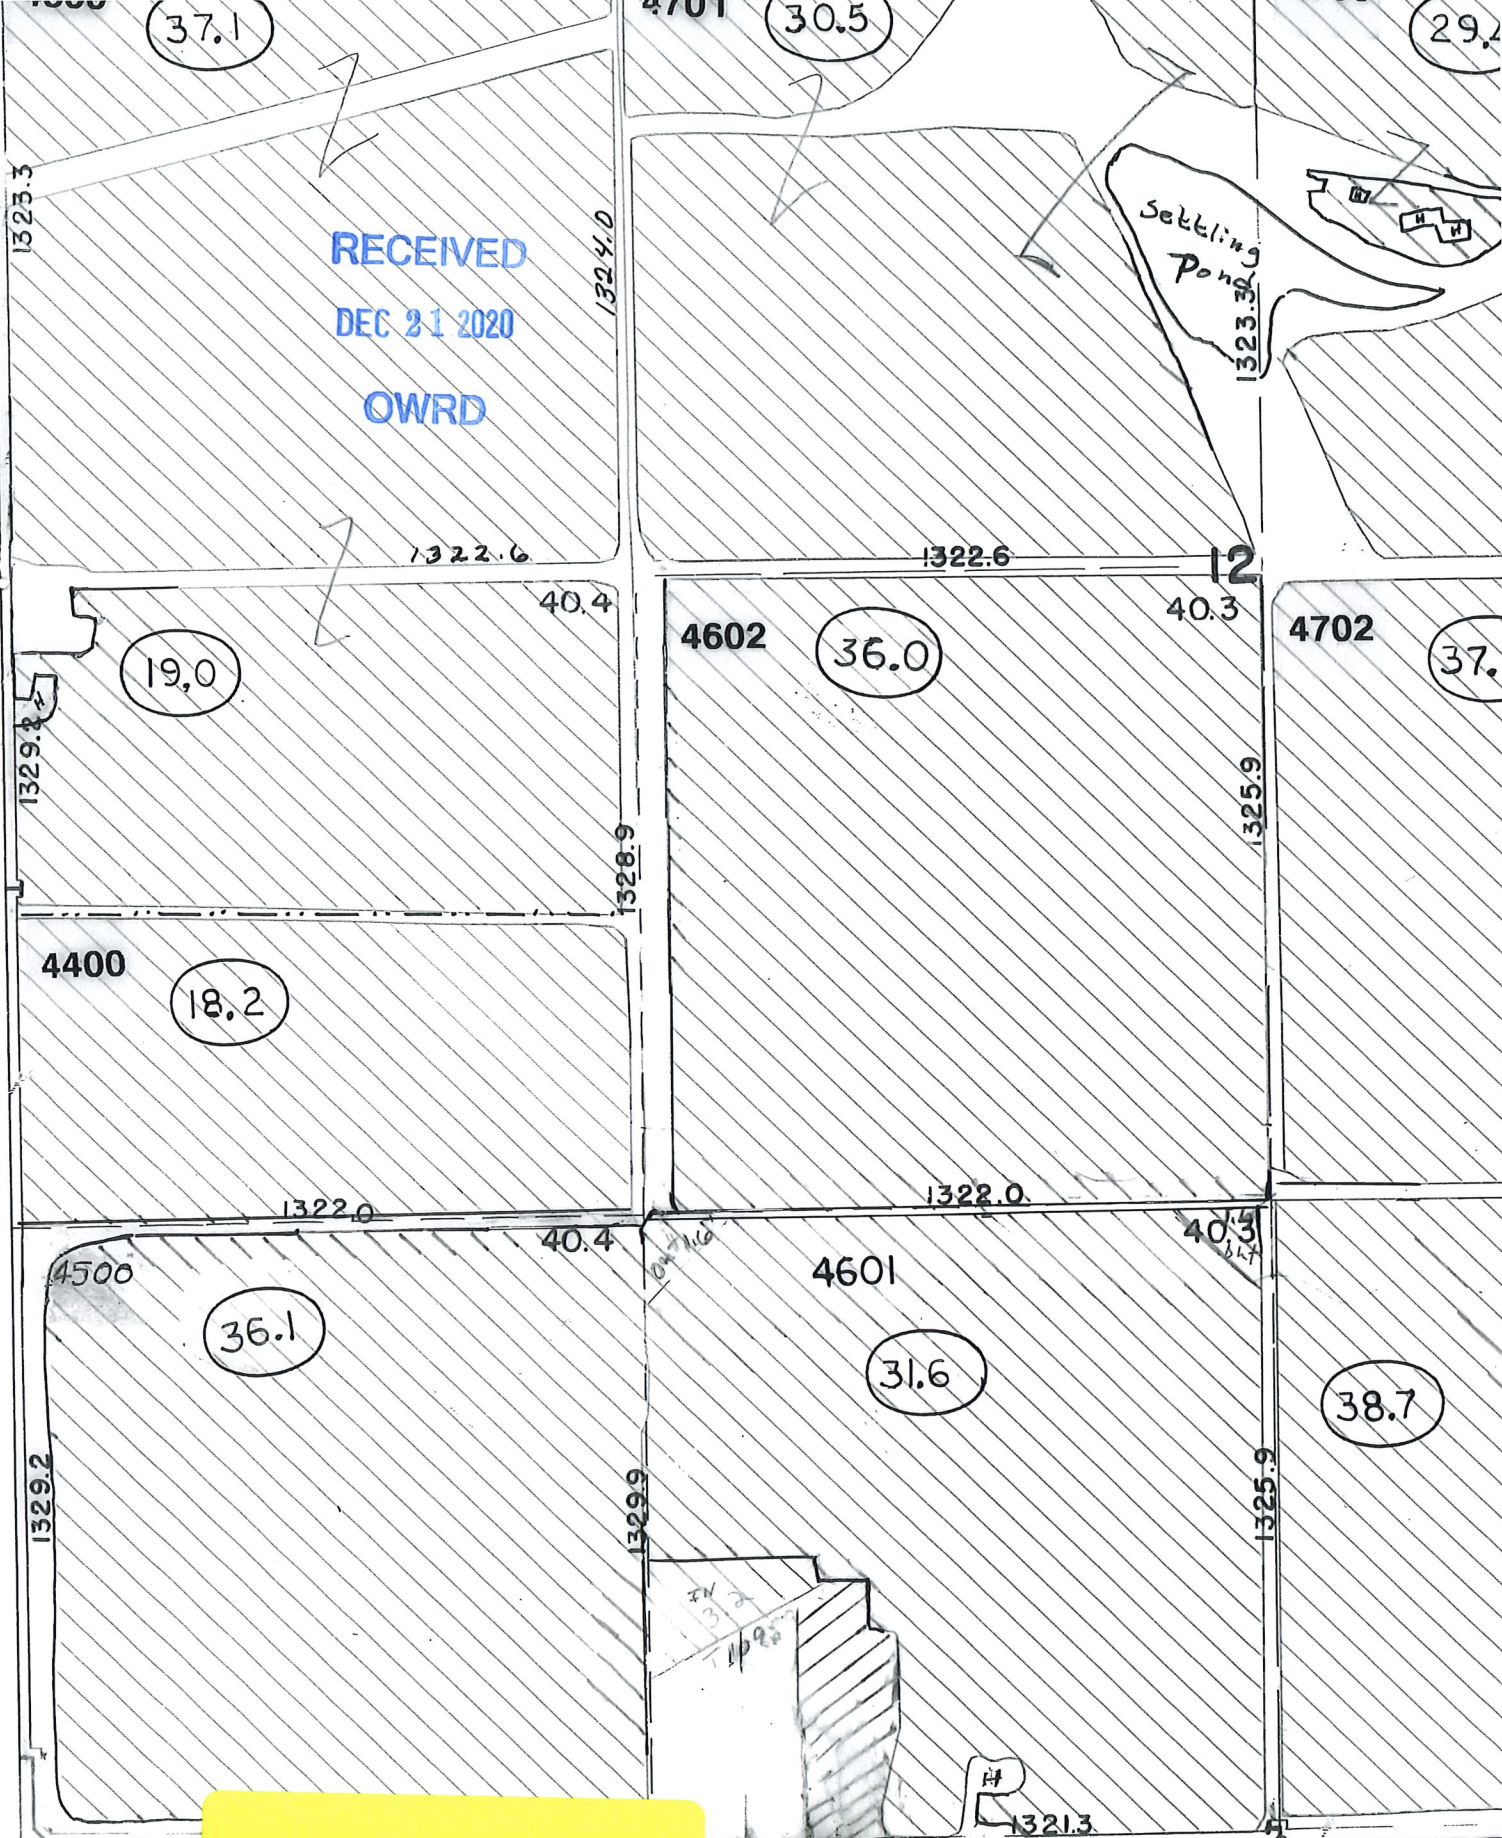

(37.1)

(30.5)

(29.2)

RECEIVED  
DEC 21 2020  
OWRD



(19.0)

4602 (36.0)

4702 (37.0)

4400 (18.2)

4500 (36.1)


4601 (31.6)

(38.7)

T-13099  
Final Order  
Tax Lot 2000 22S46E12 SESW  
ON 2.5 Acres

2.5 Ac. In.  
T-13099 (2019)

Scale 1" = 400'

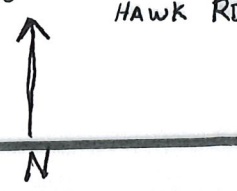

Traced: R.W.R. 4-17-53  
Checked: R.F. 6-20-55

Sec 12 T22S R46E