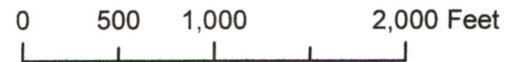
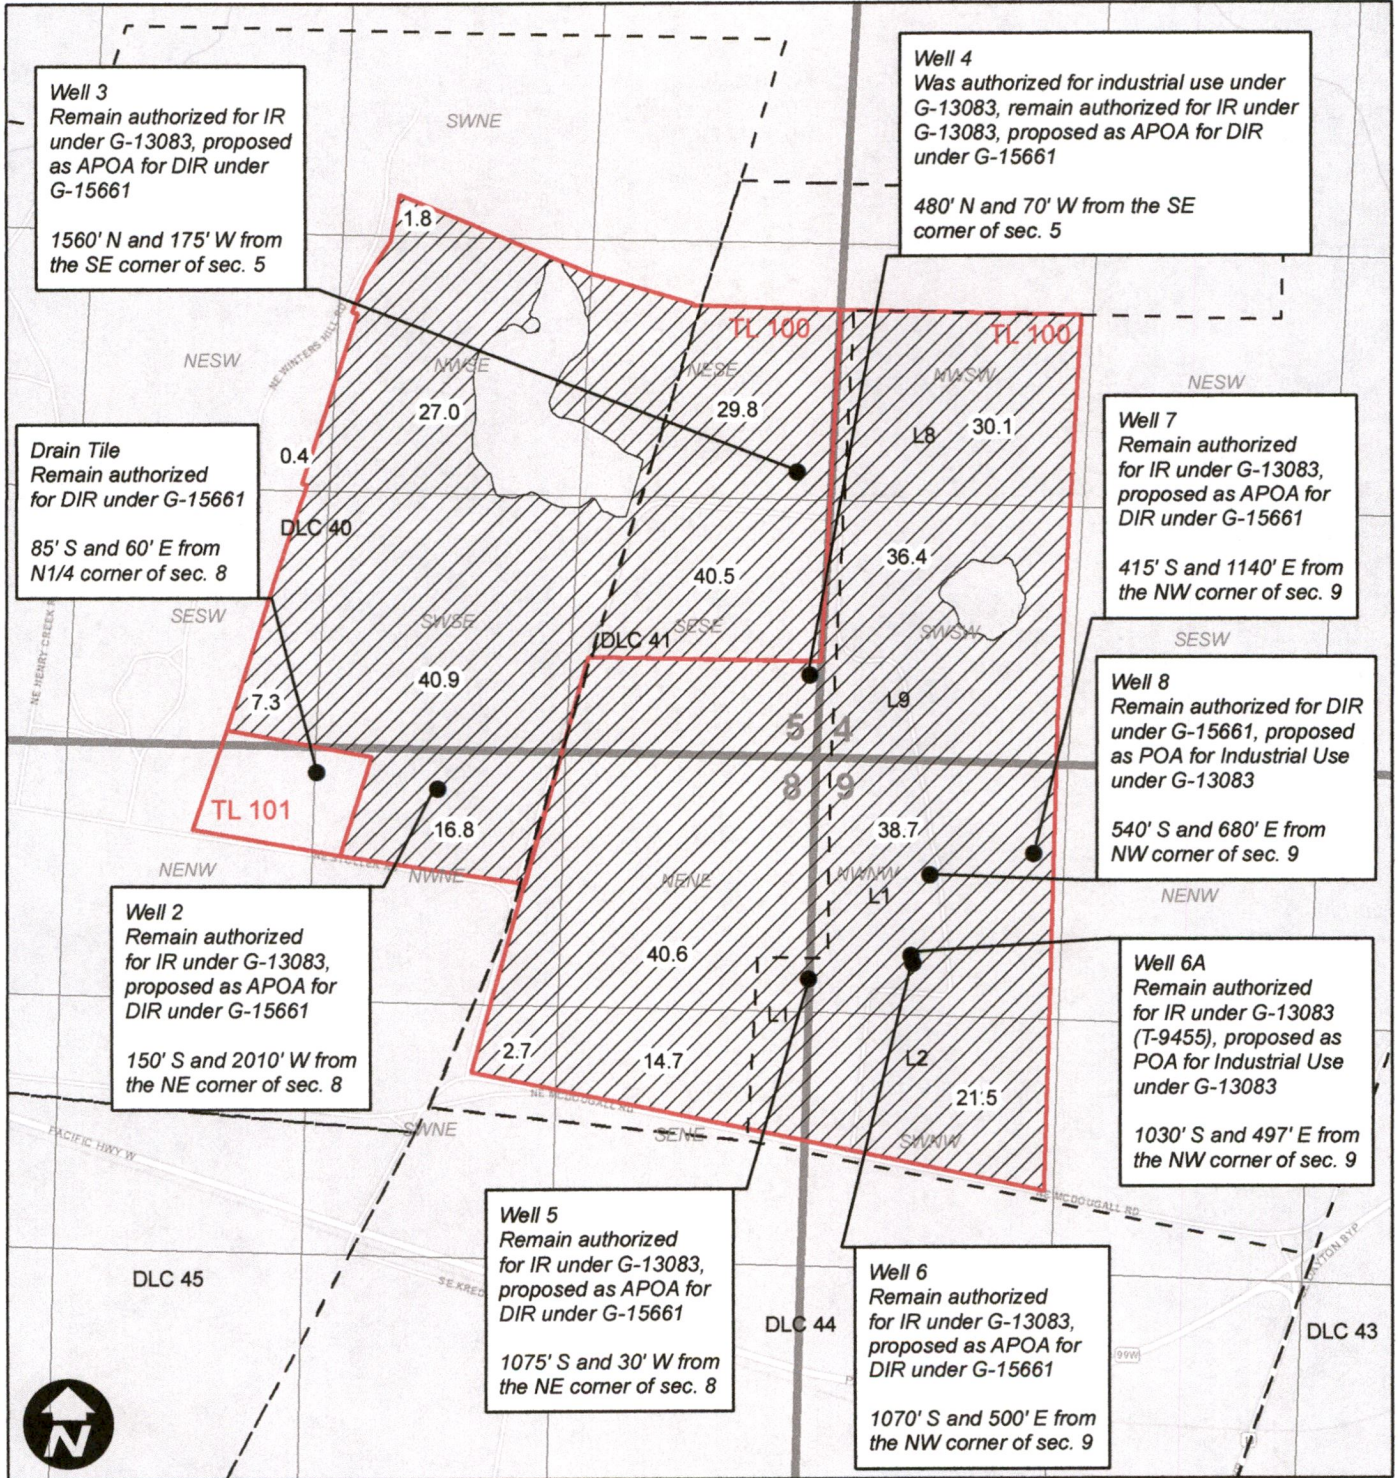


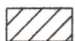
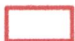

Permit Amendment William H. Stoller / Red Hills Farm LLC Permits G-13083 & G-15661

OWRD

Township 4S, Range 3W, W.M.



Legend

-  Place of Use G-13083 & G-15661
-  Tax Lot
-  DLC