


T.17S., R.13E., W.M.

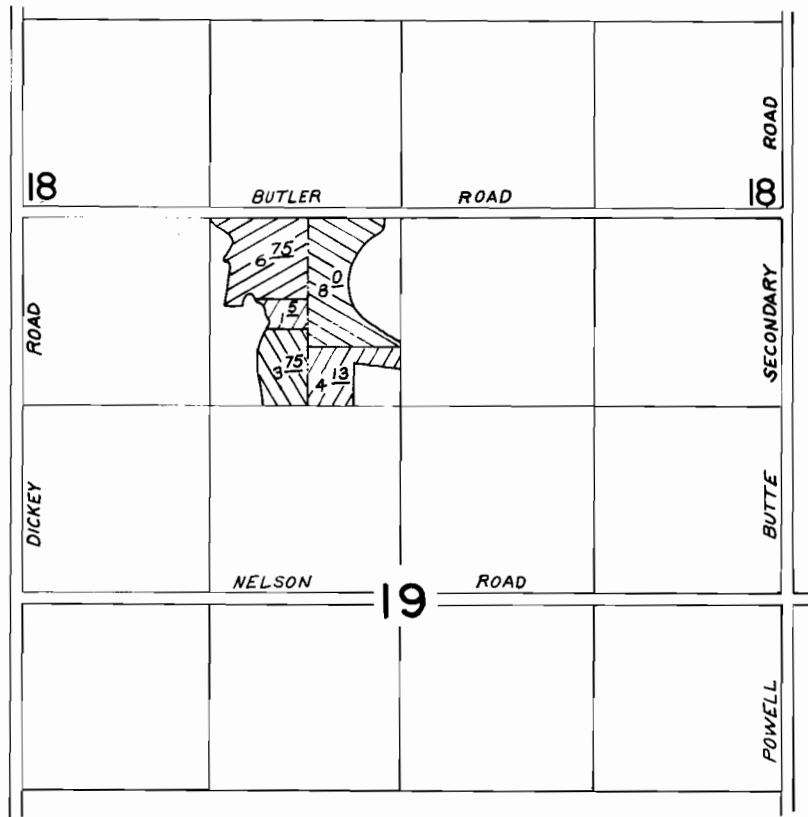

SCALE: 1" = 1320'

FINAL PROOF SURVEY
UNDER

TRANSFER NO. M-189, K-55, 2407, 2709

IN NAME OF

.....DONALD R. EDMUNDS /C.O.I.D.....

Surveyed MAR. 8... 19.85, by .LESLIE. OLSON..