



Ridgeview Irrigation District
 Temporary Transfer: From

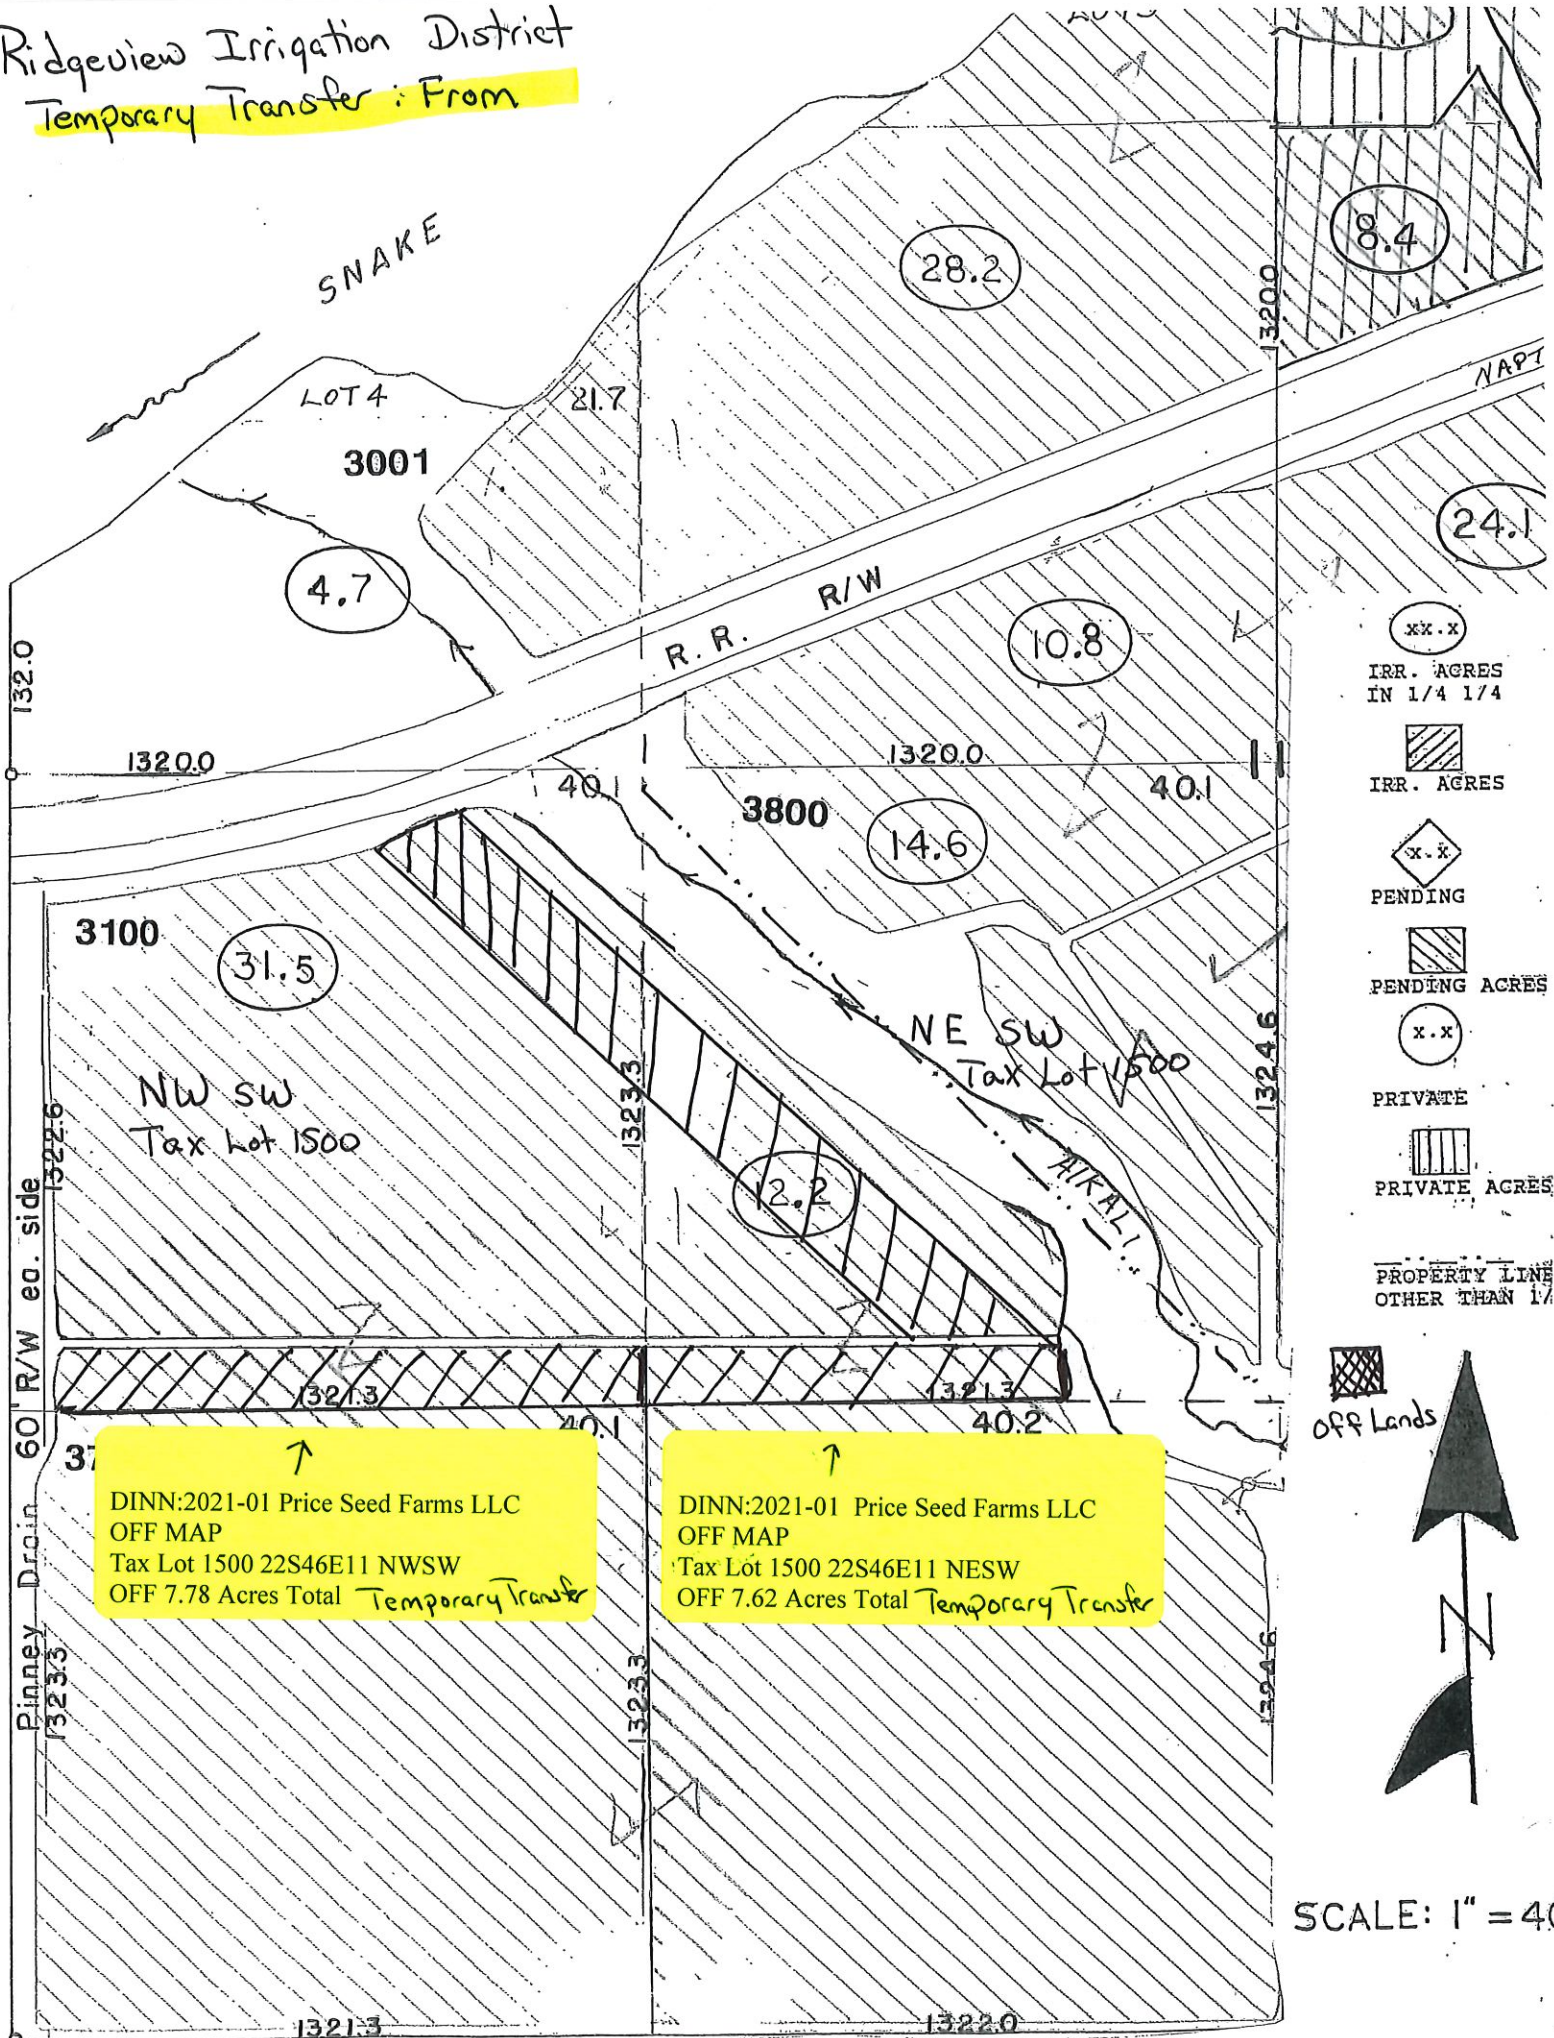

- (xx.x) IRR. ACRES IN 1/4 1/4
- [diagonal lines] IRR. ACRES
- (x.x) PENDING
- [diagonal lines] PENDING ACRES
- (x.x) PRIVATE
- [vertical lines] PRIVATE ACRES
- PROPERTY LINE OTHER THAN 1/4

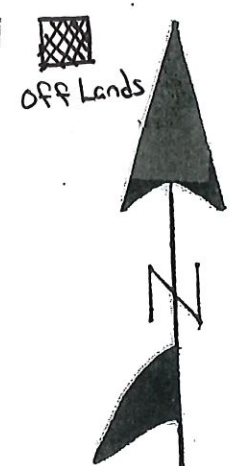

SCALE: 1" = 400'

↑
 DINN:2021-01 Price Seed Farms LLC
 OFF MAP
 Tax Lot 1500 22S46E11 NWSW
 OFF 7.78 Acres Total Temporary Transfer


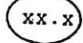





↑
 DINN:2021-01 Price Seed Farms LLC
 OFF MAP
 Tax Lot 1500 22S46E11 NESW
 OFF 7.62 Acres Total Temporary Transfer

Ridgeview Irrigation District

Temporary Transfer: To

PRIVATE #27489

DINN:2021-01 Price Seed Farms LLC
ON MAP
Govt. Lot 8, Tax Lot 1300
22S46E03 NESW
ON 5.4 Acres Total

-  Temporary Trans. Ac.
-  IRR. ACRES IN 1/4 1/4
-  IRR. ACRES
-  PENDING
-  PENDING ACRES
-  PRIVATE
-  PRIVATE ACRES

PROPERTY LINE IF OTHER THAN 1/4 1/4

RIVER




SCALE: 1" = 400

DINN:2021-01 Price Seed Farms LLC
ON MAP
Govt. Lot 9, Tax Lot 1500
22S46E03 SESW
ON 2.9 Acres Total


Southwest CORNER of SEC. 3, T.22 S., R.46 E., W.M.

48-102-1556

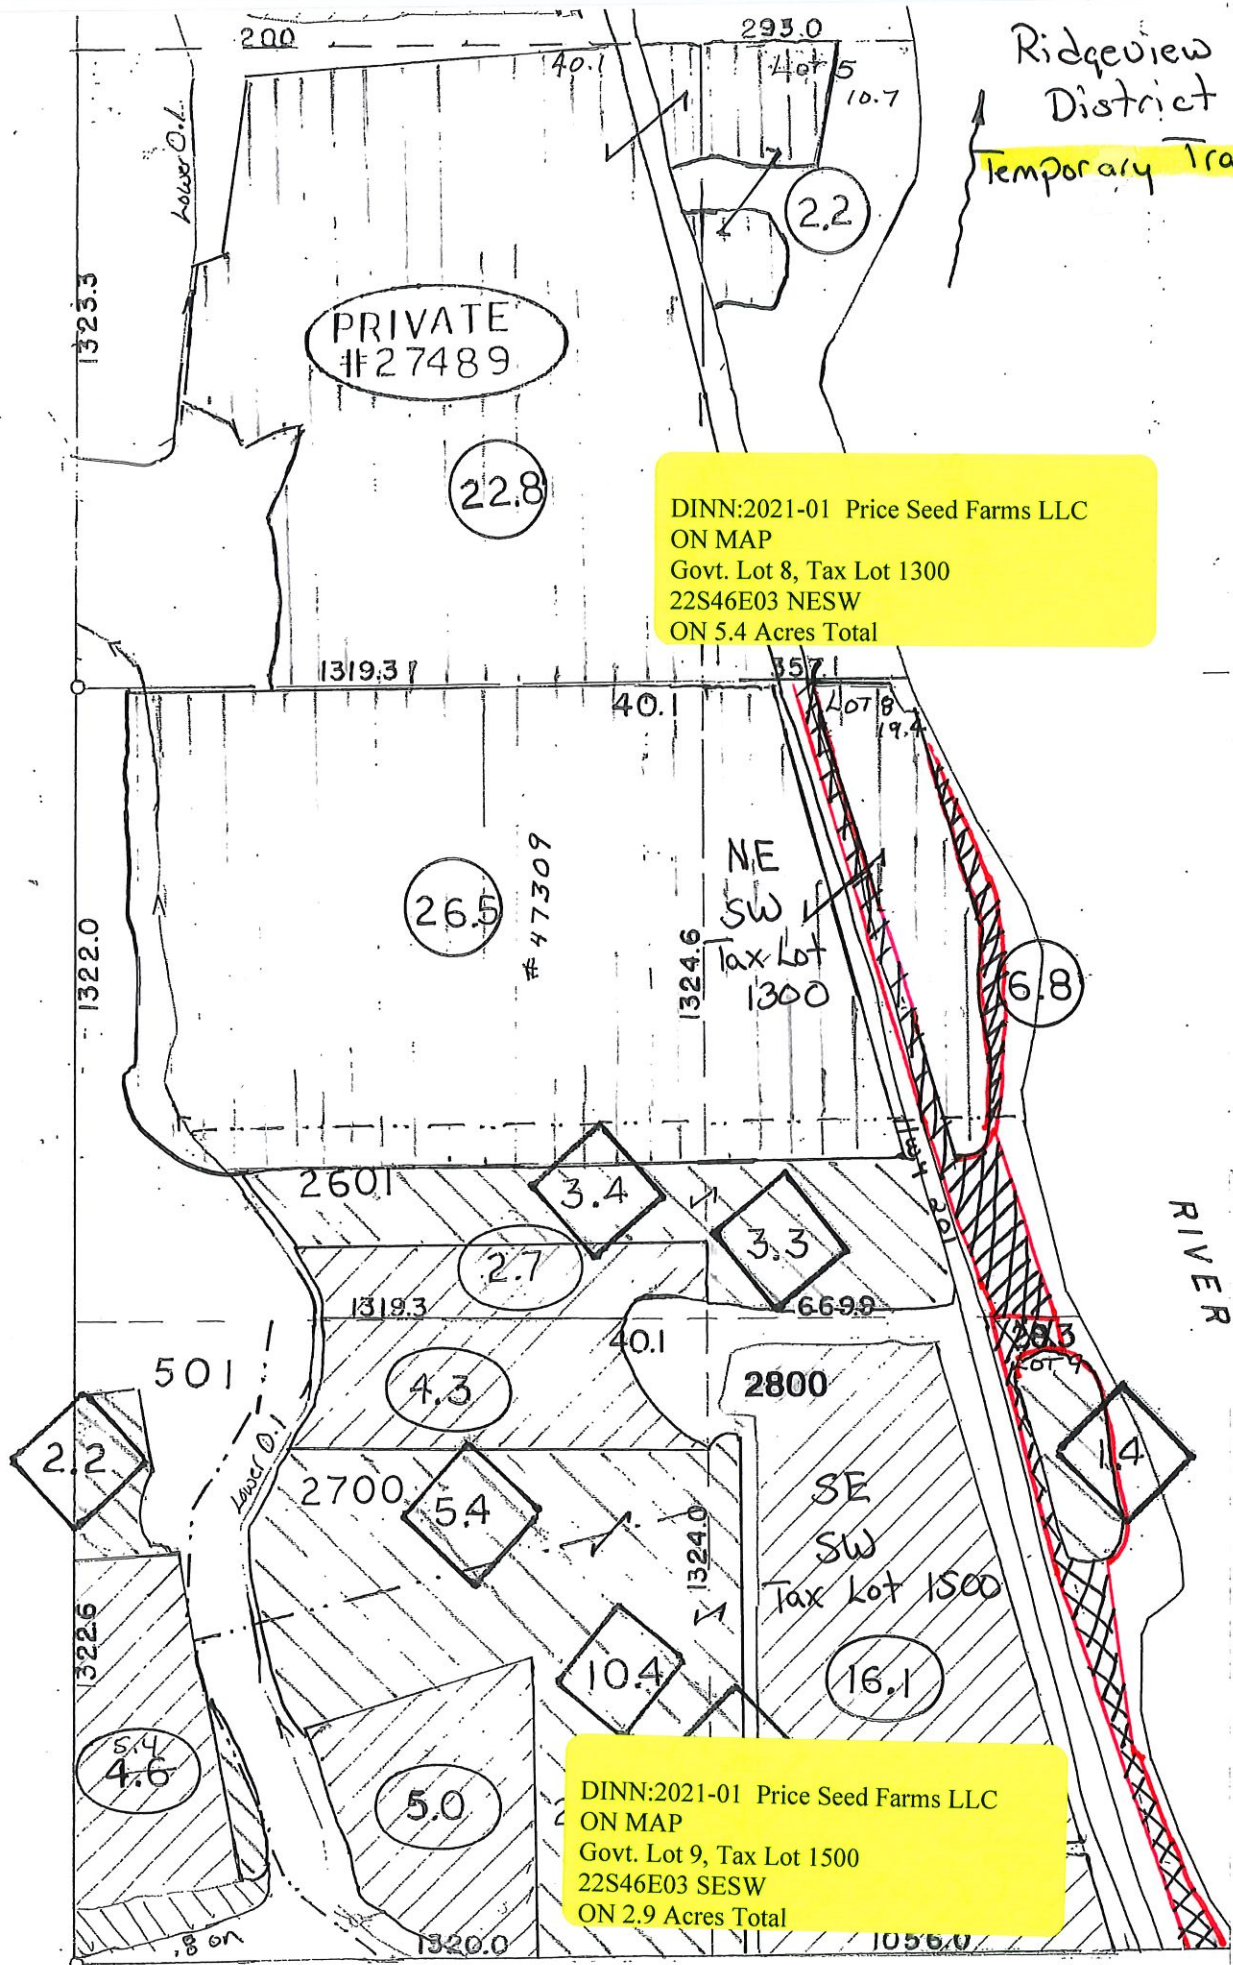

Northwest Corner of Sec 10
 RIDGEVIEW IRRIGATION DISTRICT Temporary Transfer To

DINN:2021-01 Price Seed Farms LLC
 ON MAP
 Govt. Lot 3, Tax Lot 100
 22S46E10 NENW
 ON 1.8 Acres Total

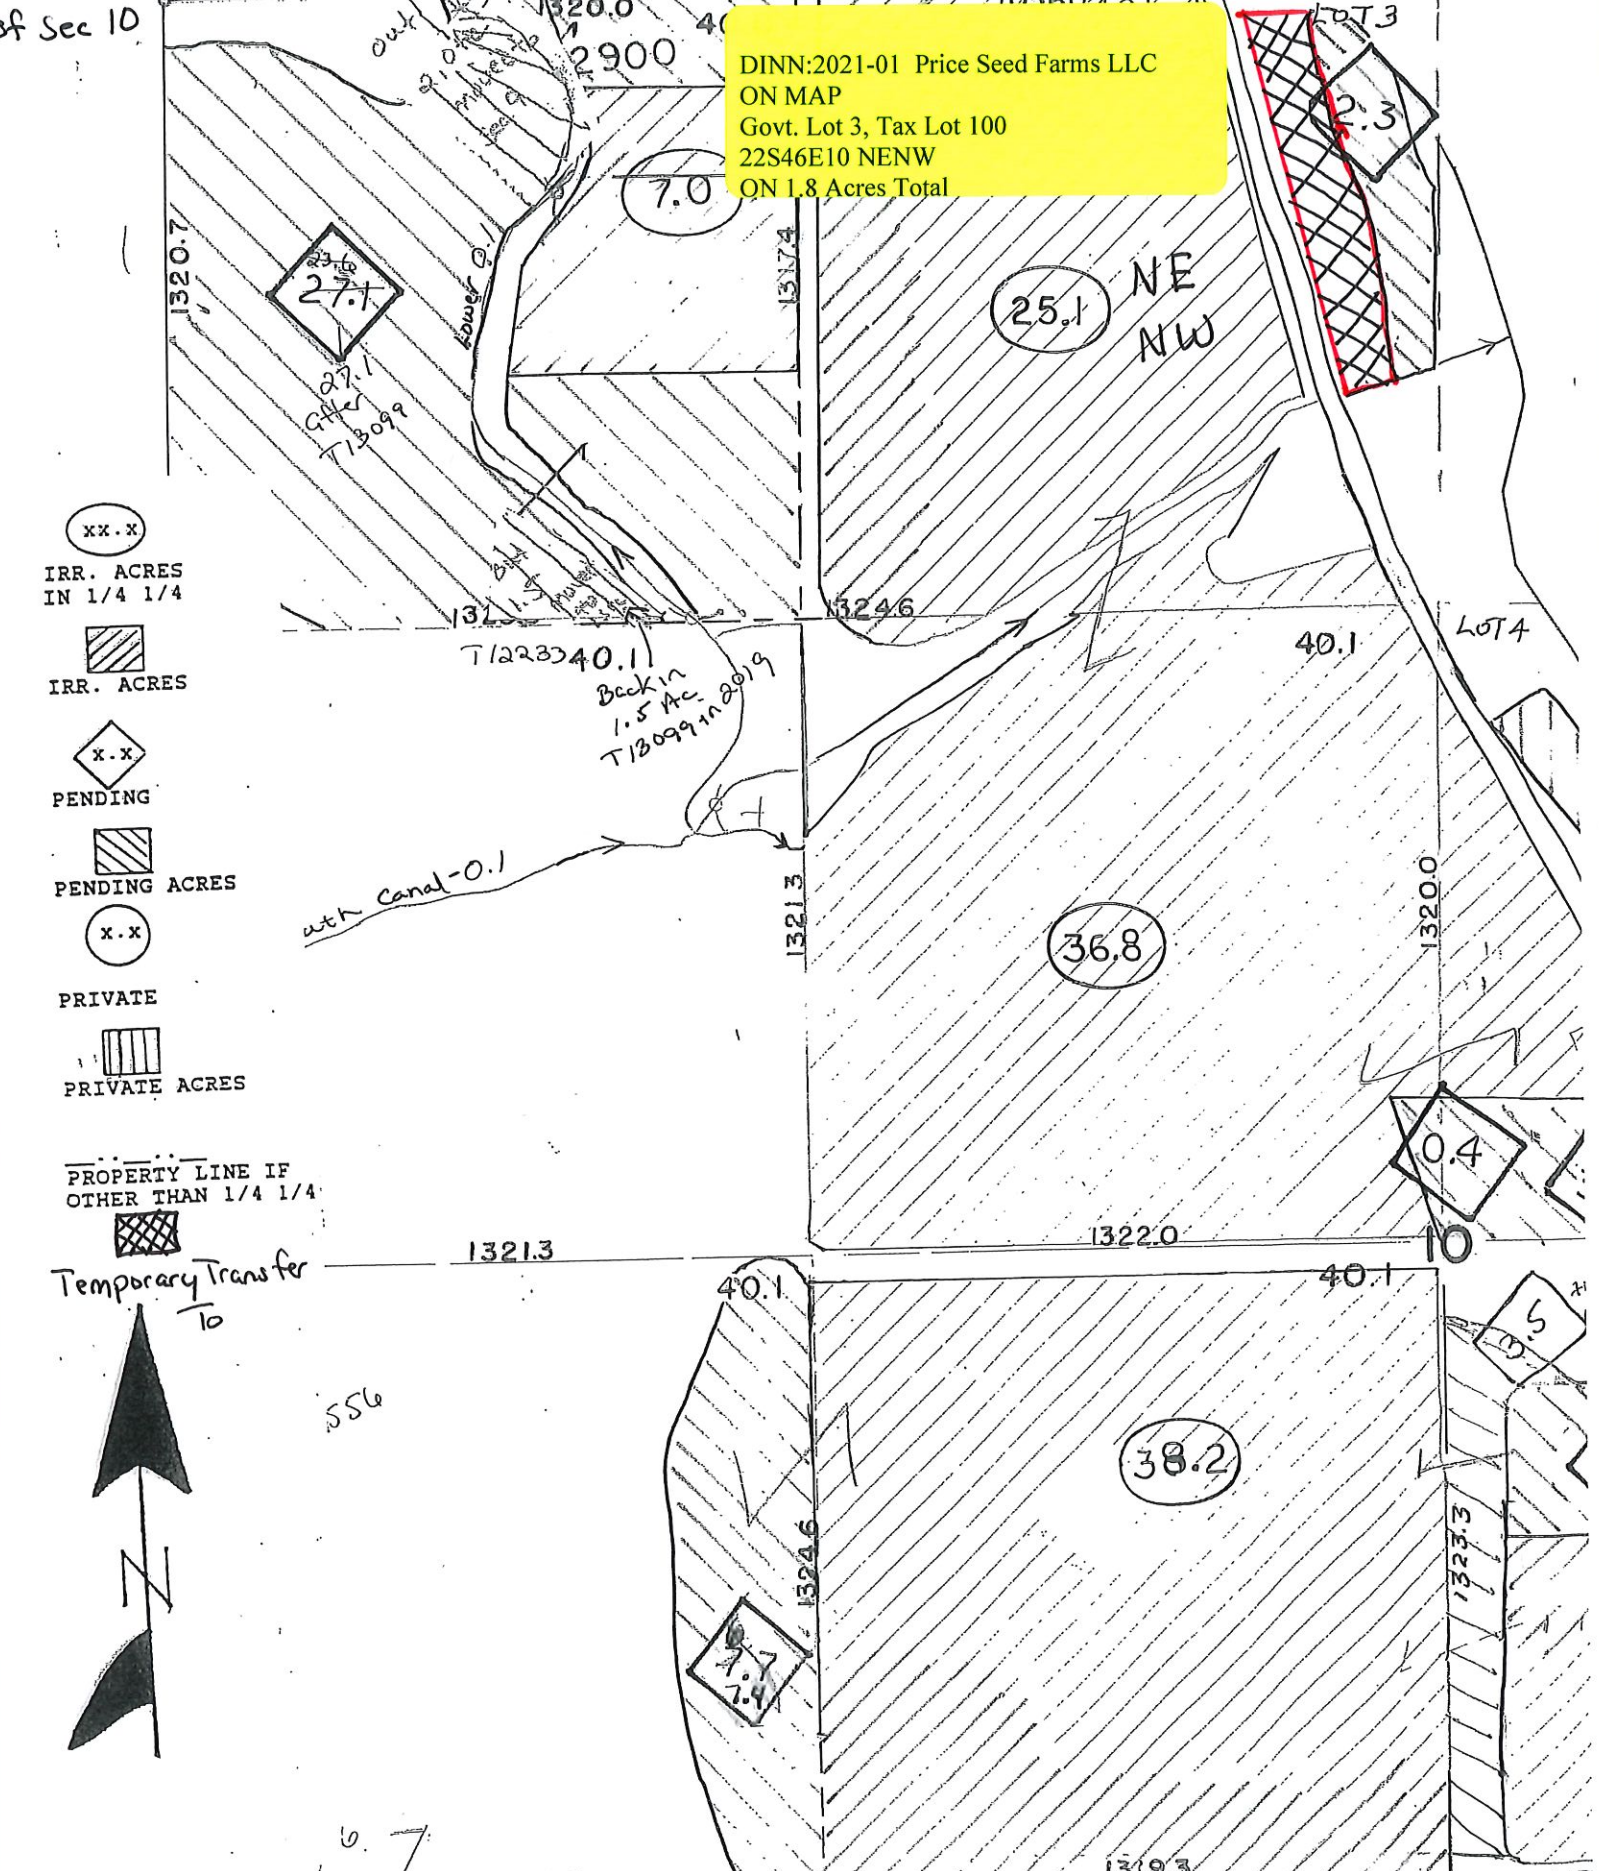

- (xx.x) IRR. ACRES IN 1/4 1/4
- [Hatched Box] IRR. ACRES
- (x.x) PENDING
- [Hatched Box] PENDING ACRES
- (x.x) PRIVATE
- [Hatched Box] PRIVATE ACRES

PROPERTY LINE IF OTHER THAN 1/4 1/4

Temporary Transfer









SCALE: 1" = 400'

Ridgeview Irrigation District
 Temporary Transfer: To

DINN:2021-01 Price Seed Farms LLC
 ON MAP
 Govt. Lot 4, Tax Lot 1600
 22S46E10 SWNE
 ON 2.8 Acres Total

DINN:2021-01 Price Seed Farms LLC
 ON MAP
 Tax Lot 1600 22S46E10 SE NE
 ON 0.3 Acres Total

DINN:2021-01 Price Seed Farms LLC
 ON MAP
 Govt. Lot 5, Tax Lot 1600
 22S46E10 NE SE
 ON 2.2 Acres Total

- xx.x
IRR. ACRES
IN 1/4 1/4
- 
IRR. ACRES
- 
PENDING
- 
PENDING ACRES
- 
PRIVATE
- 
PRIVATE ACRES
- PROPERTY LINE
OTHER THAN 1/4
- 
Temp. Transfer



SCALE: 1" = 40'

South East corner
 of Sec 10
 48-102-1558

SEC. 10, T.22 S., R.46 E., W.M.

