


# Groundwater Registration Modification Application GR 2289 - Case Family LLC

Township 10S, Range 3W, W.M.

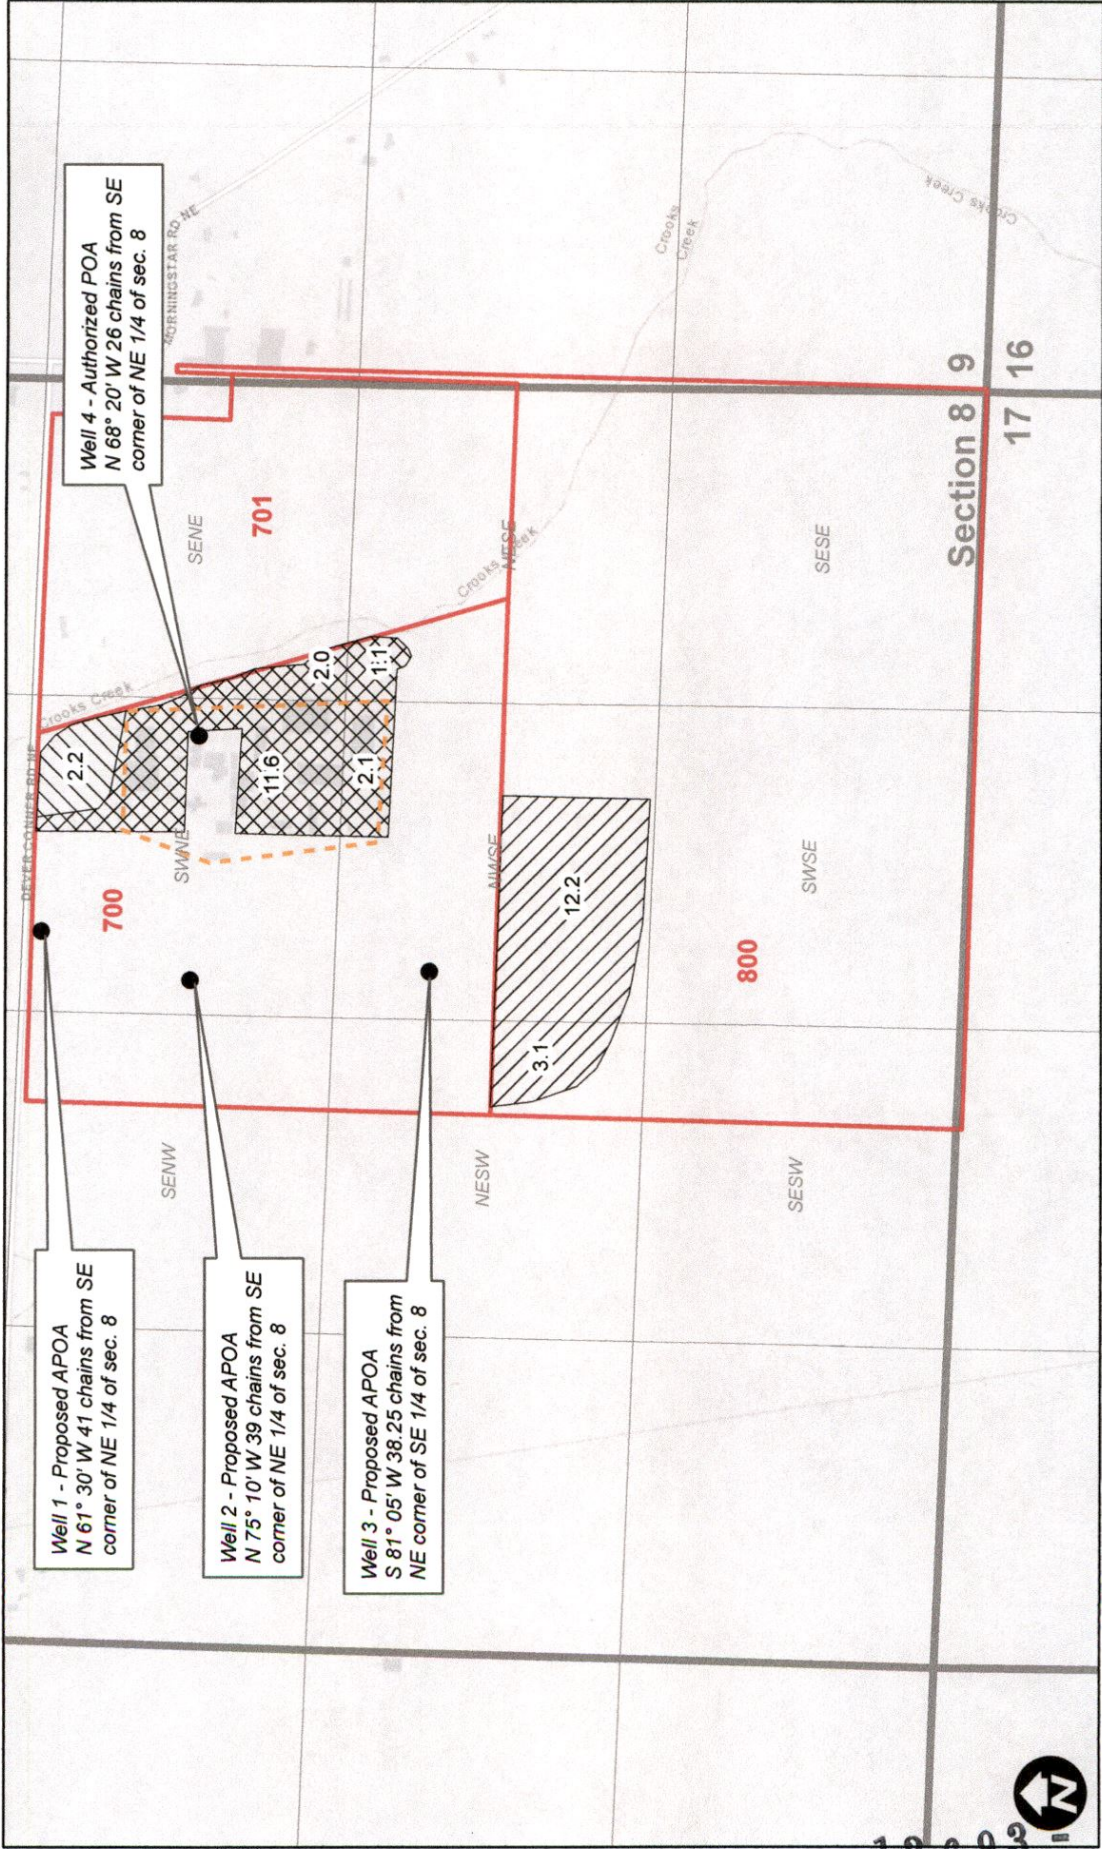

## Legend

- GR 2289 - From
- GR 2289 - No Change
- GR 2289 - To - Agricultural/Industrial
- Tax Lot
- GR 2289 - To - Irrigation

RECEIVED

APR 28 2021

OWRD