


RECEIVED

MAY 10 2021

Transfer Application Fery - Certificate 45075

OWRD

Township 9S, Range 1W, W.M.

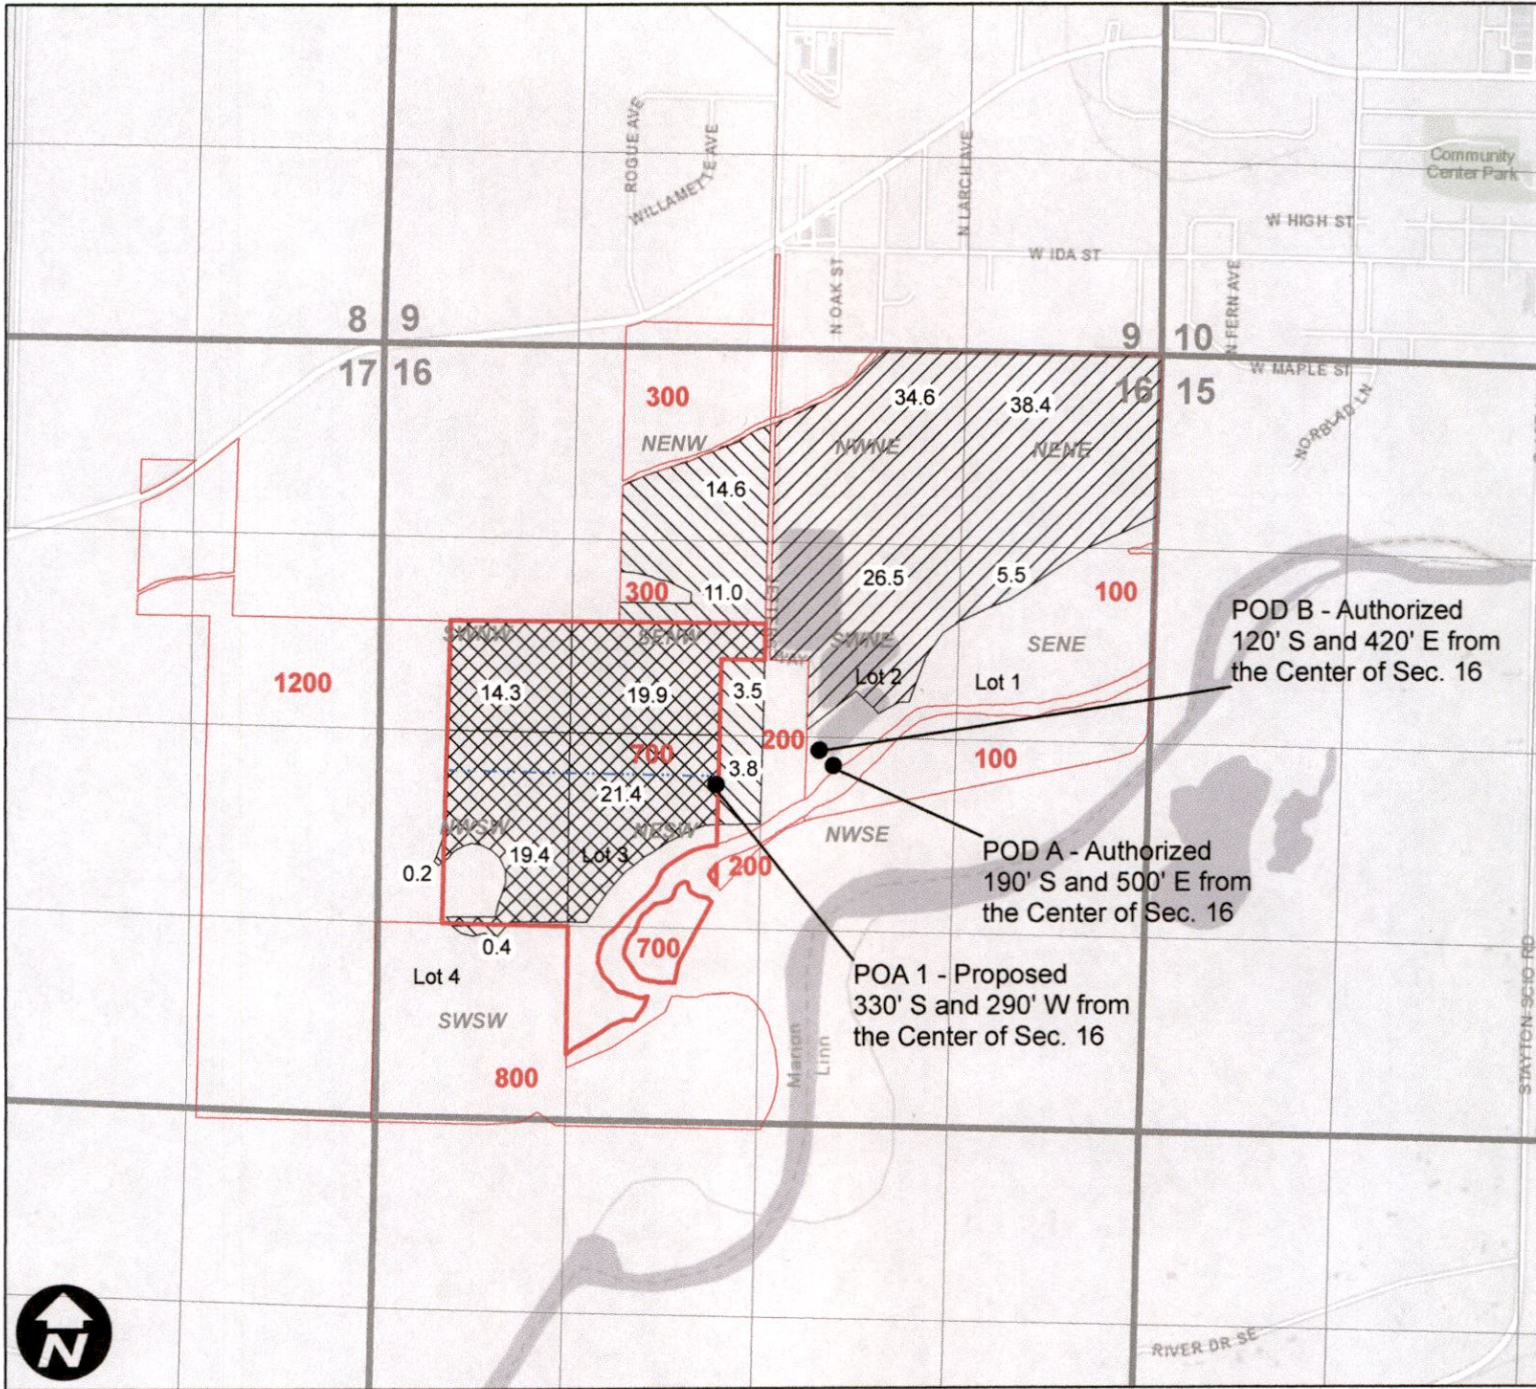

Legend

- Cert. 45075 - SW to GW
- Cert. 45075 (N Santiam R., Unnamed Res. & Detroit Res.) - No Change
- Cert. 45075 (Unnamed Res. & Detroit Res.) - No Change
- Mainline
- Taxlot

0 660 1,320 2,640 Feet

13704 -



EXPIRES: 12/31/2022