


Well Log: YAMH 5649

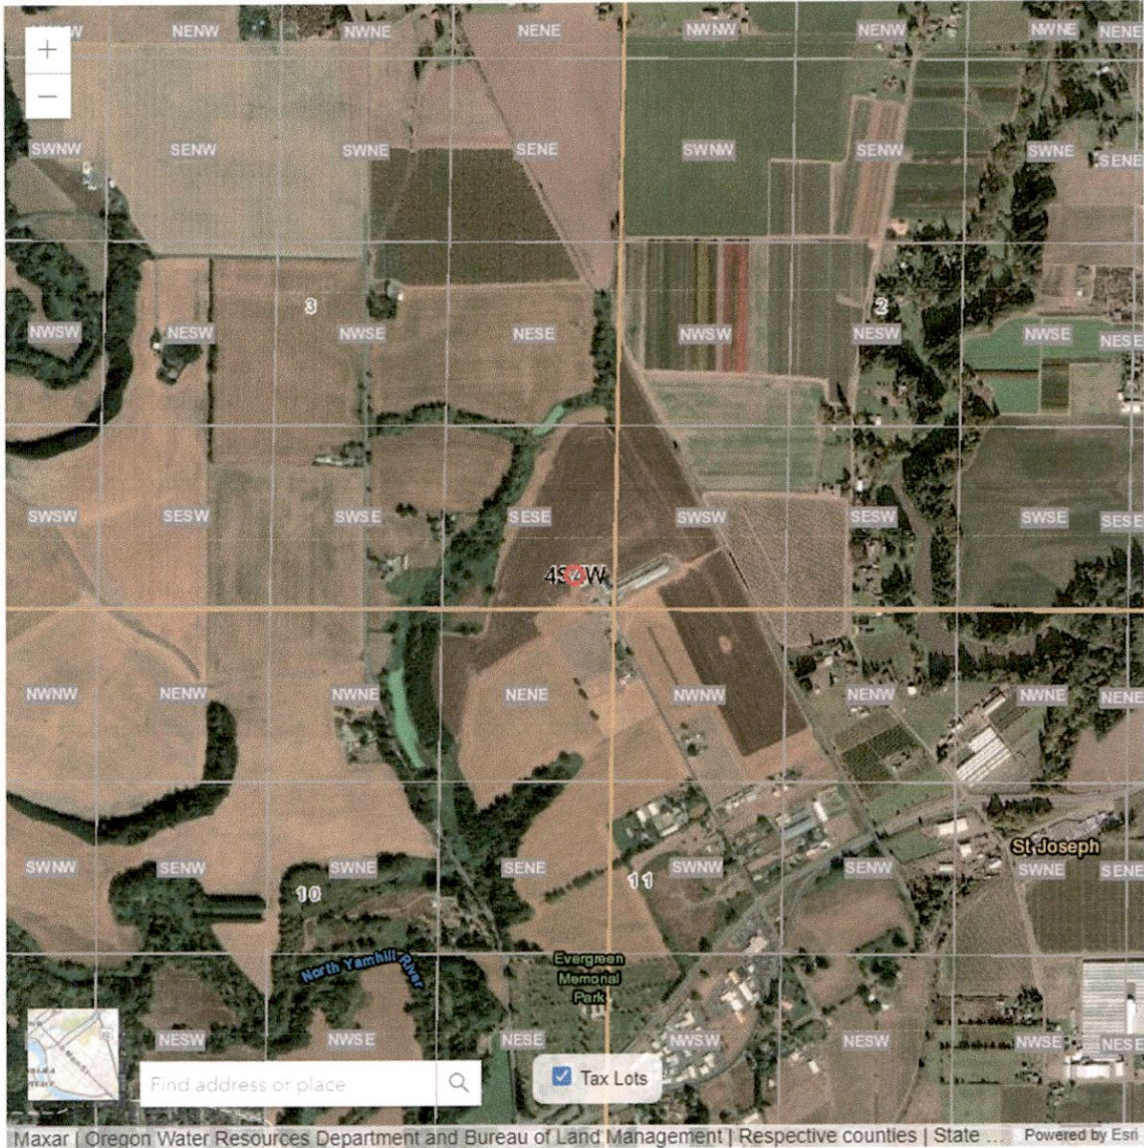

RECEIVED


MAY 12 2021

OWRD

13712 -

Groundwater Registration Modification GR 1424 - Aebi

OWRD
Township 4S, Range 4W, W.M.

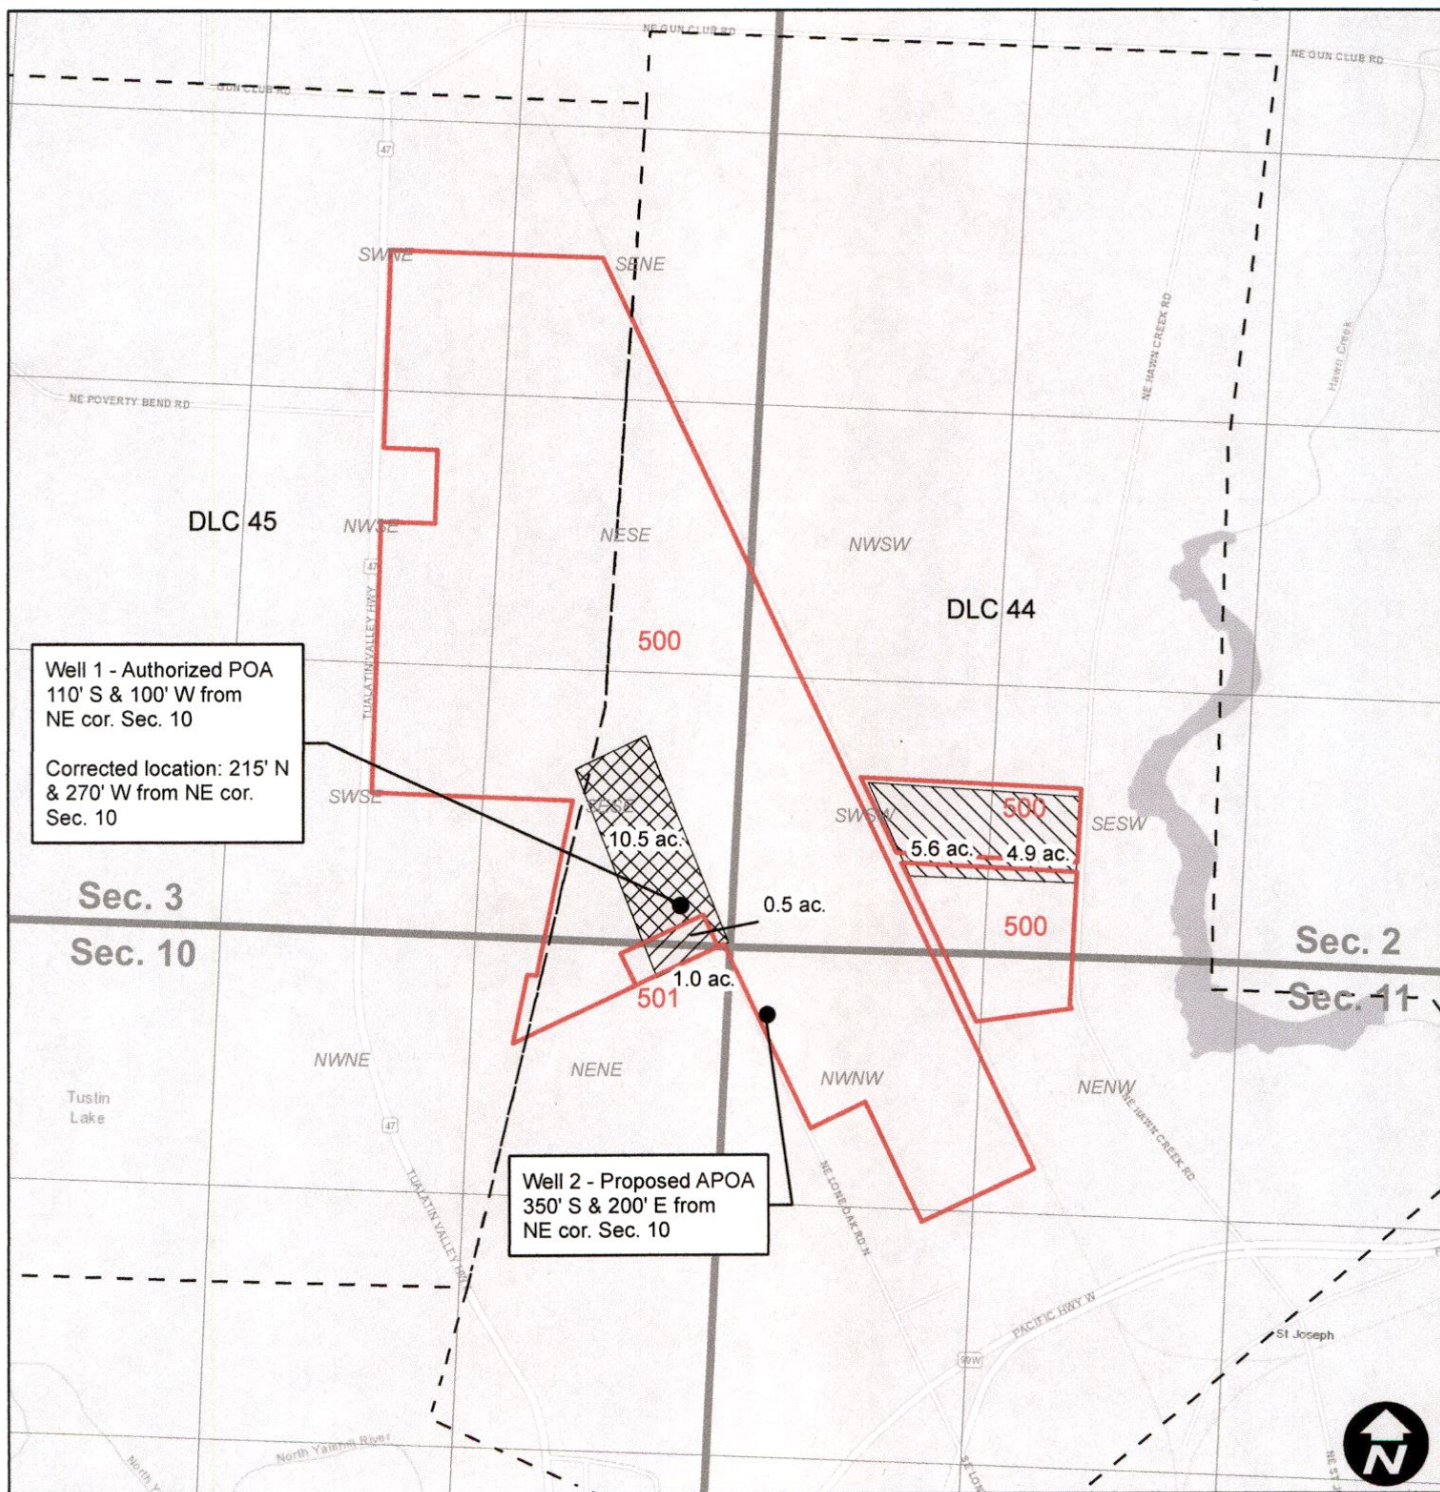

Well 1 - Authorized POA
110' S & 100' W from
NE cor. Sec. 10

Corrected location: 215' N
& 270' W from NE cor.
Sec. 10

Well 2 - Proposed APOA
350' S & 200' E from
NE cor. Sec. 10

Legend

-  GR 1424 From
-  GR 1424 No Change
-  DLC
-  GR 1424 To
-  Taxlot

13712 -