



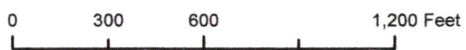


Historic Transfer - POD

Whitehead - Certificate 21991

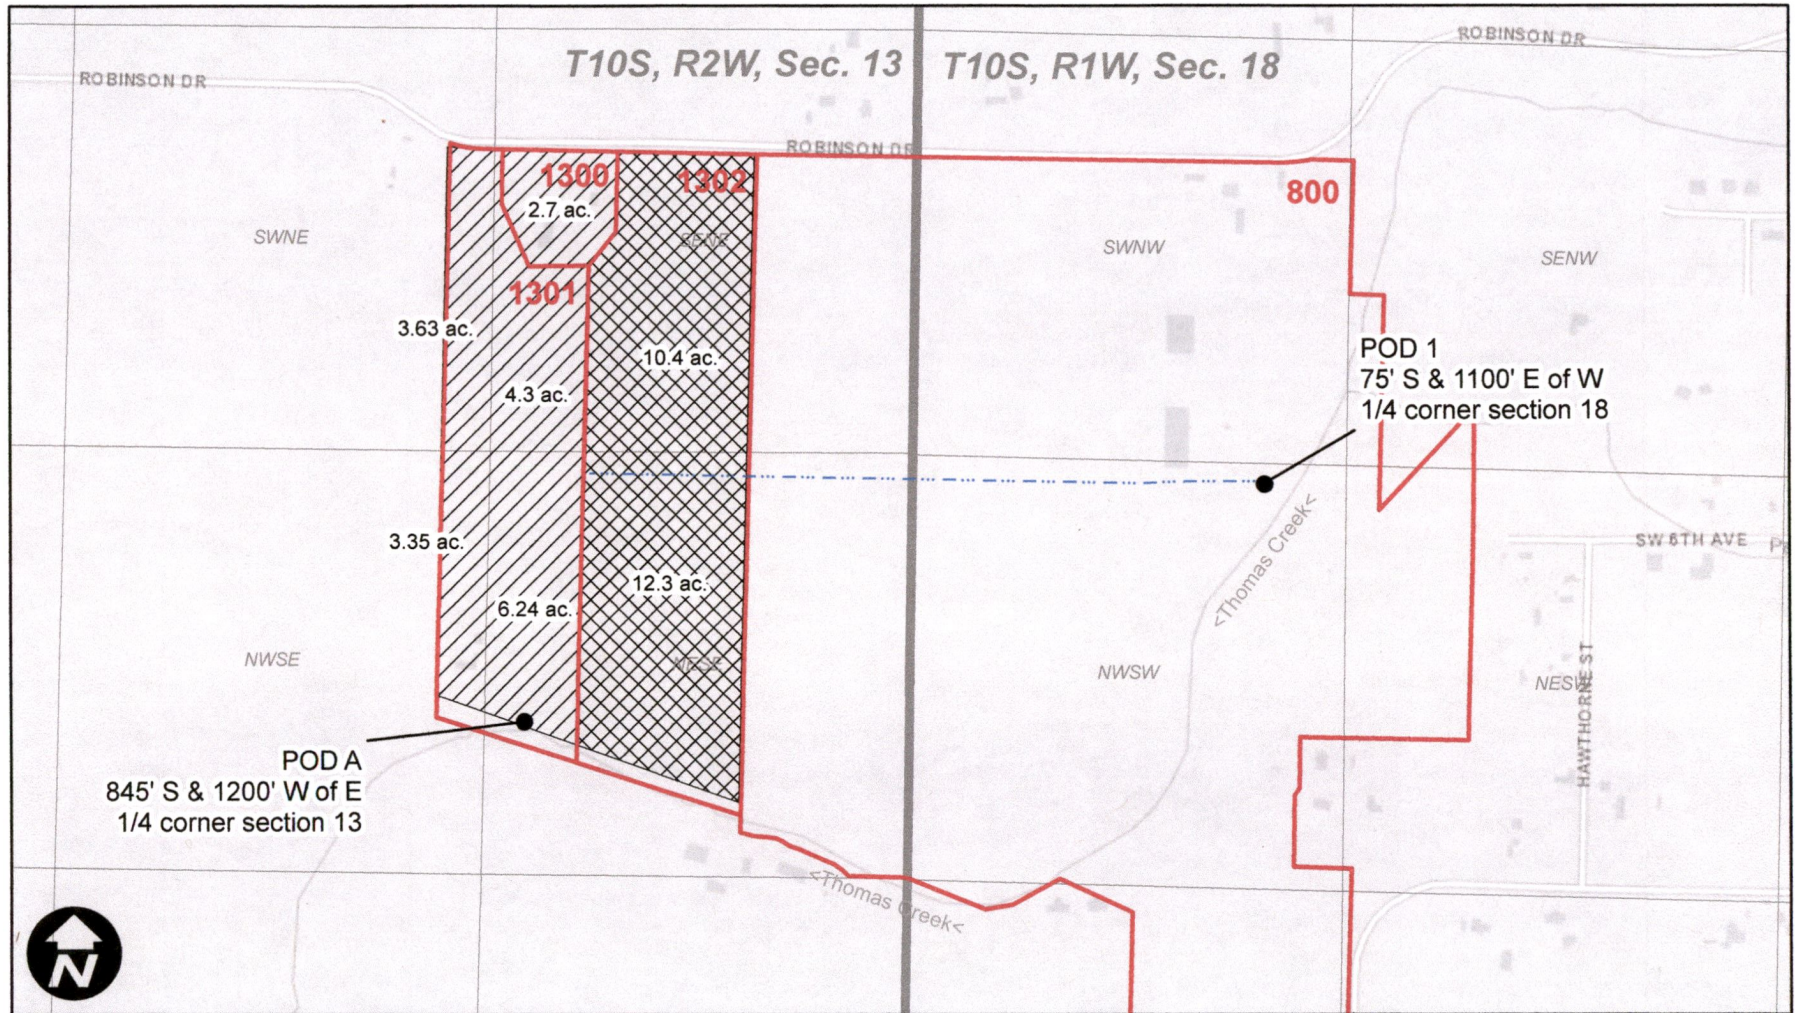

Legend

-  Cert. 21991 No Change
-  Cert. 21991 Transfer
-  Mainline
-  Tax Lots

RECEIVED

JUN 01 2021

OWRD



Imagery Date: 8/12/2020

44°41'59.60" N 122°52'25.98" W elev 297 ft eye alt 4697 ft

Google Earth

RECEIVED

JUN 01 2021

OWRD

13726



Imagery Date: 7/8/2010

44°42'10.72" N 122°52'21.08" W elev 300 ft eye alt 5332 ft

RECEIVED

JUN 01 2021

OWRD13726



Imagery Date: 6/16/2006

44°42'11.87" N 122°52'30.93" W elev 297 ft eye alt 5332 ft

RECEIVED

JUN 01 2021

OWPD 13726



RECEIVED
JUN 01 2021
OWRD

Imagery Date: 8/12/2020

44°42'01.84" N 122°51'44.79" W elev 304 ft eye alt 704 ft

13726



HISTORIC
POD 1

Google Earth

Imagery Date: 7/8/2010 44°42'01.88" N 122°51'43.76" W elev 300 ft eye alt 704 ft

RECEIVED

JUN 01 2021

OWRD

13726



HISTORIC
POD 1

Google Earth


Imagery Date: 6/28/2005 44°42'01.70" N 122°51'45.17" W elev 305 ft eye alt 704 ft

RECEIVED

JUN 01 2021

OWRD

13726

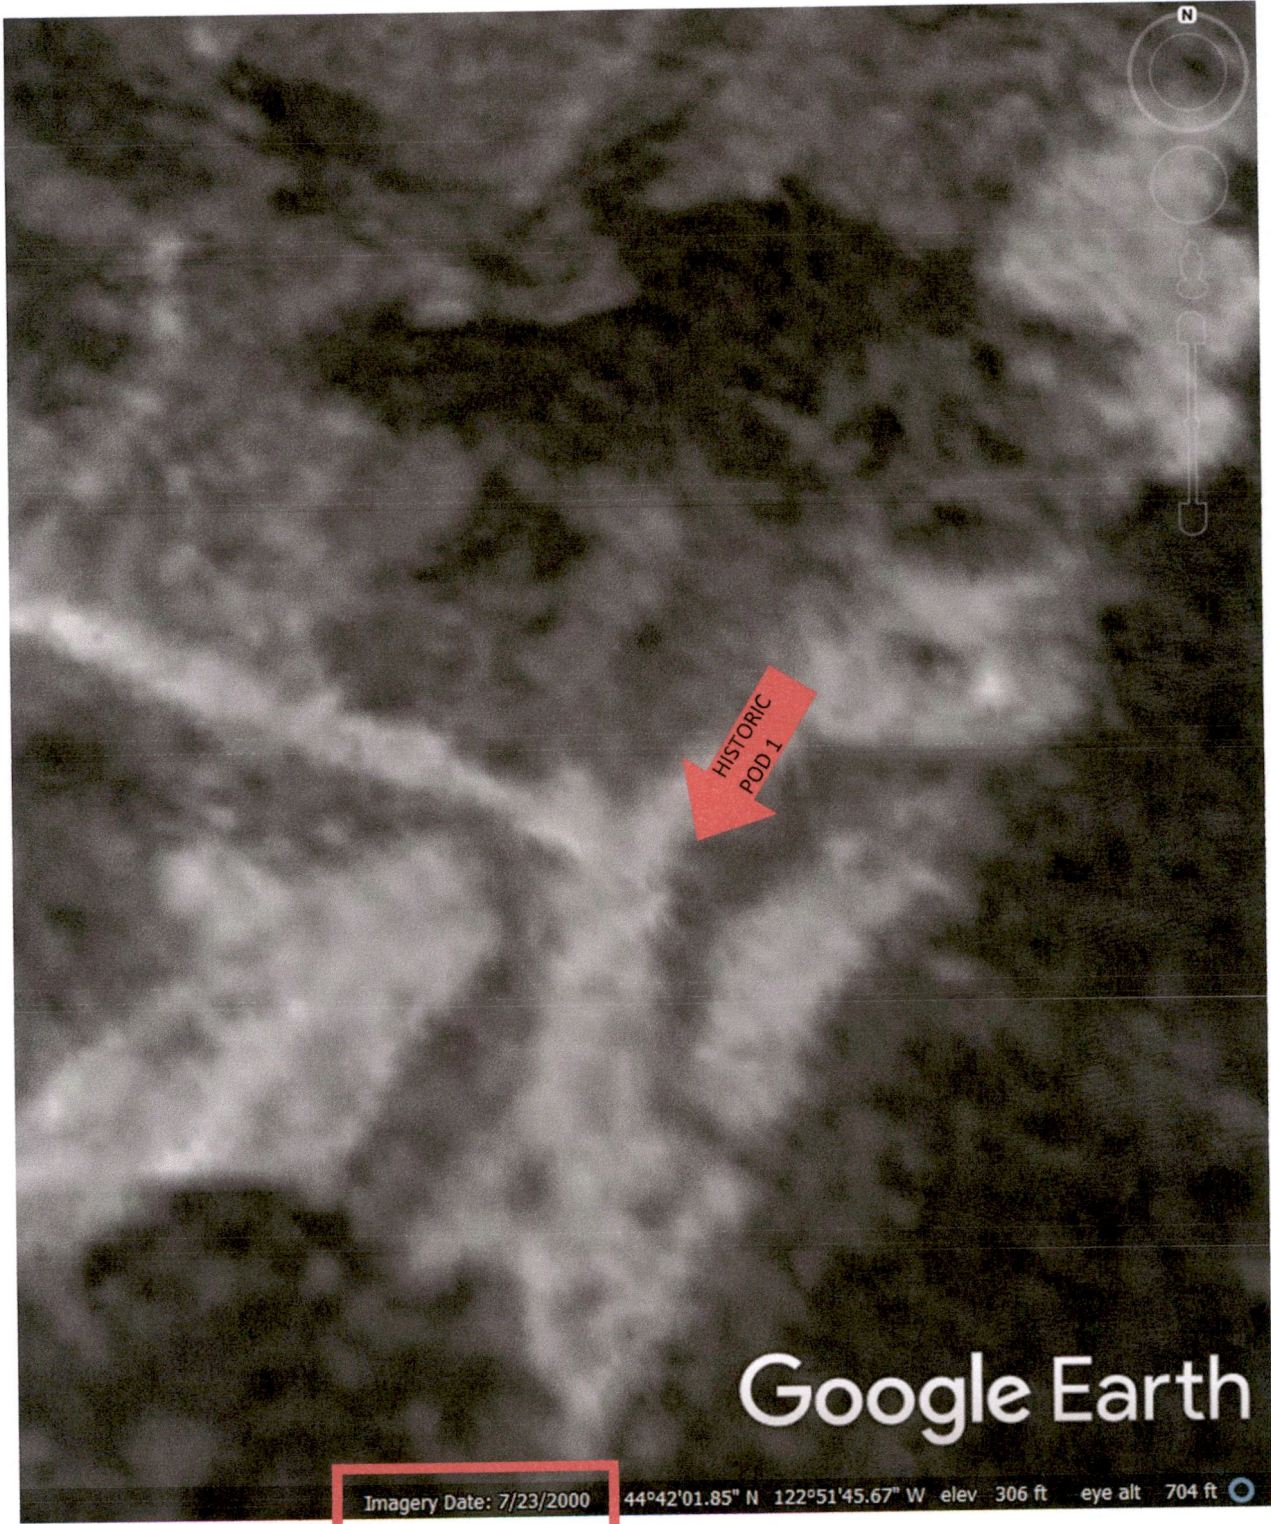

RECEIVED

JUN 01 2021

OWRD

13726