

RECEIVED


JUN 04 2021

OWRD






 


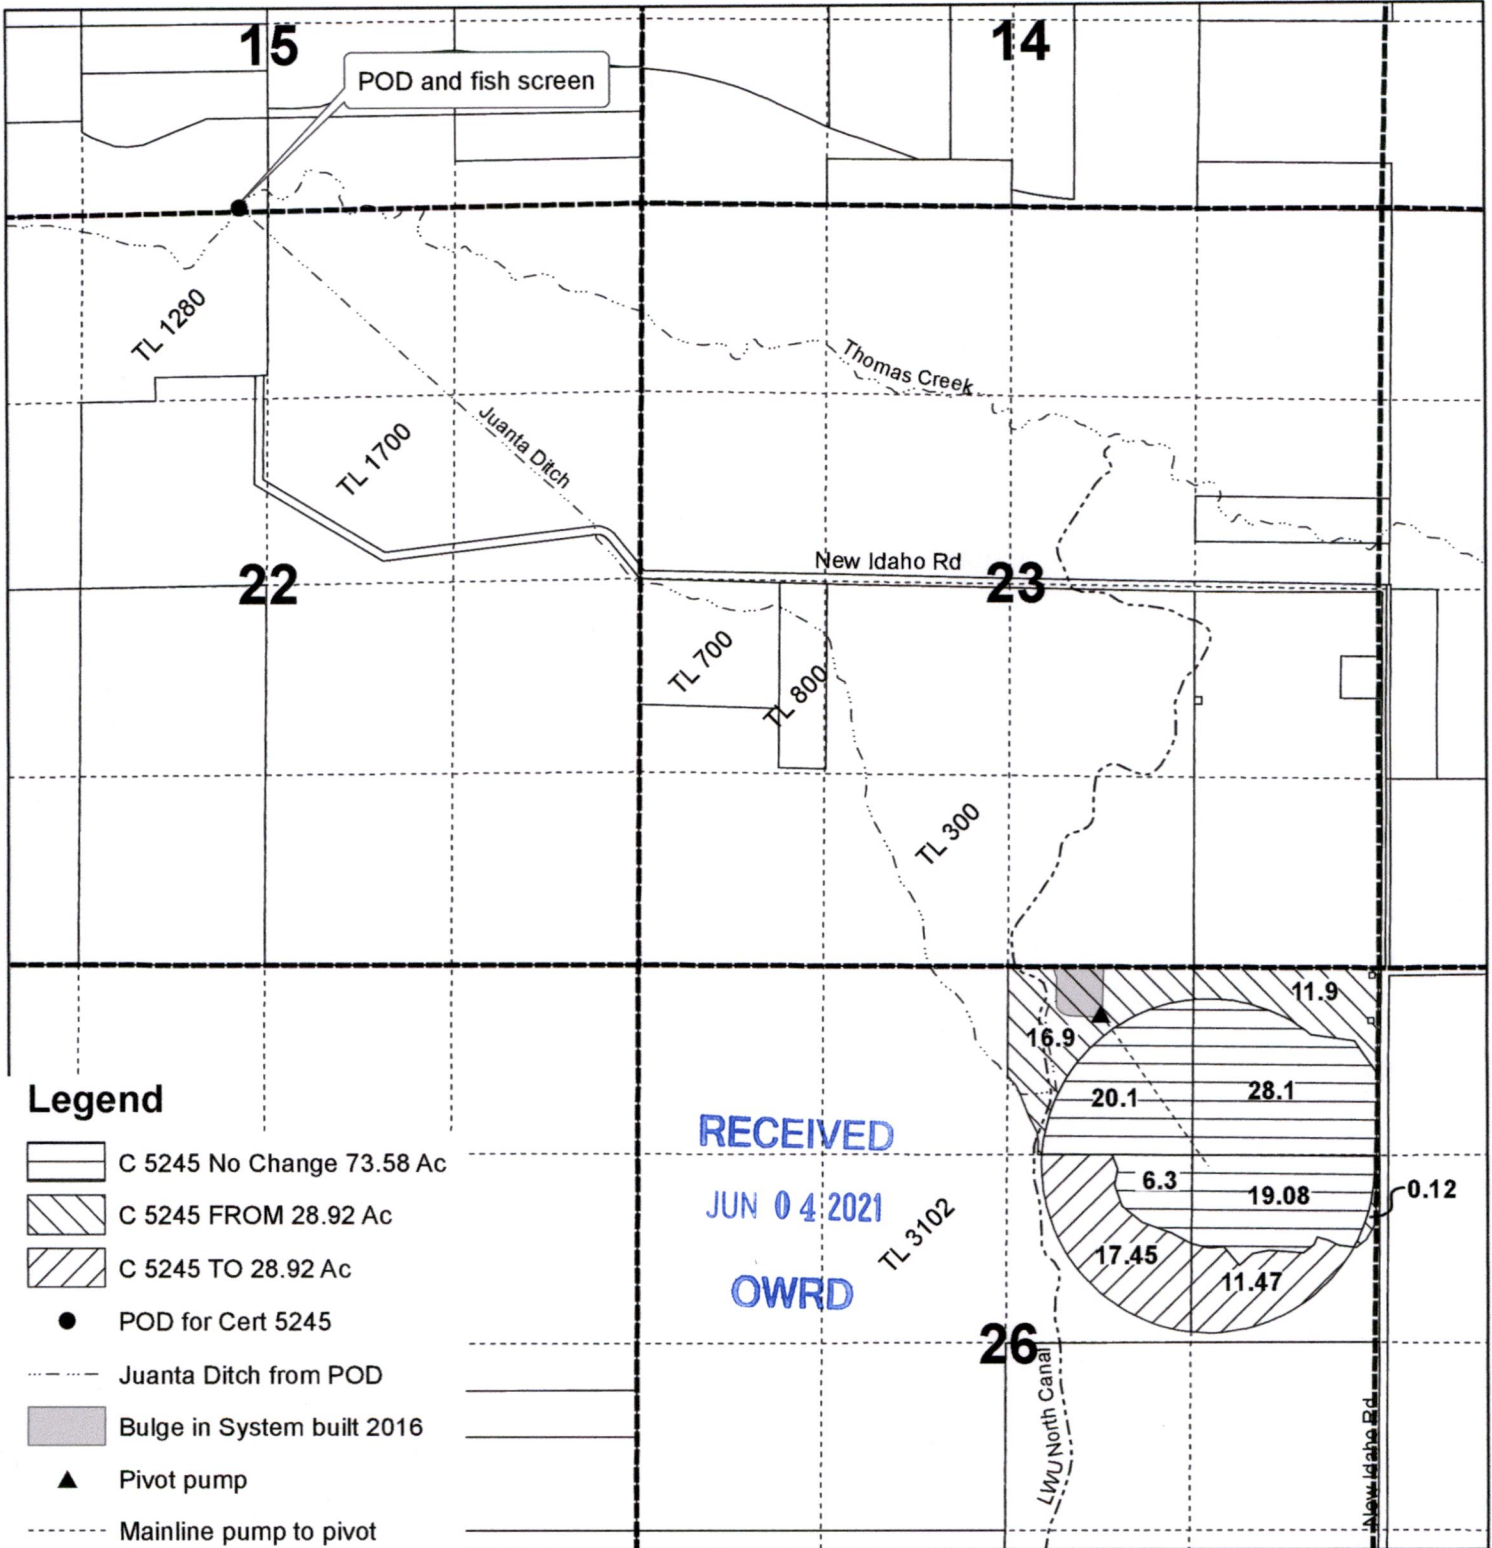13731

Robert & Teresa Squires Transfer Application Map Certificate 5245

T 38 S, R 19 E, WM
Section 26



Legend


-  C 5245 No Change 73.58 Ac
-  C 5245 FROM 28.92 Ac
-  C 5245 TO 28.92 Ac
-  POD for Cert 5245
-  Juanta Ditch from POD
-  Bulge in System built 2016
-  Pivot pump
-  Mainline pump to pivot



1 inch = 1,320 feet

POD located in the
SESW of Sec 15
26.4 Ft North &
210.8 Ft West Fm
North 1/4 Cor of
Sec. 22, T38S, R19E

Note: This map is not
intended to provide
legal dimensions or
locations of property
ownership lines.

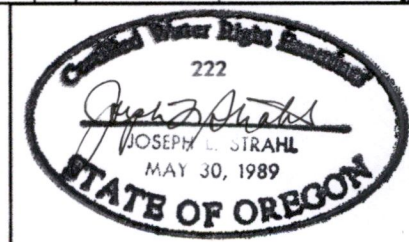

13731

5021

Map of Survey in
Section 15, T.38S. R.19E., W.M.
Lake County, Oregon

RECEIVED
JUN 04 2021
OWRD



1" = 1000'

1/4 10
15

Found 2 1/2" aluminum cap, PLS 1918, 1989
and bearing trees as per record survey #5000

N0°48'14"E - 5342.96'
(S0°47'55"W - 5343.19')

Thomas
Creek
Road

Set 1" x 30" galvanized iron pipe with 2 1/2"
Lake County Surveyor brass cap 28" in ground
for 1/4 corner Sections 15 & 22. Position
determined by single proportionate measurement.
References: 5/8" x 30" iron pin with yellow
plastic cap marked PLS 1664
N03°19'47"E - 10.0'
S05°23'55"E - 10.0'

(2656.87')
2656.71'

N89°39'09"E
(S89°39'09"W) Basis of bearings

(2656.87')
2656.71'

Found 2" iron pipe as per 1954
County Surveyor notes and record
survey #4980

Found 5/8" iron pin as
per record survey #3021

Legend

- ⊙ Set monument as noted
- Found monument as noted
- () Record as per record survey #3021
- x Steel fence posts set on line at position indicated

Narrative

Purpose: To mark the north-south center line
of Section 15.

Procedure: The south 1/4 corner Section 15
was established by single proportionate
measurement. A random traverse was run from
the south 1/4 to the north 1/4 and the center
line of the section marked with steel fence
posts.

Instruments used were a Nikon NTD-4 semi-
automatic total station and a 100' steel tape.

FILED
IN THE OFFICE OF THE
LAKE COUNTY SURVEYOR

THIS 14 DAY OF April 1990

Carl E. Sundet

COUNTY SURVEYOR

REGISTERED
PROFESSIONAL
LAND SURVEYOR

Carl E. Sundet

OREGON
JULY 14, 1978
CARL E. SUNDET
1664

Survey for: John Collins

Survey by: SUNDET AND ASSOCIATES
P.O. Box 1228
Lakeview, Oregon 97630
(503) 947-3293

Date: April 1990

Drawing # 507

5021

13731


RECEIVED

JUN 04 2021

Bob Squires
Proof of Use Map
Transfer of Certificate 5245

OWRD T 38 S, R 19 E, WM
Section 26

Photo Date June 9, 2019

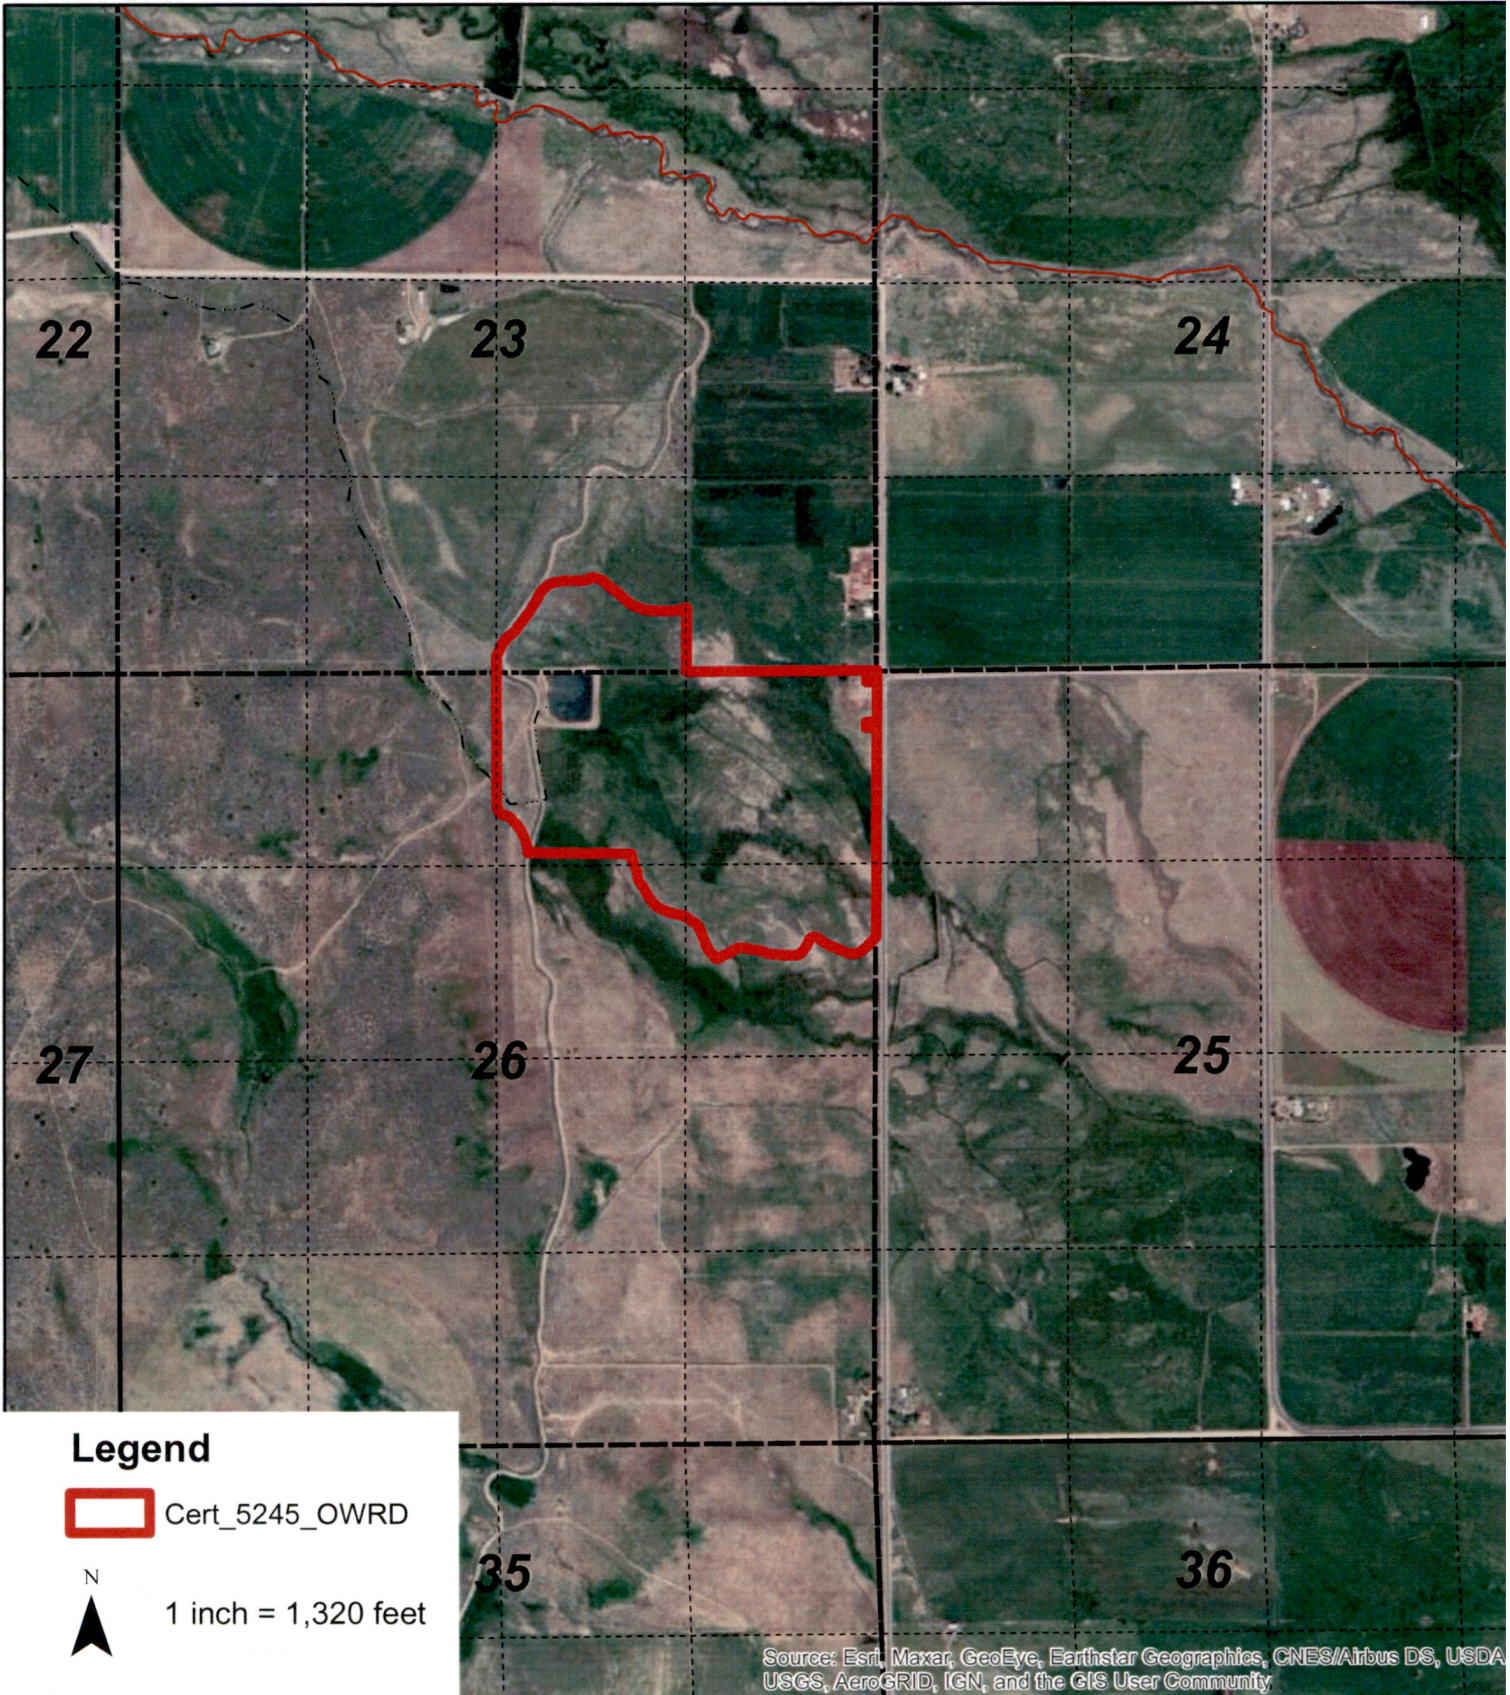

Source: Esri, Maxar, GeoEye, Earthstar Geographics, CNES/Airbus DS, USDA USGS, AeroGRID, IGN, and the GIS User Community

13731