



SCALE:
1"=400'


RECEIVED

AUG 12 2021

OWRD

STEVE SHARP
DROUGHT T.T.
T. 9S 45E. SECT 18 NW 1/4

 C-89274
1885 15⁺ AC
 C-83363
1881 28⁺ AC

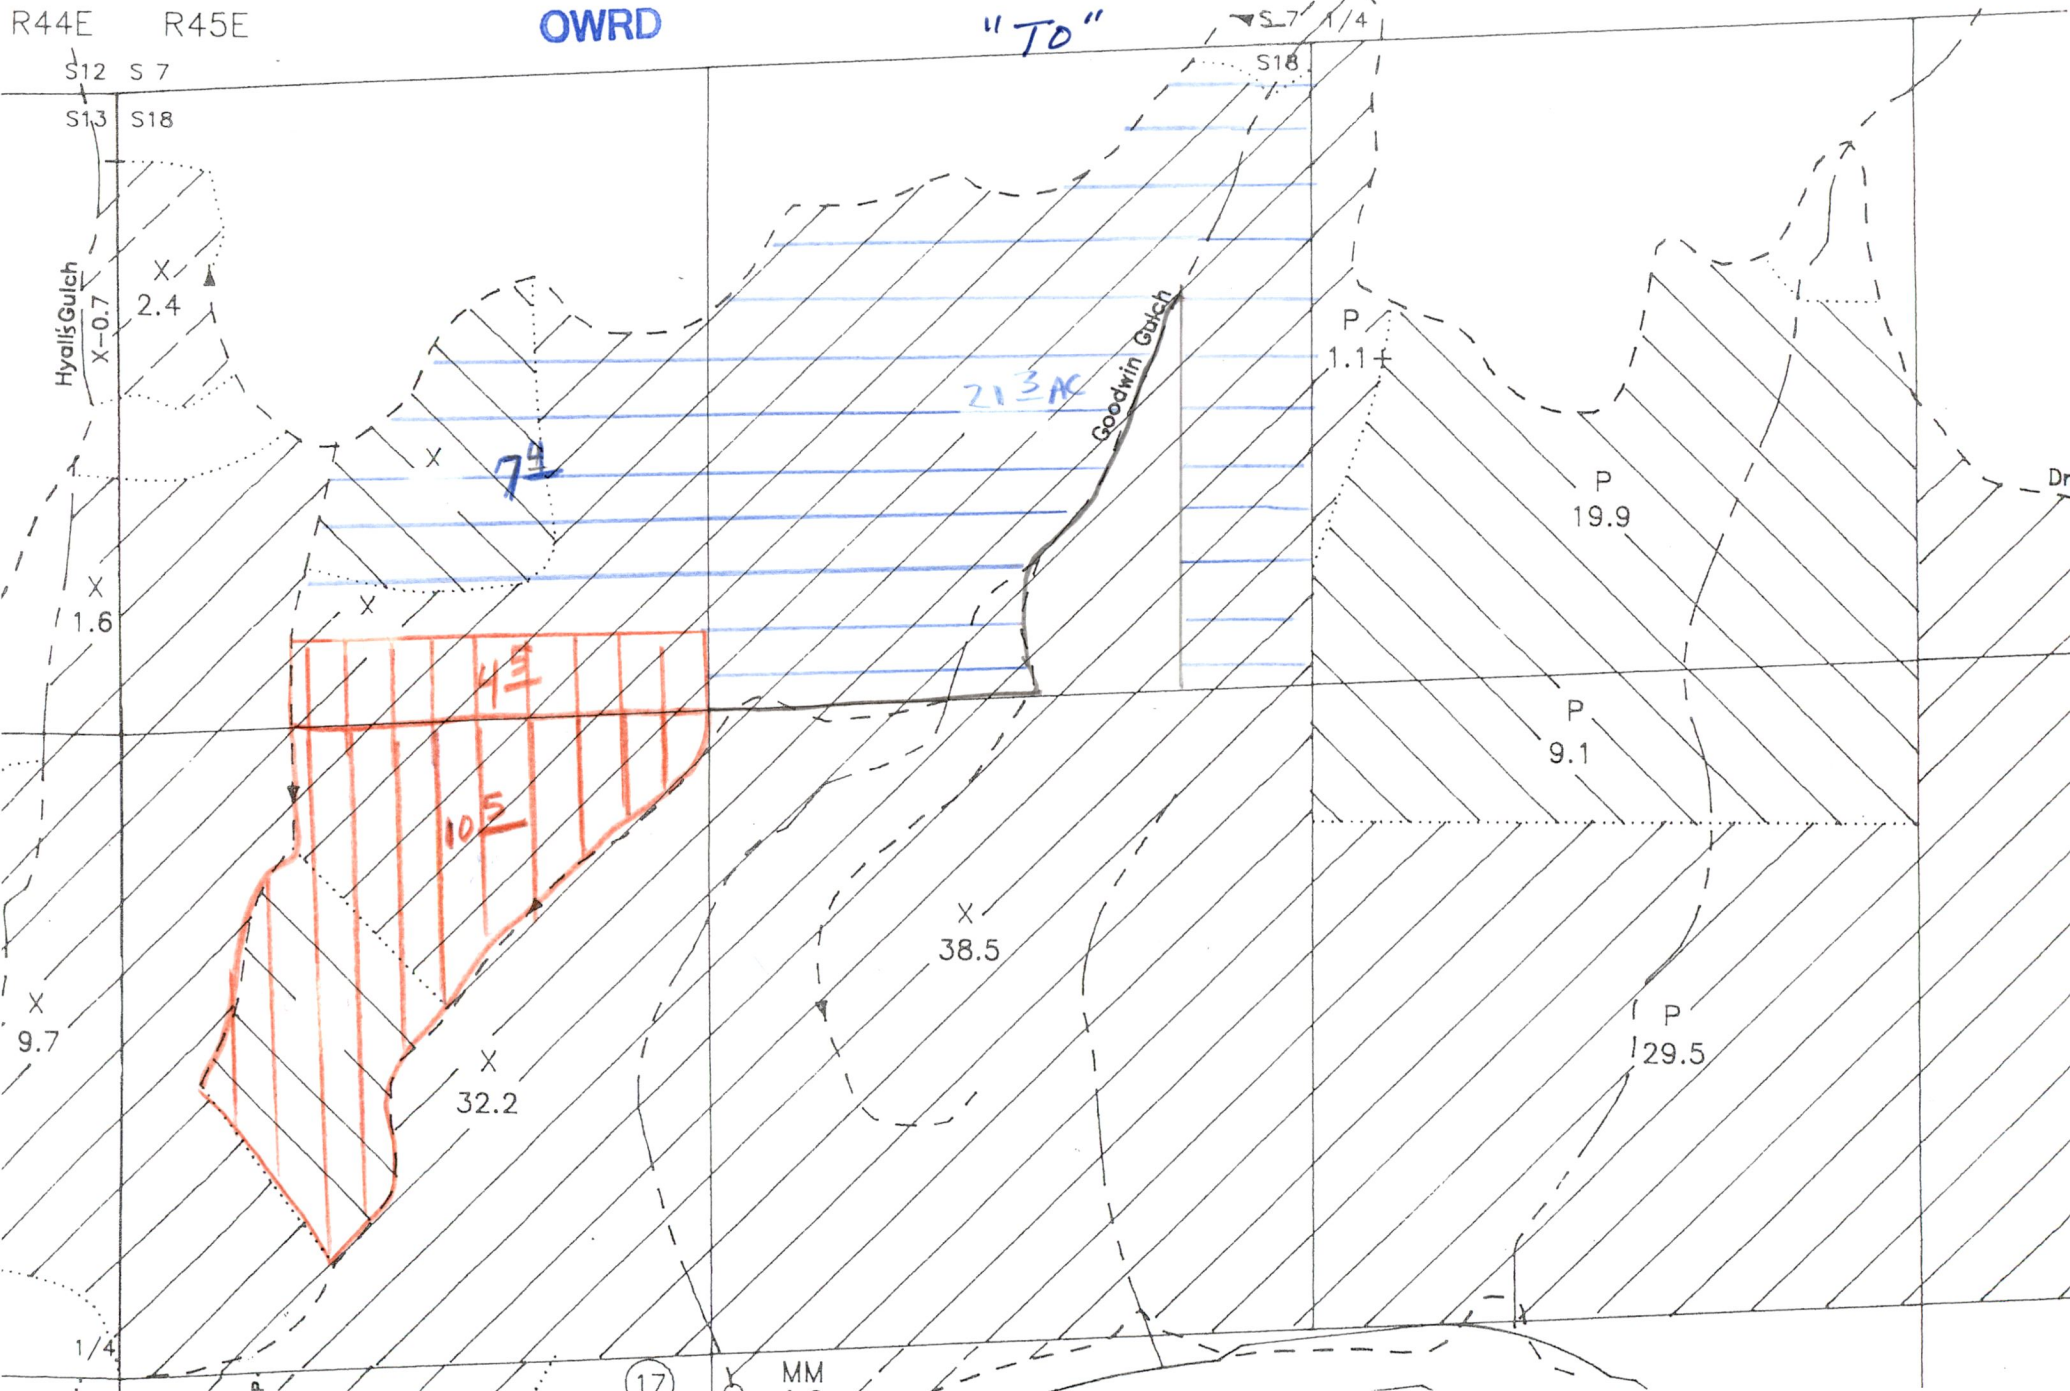



SCALE
1" = 400'

RECEIVED

AUG 12 2021

STEVE SHARP
DROUGHT TT.

T. 9.S. 45E SECT 18

"FROM" NW 1/4

OWRD

- "FROM"
-  C-85561
1894 10 1/4 AC
 -  "FROM"
C-75362
1909 33 3/4 AC
 -  C-75362
1909 RR

R44E R45E

S12 S7

S13 S18

Hyalis Gulch

X-0.7

X-2.4

X
4.9

X
1.6

7°

5°

X
5.5

X
9.7

X
38.5

Goodwin Gulch

21 3/4

P
1.1+

P
19.9

P
9.1

P
129.5

Dr

1/4

(17)

MM

T. 8S R. 415
SECT 20

RECEIVED

AUG 12 2021

OWRD

AUTHORIZED :
~~PROPOSED~~ P.O.D -
DRY GULCH DITCH

22nd

S18 S17
S19 S20

NWNW

Dry Gulch Ditch
Diversion Point
75'S & 1550'E
from NW Corner of S20

(21)

NENW

1/4 S17
S20

1/4
S19 S20


EAGLE CREEK COUNTY ROAD
EAGLE CREEK
Dry Gulch Ditch

RECEIVED

AUG 12 2021

OWRD

Authorized & Proposed Additional
T. 9S, R. 45E

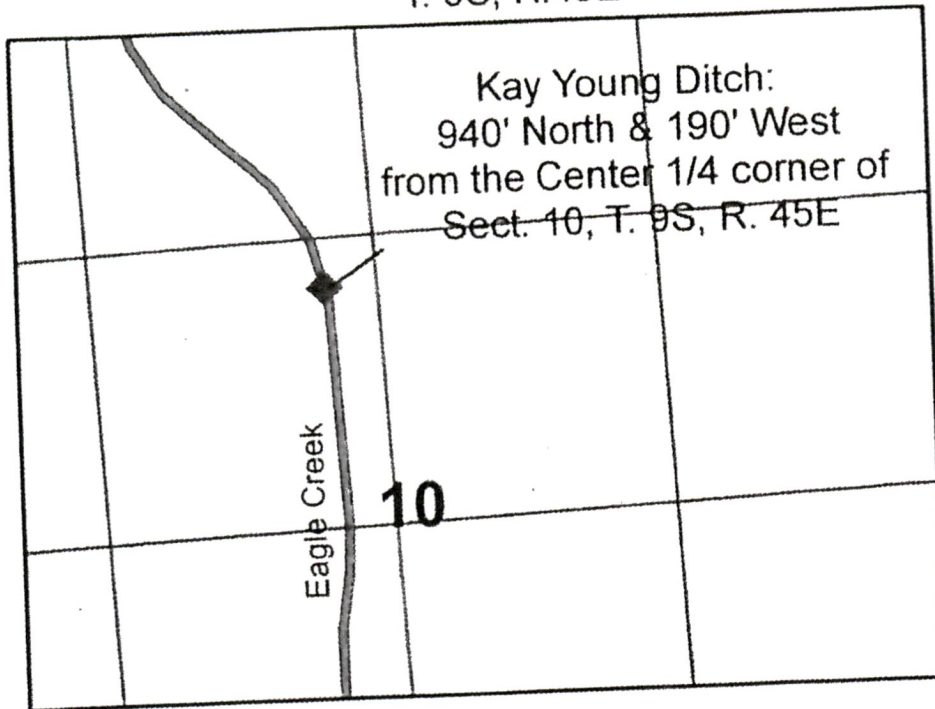


RECEIVED

AUG 12 2021

OWRD

Authorized & Proposed Additional
T. 9S, R.45E

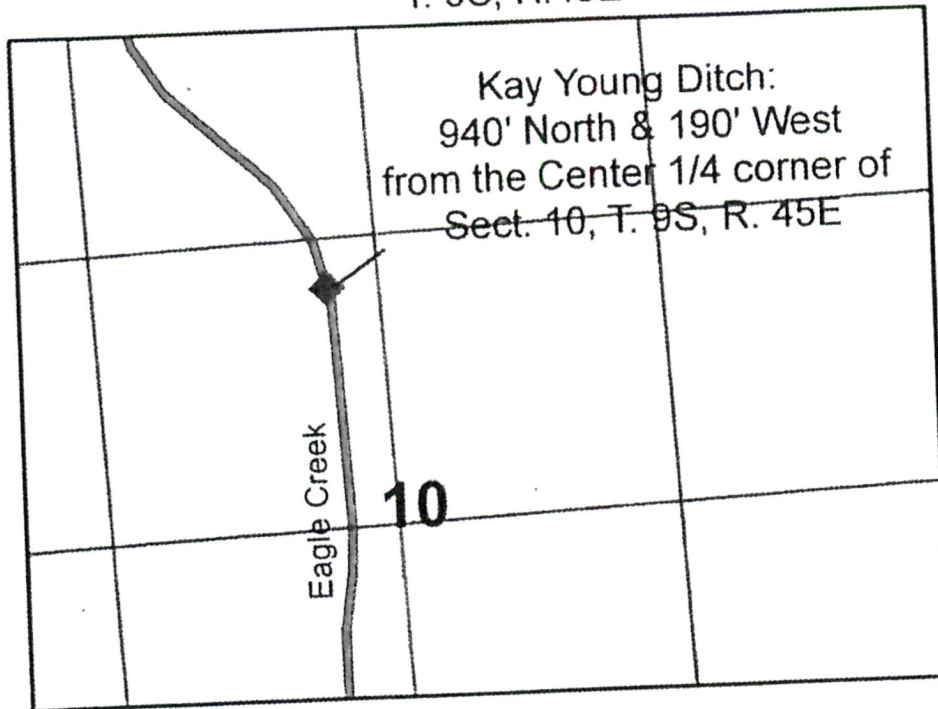



RECEIVED

AUG 12 2021

OWRD



RECEIVED

AUG 12 2021

OWRD