

Map # 3


From Lands for Certificate 44889

RECEIVED

AUG 30 2021

OWRD

T. 9 S. R. 5 W. W.M.

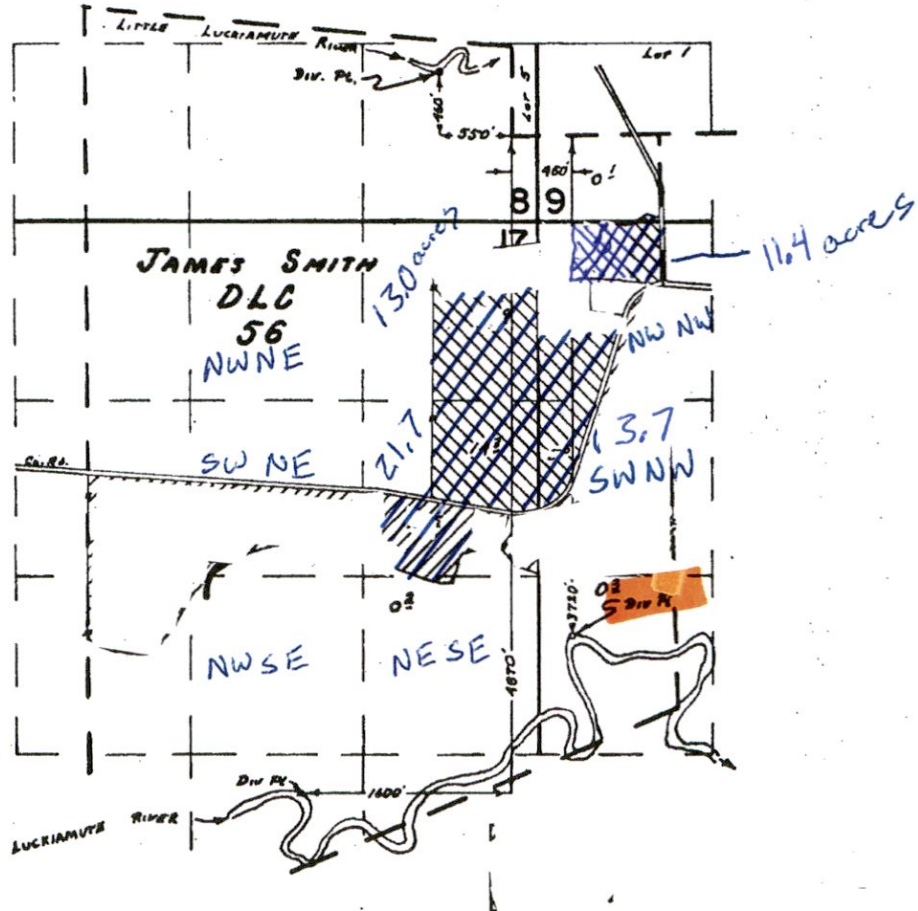

FINAL PROOF SURVEY UNDER

Application No. 46036 Permit No. 34380

IN NAME OF

C. A. TWISS

Surveyed MAR. 18, 1973, by R.B. MUEHLEN

13810

Map # 2



Too Lands for Certificate 65744


10-26-1950

RECEIVED

AUG 30 2021

OWRD

T. 9 S. R. 5 W. W.M.

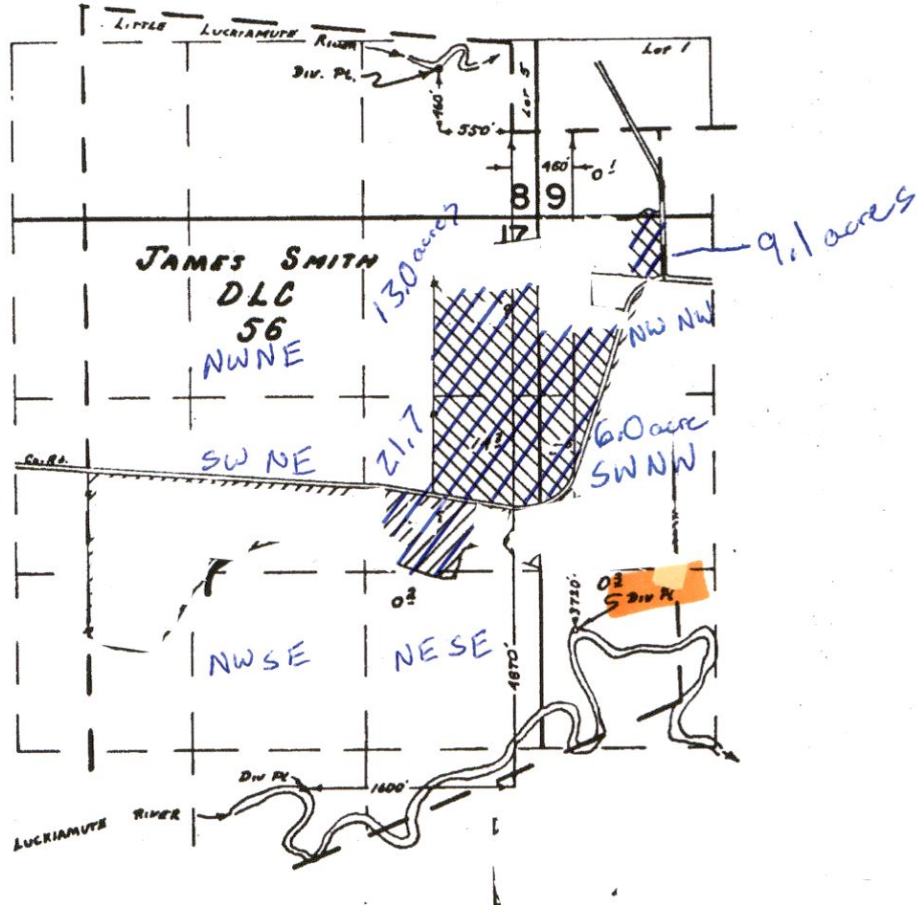

FINAL PROOF SURVEY
UNDER

Application No. 46036 Permit No. 34380

IN NAME OF

C. A. TWISS

Surveyed MAR. 16 1973, by R. B. MUCKEN

13810

Map # 1



Transfer From Certificate 65744 priority date 10-26-1950


Transfer Certificate 44889 Too Lands priority date 5-12-1969

T. 9 S., R. 5 W., W.M.

RECEIVED

AUG 30 2021

OWRD

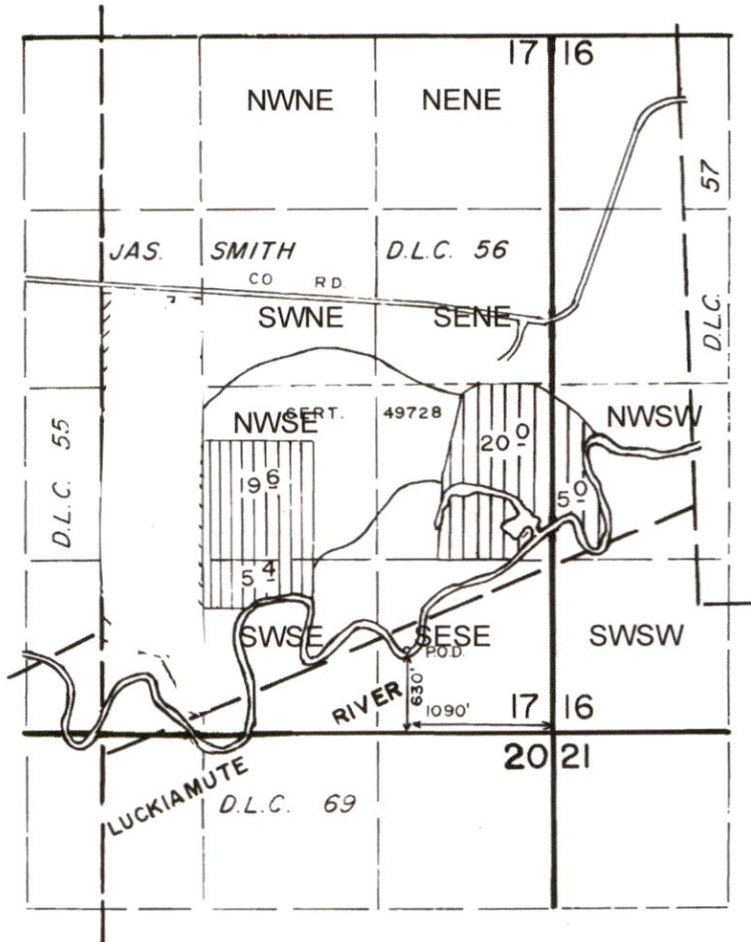

1" = 1320'



priority 10-26-50

FINAL PROOF SURVEY UNDER

TRANSFER NO. 4504, 4505, 4506, 4507

Application No. Permit No.
IN NAME OF

.....ALAN L. & JANICE L. FROST.....

Surveyed MAY 11 1987 by B.W. BISHOP

10-3-90
DPP-2P-7
41053-178-203D


13810

RECEIVED

AUG 30 2021

T. 9 S. R. 5 W. W.M.

OWRD

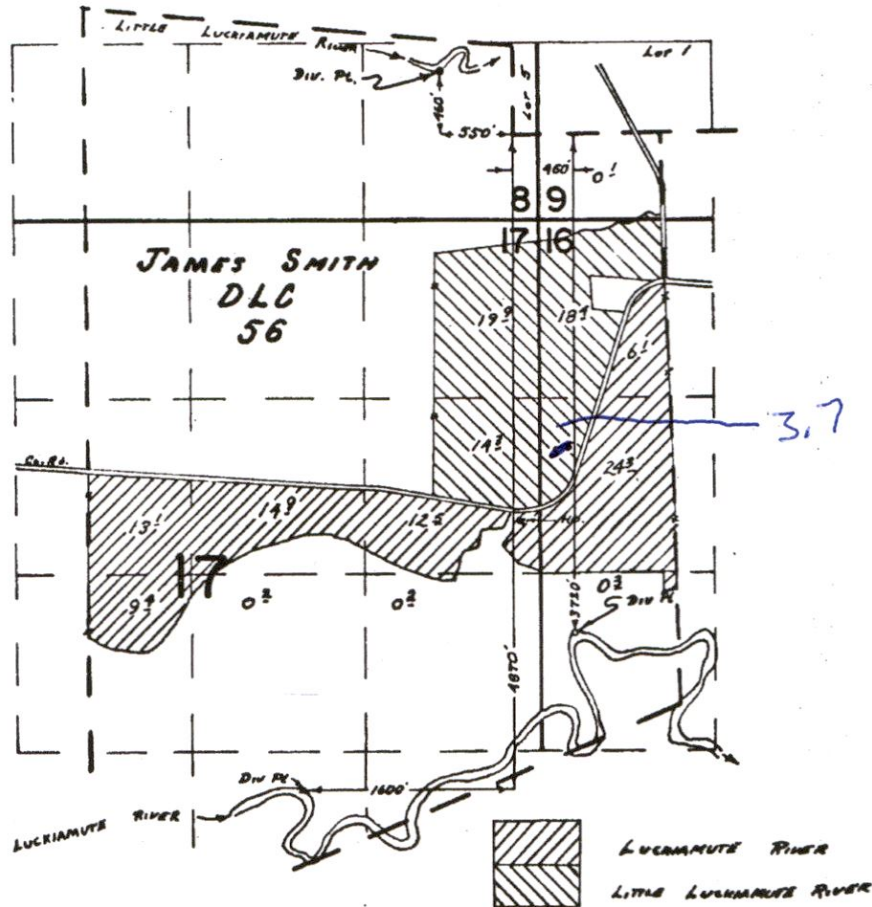

FINAL PROOF SURVEY
UNDER

Application No. 46036 Permit No. 34380

IN NAME OF

C. A. TWISS

Surveyed MAR. 18 1973, by R. B. MUCKEN


13810

T. 9 S., R. 5 W., W.M.

RECEIVED

AUG 30 2021

OWRD

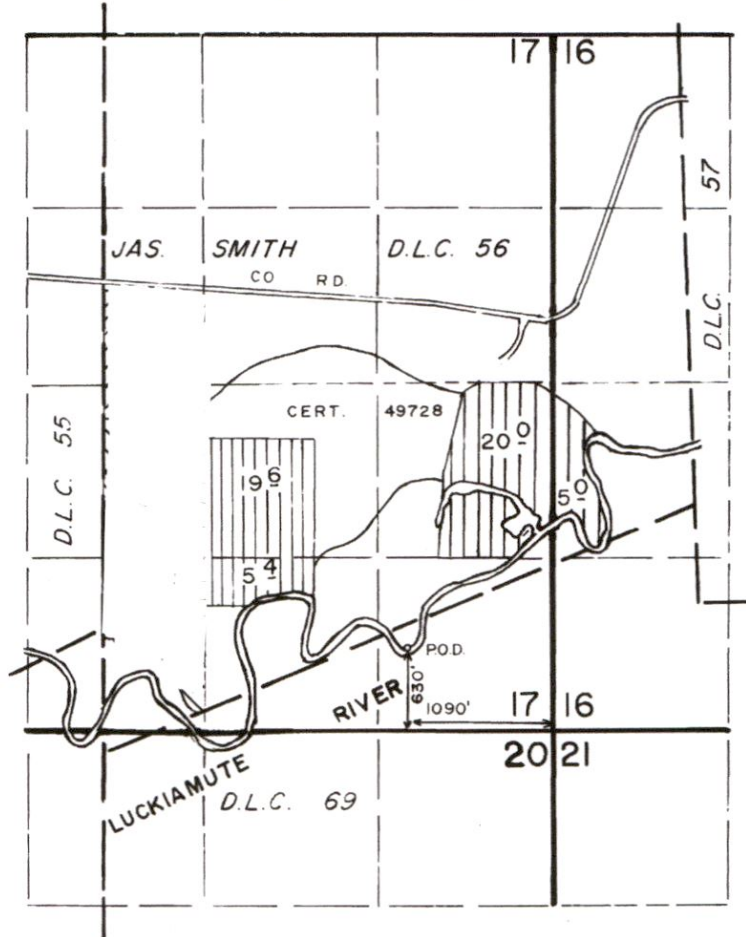

1" = 1320'



priority 10-26-50

Cert 65744

**FINAL PROOF SURVEY
UNDER**

TRANSFER NO. 4504, 4505, 4506, 4507

Application No. Permit No.
IN NAME OF

.....ALAN L. & JANICE L. FROST.....

Surveyed MAY 11 1987, by B.W. BISHOP

10-3-90
UFP-2P-7
41053-178-203D

13810