CERTIFIED WATER RIGHT EXAMINER
85503
DOANN HAMILTON
MAY 10, 2018
STATE OF OREGON
EXPIRES: June 30, 2023

RECEIVED
OCT 29 2021
OWRD

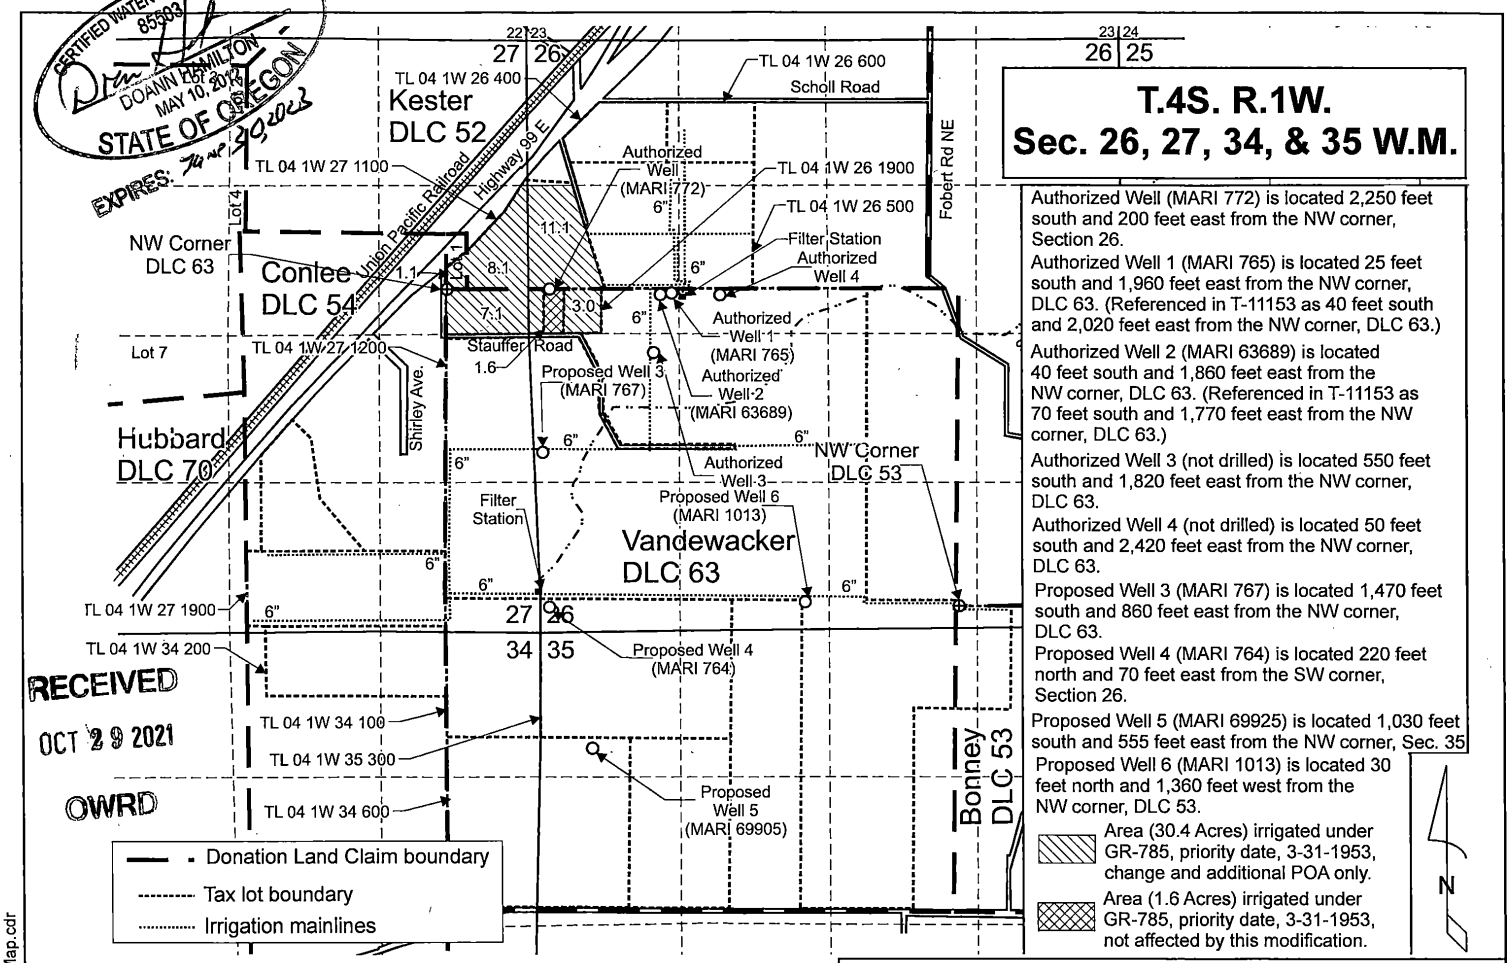

Scale: 1" = 1,320'

0 1,320 Feet

This map was prepared for the purpose of identifying the location of a water right only and is not intended to provide legal dimensions or location of property ownership lines.

Pacific Hydro-Geology Inc.

Groundwater Registration Modification Application Map
GR-785 / T-11153

Stauffer Farms Inc.
T.4S. R.1W. Sec. 26, 27. 34 & 35, W.M.

07/2021

StaufferTransMap.cdr