


RIDGEVIEW IRRIGATION DISTRICT

OWRD RECEIVED
Ann Reece, 1/20/2022, 4:04:46 PM

Permanent **off** Transfer Map For Paul Shenk Certificate 21012

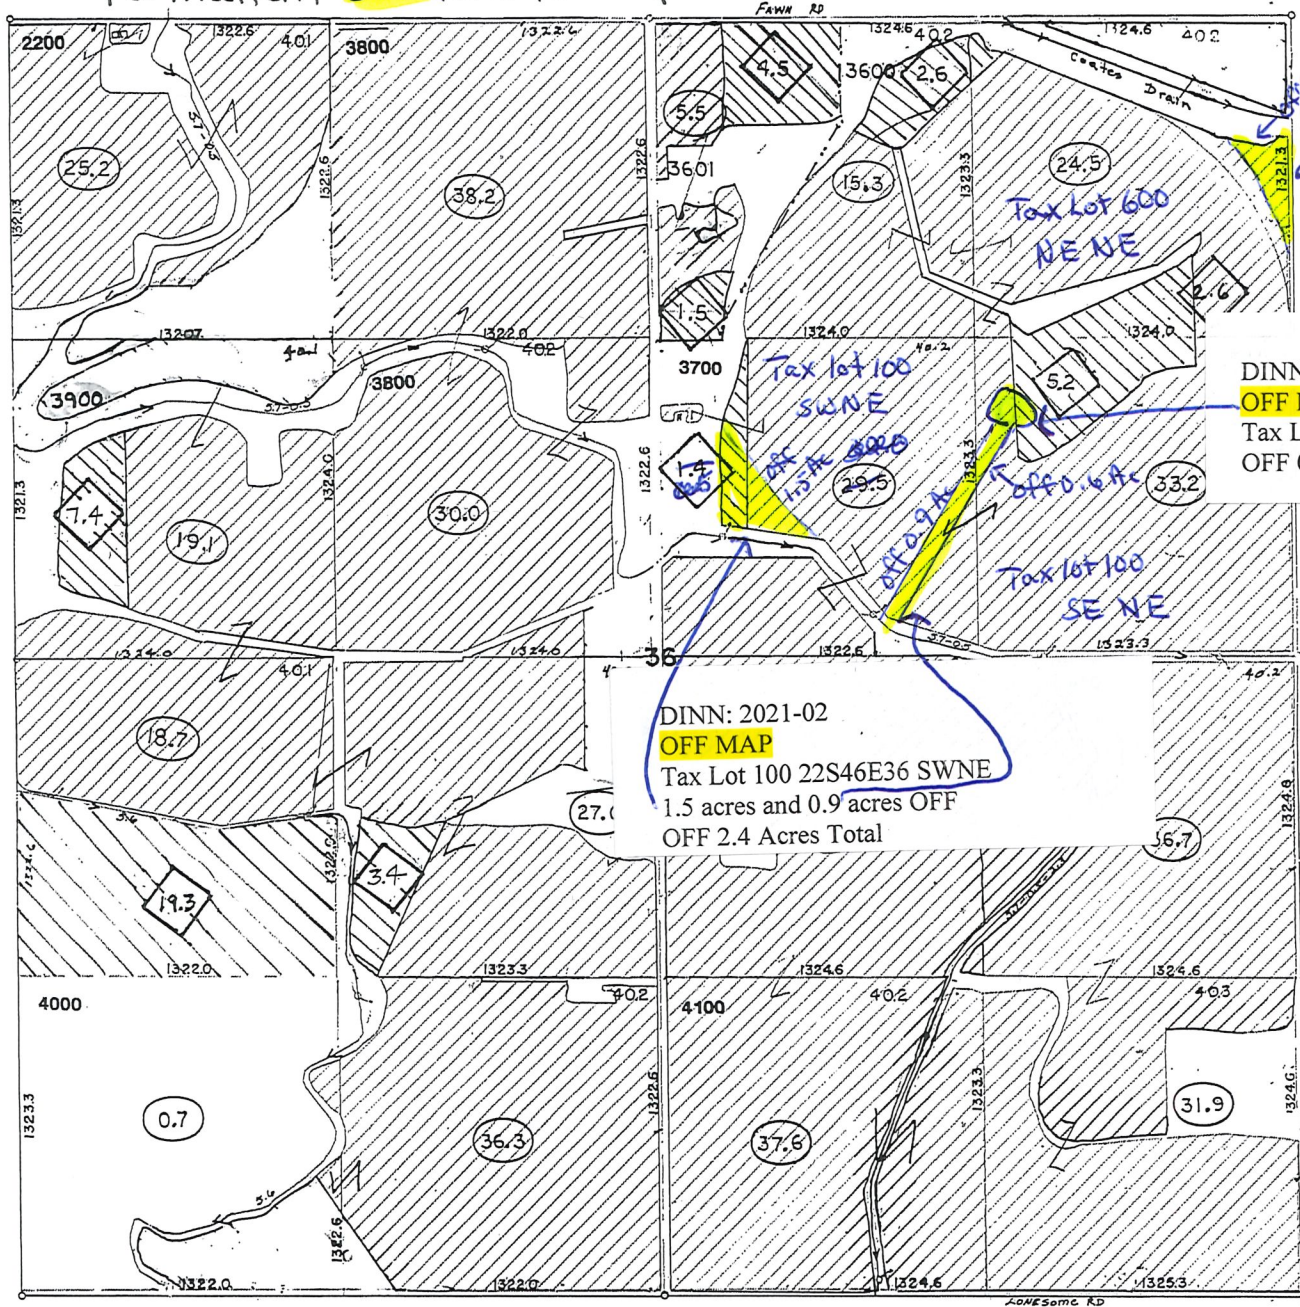

DINN: 2021-02
OFF MAP
Tax Lot 600 22S46E36 NENE
OFF 1.0 Acre Total

DINN: 2021-02
OFF MAP
Tax Lot 100 22S46E36 SENE
OFF 0.6 Acre Total

DINN: 2021-02
OFF MAP
Tax Lot 100 22S46E36 SWNE
1.5 acres and 0.9 acres OFF
OFF 2.4 Acres Total

off Area

- (x.x) IRR. ACRES IN 1/4 1/4
- [diagonal lines] IRR. ACRES
- (x.x) PENDING
- [diagonal lines] PENDING ACRES
- (x.x) PRIVATE
- [diagonal lines] PRIVATE ACRES
- PROPERTY LINE IF OTHER THAN 1/4 1/4

Now Approved Irr.



SCALE: 1" = 400'

SEC. 36, T:22 S., R.46 E., W.M.

48-102-1572

Traced: R.E. 6-13-55
Checked: H.G. 6-21-55

RIDGEVIEW IRRIGATION DISTRICT

OWRD RECEIVED
Ann Reece, 1/20/2022, 4:04:46 PM

Permanent on Transfer Map For Paul Shenk Certificate 81012



DINN:2021-02
ON MAP
Tax Lot 100 22S46E36 SWNE
ON 4.0 Acres Total

Tax Lot 100
SW NE

on Area

Now Approved Irr.


SEC. 36, T:22 S., R.46 E., W.M.

48-102-15712

Traced: R.F. 6-13-55
Checked: H.G. 6-21-55

RIDGEVIEW IRRIGATION DISTRICT

Permanent on Transfer Map for Price Seed Farm Certificate 81012

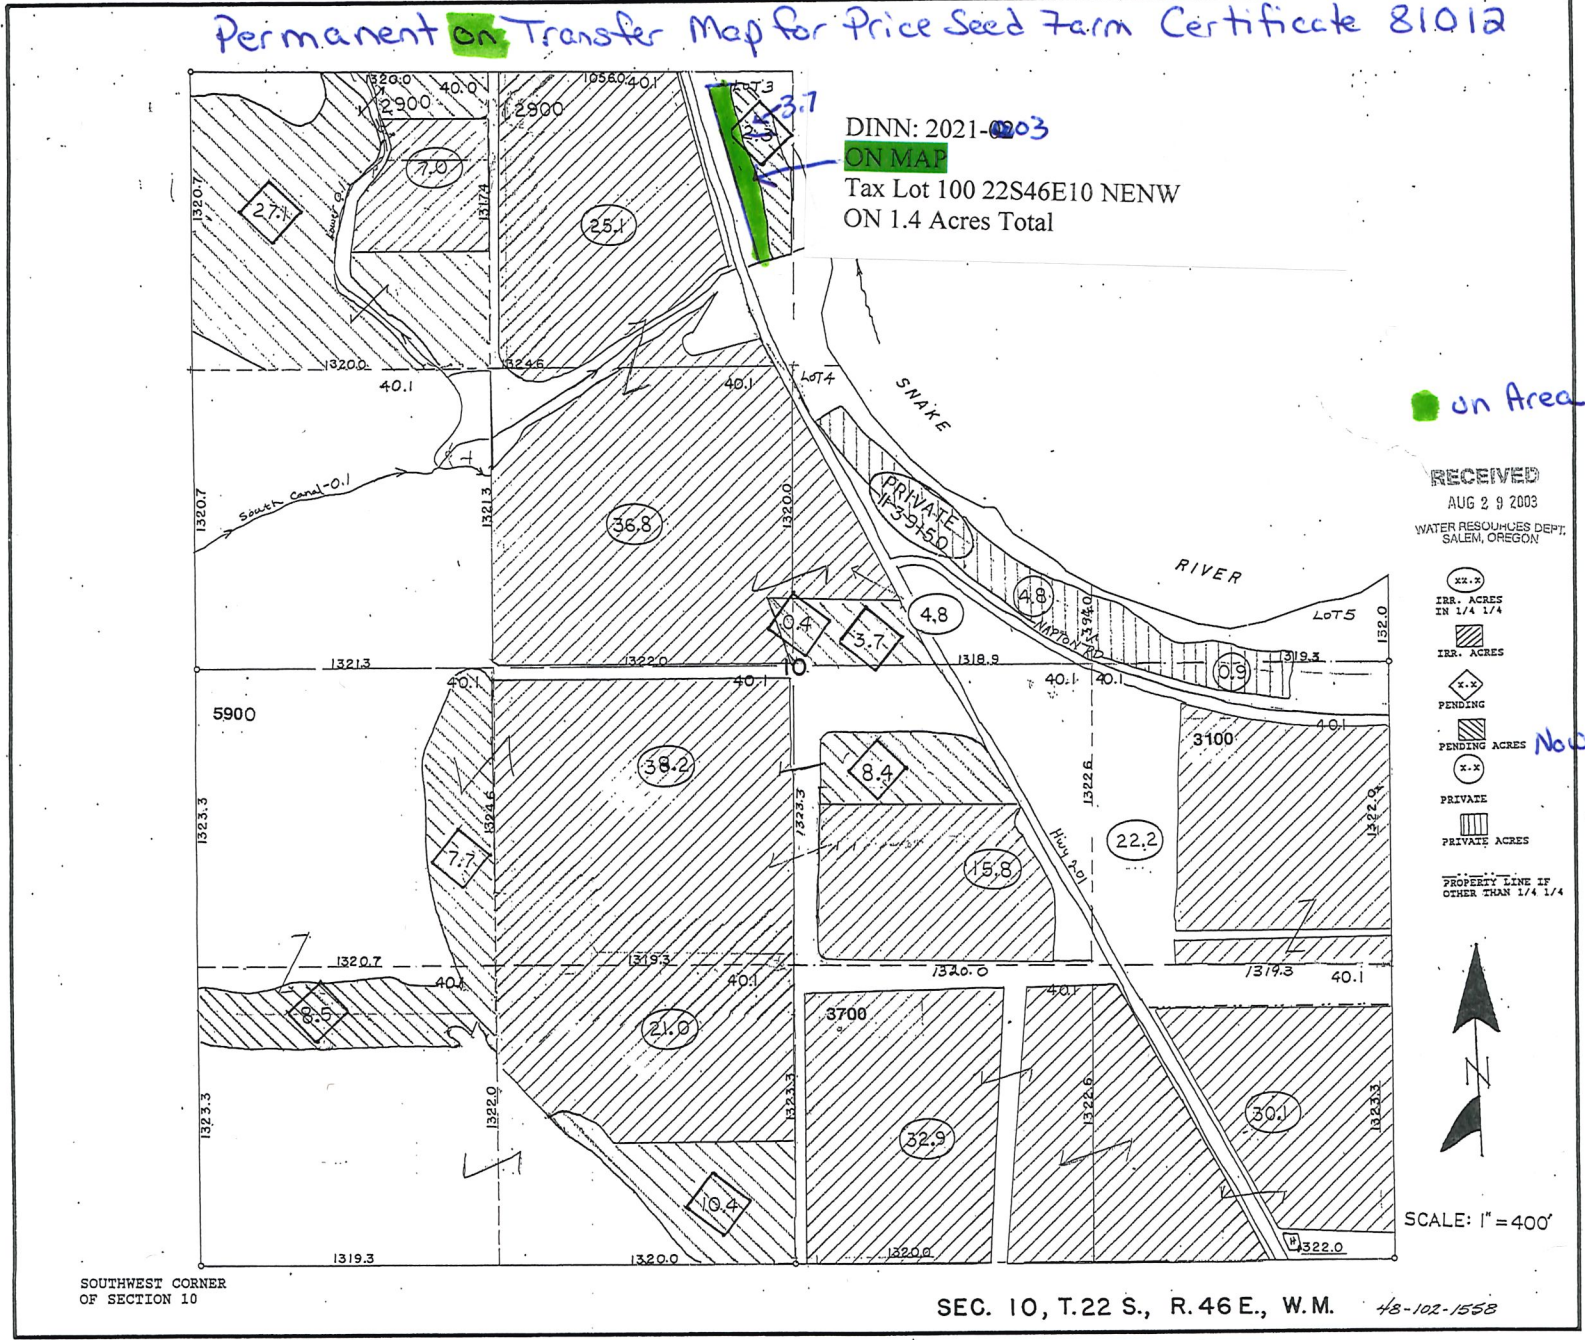

DINN: 2021-0203
ON MAP
Tax Lot 100 22S46E10 NENW
ON 1.4 Acres Total

on Area

RECEIVED
AUG 29 2003
WATER RESOURCES DEPT.
SALEM, OREGON

- (xx-x) IRR. ACRES IN 1/4 1/4
- (diagonal lines) IRR. ACRES
- (x-x) PENDING
- (diagonal lines) PENDING ACRES
- (x-x) PRIVATE
- (diagonal lines) PRIVATE ACRES

Now Approved



SCALE: 1" = 400'

SOUTHWEST CORNER
OF SECTION 10


SEC. 10, T.22 S., R.46 E., W.M. 48-102-1558

Traced: R.W.R. 4-15-53
Checked: R.F. 6-20-55

RIDGEVIEW IRRIGATION DISTRICT

OWRD RECEIVED
Ann Reece, 1/20/2022, 4:03:06 PM

Permanent **off** Transfer Map
for Price Seed Farm
Certificate 81012

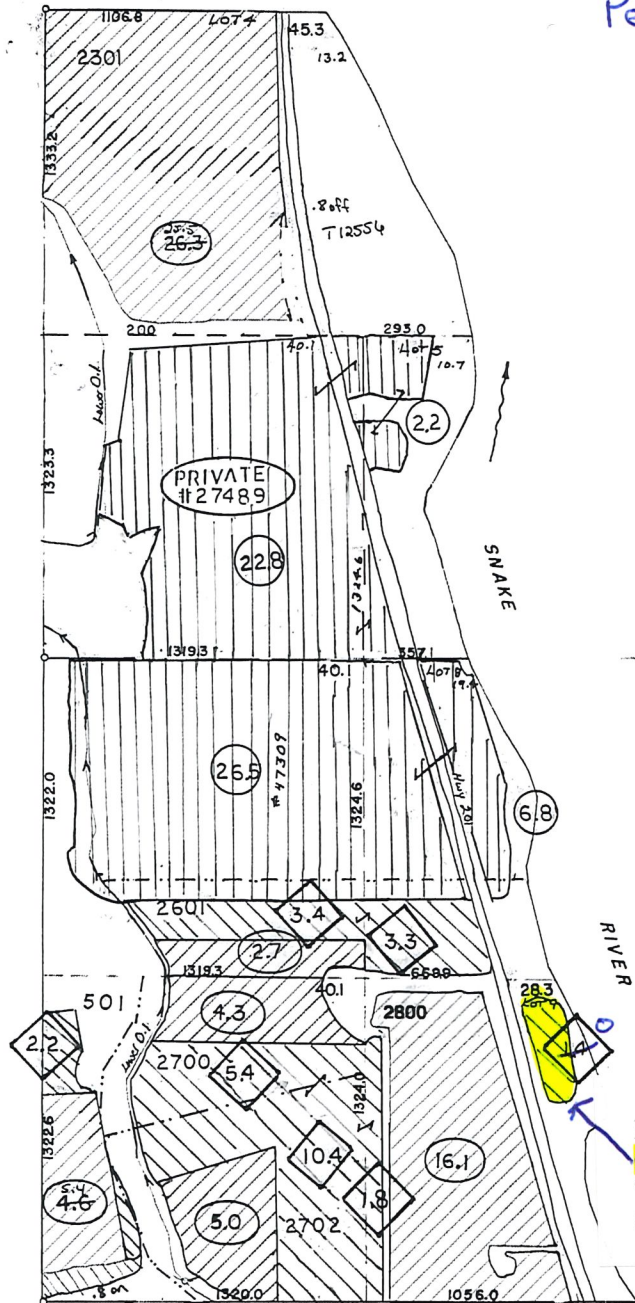

off area

- IRR. ACRES IN 1/4 1/4
- IRR. ACRES
- PENDING
- PENDING ACRES *Now Approved*
- PRIVATE
- PRIVATE ACRES
- PROPERTY LINE IF OTHER THAN 1/4 1/4

DINN: 2021-03
OFF MAP
Tax Lot 1500 22S46E03 SESW
OFF 1.4 Acres Total



SCALE: 1" = 400'
18-102-1556

SOUTHWEST CORNER OF SECTION 3


SEC. 3, T.22 S., R.46 E., W.M.

Traced: R.W.R. 4-15-53
Checked: R.F. 6-20-55

SUPERSEDED

RIDGEVIEW IRRIGATION DISTRICT

Permanent Transfer - ON Paul Shank

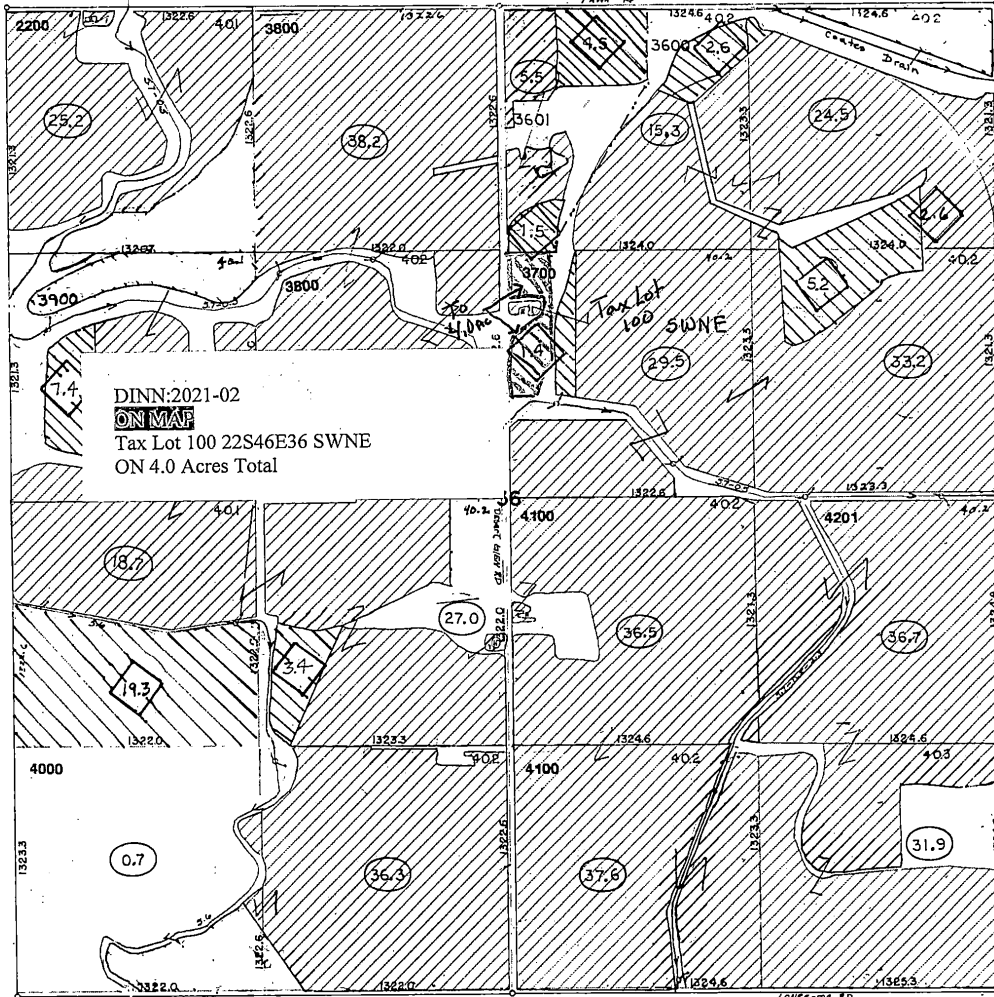

- 22.0 IRR. ACRES IN 1/4 1/4
- IRR. ACRES
- PENDING
- PENDING ACRES
- PRIVATE
- PRIVATE ACRES
- PROPERTY SIZE IF OTHER THAN 1/4 1/4

See Copy for
Scale
of Water
Rights
Thru...



SCALE: 1" = 400'

SEC. 36, T.22 S., R. 46 E., W.M. 48-122-1572

Traced: R.E. 6-13-55
Checked: H.G. 6-27-55

98861


RECEIVED
JAN 03 2022
OWRD

SUPERSEDED

RIDGEVIEW IRRIGATION DISTRICT

Permanent Transfer - ON Price Seed
To: 1.4 Ac

DINN: 2021-02
ON MAP
Tax Lot 100 22S46E10 NENW
ON 1.4 Acres Total

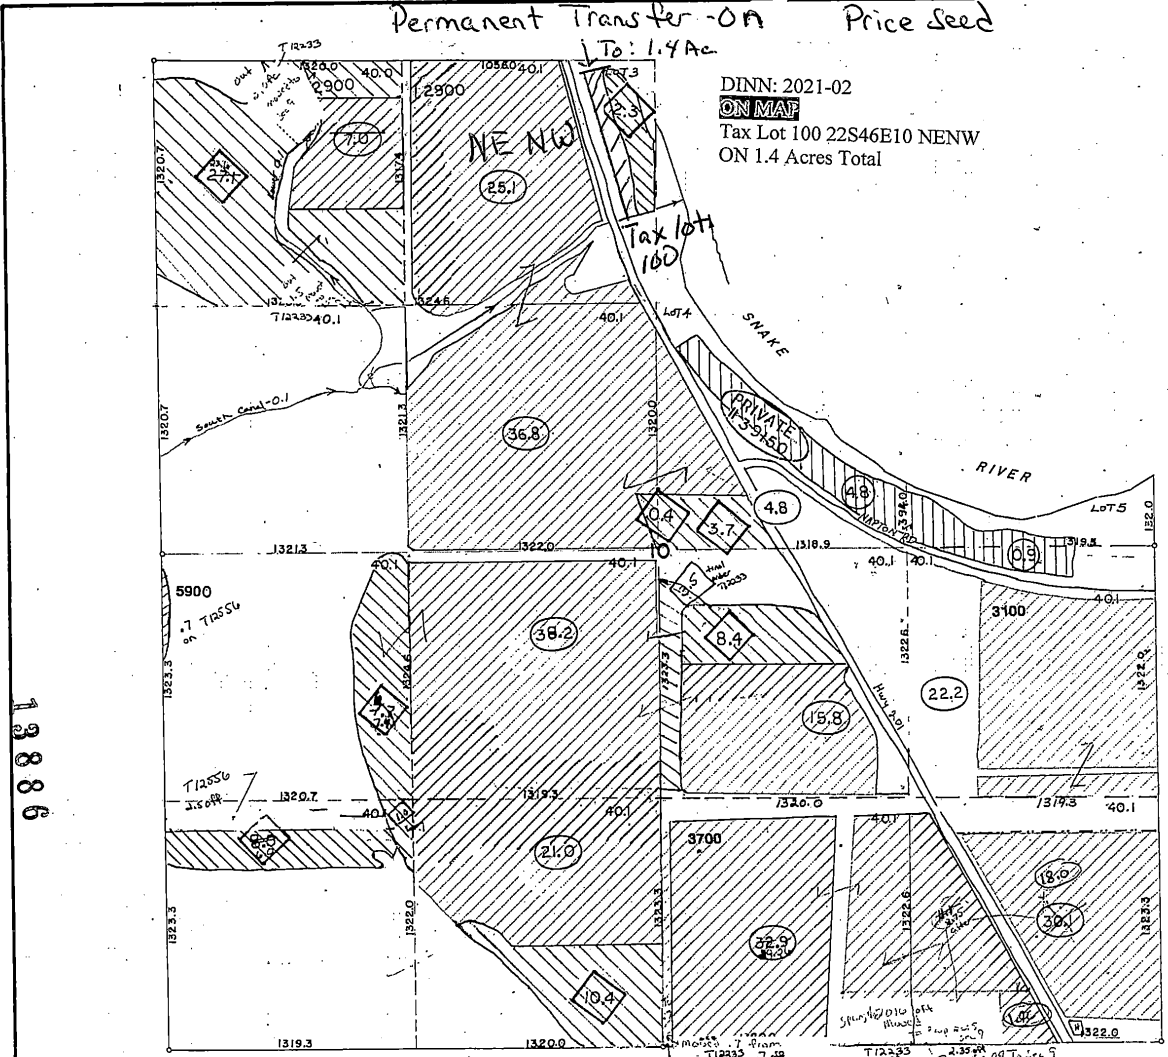

- XX.2 IRR. ACRES OR 1/4 1/4
 - IRR. ACRES
 - PENDING ACRES
 - PENDING ACRES
 - PRIVATE
 - PRIVATE ACRES
- PROPERTY LINE IF OTHER THAN 1/4 1/4



RECEIVED
JAN 03 2022
OWRD

SCALE: 1" = 400'

13886

SOUTHWEST CORNER OF SECTION 10

SEC. 10, T.22 S., R.46 E., W.M. 48-102-1558

Traced: R.W.R. 4-15-53
Checked: R.F. 6-20-55

SUPERSEDED


RIDGEVIEW IRRIGATION DISTRICT

Paul Shank Permanent Transfer - OFF

DINN: 2021-02
OFF MAP
Tax Lot 600 22S46E36 NENE
OFF 1.0 Acre Total

DINN: 2021-02
OFF MAP
Tax Lot 100 22S46E36 SENE
OFF 0.6 Acre Total

DINN: 2021-02
OFF MAP
Tax Lot 100 22S46E36 SWNE
OFF 2.4 Acres Total

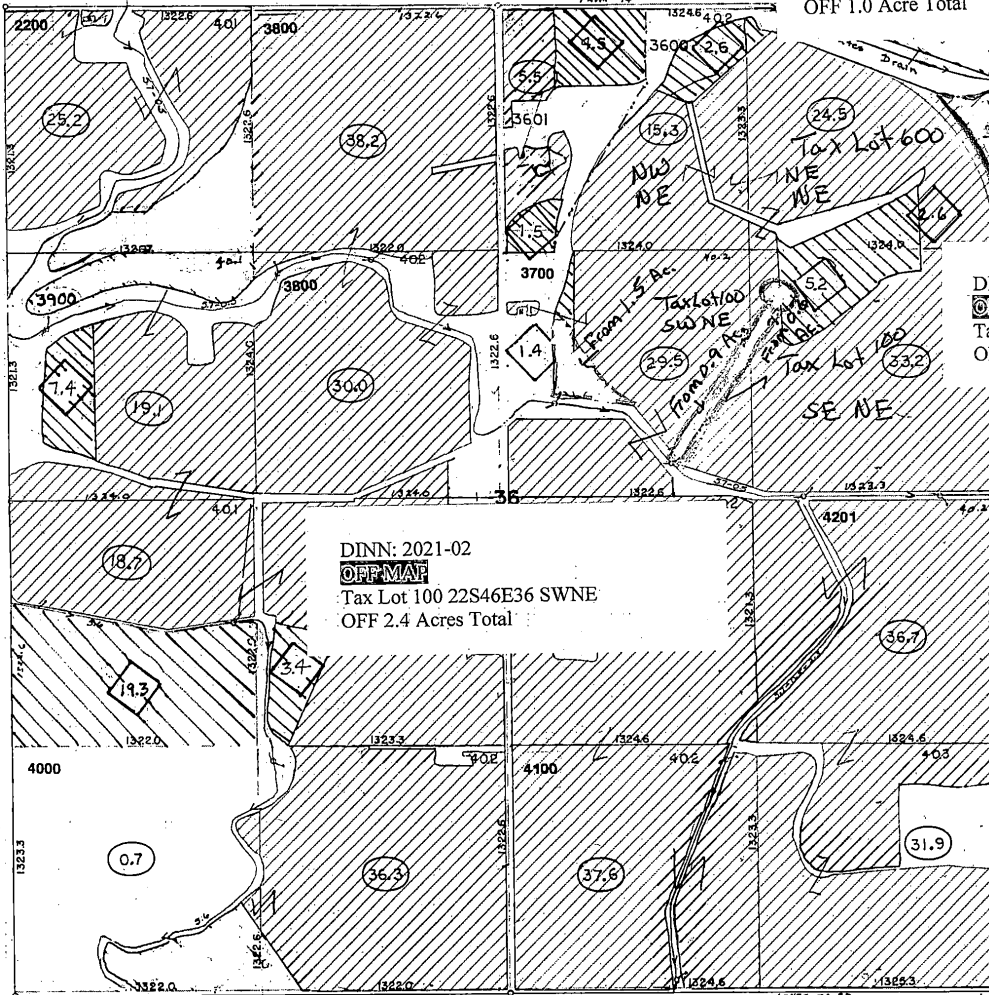

13886

See Copy for Sale Split of Water Right Thomas

RECEIVED
JAN 03 2022
OWRD

SEC. 36, T.22 S., R. 46 E., W.M.


Traced: R.E. 6-13-55
Checked: H.C. 6-21-55

43-102-15712

SUPERSEDED

RIDGEVIEW IRRIGATION DISTRICT

Permanent Transfer Off Price Seed

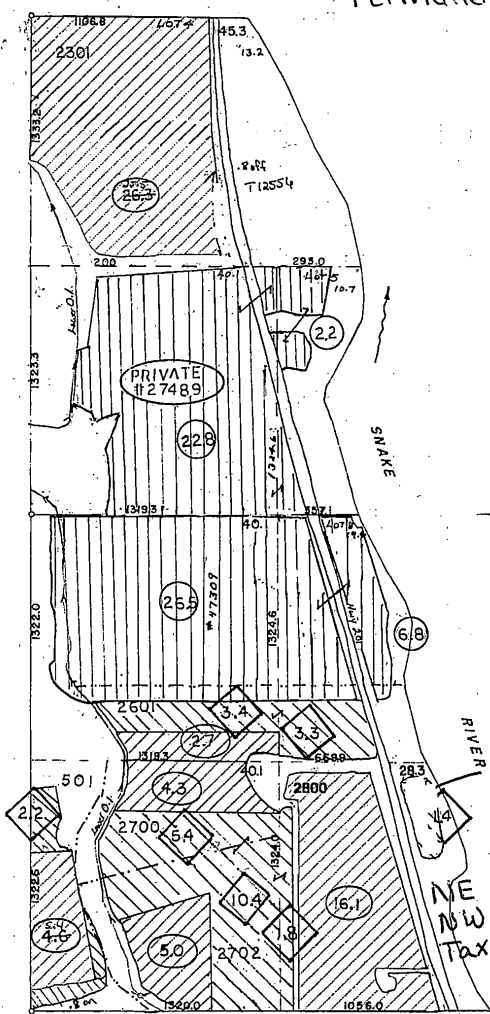

3

- EX. 1
- 228. ACRES IN 1/4 1/4
- 228. ACRES
- PENDING
- PENDING ACRES
- PRIVATE
- PRIVATE ACRES
- PROPERTY LINE IS OTHER THAN 1/4 1/4

13886

DINN: 2021-03
OFF MAP
 Tax Lot 1500 22S46E03 SESW
 OFF 1.4 Acres Total

RECEIVED

JAN 03 2022

NE NW
 Tax lot ~~1500~~
 1500

OWRD

SCALE: 1" = 400'

SOUTHWEST CORNER OF SECTION 3

SEC. 3, T.22 S., R.46 E., W.M.

Traced: R.M.P. 4-18-53
 Checked: R.F. 6-20-55

18-102-1556