




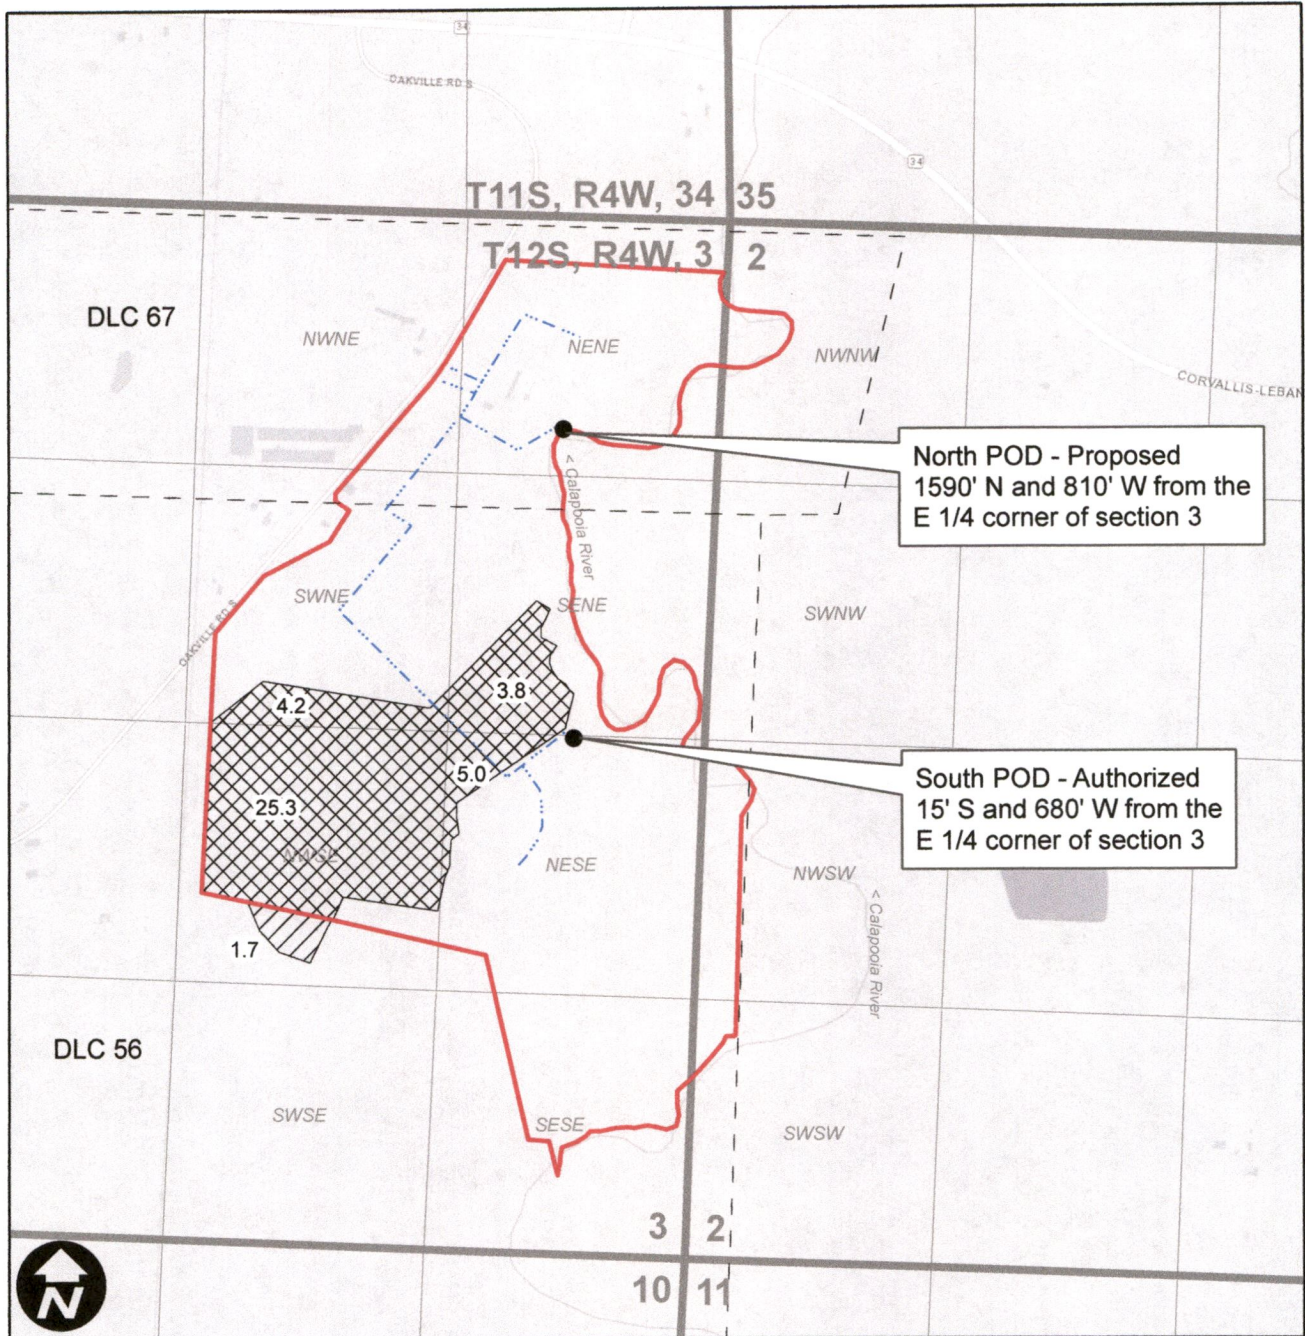


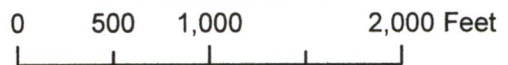
# Transfer Application Certificate 12352 - Stellmacher

OWRD



## Legend

-  Cert. 12352 Transfer
-  Mainline
-  Cert. 12352 No Change
-  DLC
-  Tax Lot 1000



EXPIRES: 12-31-2022

RECEIVED

JAN 28 2022

OWRD



RECEIVED

DEC 16 2021

OWRD

13902