

PERMIT AMENDMENT MAP

APPLICATION G-16936, PERMIT G-16352
 SECTIONS 9, 13, 15, 16, 17, 22, 23, 24, AND 27,
 TOWNSHIP 11 SOUTH, RANGE 24 EAST,
 WILLAMETTE MERIDIAN, WHEELER COUNTY, OREGON.
 JANUARY, 2022

RECEIVED

JAN 27 2022

OWRD


AMENDED POINT OF APPROPRIATION #9 LOCATION FOR IRRIGATED LANDS UNDER APPLICATION G-16936, REPLACEMENT WELL WHEE 50500, INSTALLED. LOCATED 1519 FEET NORTH AND 2851 FEET EAST FROM SW CORNER, SECTION 13, T11S, R24E, W.M., LATITUDE: 44.61200, LONGITUDE: -119.78564

ORIGINAL POINT OF APPROPRIATION #4 LOCATION FOR IRRIGATED LANDS UNDER APPLICATION G-16936, LOG ID: WHEE 50337, TAG#: 91174 LOCATED 1342 FEET NORTH AND 2638 FEET EAST FROM SW CORNER, SECTION 13, T11S, R24E, W.M. LATITUDE: 44.611524, LONGITUDE: -119.786469

ORIGINAL POINT OF APPROPRIATION #5 LOCATION FOR IRRIGATED LANDS UNDER APPLICATION G-16936, LOG ID: WHEE 50330, TAG#: 91169 LOCATED 964 FEET NORTH AND 2498 FEET EAST FROM SW CORNER, SECTION 13, T11S, R24E, W.M. LATITUDE: 44.610480, LONGITUDE: -119.787041

AMENDED POINT OF APPROPRIATION #8 LOCATION FOR IRRIGATED LANDS UNDER APPLICATION G-16936, REPLACEMENT WELL WHEE 50519, INSTALLED LOCATED 1897 FEET SOUTH AND 2883 FEET EAST FROM NW CORNER, SECTION 23, T11S, R24E, W.M. LATITUDE: 44.60256, LONGITUDE: -119.80578

ORIGINAL POINT OF APPROPRIATION #3 LOCATION FOR IRRIGATED LANDS UNDER APPLICATION G-16936, LOG ID: WHEE 50328, TAG#: 91175 LOCATED 2167 FEET SOUTH AND 2427 FEET EAST FROM NW CORNER, SECTION 23, T11S, R24E, W.M. LATITUDE: 44.601846, LONGITUDE: -119.807541

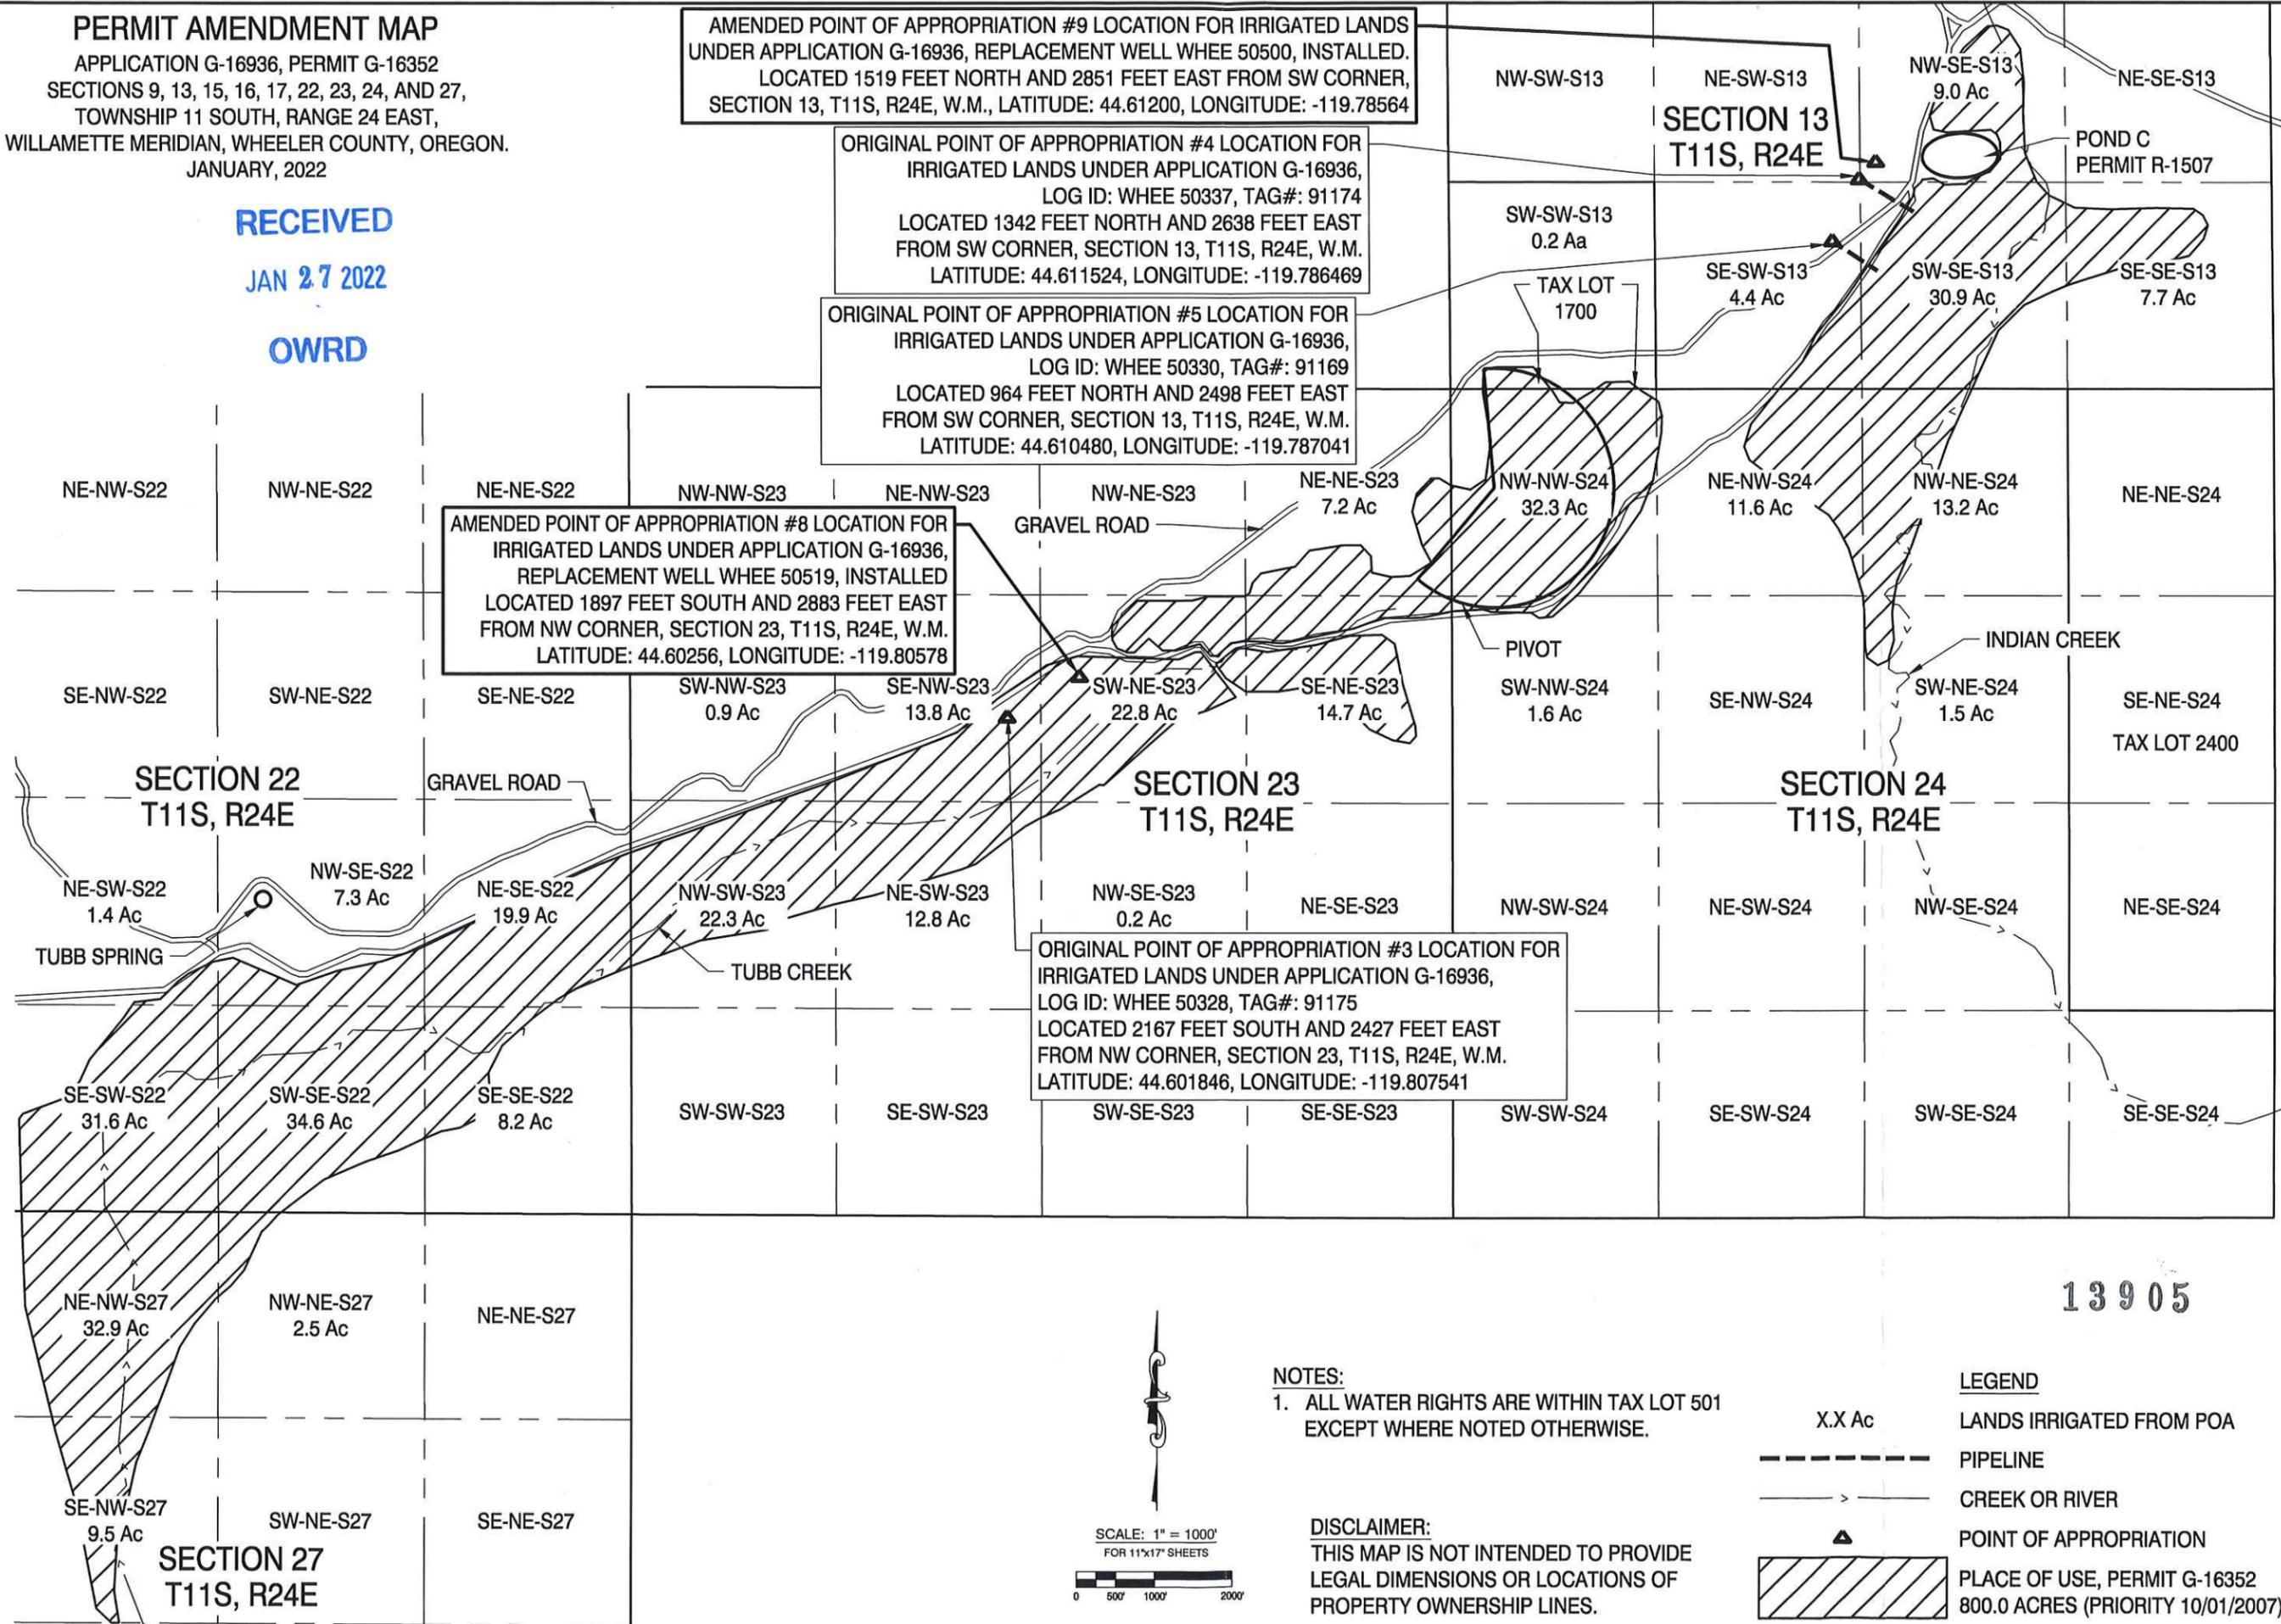

DRAWING STATUS:	DATE:	NO.	REVISION:
<input checked="" type="checkbox"/> PERMIT AMEND.	01/20/22	1	
<input type="checkbox"/>			


H.A.M. COY
 ENGINEERING & SURVEYING, LLC
 1120 SW Lake Blvd, Suite 201, Medford, OR 97504
 P.E. JAMES HAYES, LICENSED PROFESSIONAL ENGINEER
 P.E. JAMES HAYES, LICENSED PROFESSIONAL SURVEYOR
 541-945-7554 | james@hamcoy.com

PROJECT: PERMIT AMENDMENT MAP
 PROJECT LOCATION: WHEELER COUNTY, OREGON
 CLIENT: JASPER COUNTY, LLC

SHEET TITLE: EASTERN PORTIONS

JOB NO. 1063.102
 DRAWN BY: JJW
 DRAWING: WR1.2

13905

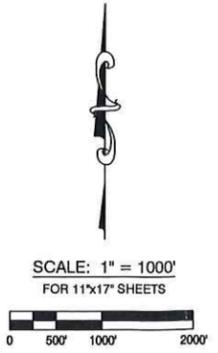

- NOTES:**
- ALL WATER RIGHTS ARE WITHIN TAX LOT 501 EXCEPT WHERE NOTED OTHERWISE.

DISCLAIMER:
 THIS MAP IS NOT INTENDED TO PROVIDE LEGAL DIMENSIONS OR LOCATIONS OF PROPERTY OWNERSHIP LINES.


LEGEND

- X.X Ac
- PIPELINE
- CREEK OR RIVER
- ▲ POINT OF APPROPRIATION
- ▨ PLACE OF USE, PERMIT G-16352 800.0 ACRES (PRIORITY 10/01/2007)


FILE: Z:\HAM_Eng\1063.102_DSD - Newton Water Rights\20120-1063102-PA_MAP.dwg 1/20/2022 1:42 PM - Owner

RECEIVED
 JAN 27 2022
 OWRD

PERMIT AMENDMENT MAP
 APPLICATION G-16936, PERMIT G-16352
 SECTIONS 9, 13, 15, 16, 17, 22, 23, 24, AND 27,
 TOWNSHIP 11 SOUTH, RANGE 24 EAST,
 WILLAMETTE MERIDIAN, WHEELER COUNTY, OREGON.
 JANUARY, 2022

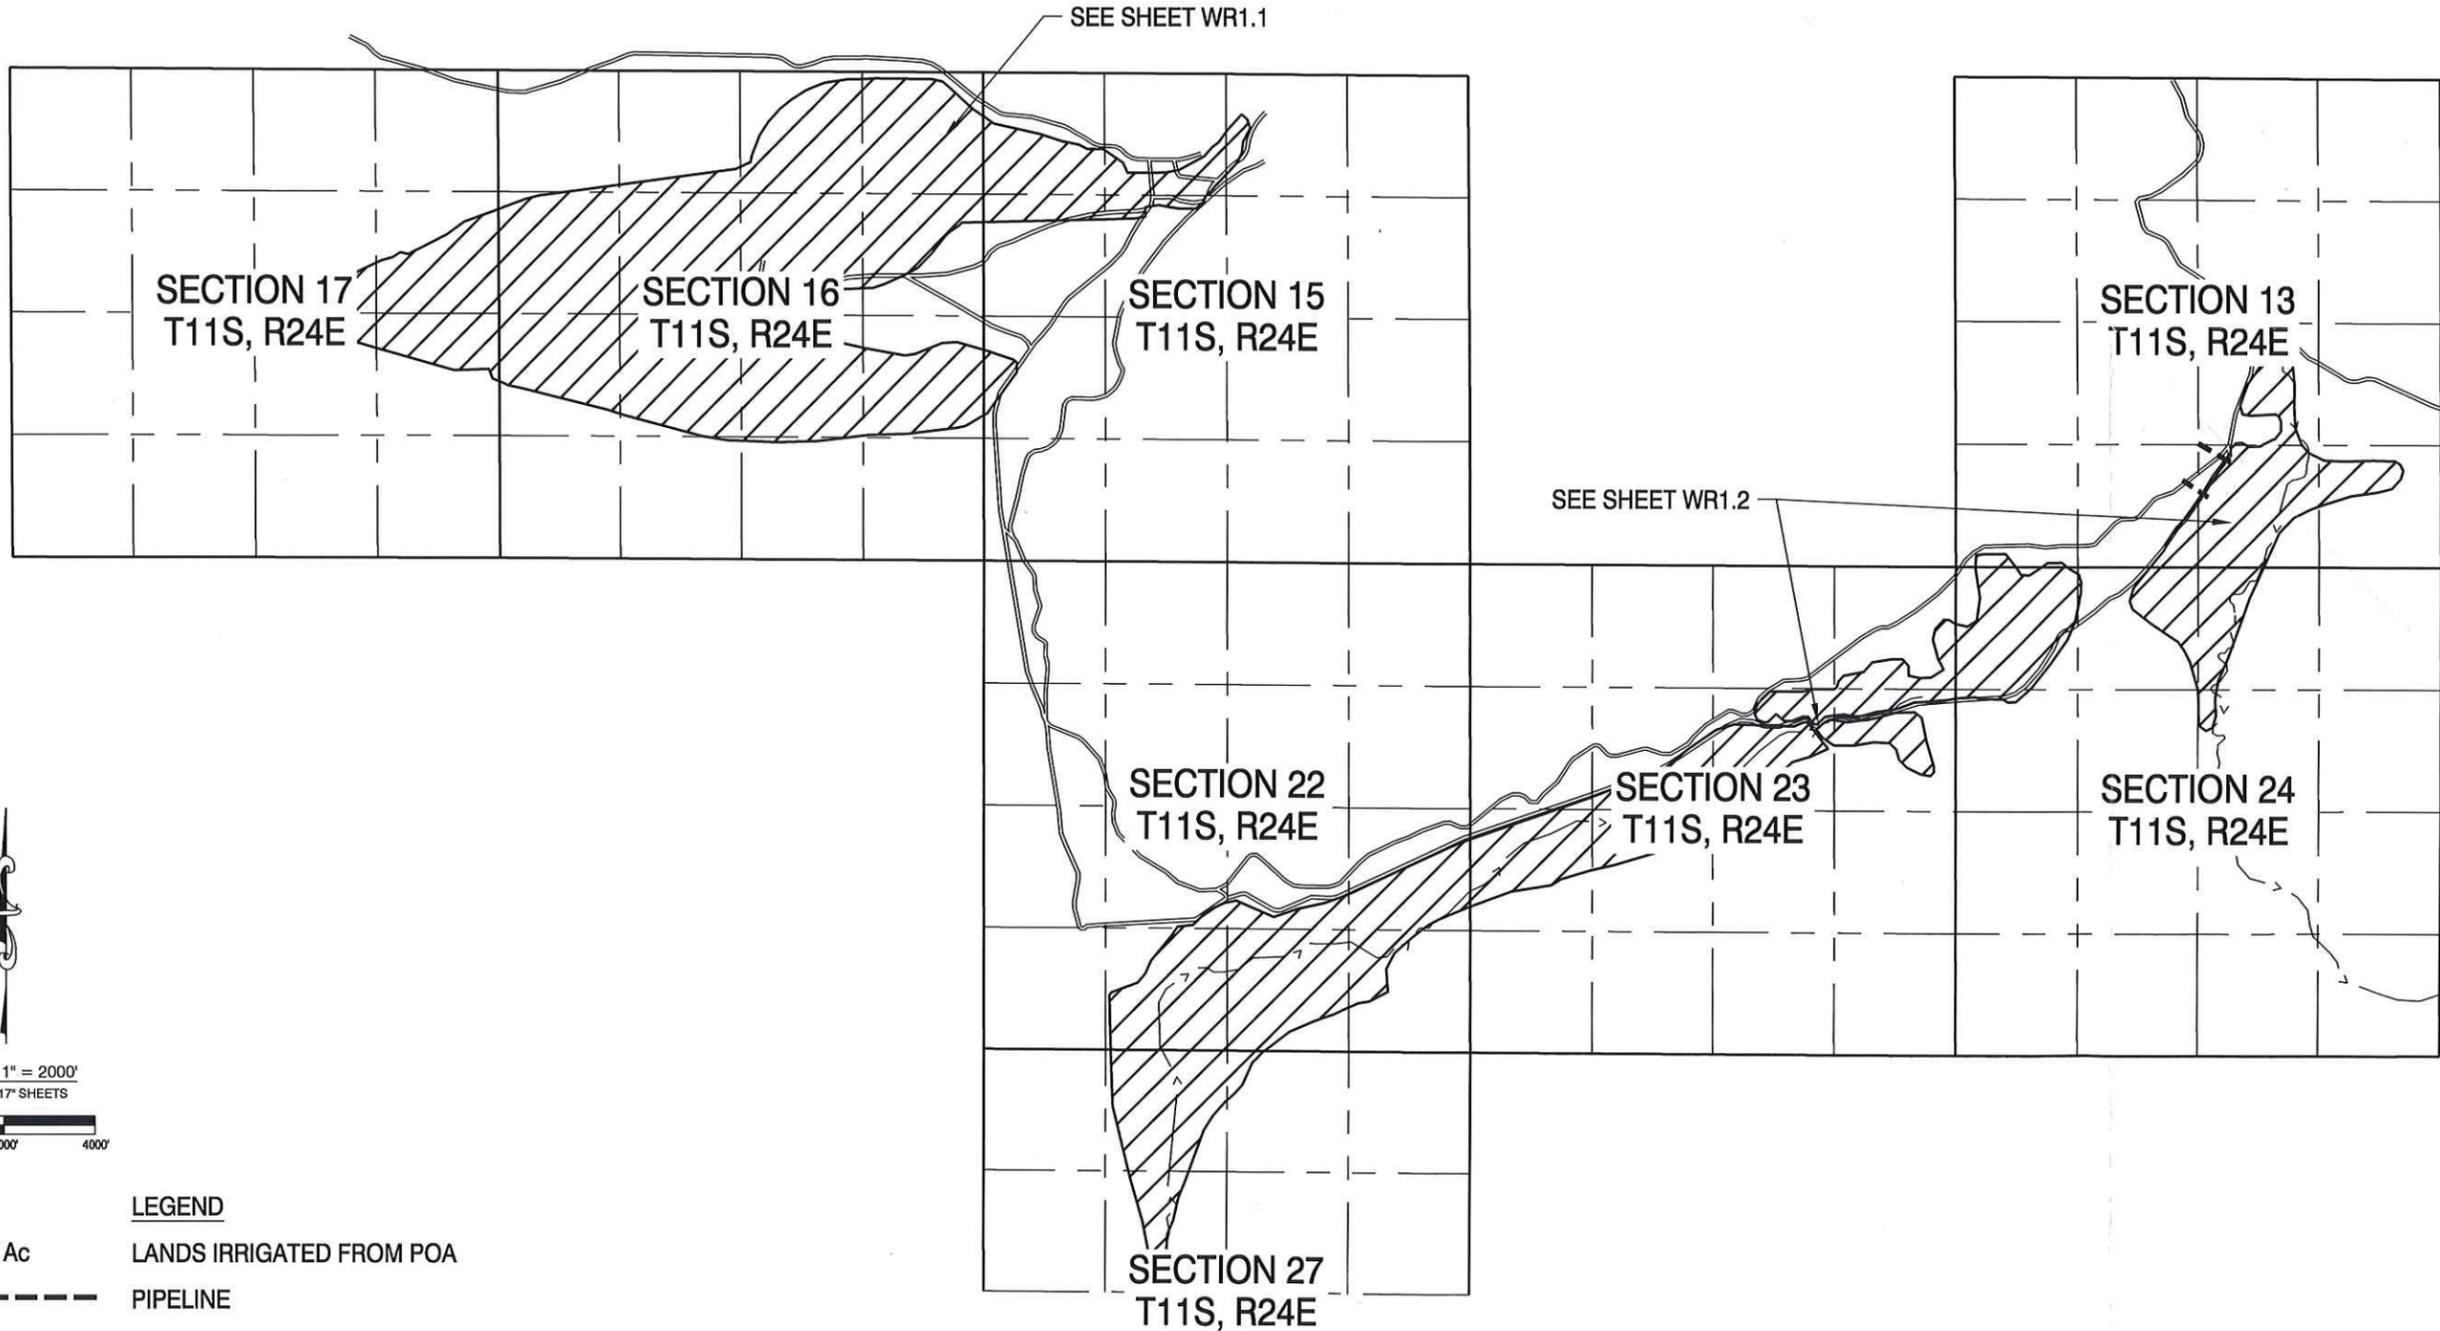

FILE: Z:\HAM Eng\1063.102 - Newton\Water Rights\20120-1063.102-PA_MAP.dwg 1/20/2022 1:42 PM - Owner

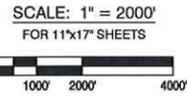

- LEGEND**
- X.X Ac LANDS IRRIGATED FROM POA
 - PIPELINE
 - CREEK OR RIVER
 - ▲ POINT OF APPROPRIATION
 - [Hatched Box] PLACE OF USE, PERMIT G-16352
800.0 ACRES (PRIORITY 10/01/2007)

DISCLAIMER:
 THIS MAP IS NOT INTENDED TO PROVIDE
 LEGAL DIMENSIONS OR LOCATIONS OF
 PROPERTY OWNERSHIP LINES.

DRAWING STATUS:	DATE:	REVISION:	No.	DATE:
<input checked="" type="checkbox"/> PERMIT AMEND.	01/20/22		1	
<input type="checkbox"/>			2	
<input type="checkbox"/>			3	
<input type="checkbox"/>			4	
<input type="checkbox"/>			5	
<input type="checkbox"/>			6	
<input type="checkbox"/>			7	
<input type="checkbox"/>			8	
<input type="checkbox"/>			9	
<input type="checkbox"/>			10	

H.A. McCOY
 ENGINEERING & SURVEYING, LLC
 11100 L. Ave. SE, Ste 101, Redmond, OR 97756
 HAYES, M.S. CIVIL
 P.E., S.I.S., OWRB
 541-942-7554
 hayes@ham-ecp.com

PROJECT:
 PERMIT AMENDMENT MAP

PROJECT LOCATION:
 WHEELER COUNTY, OREGON

CLIENT:
 JASPER COUNTY, LLC

SHEET TITLE:
 COVER SHEET

JOB NO. 1063.102
 DRAWN BY: JJW
 DRAWING:
WR1.0

13905