



Carbon Farm - Transfer POU - Certificate 4841

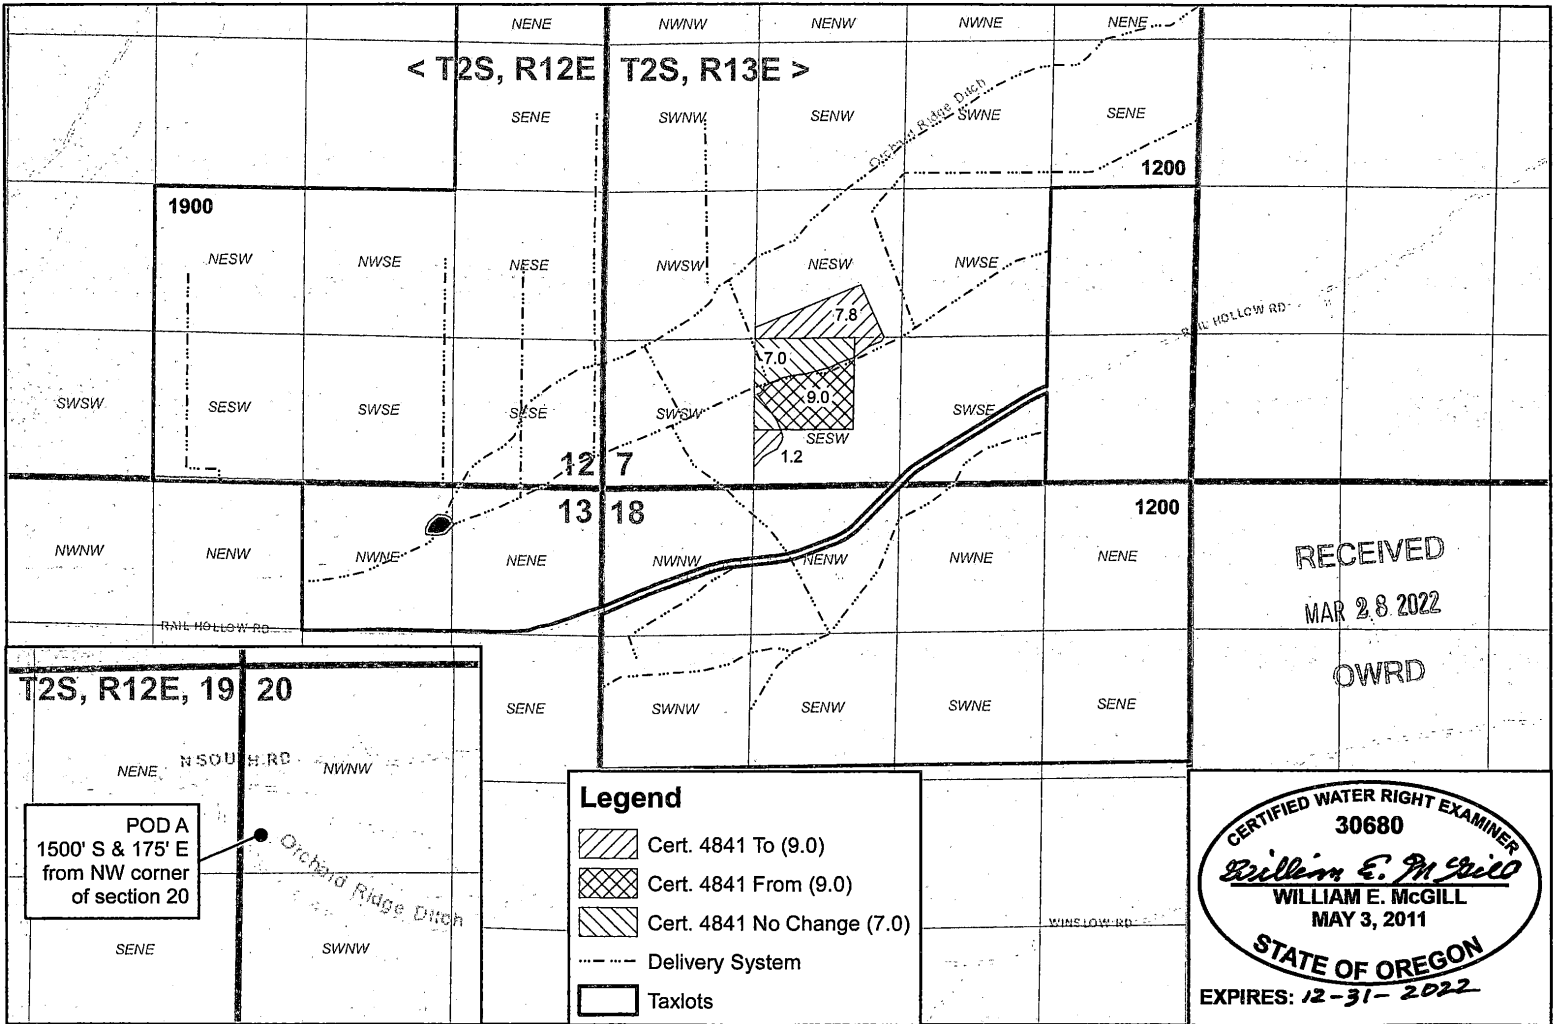

CERTIFIED WATER RIGHT EXAMINER
 30680
William E. McGill
 WILLIAM E. MCGILL
 MAY 3, 2011
 STATE OF OREGON
 EXPIRES: 12-31-2022

13956 WILL MCGILL SURVEYING LLC

Carbon Farm - Transfer POU - Certificate 3483

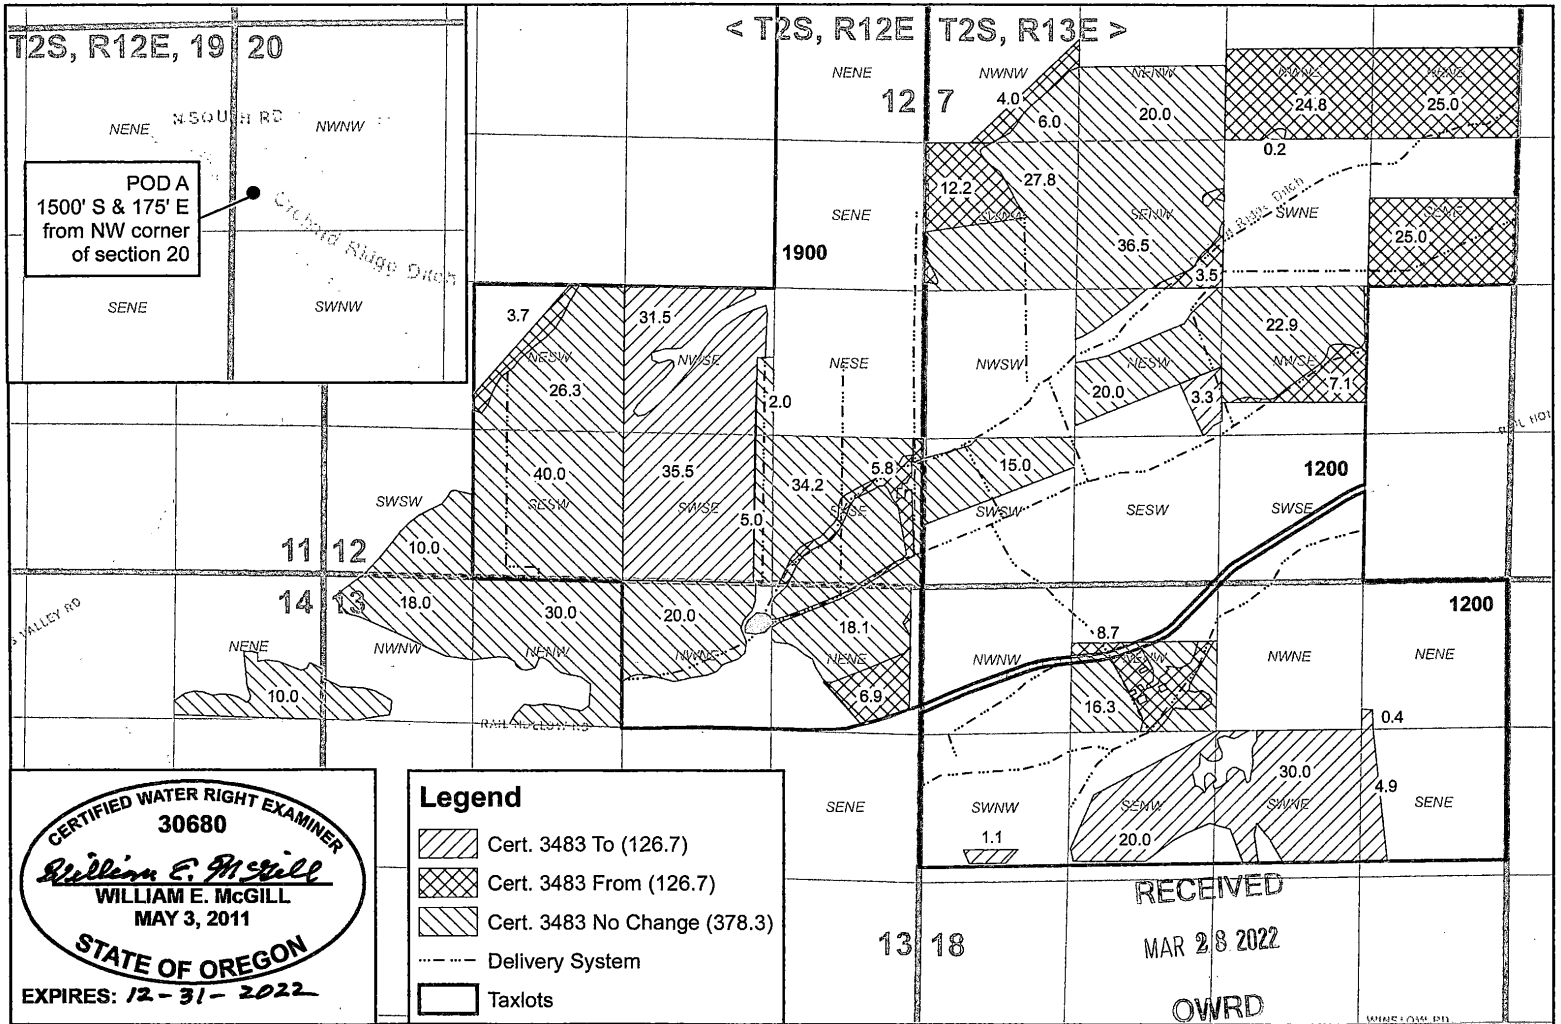


0 1,320 2,640 5,280 Feet

13956

WILL MCGILL SURVEYING LLC

Carbon Farm - Transfer POU - Certificate 8105

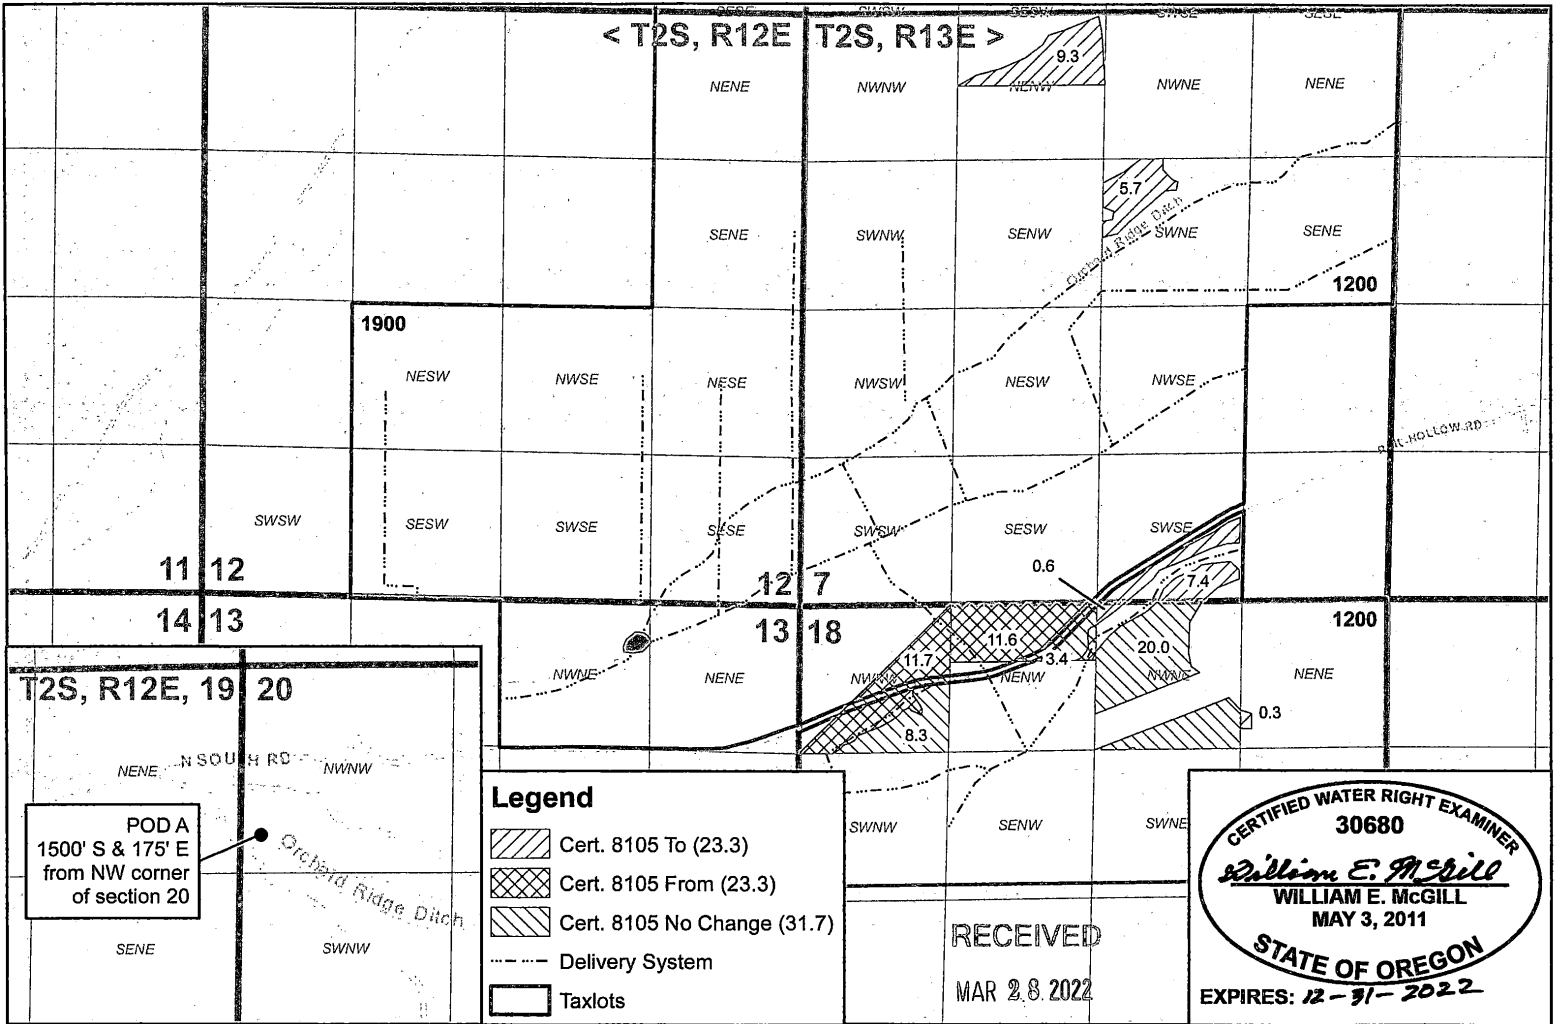

T2S, R12E, 19 | 20

PODA
1500' S & 175' E
from NW corner
of section 20

Orchard Ridge Ditch

< T2S, R12E | T2S, R13E >

1200

1900

11 | 12
14 | 13

12 | 7
13 | 18

1200

RECEIVED
MAR 28 2022

CERTIFIED WATER RIGHT EXAMINER
30680
William E. McGill
WILLIAM E. MCGILL
MAY 3, 2011
STATE OF OREGON
EXPIRES: 12-31-2022



0 1,320 2,640 5,280 Feet

OWRD
13956

WILL MCGILL SURVEYING LLC

Carbon Farm - Transfer POU - Certificate 10112

