


RIDGEVIEW IRRIGATION DISTRICT

Temporary OFF Transfer Map For Price Seed Farm  
 Certificate: 81012

LDP  
 4/6/2022

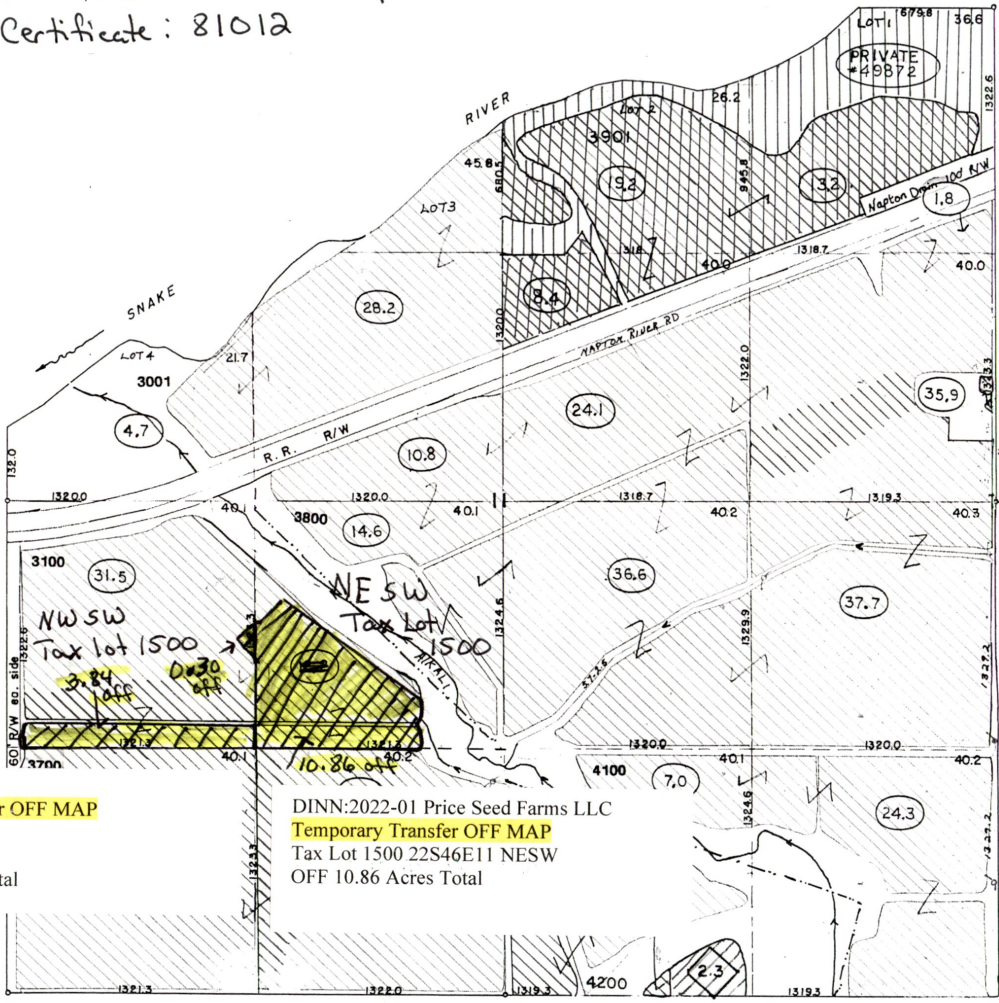

Temp  
 Transfer

- OVERLAP ACRES
- IR. ACRES IN 1/4 1/4
- IR. ACRES
- PENDING
- Now Approved
- PRIVATE ACRES
- PRIVATE ACRES
- PROPERTY LINE IF OTHER THAN 1/4 1/4



SCALE: 1" = 400'

RECEIVED  
 APR 11 2022  
 OWRD

13970

Temporary Transfer OFF MAP  
 Tax Lot 1500  
 22S46E11 NWSW  
 OFF 4.14 Acres Total

DINN:2022-01 Price Seed Farms LLC  
 Temporary Transfer OFF MAP  
 Tax Lot 1500 22S46E11 NESW  
 OFF 10.86 Acres Total

SOUTHWEST CORNER  
 OF SECTION 11

SEC. 11, T.22 S., R. 46 E., W.M. 44-132-1857

Traced: R.W.B. 4-16-53  
 Checked: R.F. 6-20-55

RIDGEVIEW IRRIGATION DISTRICT


Temporary ON Transfer Map For Price Seed Farm Certificate 81012

WOP  
4/6/2022

OWRD  
RECEIVED  
APR 11 2022

RECEIVED  
APR 11 2022  
OWRD

Temporary Transfer ON MAP  
Tax Lot 1600  
22S46E10 SENE  
ON 0.3 Acres Total

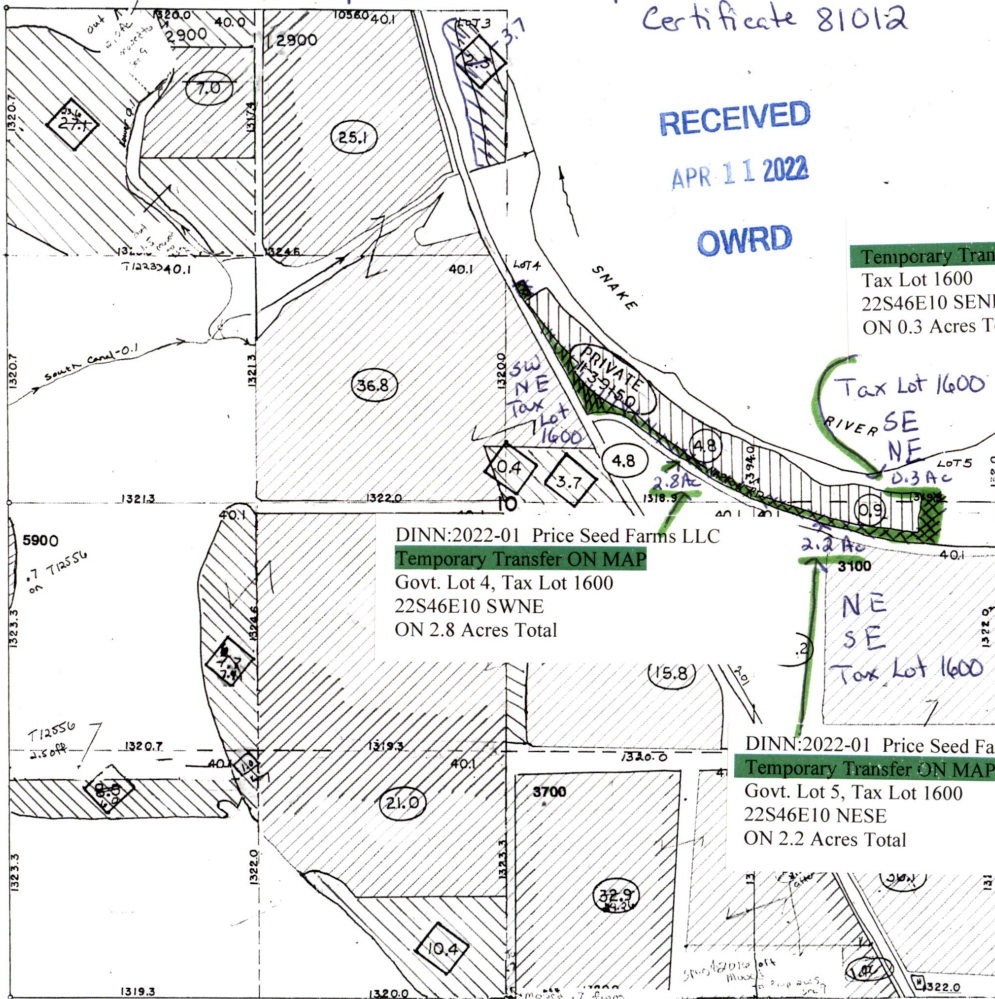

DINN:2022-01 Price Seed Farms LLC  
Temporary Transfer ON MAP  
Govt. Lot 4, Tax Lot 1600  
22S46E10 SWNE  
ON 2.8 Acres Total

DINN:2022-01 Price Seed Farms LLC  
Temporary Transfer ON MAP  
Govt. Lot 5, Tax Lot 1600  
22S46E10 NESE  
ON 2.2 Acres Total

Temp Transfer  
Now Approved

13970

SCALE: 1" = 400'

SOUTHWEST CORNER  
OF SECTION 10

SEC. 10, T.22 S., R. 46 E., W.M.

Traced: R.W.R. 4-15-53  
Checked: R.F. 6-20-55

48-102-1558




RIDGEVIEW IRRIGATION DISTRICT

Temporary ON Transfer Map for Price Seed Farm  
Certificate 81012

RECEIVED  
APR 11 2022  
OWRD

LDP  
4/6/2022

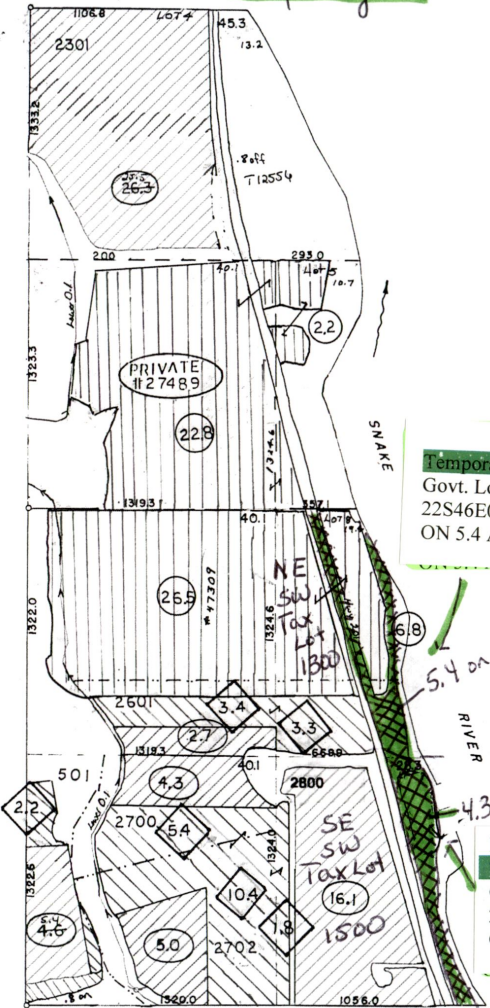

Temporary Transfer ON MAP  
Govt. Lot 8, Tax Lot 1300  
22S46E03 NESW  
ON 5.4 Acres Total

DINN:2022-01 Price Seed Farms LLC  
Temporary Transfer ON MAP  
Govt. Lot 9, Tax Lot 1500  
22S46E03 SESW  
ON 4.3 Acres Total

- Temp Transfer
- 22.2
- 22.2 ACRES IN 1/4 1/4
- 22.2 ACRES
- PENDING
- PENDING ACRES Now Approved
- PRIVATE
- PRIVATE ACRES
- PROPERTY LINE IF OTHER THAN 1/4 1/4

13970



SCALE: 1" = 400'

SOUTHWEST CORNER  
OF SECTION 3

SEC. 3, T.22 S., R.46 E., W.M.

48-102-1556

Traced: N.W.P. 4-15-53  
Checked: R.F. 6-20-55